


DATE: 05/09/2002
 TIME: 11:00 AM
 USER: DAVE MILLER

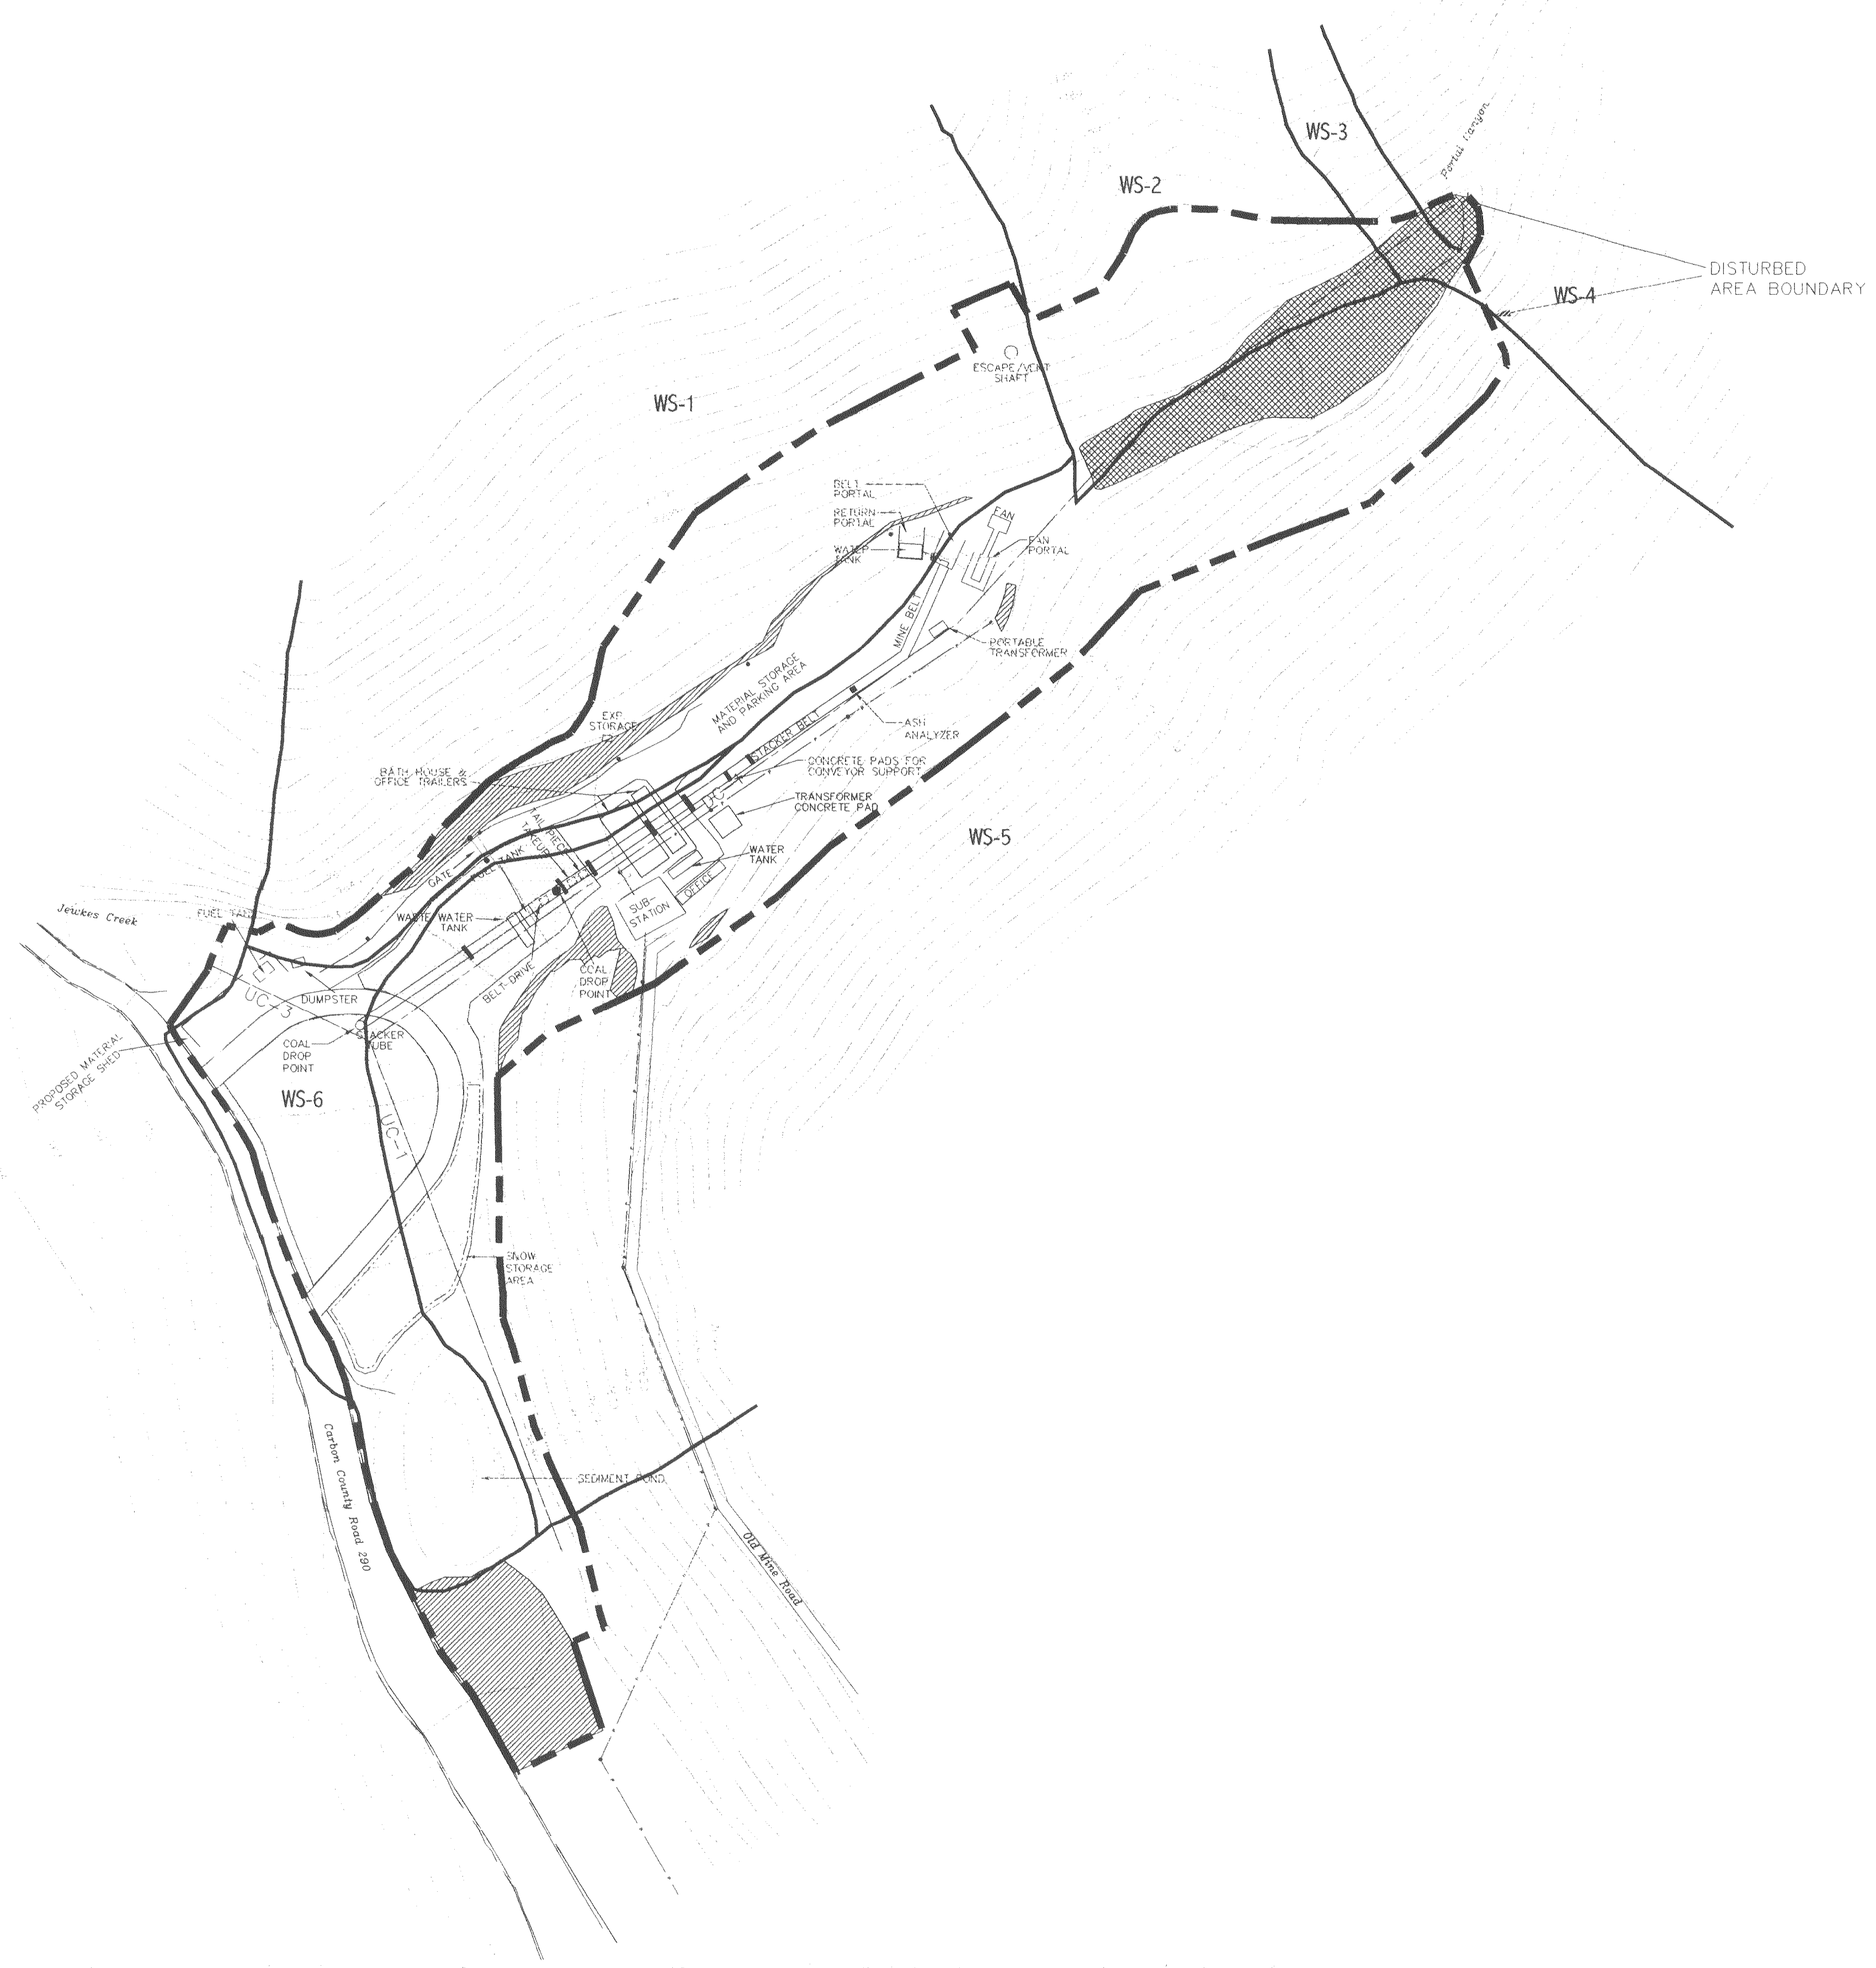

PROPOSED
 DIVISION OF
 SITES PLAN AND MINING
 LEGEND

	POWER/TELEPHONE POLES
	UNIMPROVED ROAD
	IMPROVED GRAVEL ROAD
	STREAMS AND DITCHES
	CULVERT
	WATERSHED BOUNDARY

6 5 4

1

7 8 9


12

18 16

13

LEGEND

	IMPROVED GRAVEL ROAD
	UNIMPROVED ROAD
	JEEP TRAILS
	STREAMS

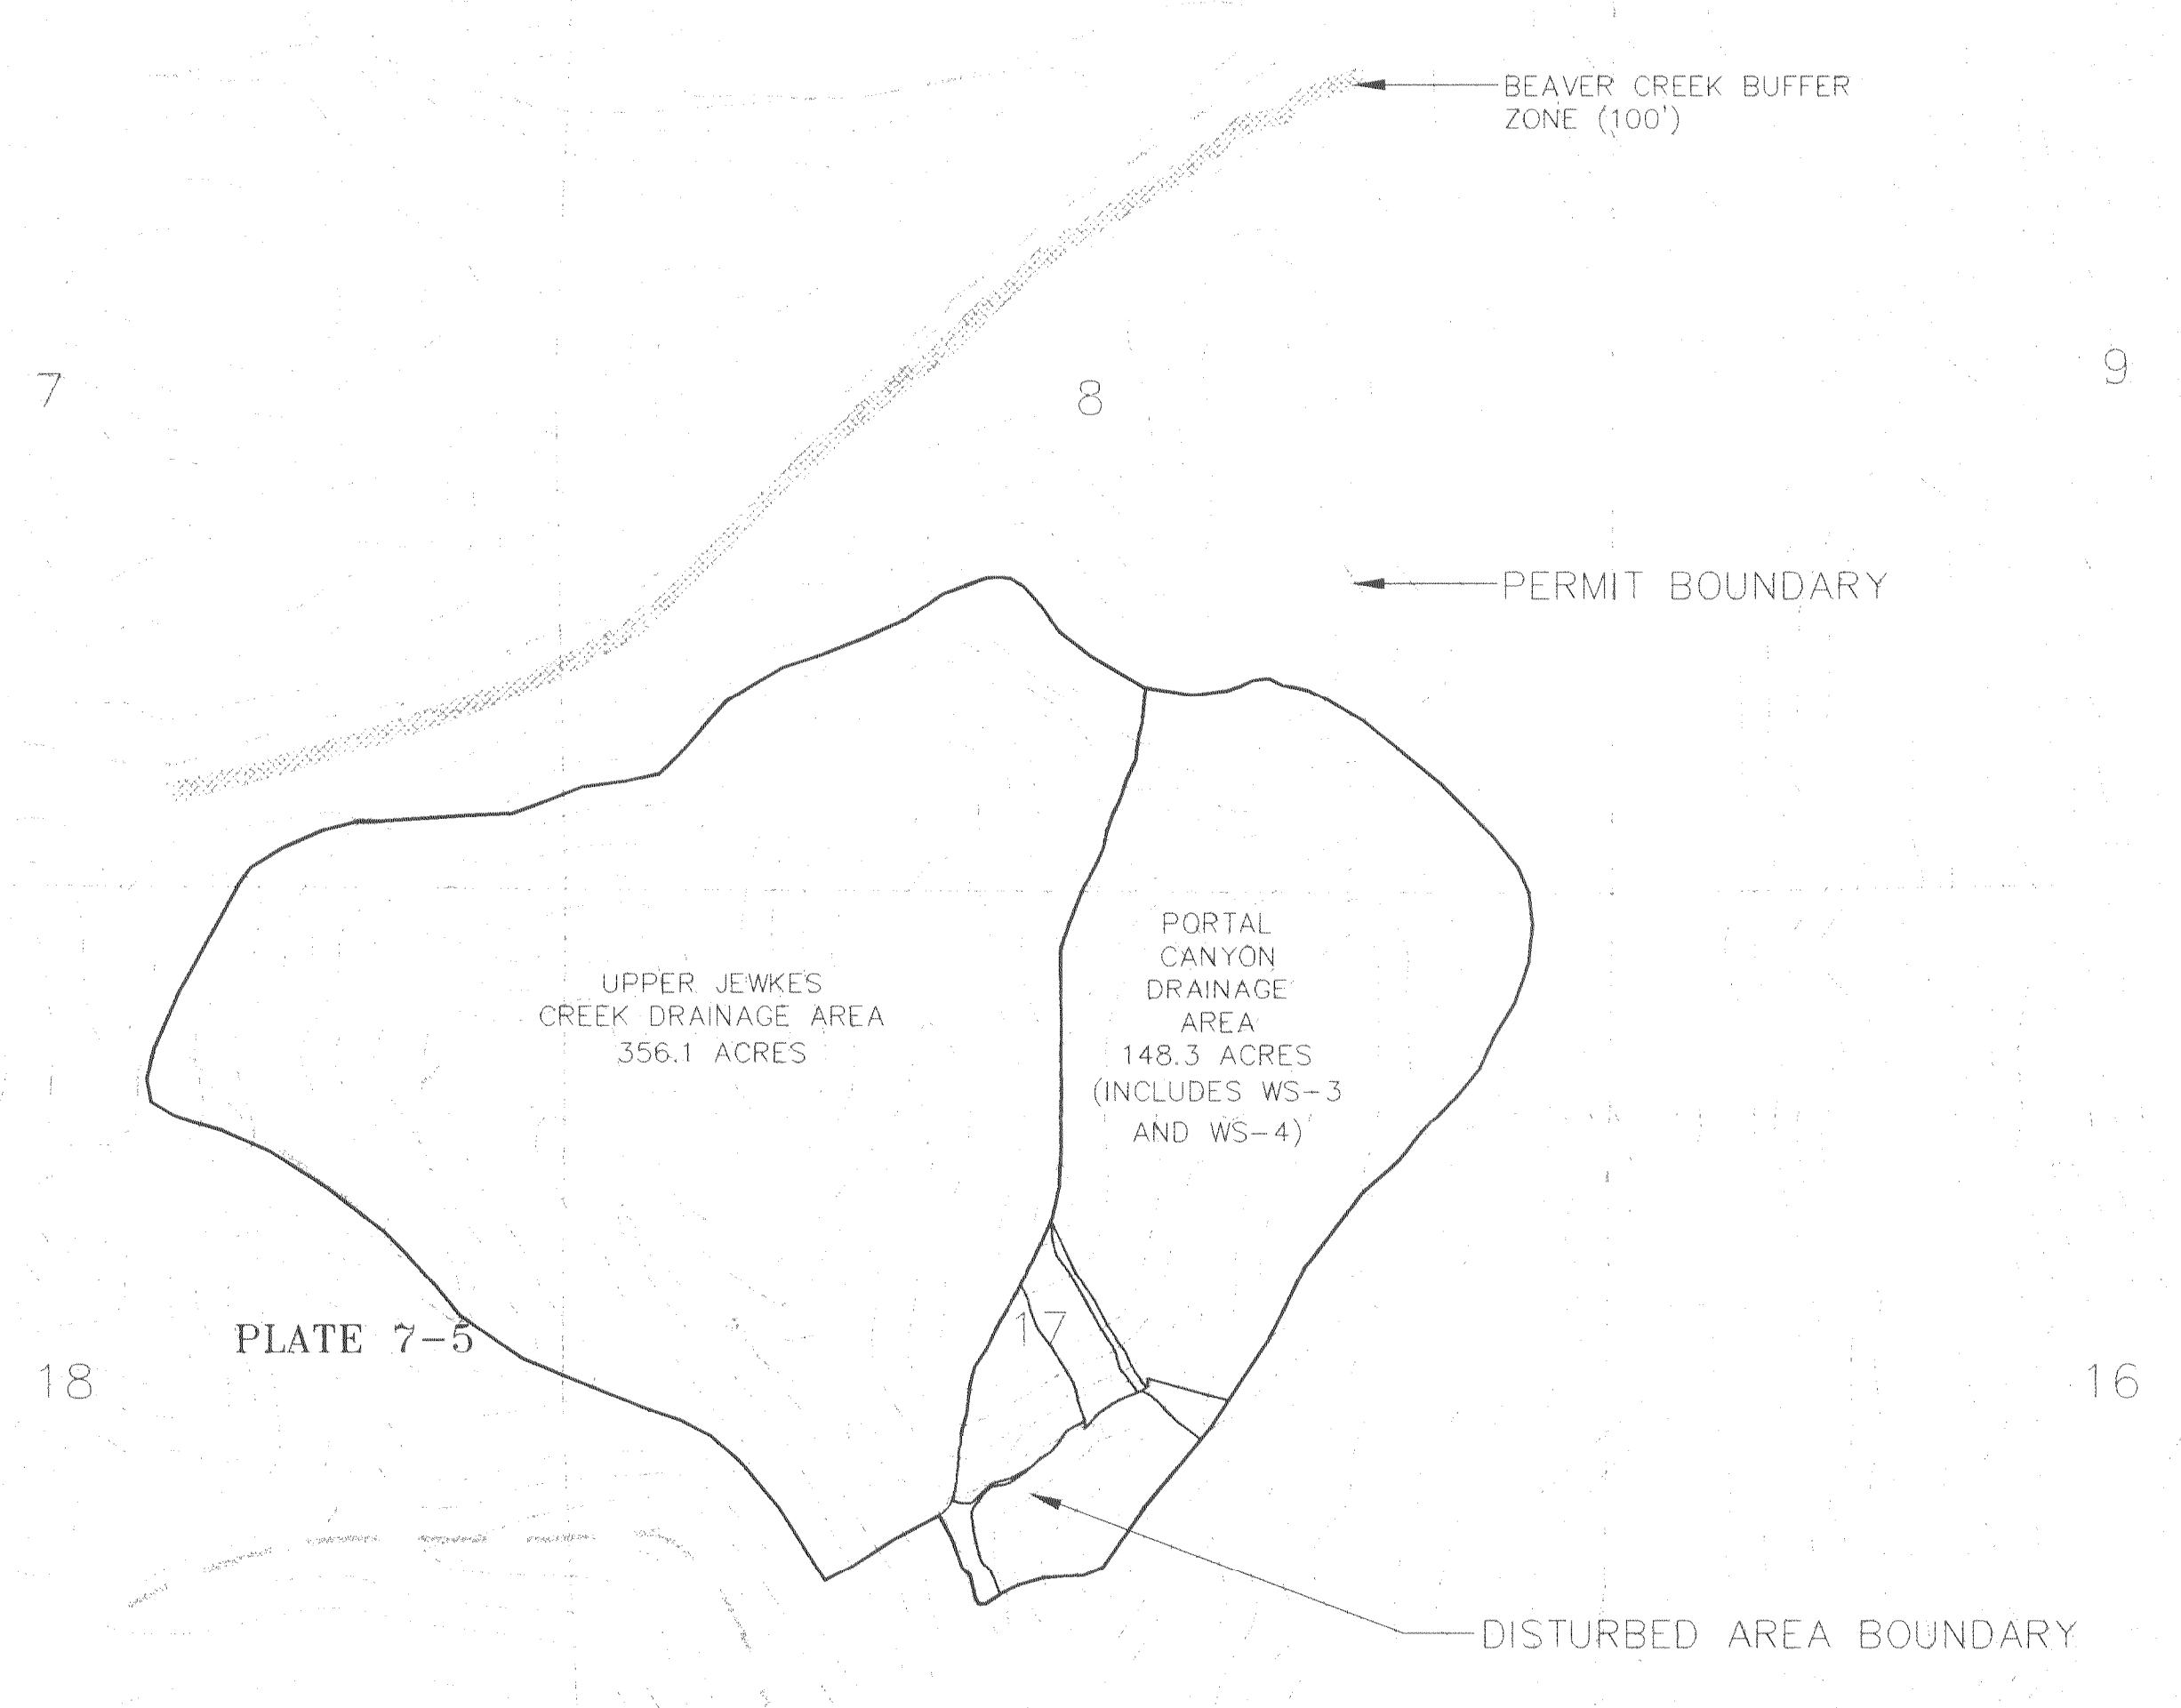

LEGEND:

PLATE 7-5	SEDCAD OUTPUT	CURVE #
WS1	or 1 =	70
WS2	or 2 =	70
WS5	or 3 =	77
WS6	or 4 =	90



REVISION	
BY	DATE
RRW	10-16-97
DDM	5-31-99
	AS BUILT

LODESTAR ENERGY, INC.
 HORIZON MINE
 HC35 BOX 370
 HELPER, UTAH 84526

PLATE 7-5

DRAINAGE OPERATIONS

DRAWN BY: RR CHECKED BY: Dave Miller DATE: May 09, 2002
 APPROVED BY: Dave Miller ATTACHED FILE: \\G:\Data\Horizon Permits\Submittal\ PLT7-5.dwg

Lodestar Engineering, Inc.