


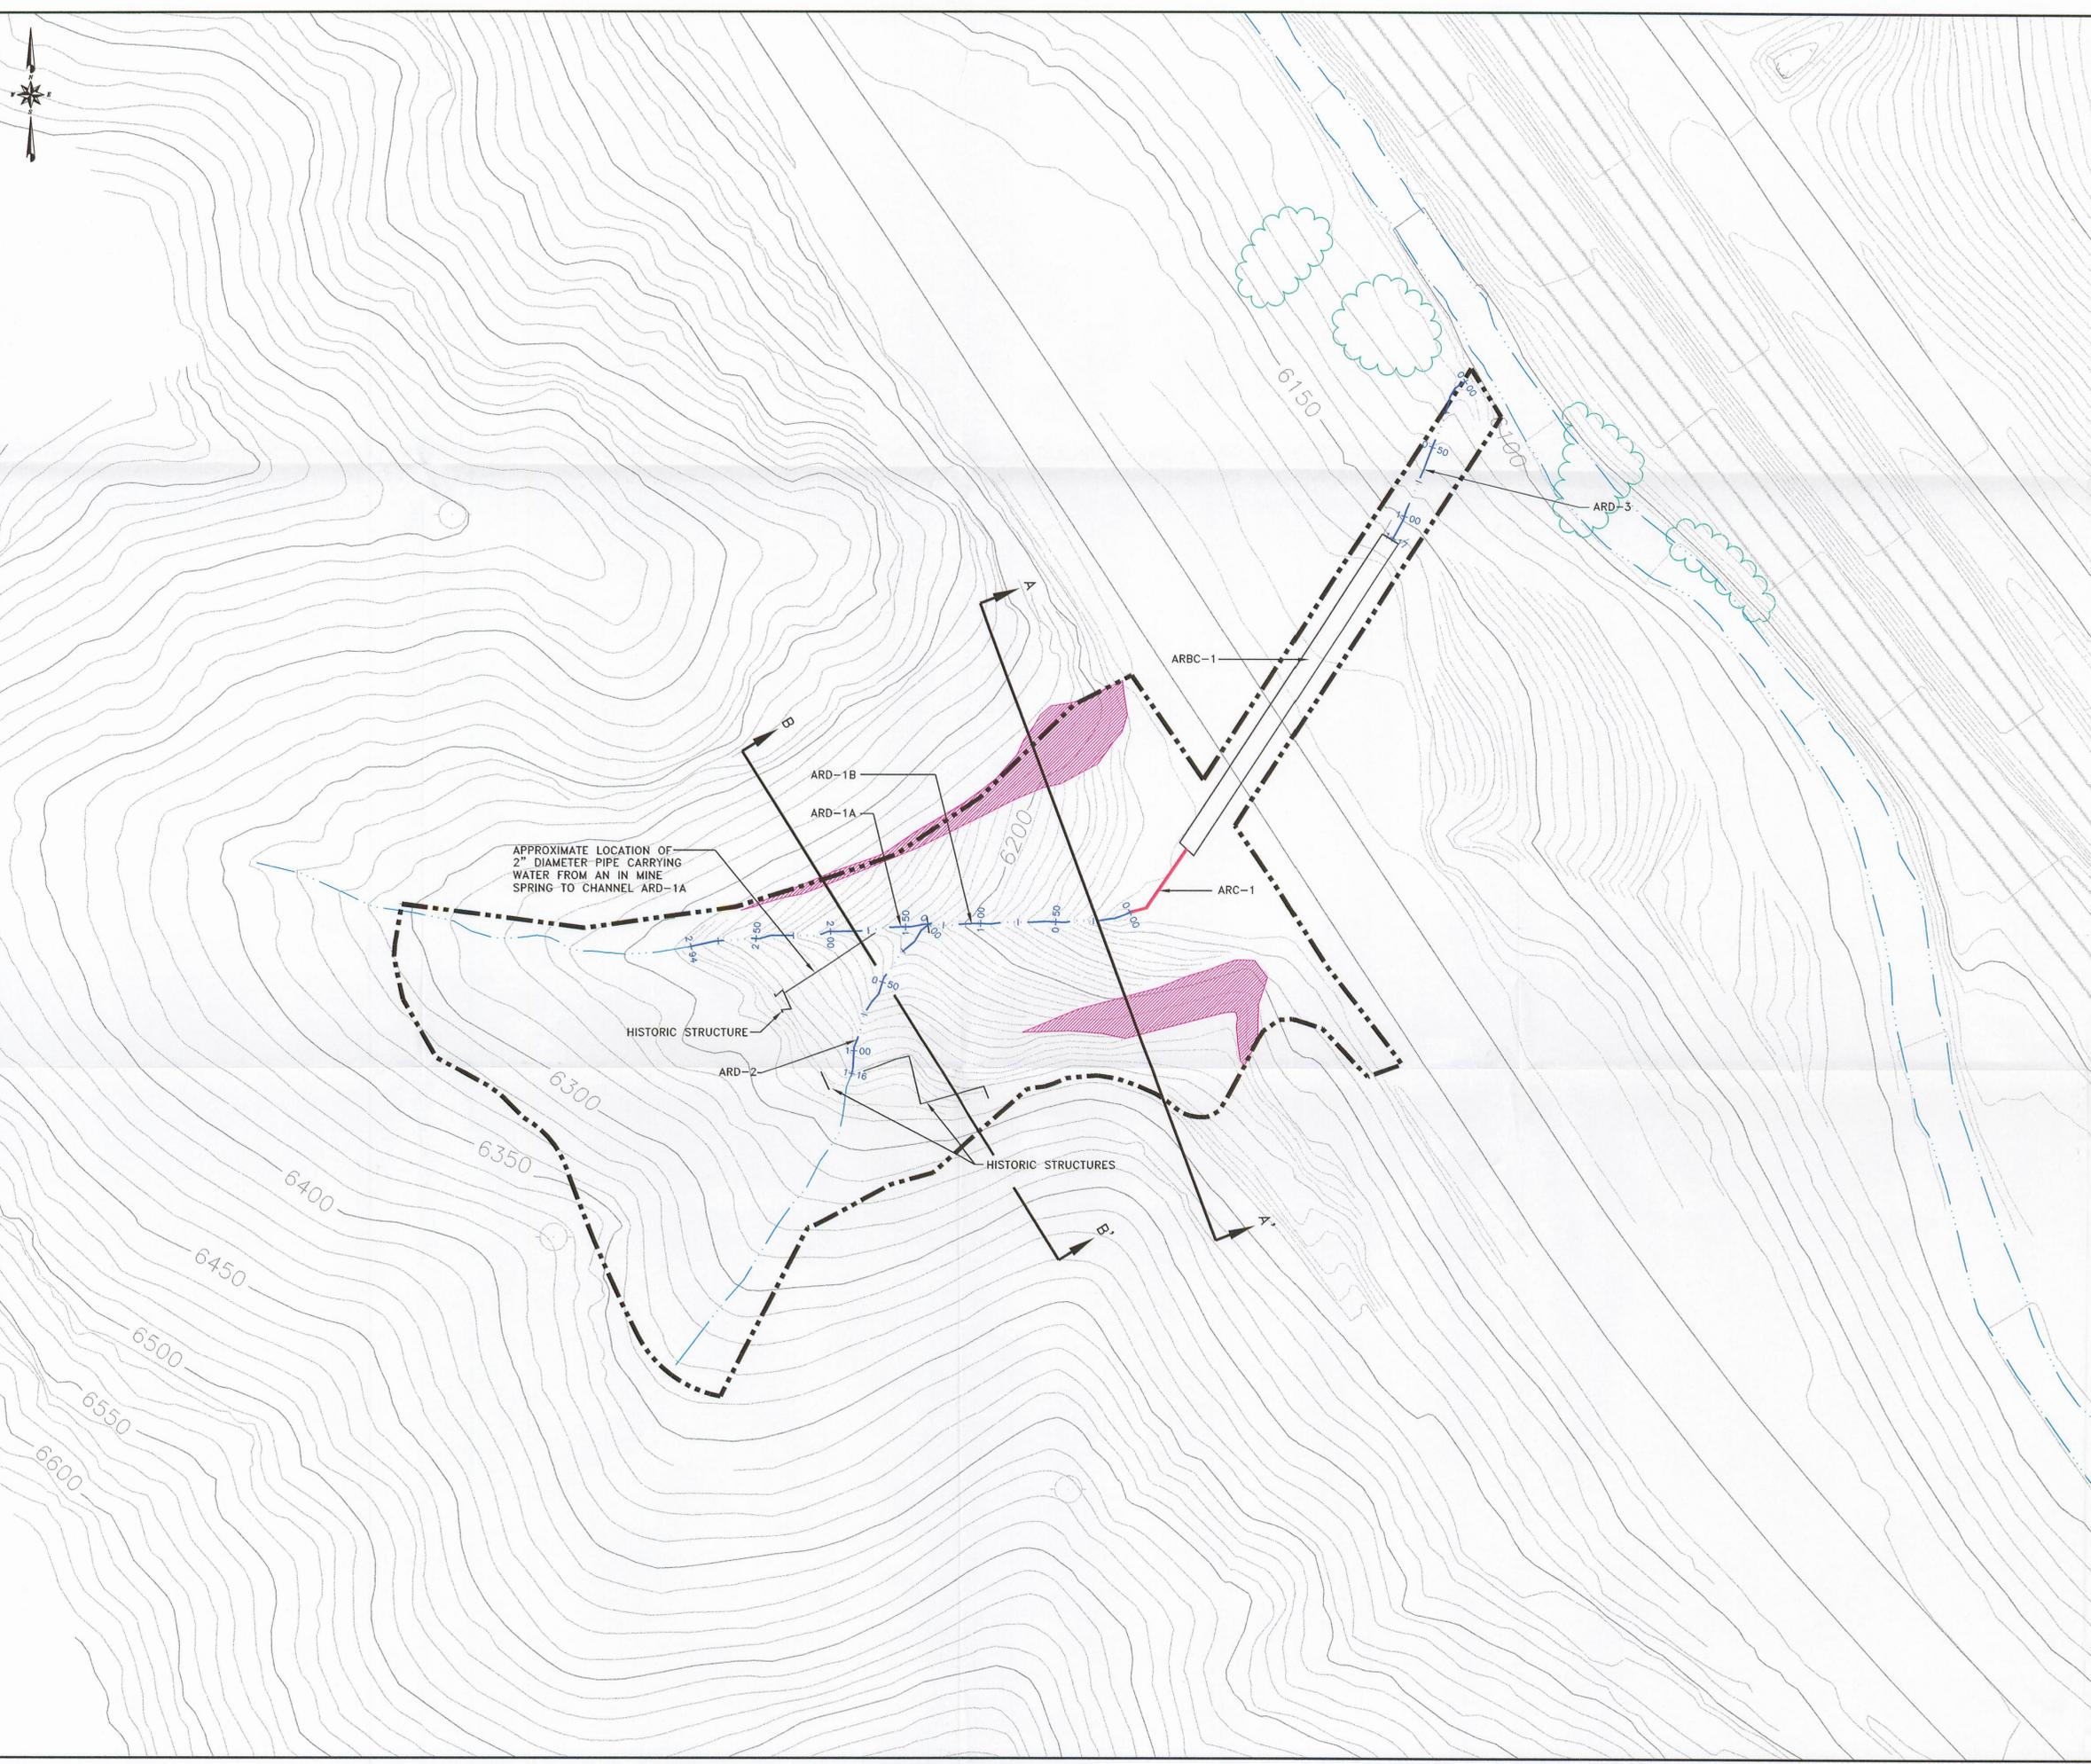

**LEGEND**

---	DISTURBED AREA BOUNDARY
---	STREAM, DRAINAGE, RIVER
---	(ARD-1) ADIT NO. 1 RECLAMATION DIVERSION
---	RETAINED PRE-SMCRA CUTSLOPE
---	ARC-1 ADIT NO. 1 RECLAMATION CULVERT
---	ARC-1 ADIT NO. 1 RECLAMATION BOX CULVERT

NOTES:



RECEIVED  
MAY 05 2005  
DIV. OF OIL, GAS & MINING



REVISION	
DATE	BY
9-18-01	LDJ
1-30-01	LDJ
APR 05	LDJ

**Castle Gate Mine**  
Carbon County, Utah

ADIT NO. 1  
AS-BUILT RECLAMATION  
TOPOGRAPHY AND DRAINAGE  
STRUCTURE LOCATION MAP

**CASTLE GATE HOLDING**

DRAWN BY: SWF	PROJECT NUMBER: UC-709-08	SCALE: 1" = 50'
APPROVED BY: LDJ	FILE NAME: G:\UC709\29\DWG\EX35-5AB.DWG	EXHIBIT 3.5-5AB
DATE: APRIL 2001	EarthFax Engineering, Inc.	