

C/007/005 Incoming



Jeremiah Armstrong, Environmental Eng.
HC35, Box 380
Helper, Utah 84526
(435) 448-2645
Fax (435) 448-2632

January 19, 2016

Mr. Daron R. Haddock
Division of Oil, Gas, and Mining
1594 West North Temple
Salt Lake City, Utah 84114-5801

RECEIVED
RECEIVED
JAN 28 2016
DIV. OF OIL, GAS & MINING
DIV. OF OIL, GAS & MINING

Winter Quarters Ventilation Facility – As Built, Canyon Fuel Company, LLC, Skyline Mine, C/007/005

Dear Daron,

Attached to this letter is pertinent information addressing modifications to the Skyline Mine M&RP to include an as-built drawing of the Winter Quarter Ventilation Facility. The modification includes all installed facilities including the ventilation fan, refuge building, and other minor surface items. Temporary construction facilities have been removed from the drawing. The permit modifications consist of: 1) updated drawing 3.2.4-3A.

Attached to this cover letter are the completed C1 and C2 forms and Two (2) CLEAN hard copies of the M&RP modifications in Section 3.2.

If you have any questions regarding this information, please give me a call at (435) 448-2645.

Sincerely,

Jeremiah Armstrong
Canyon Fuel Company, LLC – Skyline Mines
Environmental Engineer

- Enclosures
- C1 Application for Coal Permit Processing
- C2 Detailed Schedule of Changes
- Plate 3.2.4-3A (Two (2) clean copies)

APPLICATION FOR COAL PERMIT PROCESSING

Permit Change New Permit Renewal Exploration Bond Release Transfer

Permittee: Canyon Fuel Company, LLC

Mine: Skyline Mine

Permit Number: C/007/005

Title: Winter Quarters Ventilation Facility – As Built

Description, Include reason for application and timing required to implement:

Finalized Winter Quarters Vent Pad drawing

Instructions: If you answer yes to any of the first eight (gray) questions, this application may require Public Notice publication.

- Yes No 1. Change in the size of the Permit Area? Acres: ___ Disturbed Area: _____ increase decrease.
- Yes No 2. Is the application submitted as a result of a Division Order? DO# _____
- Yes No 3. Does the application include operations outside a previously identified Cumulative Hydrologic Impact Area?
- Yes No 4. Does the application include operations in hydrologic basins other than as currently approved?
- Yes No 5. Does the application result from cancellation, reduction or increase of insurance or reclamation bond?
- Yes No 6. Does the application require or include public notice publication?
- Yes No 7. Does the application require or include ownership, control, right-of-entry, or compliance information?
- Yes No 8. Is proposed activity within 100 feet of a public road or cemetery or 300 feet of an occupied dwelling?
- Yes No 9. Is the application submitted as a result of a Violation? NOV # _____
- Yes No 10. Is the application submitted as a result of other laws or regulations or policies?
Explain: _____
- Yes No 11. Does the application affect the surface landowner or change the post mining land use?
- Yes No 12. Does the application require or include underground design or mine sequence and timing? (Modification of R2P2)
- Yes No 13. Does the application require or include collection and reporting of any baseline information?
- Yes No 14. Could the application have any effect on wildlife or vegetation outside the current disturbed area?
- Yes No 15. Does the application require or include soil removal, storage or placement?
- Yes No 16. Does the application require or include vegetation monitoring, removal or revegetation activities?
- Yes No 17. Does the application require or include construction, modification, or removal of surface facilities?
- Yes No 18. Does the application require or include water monitoring, sediment or drainage control measures?
- Yes No 19. Does the application require or include certified designs, maps or calculation?
- Yes No 20. Does the application require or include subsidence control or monitoring?
- Yes No 21. Have reclamation costs for bonding been provided?
- Yes No 22. Does the application involve a perennial stream, a stream buffer zone or discharges to a stream?
- Yes No 23. Does the application affect permits issued by other agencies or permits issued to other entities?

Information submitted electronically in Adobe Acrobat .pdf format. (This number includes a copy for the Price Field Office.)

I hereby certify that I am a responsible official of the applicant and that the information contained in this application is true and correct to the best of my information and belief in all respects with the laws of Utah in reference to commitments, undertakings, and obligations, herein.

Corey Heaps
Print Name

Corey Heaps, GM, 1-19-16
Sign Name, Position, Date


Subscribed and sworn to before me this 19th day of JAN, 2016

Kathleen Atwood
Notary Public

My commission Expires: _____
Attest: State of Utah 12-02, 2019) ss:
County of Carbon



<p>For Office Use Only:</p>	<p>Assigned Tracking Number:</p>	<p>Received by Oil, Gas & Mining</p> <p style="text-align: center; font-size: 1.5em; color: blue; font-weight: bold;">RECEIVED</p> <p style="text-align: center; color: red; font-weight: bold;">JAN 28 2016</p> <p style="text-align: center; color: blue; font-weight: bold;">DIV. OF OIL, GAS & MINING</p>
------------------------------------	----------------------------------	---

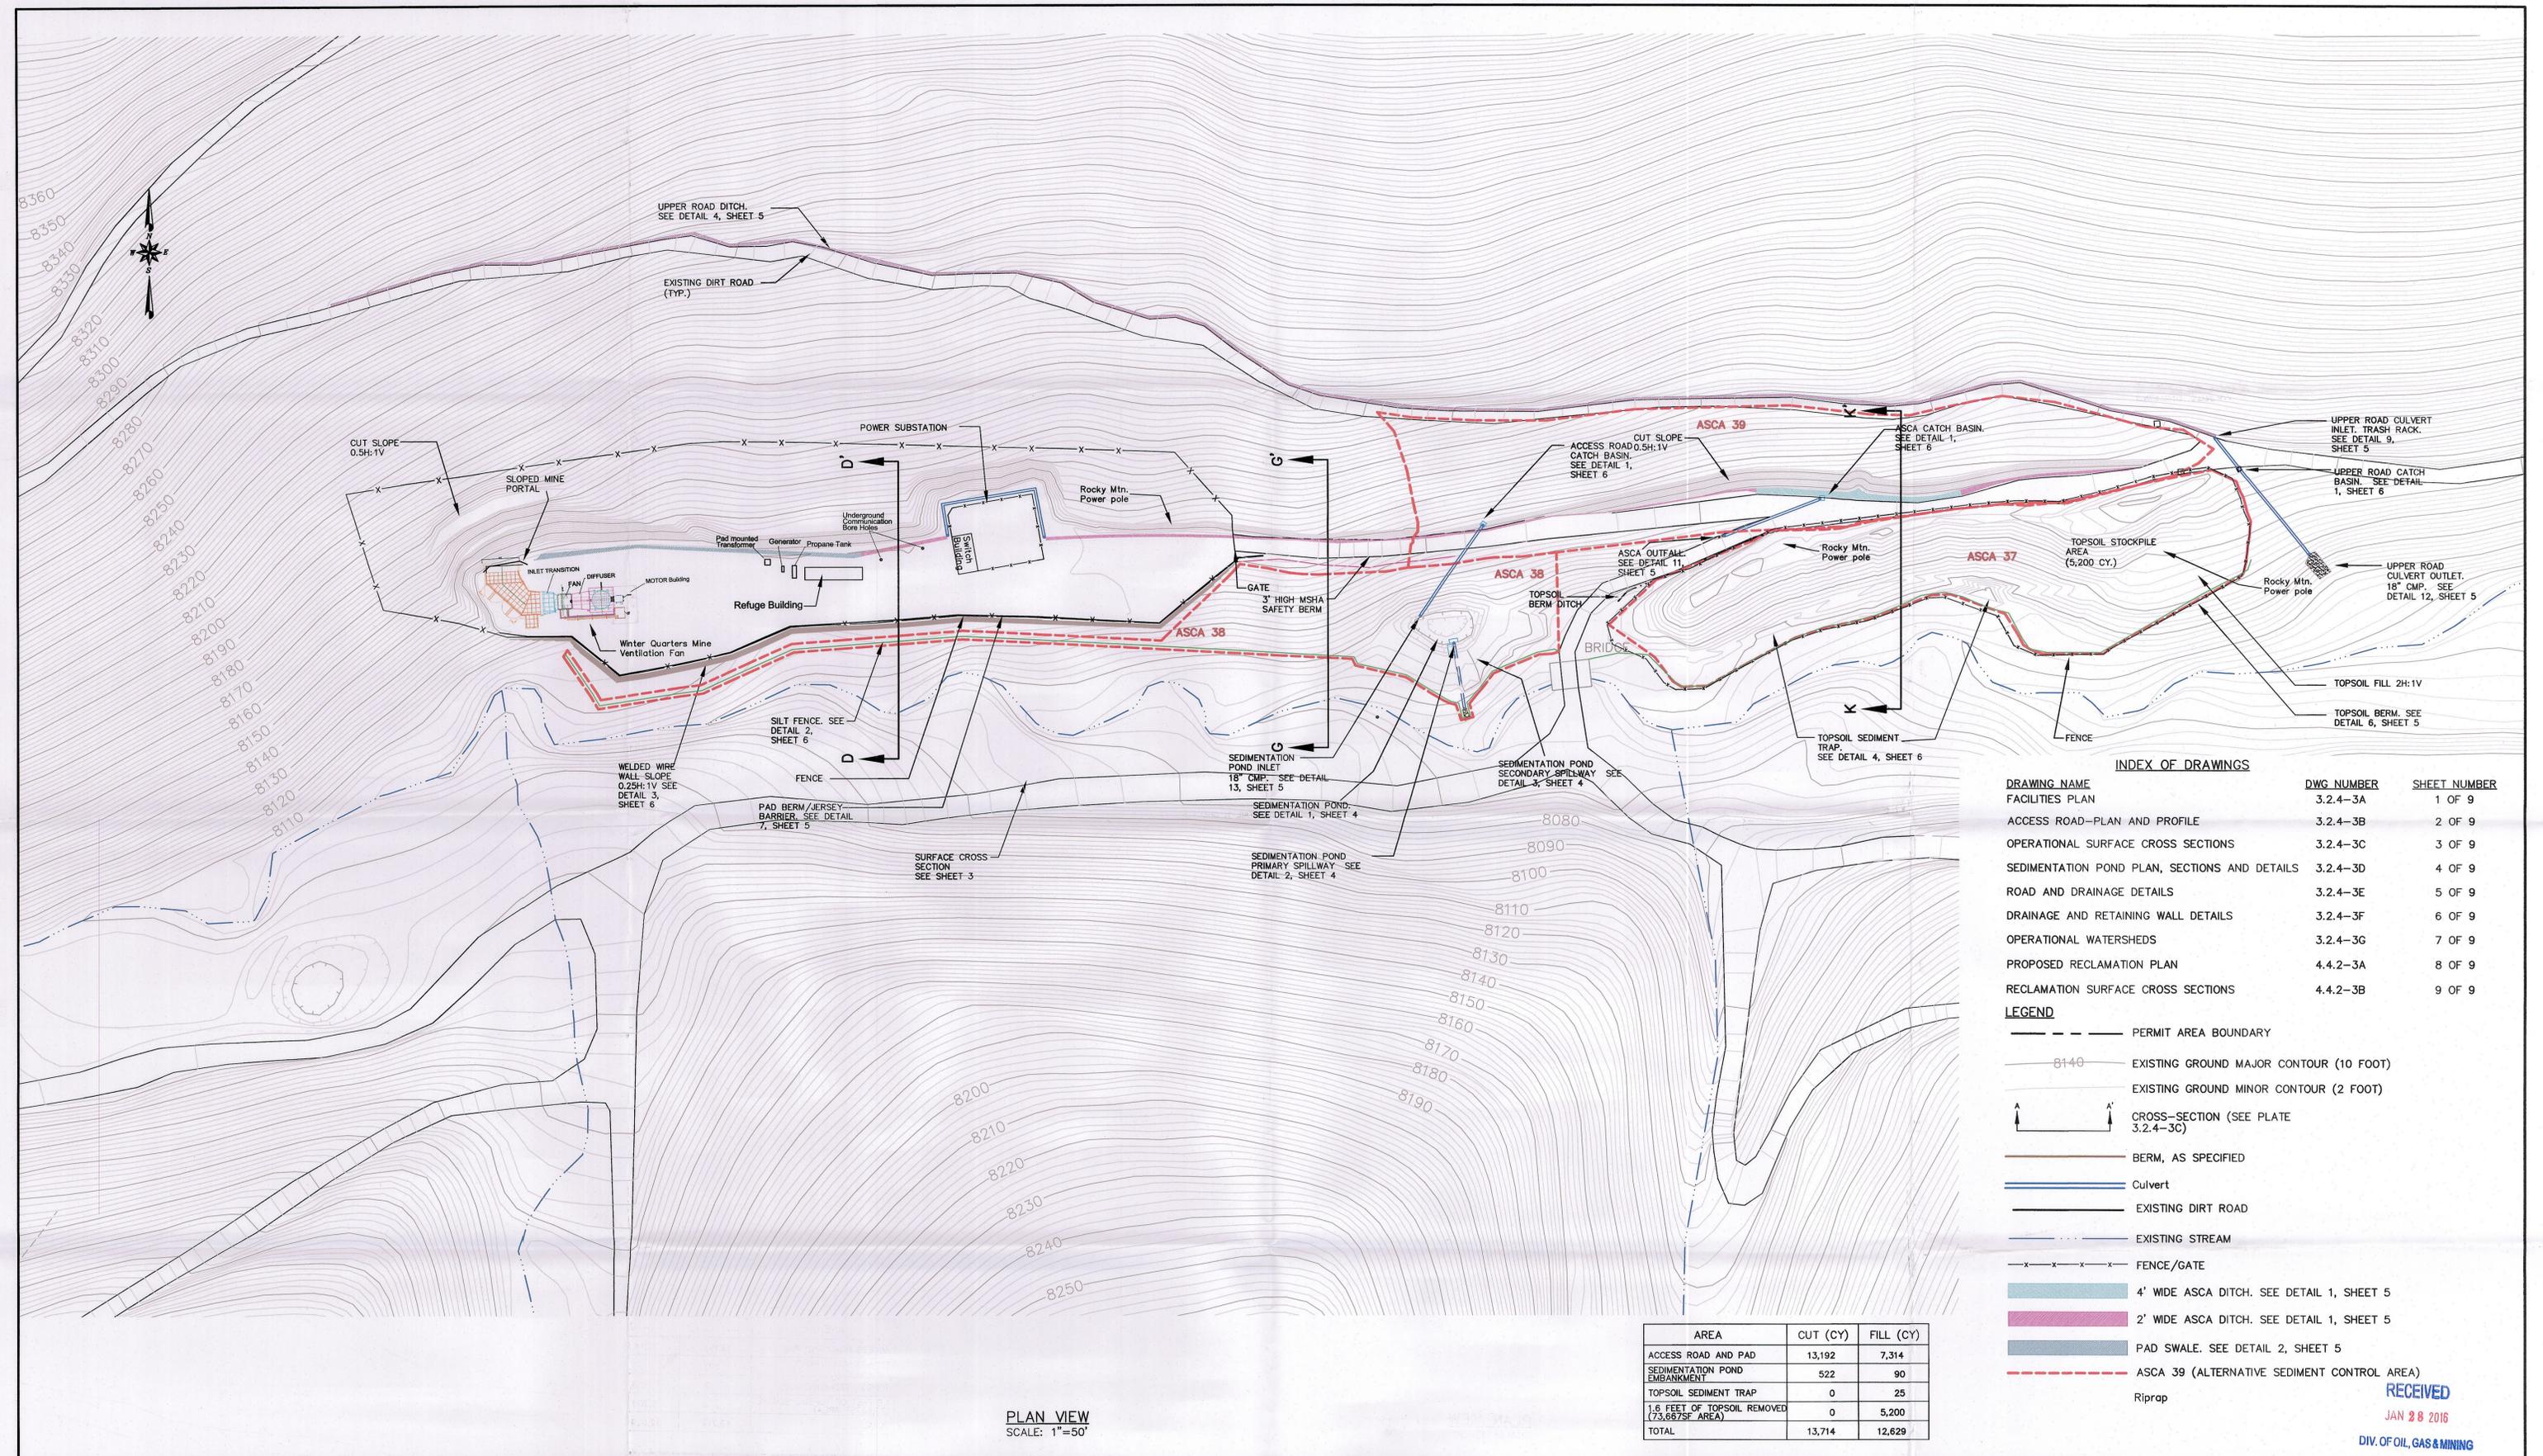

INDEX OF DRAWINGS



DRAWING NAME	DWG NUMBER	SHEET NUMBER
FACILITIES PLAN	3.2.4-3A	1 OF 9
ACCESS ROAD-PLAN AND PROFILE	3.2.4-3B	2 OF 9
OPERATIONAL SURFACE CROSS SECTIONS	3.2.4-3C	3 OF 9
SEDIMENTATION POND PLAN, SECTIONS AND DETAILS	3.2.4-3D	4 OF 9
ROAD AND DRAINAGE DETAILS	3.2.4-3E	5 OF 9
DRAINAGE AND RETAINING WALL DETAILS	3.2.4-3F	6 OF 9
OPERATIONAL WATERSHEDS	3.2.4-3G	7 OF 9
PROPOSED RECLAMATION PLAN	4.4.2-3A	8 OF 9
RECLAMATION SURFACE CROSS SECTIONS	4.4.2-3B	9 OF 9

- LEGEND**
- PERMIT AREA BOUNDARY
 - 8140 --- EXISTING GROUND MAJOR CONTOUR (10 FOOT)
 - EXISTING GROUND MINOR CONTOUR (2 FOOT)
 - ↑ --- CROSS-SECTION (SEE PLATE 3.2.4-3C)
 - BERM, AS SPECIFIED
 - Culvert
 - EXISTING DIRT ROAD
 - EXISTING STREAM
 - x-x-x-x- FENCE/GATE
 - 4' WIDE ASCA DITCH. SEE DETAIL 1, SHEET 5
 - 2' WIDE ASCA DITCH. SEE DETAIL 1, SHEET 5
 - PAD SWALE. SEE DETAIL 2, SHEET 5
 - ASCA 39 (ALTERNATIVE SEDIMENT CONTROL AREA)
 - Riprap

AREA	CUT (CY)	FILL (CY)
ACCESS ROAD AND PAD	13,192	7,314
SEDIMENTATION POND EMBANKMENT	522	90
TOPSOIL SEDIMENT TRAP	0	25
1.6 FEET OF TOPSOIL REMOVED (73,667SF AREA)	0	5,200
TOTAL	13,714	12,629

PLAN VIEW
SCALE: 1"=50'

GENERAL NOTES:

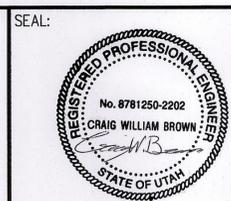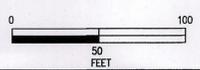

DATE	No.	REVISIONS	Drw	Chk
10-4-11	1	Added Temporary Powder and Cap magazines and temporary construction buildings		
12-21-11	2	Provided As-built modifications		
1-19-16	3	Removed temporary construction buildings and powder and cap Magazines; added finished fan structure, refuge building, propane tank, generator, transformer, and bore holes.	JCA	GAG

**WINTER QUARTERS VENTILATION PAD
FACILITIES AS-BUILT**

RECEIVED
JAN 28 2016
DIV. OF OIL, GAS & MINING

Canyon Fuel Company, LLC
Skyline Mines

P.O. BOX 718 HELPER, UTAH 84528
801-637-7929
DATE: 12/21/11 CK.BY: CWB REVISION: 3
SCALE: AS SHOWN DR.BY: TWE
DWG. NO.: 3.2.4-3A SHEET 1 OF 9 1/19/2016