


SEE MAP 1

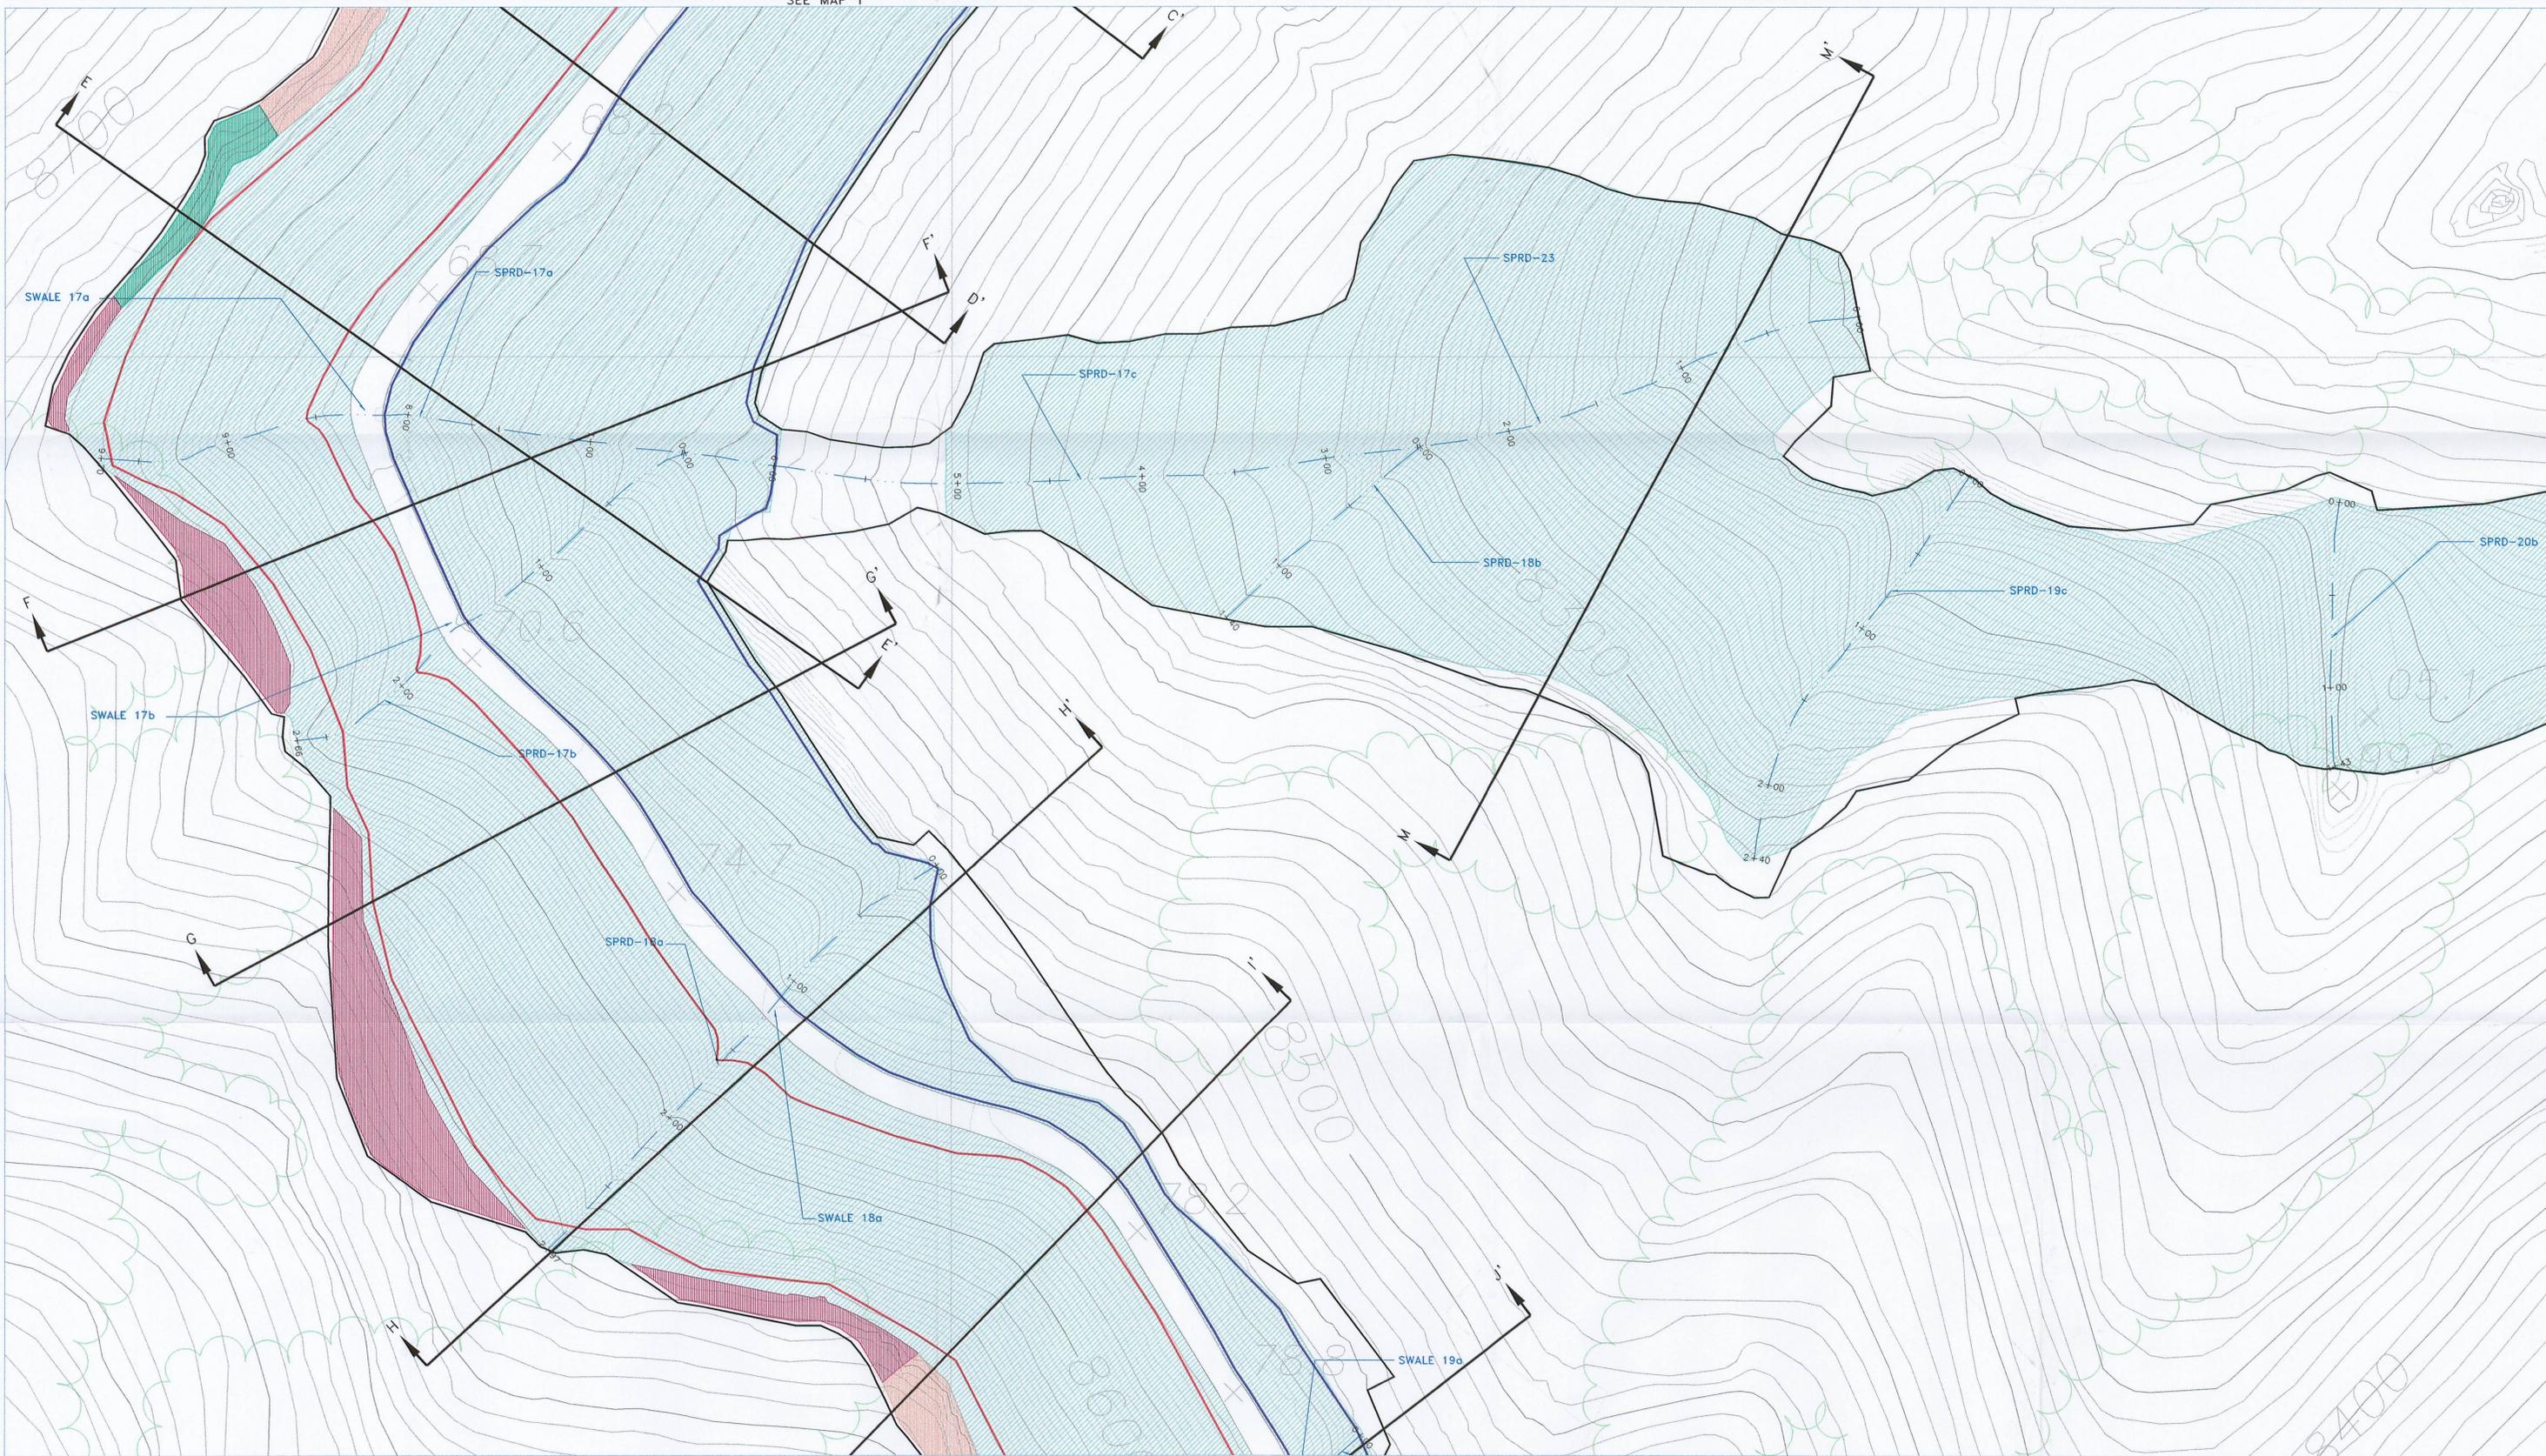


SEE MAP 3

LEGEND

	PRIMARY ROAD		CROSS SECTION
	SECONDARY ROAD		PERMIT BOUNDARY
	TRAIL		SECTION CORNER
	BRIDGE, CULVERT		PARTIALLY BACKFILLED PRE-SMCRA HIGHWALL
	RAILROAD		PARTIALLY BACKFILLED PRE-SMCRA CUTSLOPE
	BUILDINGS, STRUCTURES		PARTIALLY BACKFILLED POST-SMCRA CUTSLOPE
	LAKE, POND		RECLAMATION CHANNEL
	RIVER, STREAM		DEEP GOUGED SURFACE (HAY AND STRAW MULCH) LAST AUGMENTED SEEDING FALL 2002
	FENCE		
	ASBUILT CONTOURS		
	TREE LINES		
	RECLAMATION DISTURBED AREA BOUNDARY		

	SECTION CORNER		AREA OF COAL REFUSE BURIAL. COAL REFUSE BURIED WITH A MIN. OF 4' OF COVER MATERIAL. (APPROX. 113,532 CY HAULED TO THE LION'S DECK)
	AREA PROVIDING COVER MATERIAL FOR COAL REFUSE PLACED ON THE LION'S DECK (APPROX. 14,700 CY WAS USED TO FILL THE STOPE HOLE AND 54,502 CY WAS USED TO COVER THE COAL REFUSE)		

- NOTES:**
- PHASE 1 BOND RELEASE FOR 93.77 ACRES.
 - BACKFILL, GRADING AND GROWTH MEDIA/TOPSOIL PLACEMENT FOR THE MINE #1 AND MINE #2 AREAS BEGAN IN AUGUST, 2001 AND WERE COMPLETED IN DECEMBER, 2001. GROWTH MEDIA/TOPSOIL PLACEMENT OCCURRED CONCURRENTLY WITH BACKFILLING AND GRADING AS AREAS ACHIEVED FINAL GRADE.
 - BACKFILL, GRADING AND GROWTH MEDIA/TOPSOIL PLACEMENT FOR THE LION'S DECK, PONDS 1 AND 2, AND THE LOWER FACILITIES AREAS BEGAN IN APRIL, 2002 AND WERE COMPLETED IN NOVEMBER, 2002. GROWTH MEDIA/TOPSOIL PLACEMENT OCCURRED CONCURRENTLY WITH BACKFILLING AND GRADING AS AREAS ACHIEVED FINAL GRADE.
 - TOWNSHIP 15 SOUTH, RANGE 8 EAST.

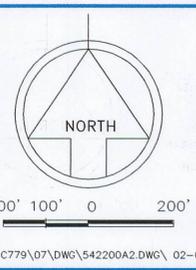

REVISION/HISTORY

BY	DATE	DESCRIPTION
LDJ	05-05-02	RESPOND TO TA
LDJ	10-10-03	AS-BUILT
LDJ	02-05-04	RESPOND TO TA COMMENTS

STARPOINT MINE
ASBUILT TOPOGRAPHY

RECEIVED
JUL 21 2004
DIV. OF OIL, GAS & MINING

PLATEAU MINING CORPORATION
847 NW HIGHWAY 191 HELPER, UTAH 84526
PHONE: (435) 472-0475

MAP 542.200a.2

FILE: G:\UC779\07\DWG\542200A2.DWG\ 02-04-04