



VIA: E-mail

September 9, 2014

Daron Haddock
Utah Division of Oil, Gas & Mining Coal Program
1594 West North Temple, Suite 1210
P.O. Box 145801
Salt Lake City, Utah 84114-5801

RE: A Redlined Application to Revise Sediment Control Methods at the Wellington Site C/007/0012

Dear Mr. Haddock:

Attached please find an amendment to the Wellington Prep Plant's Mining & Reclamation Plan (MRP). C1 and C2 forms have also been included herein.

The bottom line for this amendment is that we would like to have the option to include **erosion control waddles** for sediment control and as a best management practice (BMP). The current plan approves silt fences, straw bales, berms and/or gouges. We would also like to have the option to employ the most appropriate technique using the above erosion control structures in each area depending on local topography, prevailing winds and hydrologic conditions (see the enclosed Drawings F9-177).

Once reviewed the new maps will be appropriately stamped for the final copies to the Division.

Sincerely,

Patrick D. Collins, Ph.D.
Resident Agent

Enclosures

cc: T. Stanley, R. Dial

APPLICATION FOR COAL PERMIT PROCESSING

Permit Change New Permit Renewal Exploration Bond Release Transfer

Permittee: Price River Terminal

Mine: Wellington Prep Plant

Permit Number: C/007/0012

Title: A Redlined Application to Revise Sediment Control Methods at Wellington

Description: Include reason for application and timing required to implement:

Application is due to maintenance issues. We would like to implement the changes on site immediately.

Instructions: If you answer yes to any of the first eight (gray) questions, this application may require Public Notice publication.

- Yes No 1. Change in the size of the Permit Area? Acres: _____ Disturbed Area: _____ increase decrease.
- Yes No 2. Is the application submitted as a result of a Division Order? DO# _____
- Yes No 3. Does the application include operations outside a previously identified Cumulative Hydrologic Impact Area?
- Yes No 4. Does the application include operations in hydrologic basins other than as currently approved?
- Yes No 5. Does the application result from cancellation, reduction or increase of insurance or reclamation bond?
- Yes No 6. Does the application require or include public notice publication?
- Yes No 7. Does the application require or include ownership, control, right-of-entry, or compliance information?
- Yes No 8. Is proposed activity within 100 feet of a public road or cemetery or 300 feet of an occupied dwelling?
- Yes No 9. Is the application submitted as a result of a Violation? NOV # _____
- Yes No 10. Is the application submitted as a result of other laws or regulations or policies?
Explain: _____
- Yes No 11. Does the application affect the surface landowner or change the post mining land use?
- Yes No 12. Does the application require or include underground design or mine sequence and timing? (Modification of R2P2)
- Yes No 13. Does the application require or include collection and reporting of any baseline information?
- Yes No 14. Could the application have any effect on wildlife or vegetation outside the current disturbed area?
- Yes No 15. Does the application require or include soil removal, storage or placement?
- Yes No 16. Does the application require or include vegetation monitoring, removal or revegetation activities?
- Yes No 17. Does the application require or include construction, modification, or removal of surface facilities?
- Yes No 18. Does the application require or include water monitoring, sediment or drainage control measures?
- Yes No 19. Does the application require or include certified designs, maps or calculation?
- Yes No 20. Does the application require or include subsidence control or monitoring?
- Yes No 21. Have reclamation costs for bonding been provided?
- Yes No 22. Does the application involve a perennial stream, a stream buffer zone or discharges to a stream?
- Yes No 23. Does the application affect permits issued by other agencies or permits issued to other entities?

Please attach one (1) review copy of the application.

I hereby certify that I am a responsible official of the applicant and that the information contained in this application is true and correct to the best of my information and belief in all respects with the laws of Utah in reference to commitments, undertakings, and obligations, herein.

PATRICK D. COLLINGS
Print Name

Patrick D. Collings Res. Ag. 9/8/14
Sign Name, Position, Date

Subscribed and sworn to before me this 8 day of Sept., 2014

Marcie S. Clark
Notary Public

My commission Expires: June 21, 2018

Attest: State of Utah } ss:
County of Utah



MARCIE S CLARK
NOTARY PUBLIC-STATE OF UTAH
COMMISSION# 677113
COMM. EXP. 06-21-2018

For Office Use Only:

Assigned Tracking Number:

Received by Oil, Gas & Mining

7.52 SEDIMENT CONTROL MEASURES (R645-301-752)

All sediment control measures except for the Alternative Sediment control Areas (ASCA's) have been addressed previously in Section 7.42. A discussion for the ASCA's follows.

There have been seven areas identified for ASCA's. These areas, numbered ASCA #1 through ASCA #7, are shown on Dwg. F9-177 (rev.). The disturbed acreage and estimated disturbed area runoff from the 10-year, 24-hour storm has been estimates and area shown in Volume II - Hydrology Appendix. These areas are not tributary to a sediment pond. Sediment control from these areas is achieved by berm, silt fences, bales and/or gouges in drainageways, as discussed in the Appendix.

A summary of the total Alternative Sediment Control areas is presented on the following table. The total area of the ASCA's is 80.16 acres which represents about 20% of the total disturbed site within the permit area.

ALTERNATIVE SEDIMENT CONTROL AREAS (ASCA's)			
ASCA #	AREA (acres)	DISTURBED AREA 10-Year 24-Hour Runoff Volume (Acre-Feet)	ALTERNATIVE SEDIMENT CONTROL
1	45.00	2.9	Depression storage and straw bales, silt fences or erosion control waddles.
2	9.41	0.4	Silt fence, straw bales or erosion control waddles.
3	12.64	0.3	Silt fence, straw bales or erosion control waddles.
4	7.80	0.04	Silt fence, erosion control waddles, and/or straw bales.
5	2.47	0.1	Berm and silt fence, straw bales or erosion control waddles.
6	0.35	0.02	Straw bales silt fences or erosion control waddles.
7	2.52	0.24	Berm around topsoils stockpile; remainder of area uses silt fences, straw bales, berms, erosion control waddles, and/or gouges.
TOTAL	80.16	4.00	

A typical installation guide of silt fence and straw bale barrier is provided on the following sheets.

The Operator may also elect to excavate sediment traps at sediment control inlets and/or outlets. The minimum size for the sediment traps, if used by the Operator, shall be 2 feet by 2 feet by 6 inches deep.

Straw bales, silt fences and/or erosion control waddles will be used in within and adjacent to the ASCA's and other areas as shown on the Hydrologic Evaluation Map (F9-177). As a means to control erosion near and around the Siaperas Ditch area at the Wellington site, silt fences, straw bales, erosion control waddles and/or gouges will be used. "Gouging" the ground surface is a method used to control runoff sediments and erosion as well as to harvest water by the creation of small basins resulting in microenvironments that can also be used to enhance revegetation success of reclaimed lands in the semi-arid West. These gouges, or micro-basins, can be created by specially designed heavy equipment, as well as by using more common equipment such as a backhoe or trackhoe. The recommended depth for the micro-basins is 18 to 24 inches, with a recommended width that can be equal to the size of the backhoe bucket (*The Practical Guide to Reclamation*, State of Utah, Division of Oil, Gas & Mining, Salt Lake City, UT).

The gouges will be created at the specifications mentioned above. The finished surface would consist of at least 50% basins, meaning at least half of the surface area will consist of the gouges; their average depths will exceed 18 inches. Taken from the same reference cited above, using a random and overlapping pattern should make it impossible for water to flow downslope with a slope of 1h:1.5v (the Siaperas Ditch area is much less than this slope angle).

Taken from the Western U.S. Precipitation Frequency Maps published in 1973 (NOAA, Atlas 2, HDSC/NWS, Office of Hydrology, Silver Spring, MD) and using the 10-year, 24-hour precipitation event of 1.8 inches, and with an effective basin area of 50% of the total surface area, the depth of water in the micro-basins would be only 3.6 inches (this assumes absolutely no infiltration to the existing soils). Thus, with proper construction of gouges in the area, there would be no runoff at all from this precipitation event. That said, clean-out or reconstruction of the gouges would occur only if the average basin depths were to decrease by natural weathering processes to less than 3.6 inches.

Similarly, using the much larger 100-year, 24-hour precipitation event of 2.6 inches and the same 50% basin area, the depth of water in the depressions would only be 5.2 inches. Using an even more conservative scenario, if the basin area were to make up only 1/3 of the total surface area, the water depth in the gouges would be only 7.8 inches, which is less than half full of their capacity.

REVISED
MAR 29 1996
ENVIRONMENTAL ENGINEERING



MATCH LINE SHEET 2 OF 2

LEGEND	
	— DRAINAGE BASIN BOUNDARY
	- - - PERMIT BOUNDARY
	— CULVERT
	● ALTERNATIVE SEDIMENT CONTROL AREA

I certify that to the best of my knowledge the information contained on this map represents true and accurate conditions as a level consistent with the accuracy of information provided by Castle Valley Resources, Inc. at the time the map was developed.

INCORPORATED EFFECTIVE

FEB 12 1996

UTAH DIVISION OF OIL, GAS AND MINING

BASE MAP PROVIDED BY: OLYMPUS AERIAL SURVEYS, INC. SLC, UTAH
 CONTOUR INTERVAL - 2 FEET
 PHOTOGRAPHY DATE - JUNE 10, 1991

**HANSEN
 ALLEN
 & LUCE**

CONSULTANTS
 ENGINEERS
 Salt Lake City
 Utah



NO.	DATE	BY	REVISIONS
1	NOV. 94	GJP	REVISED ASCA'S IN ACCORDANCE WITH DIRECTIVE TECH-003
2	SEPT 2014	DRB	BALES, ETC * = STRAW BALES, SILT FENCES OR EROSION CONTROL WADDLES
3	SEPT. 1991	GDC	DESIGNED

PDC ECP
 BJB GJP
 BY APVD


SCALE
 1" = 200'



MT. NEBO SCIENTIFIC
 Springville, Utah

CASTLE VALLEY RESOURCES, INC.
 WELLINGTON COAL PREPARATION PLANT
 HYDROLOGIC EVALUATION MAP

DRAWING NO.
 EG-177
 (REV)
 1 OF 2
 93-01-100

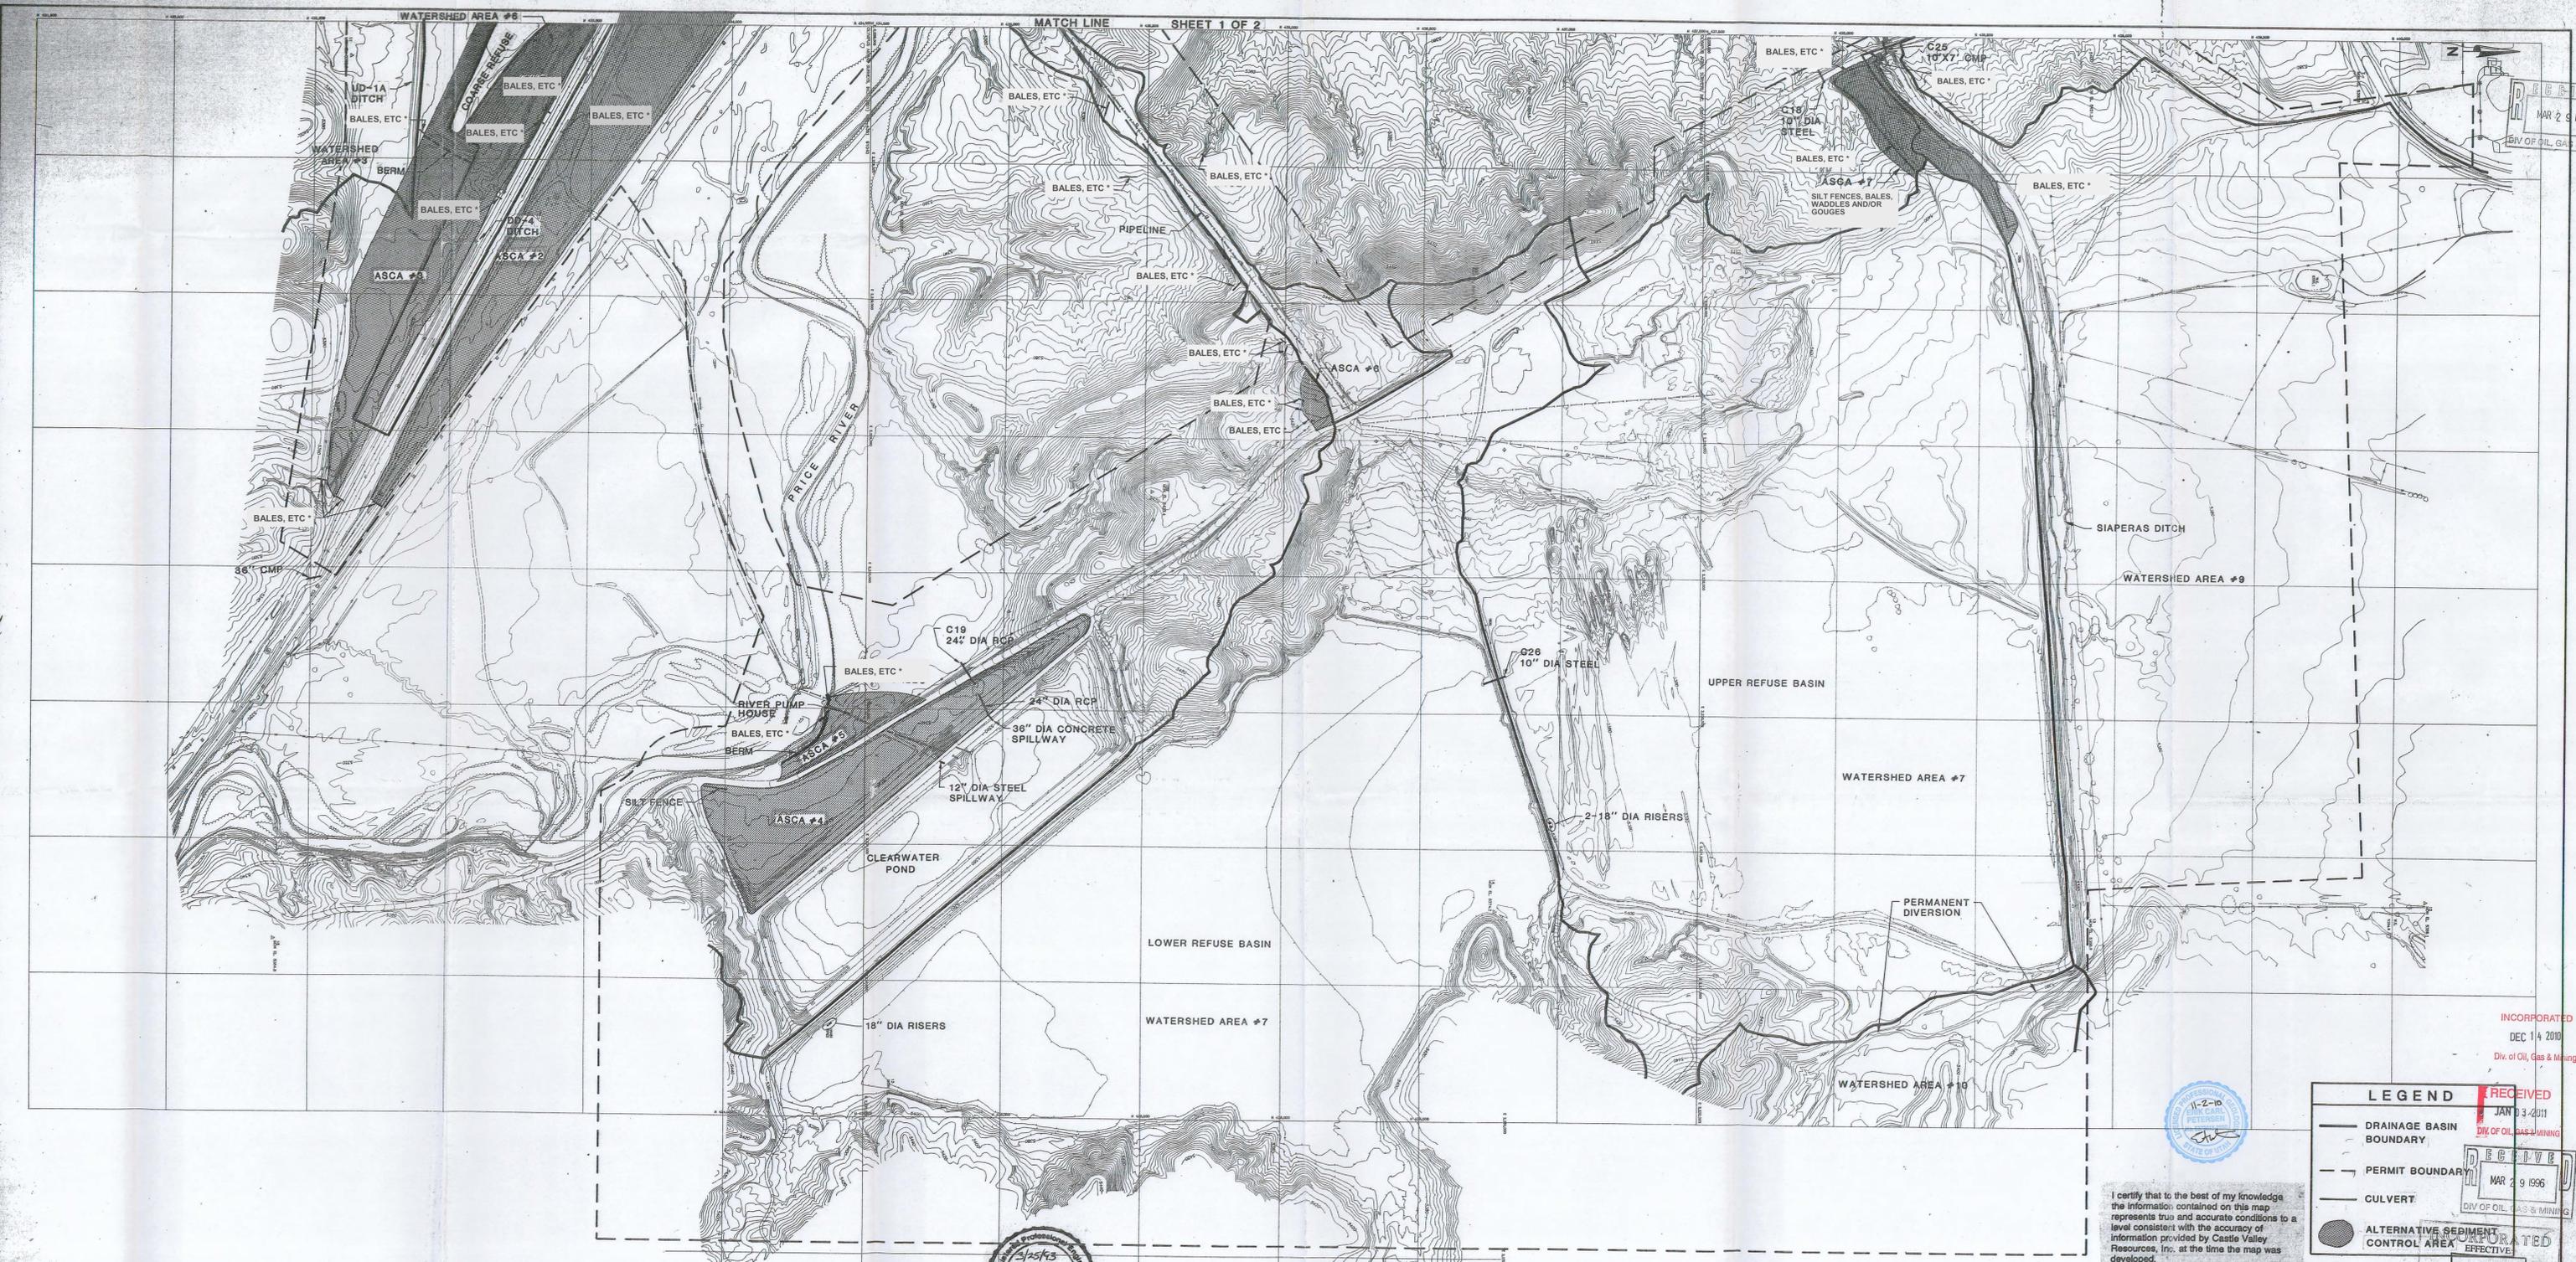

RECEIVED
MAR 29 1996
DIV OF OIL, GAS & MINING

LEGEND

- DRAINAGE BASIN BOUNDARY
- - - PERMIT BOUNDARY
- CULVERT
- ALTERNATIVE SEDIMENT CONTROL AREA

RECEIVED
JAN 03 2011
DIV OF OIL, GAS & MINING

RECEIVED
MAR 29 1996
DIV OF OIL, GAS & MINING

RECEIVED
FEB 12 2011

I certify that to the best of my knowledge the information contained on this map represents true and accurate conditions to a level consistent with the accuracy of information provided by Castle Valley Resources, Inc. at the time the map was developed.

BASE MAP PROVIDED BY: OLYMPUS AERIAL SURVEYS, INC. SLC, UTAH
CONTOUR INTERVAL - 2 FEET
PHOTOGRAPHY DATE - JUNE 10, 1991

HANSEN ALLEN & LUCE
CONSULTANTS ENGINEERS
Salt Lake City Utah

DESIGNED GDC
DRAFTED DRB
CHECKED GJP
DATE SEPT. 1991

NO.	DATE	REVISIONS
1	NOV. 94	REVISED ASCA'S IN ACCORDANCE WITH DIRECTIVE TECH-003
2	SEPT. 2014	BALES, ETC * = STRAW BALES, SILT FENCES OR EROSION CONTROL WADDLES

PDC ECP
BJB GJP
BY APVD.

SCALE
1" = 200'

VERIFY SCALE
BAR IS ONE INCH ON
GRID. DIMENSIONS ON
THIS SHEET SHOULD BE
SCALED ACCORDINGLY.



MT. NEBO SCIENTIFIC
Springville, Utah

CASTLE VALLEY RESOURCES, INC.
WELLINGTON COAL PREPARATION PLANT
HYDROLOGIC EVALUATION MAP

DRAWING NO. 79-177
2 OF 2
93-01-100