

C/007/013 Incoming

794 North "C" Canyon Road, East Carbon, Utah 84520
P. O. Box 910, East Carbon, Utah 84520

Phone: (435) 888-4000

Fax: (435) 888-4002

UtahAmerican Energy, Inc.



#5081

Utah Division of Oil, Gas and Mining
Utah Coal Program
1594 West North Temple, Suite 1210
P.O. Box 145801
Salt Lake City, Utah 84114-5801

February 8, 2016

Attn: Dana Dean
Associate Director – Mining

RECEIVED
FEB 09, 2016
DIV. OF OIL, GAS & MINING

Re: Lila Canyon Mine C/009/013
Incidental Boundary Change for a New Ventilation Breakout
Revise Text and Maps to Remove Part "A" from the MRP

Dear Ms. Dean,

Please find enclosed two (2) clean copies of maps and redlined strikeout text for an Incidental Boundary Change (IBC) application and revisions to the text and maps to remove Part "A" from the MRP to the above-referenced permit. This IBC is needed to allow for a new ventilation breakout to the outcrop just north of the Central Graben Fault, similar to those previously constructed at the Lila Canyon Mine.

We have also reduced the submitted drawings to 11"x17" size, in lieu of the larger size of the previously submitted drawings, so the maps will be easier to handle. Unless noted, the data has not changed between the larger and smaller sheets. We have also surrounded the revisions on each plate with a revision cloud to highlight the location of the IBC and revision to the permit area. Additionally, a USGS topographic map has been underlain below the map data where appropriate for reference purposes.

As you review this application, we ask that you please consider the following points:

1. This IBC would allow for the development of a new ventilation breakout to the coal outcrop for the life of the Lila Canyon Mine just north of the Central Graben Fault. The ventilation breakout will consist of two (2) portals driven from underground. All work will be performed from the underground mine workings, with no surface disturbances other than the openings themselves. Topsoil, berms and sediment control will be handled in a similar fashion to the existing South Breakout.

2. Longwall mining is currently not planned to be associated with this IBC, although the development of the new ventilation breakout is critical to the future longwall mining projected in the general area of the mine.

3. This IBC will add forty (40) acres to the permit area, which is less than 1% of the currently approved 5,992 acres, bringing the new total permit area to 6,032 acres.

4. Development mining for the new ventilation breakout will be performed in less than 700' of cover.

5. The new ventilation breakout will have insignificant surface disturbance, similar to the existing South Breakout, as all work will be performed through the underground mine workings. No surface roads or power lines are required for the breakout.

6. The ventilation breakout is not projected to occur under the nearby ephemeral drainage channels, and will not disturb the nearby Big and Little Stinky Springs. The new Plate 5-2a (IBC Area – Graben Breakout) depicts the projected location of the breakout to the coal outcrop. The actual location of the breakout may vary from the drawing due to geologic conditions that may be encountered during underground mining operations. The breakout is intended to be located as near as practical to the Central Graben Fault. As-built drawings will be provided upon completion of the breakout.

7. All of the surface and coal resources within this IBC are owned by the Bureau of Land Management (BLM), and are currently leased to UtahAmerican Energy, Inc. under Federal Lease #SL-066490. The BLM has recently approved the R2P2 to allow development of the new ventilation breakout.

8. The last aerial raptor survey in 2015 did not note any raptors in the general area of the new breakout. A new survey will be performed in May of this year (2016). The results of this survey will be reported to your office as soon as the data is available.

9. An archeological survey of the area will be performed as soon as weather permits. The results of said survey will be reported to your office as soon as the data is available.

10. The area has been included in the seep and spring surveys as shown in the submitted MRP drawings.

Dana Dean
February 8, 2016
Page 3

Due to the critical nature of these breakouts for the ventilation of the mine, we request an expedited review of this application. At current production rates, we project crossing into this IBC in the third quarter of this year (2016).

If you have any comments or questions, please feel free to contact PJ Jensen by telephone at (435) 888-4018, or by email at pjensen@coalsource.com , or at the address above.

Thank you for your time and attention.

Sincerely,

A handwritten signature in black ink, appearing to read 'Karin Madsen', with a long horizontal flourish extending to the right.

Karin Madsen
Resident Agent

APPLICATION FOR PERMIT PROCESSING

Permit Change X	New Permit <input type="checkbox"/>	Renewal <input type="checkbox"/>	Transfer <input type="checkbox"/>	Exploration <input type="checkbox"/>	Bond Release <input type="checkbox"/>	Permit Number: ACT/007/013
L16-001 Lila Canyon Incidental Boundary Change for New Ventilation Breakout						Mine: Lila Canyon
						Permittee: UtahAmerican Energy, Inc.


Description, include reason for application and timing required to implement:

Instructions: If you answer yes to any of the first 8 questions (gray), submit the application to the Salt Lake Office. Otherwise, you may submit it to your reclamation


<input type="checkbox"/> Yes	<input type="checkbox"/> No	1. Change in the size of the Permit Area? Add <u>40</u> acres Disturbed Area? _____ acres X increase <input type="checkbox"/> decrease.
<input type="checkbox"/> Yes	<input type="checkbox"/> No	2. Is the application submitted as a result of a Division Order? DO # _____
<input type="checkbox"/> Yes	<input type="checkbox"/> No	3. Does application include operations outside a previously identified Cumulative Hydrologic Impact Area?
<input type="checkbox"/> Yes	<input type="checkbox"/> No	4. Does application include operations in hydrologic basins other than as currently approved?
<input type="checkbox"/> Yes	<input type="checkbox"/> No	5. Does application result from cancellation, reduction or increase of insurance or reclamation bond?
<input type="checkbox"/> Yes	<input type="checkbox"/> No	6. Does the application require or include public notice/publication?
<input type="checkbox"/> Yes	<input type="checkbox"/> No	7. Does the application require or include ownership, control, right-of-entry, or compliance information?
<input type="checkbox"/> Yes	<input type="checkbox"/> No	8. Is proposed activity within 100 feet of a public road or cemetery or 300 feet of an occupied dwelling?
<input type="checkbox"/> Yes	<input type="checkbox"/> No	9. Is the application submitted as a result of a Violation? NOV # _____
<input type="checkbox"/> Yes	<input type="checkbox"/> No	10. Is the application submitted as a result of other laws or regulations or policies? Explain: _____
<input type="checkbox"/> Yes	<input type="checkbox"/> No	11. Does the application affect the surface landowner or change the post mining land use?
<input type="checkbox"/> Yes	<input type="checkbox"/> No	12. Does the application require or include underground design or mine sequence and timing? (Modification of R2P2?)
<input type="checkbox"/> Yes	<input type="checkbox"/> No	13. Does the application require or include collection and reporting of any baseline information?
<input type="checkbox"/> Yes	<input type="checkbox"/> No	14. Could the application have any effect on wildlife or vegetation outside the current disturbed area? Insignificant
<input type="checkbox"/> Yes	<input type="checkbox"/> No	15. Does application require or include soil removal, storage or placement? Insignificant
<input type="checkbox"/> Yes	<input type="checkbox"/> No	16. Does the application require or include vegetation monitoring, removal or revegetation activities?
<input type="checkbox"/> Yes	<input type="checkbox"/> No	17. Does the application require or include construction, modification, or removal of surface facilities?
<input type="checkbox"/> Yes	<input type="checkbox"/> No	18. Does the application require or include water monitoring, sediment or drainage control measures?
<input type="checkbox"/> Yes	<input type="checkbox"/> No	19. Does the application require or include certified designs, maps, or calculations?
<input type="checkbox"/> Yes	<input type="checkbox"/> No	20. Does the application require or include subsidence control or monitoring?
<input type="checkbox"/> Yes	<input type="checkbox"/> No	21. Have reclamation costs for bonding been provided for?
<input type="checkbox"/> Yes	<input type="checkbox"/> No	22. Does application involve a perennial stream, a stream buffer zone or discharges to a stream?
<input type="checkbox"/> Yes	<input type="checkbox"/> No	23. Does the application affect permits issued by other agencies or permits issued to other entities?

X Attach 2 complete copies of the application.

I hereby certify that I am a responsible official of the applicant and that the information contained in this application is true and correct to the best of my information and belief in all respects with the laws of Utah in reference to commitments, undertakings, and obligations, herein.

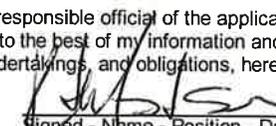
 Signed - Name - Position - Date Karin Madsen / Engineering Tech / 2-8-16

Subscribed and sworn to before me this 8th day of February, 19 2016

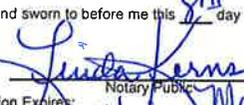
 Notary Public

My Commission Expires: March 27, 19 2017
 Attest: STATE OF Utah COUNTY OF Carbon



Received by Oil, Gas & Mining

RECEIVED

FEB 09 2016

DIV. OF OIL, GAS & MINING

ASSIGNED TRACKING NUMBER

Application for Permit Processing Detailed Schedule of Changes to the MRP

L16-001 Lila Canyon Incidental Boundary Change for New Ventilation Breakout

Permit Number: ACT/007/013

Mine: Lila Canyon

Permittee: UtahAmerican Energy, Inc.

Provide a detailed listing of all changes to the mining and reclamation plan which will be required as a result of this proposed permit application. Individually list all maps and drawings which are to be added, replaced, or removed from the plan. Include changes of the table of contents, section of the plan, pages, or other information as needed to specifically locate, identify and revise the existing mining and reclamation plan. **Include page, section and drawing numbers as part of the description.**

			DESCRIPTION OF MAP, TEXT, OR MATERIALS TO BE CHANGED
<input type="checkbox"/> ADD	<input type="checkbox"/> REPLACE	<input type="checkbox"/> REMOVE	Plates 1 through 41 have been revised, and replaced with the following: Plate 1-1 Permit Area Map Revised Plate 2-1 Soils Map Revised Plate 3-1A Wildlife Habitat: Raptors (Confidential) Revised Plate 3-1B Wildlife Habitat: Big Horn Sheep / Antelope Revised Plate 3-1C Wildlife Habitat: Elk Revised Plate 3-1D Wildlife Habitat: Mule Deer Revised Plate 3-2 Vegetation Map Revised Plate 4-1 Surface Ownership Revised Plate 4-2 Grazing Allotments Revised Plate 4-3 Cultural Resources (Confidential) Revised Plate 4-4 Area of Wilderness Character Revised Plate 5-1 Previously Mined Areas Revised Plate 5-2a IBC Area - Graben Breakout New Plate 5-3 (Confidential) Subsidence Control Map (Confidential) Revised Plate 5-3 Subsidence Control Map Revised Plate 5-4 Coal Ownership Revised Plate 5-5 Mine Map Revised Plate 6-1 Project Area Geologic Map Revised Plate 6-2 General Geology Revised Plate 6-3 Coal Thickness Isopachs Revised Plate 6-4 Cover and Structure Map Revised Plate 6-5 Coal Sections Revised Plate 7-1 Permit Area Hydrology Revised Plate 7-1A Permit Area Hydrology with Geologic Map Revised Plate 7-3 Water Rights Revised Plate 7-4 Water Monitoring Locations Revised
<input type="checkbox"/> ADD	<input type="checkbox"/> REPLACE	<input type="checkbox"/> REMOVE	Chapter 1 page 15
<input type="checkbox"/> ADD	<input type="checkbox"/> REPLACE	<input type="checkbox"/> REMOVE	Chapter 5 pages 19, 20, 22, 33, 46, and 65
<input type="checkbox"/> ADD	<input type="checkbox"/> REPLACE	<input type="checkbox"/> REMOVE	Chapter 7 pages 5, and 12
<input type="checkbox"/> ADD	<input type="checkbox"/> REPLACE	<input type="checkbox"/> REMOVE	

Any other specific or special instructions required for insertion of this proposal into the Mining and Reclamation Plan?

RECEIVED

FEB 09 2016

DIV. OF OIL, GAS & MINING

LILA CANYON MINE

009/013

CHANGE TO THE MINING AND RECLAMATION PLAN

INCIDENTAL BOUNDARY CHANGE (40 ACRES)

TO ALLOW THE DEVELOPMENT OF A NEW VENTILATION BREAKOUT

NOTES TO REVIEWERS:

1. UNDER THIS APPLICATION, NO MINING IS PROJECTED TO BE UNDER NEARBY EPHEMERAL CHANNELS.
2. UNDER THIS APPLICATION, SURFACE DISTURBANCE WILL BE INSIGNIFICANT (SIMILAR TO THE EXISTING SOUTH BREAKOUT).
3. UNDER THIS APPLICATION, DEVELOPMENT MINING ONLY IS PROJECTED IN THE IBC AREA.

SUBMITTED: FEBRUARY 8, 2016

RECEIVED

FEB 09 2016

DIV. OF OIL, GAS & MINING

Chapter 1

Revisions

- 141.** Maps have been presented in a consolidated format, to the extent possible, and include all the types of information that are set forth on U.S. Geological Survey of the 1:24,000 scale series. Maps of the permit area are to the scale of 1:6,000 or larger. Maps of the adjacent area will clearly show the lands and waters within those areas.
- 142.** Maps and plans submitted with the permit application distinguish among each of the phases during which coal mining and reclamation operations were or will be conducted at any place within the life of operations.

150. Completeness

This permit extension to the existing Horse Canyon Permit ACT/007-013 to conduct coal mining and reclamation operations is complete and includes the minimum information required under R645-301 and, if applicable, R645-302. Plates 1-1 and 1-2 show the permittee area and proposed disturbed area boundaries.

~~This permit extension is intended to add the Lila Canyon Mine as part "B" to the existing permit and to leave unchanged the current approved Horse Canyon Mine as part "A". The Horse Canyon Mine "part A" is for reclamation only.~~

141. Maps have been presented in a consolidated format, to the extent possible, and include all the types of information that are set forth on U.S. Geological Survey of the 1:24,000 scale series. Maps of the permit area are to the scale of 1:6,000 or larger. Maps of the adjacent area will clearly show the lands and waters within those areas.
142. Maps and plans submitted with the permit application distinguish among each of the phases during which coal mining and reclamation operations were or will be conducted at any place within the life of operations.

150. Completeness

This permit extension to the existing Horse Canyon Permit ACT/007-013 to conduct coal mining and reclamation operations is complete and includes the minimum information required under R645-301 and, if applicable, R645-302. Plates 1-1 and 1-2 show the permittee area and proposed disturbed area boundaries.

Chapter 5

Revisions

Powder and cap magazines will be mobile temporary, and supplied by the explosive distributor. Upon reclamation the powder and cap magazines will be returned to the distributor.

As per the approved Air Quality Order all roads will be paved and the pad areas used by mobile equipment will be treated with water or dust suppressant, open stockpiles will be watered as conditions warrant.

521. Included in this section are maps, cross sections, narratives, descriptions and calculations used to satisfy the relevant requirements. This section describes and identifies the lands subject to coal mining and reclamation operations covering the estimated life of the project.

521.100 This application includes the cross sections, maps and plans needed to present the relevant information required by the Division. This information includes the following:

521.110. Plate 5-1 Shows area previously mined and approximate dates of mining.

521.111 Plate 5-1 of part "B" and 2-2 of part "A" shows the location and extent of known workings of inactive, or abandoned underground mines. The surface portals or mine openings to the surface are shown. Plates 5-1 and 2-2 of part "A" have been prepared and certified by or under the direction of a registered professional engineer.

Doelling lists several coal mines and mining activity in within or adjacent to the permit area. Doelling lists the Calkins prospect, the Lila Canyon prospect, and the Prentiss prospect. In addition Doelling lists several coal mines Prentiss, Utah Blue Diamond, Blue Diamond and Heiner Mines. The research has shown that the Prentiss, Utah Blue Diamond, Blue Diamond and Heiner Mines were engulfed by the Book Cliffs mine. The Lila Canyon prospect refers to the old Lila Canyon mine fan portals used to ventilate the Geneva (Horse Canyon mine). The Calkins prospect is believed to have been engulfed by the Geneva mine.

An outcrop fire has been detected in an area north of the exiting permit area "A". The fire is off the permit area and located in an area that has been sealed from the old horse canyon works. The outcrop fire is not anticipated to cause any problems with mining at the Lila Canyon Mine.

- 521.112** No surface mined areas are found within the permit area. Therefore, this section does not apply.
- 521.120** Three existing structures, a 48" and a 60" CMP culvert located near the new proposed sediment pond, and the Little Park Road can be found at the Lila Canyon Mine. The existing culverts are shown on plate 5-1A and the road on Plate 5-1. ~~Existing Horse Canyon facilities are discussed in part "A" of this plan.~~
- 521.121** There are no buildings within 1000 feet of the proposed permit area for except those used as part of the Lila Canyon Mine, Part "B" mining operation.
- 521.122** There are no subsurface man-made features, other than the culverts discussed in 521.200, within, passing through, or passing over the proposed permit area ~~for Part "B".~~
- 521.123** Plate 4-1, as well as others, shows the existing county road 126 which is located partly within 100 feet of the proposed permit area. In Addition, the Little Park road is located above the surface facilities within the permit area. The Little Park road is also shown on plate 4-1
- 521.124** There are no known existing areas of spoil, waste, coal development waste, or non-coal waste disposal, dams, embankments, other impoundments, and water treatment and air pollution control facilities within part "B" of the proposed permit area. This section is not Applicable except those used as part of the mining operation.

rock is shown on Plate 5-2 as well as other appropriate plates.

521.150 Plates 6-2, 6-3, and 6-4, show surface contours that represent the existing land surface configuration of the proposed permit area.

521.151 The Plates show the surface contours for all areas to be disturbed as well as over the total permit area. The Plates showing the surface contours has been prepared by or under the supervision of a registered engineer.

521.152 No previously mined areas are included ~~within Part "B". Therefore this~~ This section does not apply.

521.160 The maps, plates, and cross sections associated with this chapter clearly show:

521.161 Proposed buildings, utility corridors, and facilities are shown on Plate 5-2 as well as others.

521.162 Area of land affected according to the sequence of mining and reclamation is shown on the appropriate plates.

521.163 Land for which a performance bond will be posted is shown on the appropriate plate. Plate 5-2 as well as others show the area for which the performance bond will be posted. All disturbed areas within the permit boundary has been bonded.

521.164 Coal storage and loading areas are shown on Plate 5-2 and certified as required. Additional information can be found in Appendix 5-4.

521.165 Topsoil, and waste piles are shown on Plate 5-2 as well as others.

521.166 The waste disposal areas are shown for non-coal waste and underground mine waste on Plate 5-2.

525.110 Plate 5-3 shows the location of State appropriated water and 5-3 (Confidential) shows the eagle nests that potentially could be diminished or interrupted by subsidence.

525.120 SUBSIDENCE POTENTIAL (See also Section 5.4 of Part "A")

A review of renewable resources in and adjacent to the permit area found resources consisting of ground water, grazing, timber, and recharge areas. Subsidence from underground coal mines has been believed to affect overlying forest and grazing resource lands in the following ways:

- o Formation of surface fissures which intercept near surface soil moisture thus draining the water away from the root zone with deleterious effects.
- o Alterations in ground slope and destabilization of critical slopes and cliffs.
- o Modification of surface hydrology due to the general downward migration of surface water through vertical fractures.
- o Modification of groundwater hydrology including connection of previously separated aquifers, reduction in flows of seeps and springs which rely upon tight aquitards for their flow, and changes in recharge mechanisms.
- o Emissions of methane originating from the coal seam through open fissures to the surface or at least the base of the surficial soil which has been known to have deleterious effects on woody plants.

Because these renewable resources exist with and adjacent to the permit area, a subsidence control plan is required. This plan is presented in Section 525.400.

A great deal of baseline data is available from many mining settings to develop subsidence damage criteria for surface structures (Bhattacharya et al. 1984). The formation of cracks and fissures are the general effects of subsidence and can have minor deleterious effects on groundwater resources without any fissuring to the surface. In the arid areas of Utah,

in Chapter 7 Section 731.211. UEI has committed to provide for mitigation of any lost water rights as per Chapter 7 Section 727.

525.490. Other information specified by the Division as necessary to demonstrate that the operation will be conducted in accordance with R645-301-525.300 will be provided.

525.500. Repair of damage.

525.510. If effects of subsidence are confirmed, any material damage to the surface lands will be restored to the extent technologically and economically feasible. The land will be restored to a condition capable of maintaining the value and reasonable foreseeable uses which it was capable of supporting before the subsidence.

525.520. Since no structures exist within or adjacent to the permit area which could be damaged by subsidence, should it occur, this section does not apply.

525.530. The Little Park Road exists in the subsidence zone. In the unlikely event the road is damaged by subsidence, UEI will repair the damage as per Section 525.120.

525.600. Public Notice.

At least six months prior to mining, or within that period if approved by the Division, the underground mine operator will mail a notification to all owners and occupants of surface property and structures above the underground workings. The notification will include, at a minimum, identification of specific areas in which mining will take place, dates that specific areas will be undermined, and the location or locations where the operator's subsidence control plan may be examined.

526. A narrative explaining the construction, modification, use, maintenance and removal of the mine facilities follows. Additional information can be found in Appendix 5-4 and Chapter 8.

526.100 Mine Structures and Facilities.

526.110 The only existing structures are found in Horse Canyon (~~Part "A" of this permit~~) and are the remains of the

“pock-marked” to minimize the potential for erosion as well as enhance revegetation establishment. It is not anticipated that soil will be disturbed in areas to steep for equipment to operate.

553.240 The structural fill area will have slopes of less than 8% upon final recontouring and revegetated to enhance the post mining land use of grazing and wildlife habitat.

553.250 A need for a refuse pile at Lila Canyon is not anticipated.

553.260 The operator will commit to all applicable R645 regulations relative to disposal of coal processing waste.

553.300 All underground development waste brought to the surface will be placed in the temporary rock pile and then blended back into the ROM product for sale. There will be no coal processing waste generated on the surface. Any oversized from the screens will be crushed and put back into the ROM stream.

553.400 Cut-and-fill terraces may be allowed by the Division

553.410 No cut and fill terraces will be required.

553.420 No terraces will be required for post mining land use.

553.500-540 and 553.600-553.650.500

The only area that falls under these provisions are the reclaimed Horse Canyon mine which lies in the north west portion of the lease area and is addressed under approved MRP Act #0013-(Part “A”).

553.700-553.900

This operation will only involve underground mining and as such the above referenced regulations do not apply.

560. Performance Standards. Coal mining and reclamation operations will be

Powder and cap magazines will be mobile temporary, and supplied by the explosive distributor. Upon reclamation the powder and cap magazines will be returned to the distributor.

As per the approved Air Quality Order all roads will be paved and the pad areas used by mobile equipment will be treated with water or dust suppressant, open stockpiles will be watered as conditions warrant.

521. Included in this section are maps, cross sections, narratives, descriptions and calculations used to satisfy the relevant requirements. This section describes and identifies the lands subject to coal mining and reclamation operations covering the estimated life of the project.

521.100 This application includes the cross sections, maps and plans needed to present the relevant information required by the Division. This information includes the following:

521.110. Plate 5-1 Shows area previously mined and approximate dates of mining.

521.111 Plate 5-1 and 2-2 shows the location and extent of known workings of inactive, or abandoned underground mines. The surface portals or mine openings to the surface are shown. Plates 5-1 and 2-2 have been prepared and certified by or under the direction of a registered professional engineer.

Doelling lists several coal mines and mining activity in within or adjacent to the permit area. Doelling lists the Calkins prospect, the Lila Canyon prospect, and the Prentiss prospect. In addition Doelling lists several coal mines Prentiss, Utah Blue Diamond, Blue Diamond and Heiner Mines. The research has shown that the Prentiss, Utah Blue Diamond, Blue Diamond and Heiner Mines were engulfed by the Book Cliffs mine. The Lila Canyon prospect refers to the old Lila Canyon mine fan portals used to ventilate the Geneva (Horse Canyon mine. The Calkins prospect is believed to have been engulfed by the Geneva mine.

An outcrop fire has been detected in an area north of the exiting permit area "A". The fire is off the permit area and located in an area that has been sealed from the old horse canyon works. The outcrop fire is not anticipated to cause any problems with mining at the Lila Canyon Mine.

521.112 No surface mined areas are found within the permit area. Therefore, this section does not apply.

521.120 Three existing structures, a 48" and a 60" CMP culvert located near the new proposed sediment pond, and the Little Park Road can be found at the Lila Canyon Mine. The existing culverts are shown on plate 5-1A and the road on Plate 5-1.

521.121 There are no buildings within 1000 feet of the proposed permit area except those used as part of the Lila Canyon mining operation.

521.122 There are no subsurface man-made features, other than the culverts discussed in 521.200, within, passing through, or passing over the proposed permit area.

521.123 Plate 4-1, as well as others, shows the existing county road 126 which is located partly within 100 feet of the proposed permit area. In Addition, the Little Park road is located above the surface facilities within the permit area. The Little Park road is also shown on plate 4-1

521.124 There are no known existing areas of spoil, waste, coal development waste, or non-coal waste disposal, dams, embankments, other impoundments, and water treatment and air pollution control facilities except those used as part of the mining operation.

521.125 There are no existing sedimentation ponds, permanent water impoundment, coal processing waste banks or coal processing waste dams near or within the permit area.

proposed permit area.

- 521.151** The Plates show the surface contours for all areas to be disturbed as well as over the total permit area. The Plates showing the surface contours has been prepared by or under the supervision of a registered engineer.
- 521.152** No previously mined areas are included. This section does not apply.
- 521.160** The maps, plates, and cross sections associated with this chapter clearly show:
- 521.161** Proposed buildings, utility corridors, and facilities are shown on Plate 5-2 as well as others.
- 521.162** Area of land affected according to the sequence of mining and reclamation is shown on the appropriate plates.
- 521.163** Land for which a performance bond will be posted is shown on the appropriate plate. Plate 5-2 as well as others show the area for which the performance bond will be posted. All disturbed areas within the permit boundary has been bonded.
- 521.164** Coal storage and loading areas are shown on Plate 5-2 and certified as required. Additional information can be found in Appendix 5-4.
- 521.165** Topsoil, and waste piles are shown on Plate 5-2 as well as others.
- 521.166** The waste disposal areas are shown for non-coal waste and underground mine waste on Plate 5-2.
- 521.167** No explosives are expected to be stored on site. However, if explosives are stored they will be stored as discussed in Section 520. on Plate 5-2.
- 521.168** Since Lila Canyon mine is an underground operation this paragraph is not applicable.

- 524.745** The total weight of the explosives used per hole will be recorded on the blasting record.
- 524.746** The maximum weight of explosives detonated in an eight-millisecond period will be recorded on the blasting record.
- 524.747** Information on the initiation system will be recorded on the blasting record.
- 524.748** The type and length of the stemming will be recorded on the blasting record.
- 524.749** Mats or other protections used will be recorded on the blasting record.
- 524.750** Since all structures are either owned by the permittee and not leased to another person or are located over six miles distance from the permit area a record of seismographic and airblast information is not required.
- 524.760** Since a blasting schedule is not required this section does not apply.
- 524.800** The operator will comply with the various appropriate State and Federal laws and regulations in the use of explosives.
- 525. Subsidence:** The permittee will comply with the appropriate R645-301-525 requirements.
- 525.100 Subsidence Control Plan**
- 525.110** Plate 5-3 shows the location of State appropriated water and 5-3 (Confidential) shows the eagle nests that potentially could be diminished or interrupted by subsidence.
- 525.120 SUBSIDENCE POTENTIAL**
A review of renewable resources in and adjacent to the permit area found resources consisting of ground water, grazing, timber, and recharge areas. Subsidence from underground coal mines has been believed to affect overlying forest and grazing

in Chapter 7 Section 731.211. UEI has committed to provide for mitigation of any lost water rights as per Chapter 7 Section 727.

525.490. Other information specified by the Division as necessary to demonstrate that the operation will be conducted in accordance with R645-301-525.300 will be provided.

525.500. Repair of damage.

525.510. If effects of subsidence are confirmed, any material damage to the surface lands will be restored to the extent technologically and economically feasible. The land will be restored to a condition capable of maintaining the value and reasonable foreseeable uses which it was capable of supporting before the subsidence.

525.520. Since no structures exist within or adjacent to the permit area which could be damaged by subsidence, should it occur, this section does not apply.

525.530. The Little Park Road exists in the subsidence zone. In the unlikely event the road is damaged by subsidence, UEI will repair the damage as per Section 525.120.

525.600. Public Notice.

At least six months prior to mining, or within that period if approved by the Division, the underground mine operator will mail a notification to all owners and occupants of surface property and structures above the underground workings. The notification will include, at a minimum, identification of specific areas in which mining will take place, dates that specific areas will be undermined, and the location or locations where the operator's subsidence control plan may be examined.

526. A narrative explaining the construction, modification, use, maintenance and removal of the mine facilities follows. Additional information can be found in Appendix 5-4 and Chapter 8.

526.100 Mine Structures and Facilities.

526.110 The only existing structures are found in Horse Canyon and are the remains of the United States Steel

as well as enhance revegetation establishment. It is not anticipated that soil will be disturbed in areas to steep for equipment to operate.

553.240 The structural fill area will have slopes of less than 8% upon final recontouring and revegetated to enhance the post mining land use of grazing and wildlife habitat.

553.250 A need for a refuse pile at Lila Canyon is not anticipated.

553.260 The operator will commit to all applicable R645 regulations relative to disposal of coal processing waste.

553.300 All underground development waste brought to the surface will be placed in the temporary rock pile and then blended back into the ROM product for sale. There will be no coal processing waste generated on the surface. Any oversized from the screens will be crushed and put back into the ROM stream.

553.400 Cut-and-fill terraces may be allowed by the Division

553.410 No cut and fill terraces will be required.

553.420 No terraces will be required for post mining land use.

553.500-540 and 553.600-553.650.500

The only area that falls under these provisions are the reclaimed Horse Canyon mine which lies in the north west portion of the lease area and is addressed under approved MRP Act #0013.

553.700-553.900

This operation will only involve underground mining and as such the above referenced regulations do not apply.

560. Performance Standards. Coal mining and reclamation operations will be conducted in accordance with the approved permit and requirements of R645-301-510 through R645-301-553.

Chapter 7

Revisions

adjacent areas. The location of the sampling points are presented on Plates 7-1 and 7-1A.

History of Data Collection. The U.S. Geological Survey conducted a water quality study in Horse Canyon from August 1978 until September 1979 during the time that U.S. Steel operated the mine. Samples were taken monthly from the Horse Canyon Creek and analyzed for most major ions and cations and field parameters. Metals, eight nitrogen species and other minor chemical constituents were taken on a quarterly basis or less.

Between January 1981 and April 1983, baseline water quality data was collected for four surface water/spring sites B-1, HC-1, RF-1 and RS-2, and 3 UPDES Discharge Points, 001 (Mine Discharge), 002 (Mine Discharge) and 003 (Sewer Plant), on the Horse Canyon permit area. Between 14 and 19 samples were taken and analyzed during the monitoring period depending on the site. The parameters that were analyzed were derived from Section 783.16 in the regulations. DOGM monitoring guidelines were not in force at that time.

Two other sites, RS-1, and RS-2, were sampled once a year during 1978, 1979, and 1980 and analyzed for most major chemical constituents. In addition, springs H-1, H-6, H-18, and H-21 were sampled once by JBR and analyzed for the major constituents in 1985. Third quarter data for 1989 were collected for B-1, HC-1, RF-1, and RS-2 and sampled for most of the parameters in DOGM's guidelines.

Sample sites B-1, HC-1, RF-1 and RS-2, along with the UPDES Discharge Points 001A and 001B, have been monitored quarterly since 1989 in accordance with the approved water monitoring plan for the Horse Canyon Mine (Part A). The results of this monitoring have been submitted to the Division each year with the Annual Report and or have been entered into the Divisions electronic data base.

Baseline monitoring was also conducted on the proposed Lila Canyon Mine extension area by Earthfax Engineering in 1993-1995. Some 60 sites were identified and monitored. This data is presented in Appendix 7-1.

The operational water monitoring program committed to the permit application was implemented in July, 2000. Data will be collected from new monitoring sites L-1-S through L-4-S. L-5-G has yet to be installed. These sites are typically dry and no quality data has been gathered as yet. Sites L-6-G through L-10-G have been monitored for baseline in 1993, 1994, and 1995. These sites, along with piezometers IPA-1, IPA-2 and IPA-3, were

Geneva exploration entries driven south from the Horse Canyon Mine into the proposed Lila Canyon mining area do contain water since the tunnels elevation is approximately 5855 feet.

The Horse Canyon Mine has been closed and the surface area reclaimed. With no significant inflow to the old workings, no discharges are occurring from any of the portal areas nor are expected in the future. It is known however, that water has collected in the old entries. As future mining activities, for the proposed Lila Canyon Mine, will be occurring near this area of collected water in the old exploration entry workings, it is likely that some of this water will be intercepted by the proposed Lila Canyon Mine (see Plate 7-1). Water may then have to be pumped from the mine. Because of undulating floor and unknown void areas, it is impossible to determine the amount of water that would be pumped. The rate of pumping, if any, would be determined by the water discharge system design. All water discharged from the mine would be discharged at UPDES Site # 002A which is Site L-5-G, and will meet all UPDES standards. DOGM has specified planning to include a mine discharge of 500 gpm maximum.

An inspection of the Horse Canyon area following mining has shown no diminution of reasonably foreseeable use of aquifers. Since mining ceased in 1983, subsidence should have occurred within two years. However, no deterioration of the aquifers in the area was identified. Mining has not yet begun on the Lila Canyon site; however, since the structure and groundwater regime is similar to the Horse Canyon area, no diminution or deterioration of groundwater resources is expected in this area.

As the mining in the Lila Canyon Mine will be from the same seam and the adjacent strata are the same and the over and underburden are the same, occurrences of ground water in the Lila Canyon Mine are expected to be similar to the Geneva Mine (Horse Canyon). The water quality is expected to be the same as the water encounter in the Horse Canyon Mine. Samples taken underground from the Horse Canyon Mine (MRP part "A" Appendix VI-1) to the north of the Lila Canyon Mine and from well S-32 (MRP part "B" Appendix 7-1) by Kalsner to the south of the Lila Canyon Mine show the water from the level of the coal seam to be a calcium, sodium-sulfate type water. Therefore, it is likely that the water from the strata between these two points from the same strata will be very similar.

Inflows of water encountered while mining are expected to reduce to seeps or dry up in a short period of time. If a significant water inflow is encountered, the water, which is not needed for underground operations, will be collected, treated as necessary, and pumped to the surface for discharge under the terms of the UPDES permit.

adjacent areas. The location of the sampling points are presented on Plates 7-1 and 7-1A.

History of Data Collection. The U.S. Geological Survey conducted a water quality study in Horse Canyon from August 1978 until September 1979 during the time that U.S. Steel operated the mine. Samples were taken monthly from the Horse Canyon Creek and analyzed for most major ions and cations and field parameters. Metals, eight nitrogen species and other minor chemical constituents were taken on a quarterly basis or less.

Between January 1981 and April 1983, baseline water quality data was collected for four surface water/spring sites B-1, HC-1, RF-1 and RS-2, and 3 UPDES Discharge Points, 001 (Mine Discharge), 002 (Mine Discharge) and 003 (Sewer Plant), on the Horse Canyon permit area. Between 14 and 19 samples were taken and analyzed during the monitoring period depending on the site. The parameters that were analyzed were derived from Section 783.16 in the regulations. DOGM monitoring guidelines were not in force at that time.

Two other sites, RS-1, and RS-2, were sampled once a year during 1978, 1979, and 1980 and analyzed for most major chemical constituents. In addition, springs H-1, H-6, H-18, and H-21 were sampled once by JBR and analyzed for the major constituents in 1985. Third quarter data for 1989 were collected for B-1, HC-1, RF-1, and RS-2 and sampled for most of the parameters in DOGM's guidelines.

Sample sites B-1, HC-1, RF-1 and RS-2, along with the UPDES Discharge Points 001A and 001B, have been monitored quarterly since 1989 in accordance with the approved water monitoring plan for the Horse Canyon Mine. The results of this monitoring have been submitted to the Division each year with the Annual Report and or have been entered into the Divisions electronic data base.

Baseline monitoring was also conducted on the proposed Lila Canyon Mine extension area by Earthfax Engineering in 1993-1995. Some 60 sites were identified and monitored. This data is presented in Appendix 7-1.

The operational water monitoring program committed to the permit application was implemented in July, 2000. Data will be collected from new monitoring sites L-1-S through L-4-S. L-5-G has yet to be installed. These sites are typically dry and no quality data has been gathered as yet. Sites L-6-G through L-10-G have been monitored for baseline in 1993, 1994, and 1995. These sites, along with piezometers IPA-1, IPA-2 and IPA-3, were


Geneva exploration entries driven south from the Horse Canyon Mine into the proposed Lila Canyon mining area do contain water since the tunnels elevation is approximately 5855 feet.

The Horse Canyon Mine has been closed and the surface area reclaimed. With no significant inflow to the old workings, no discharges are occurring from any of the portal areas nor are expected in the future. It is known however, that water has collected in the old entries. As future mining activities, for the proposed Lila Canyon Mine, will be occurring near this area of collected water in the old exploration entry workings, it is likely that some of this water will be intercepted by the proposed Lila Canyon Mine (see Plate 7-1). Water may then have to be pumped from the mine. Because of undulating floor and unknown void areas, it is impossible to determine the amount of water that would be pumped. The rate of pumping, if any, would be determined by the water discharge system design. All water discharged from the mine would be discharged at UPDES Site # 002A which is Site L-5-G, and will meet all UPDES standards. DOGM has specified planning to include a mine discharge of 500 gpm maximum.

An inspection of the Horse Canyon area following mining has shown no diminution of reasonably foreseeable use of aquifers. Since mining ceased in 1983, subsidence should have occurred within two years. However, no deterioration of the aquifers in the area was identified. Mining has not yet begun on the Lila Canyon site; however, since the structure and groundwater regime is similar to the Horse Canyon area, no diminution or deterioration of groundwater resources is expected in this area.

As the mining in the Lila Canyon Mine will be from the same seam and the adjacent strata are the same and the over and underburden are the same, occurrences of ground water in the Lila Canyon Mine are expected to be similar to the Geneva Mine (Horse Canyon). The water quality is expected to be the same as the water encounter in the Horse Canyon Mine. Samples taken underground from the Horse Canyon by Kaiser to the south of the Lila Canyon Mine show the water from the level of the coal seam to be a calcium, sodium-sulfate type water. Therefore, it is likely that the water from the strata between these two points from the same strata will be very similar.

Inflows of water encountered while mining are expected to reduce to seeps or dry up in a short period of time. If a significant water inflow is encountered, the water, which is not needed for underground operations, will be collected, treated as necessary, and pumped to the surface for discharge under the terms of the UPDES permit.

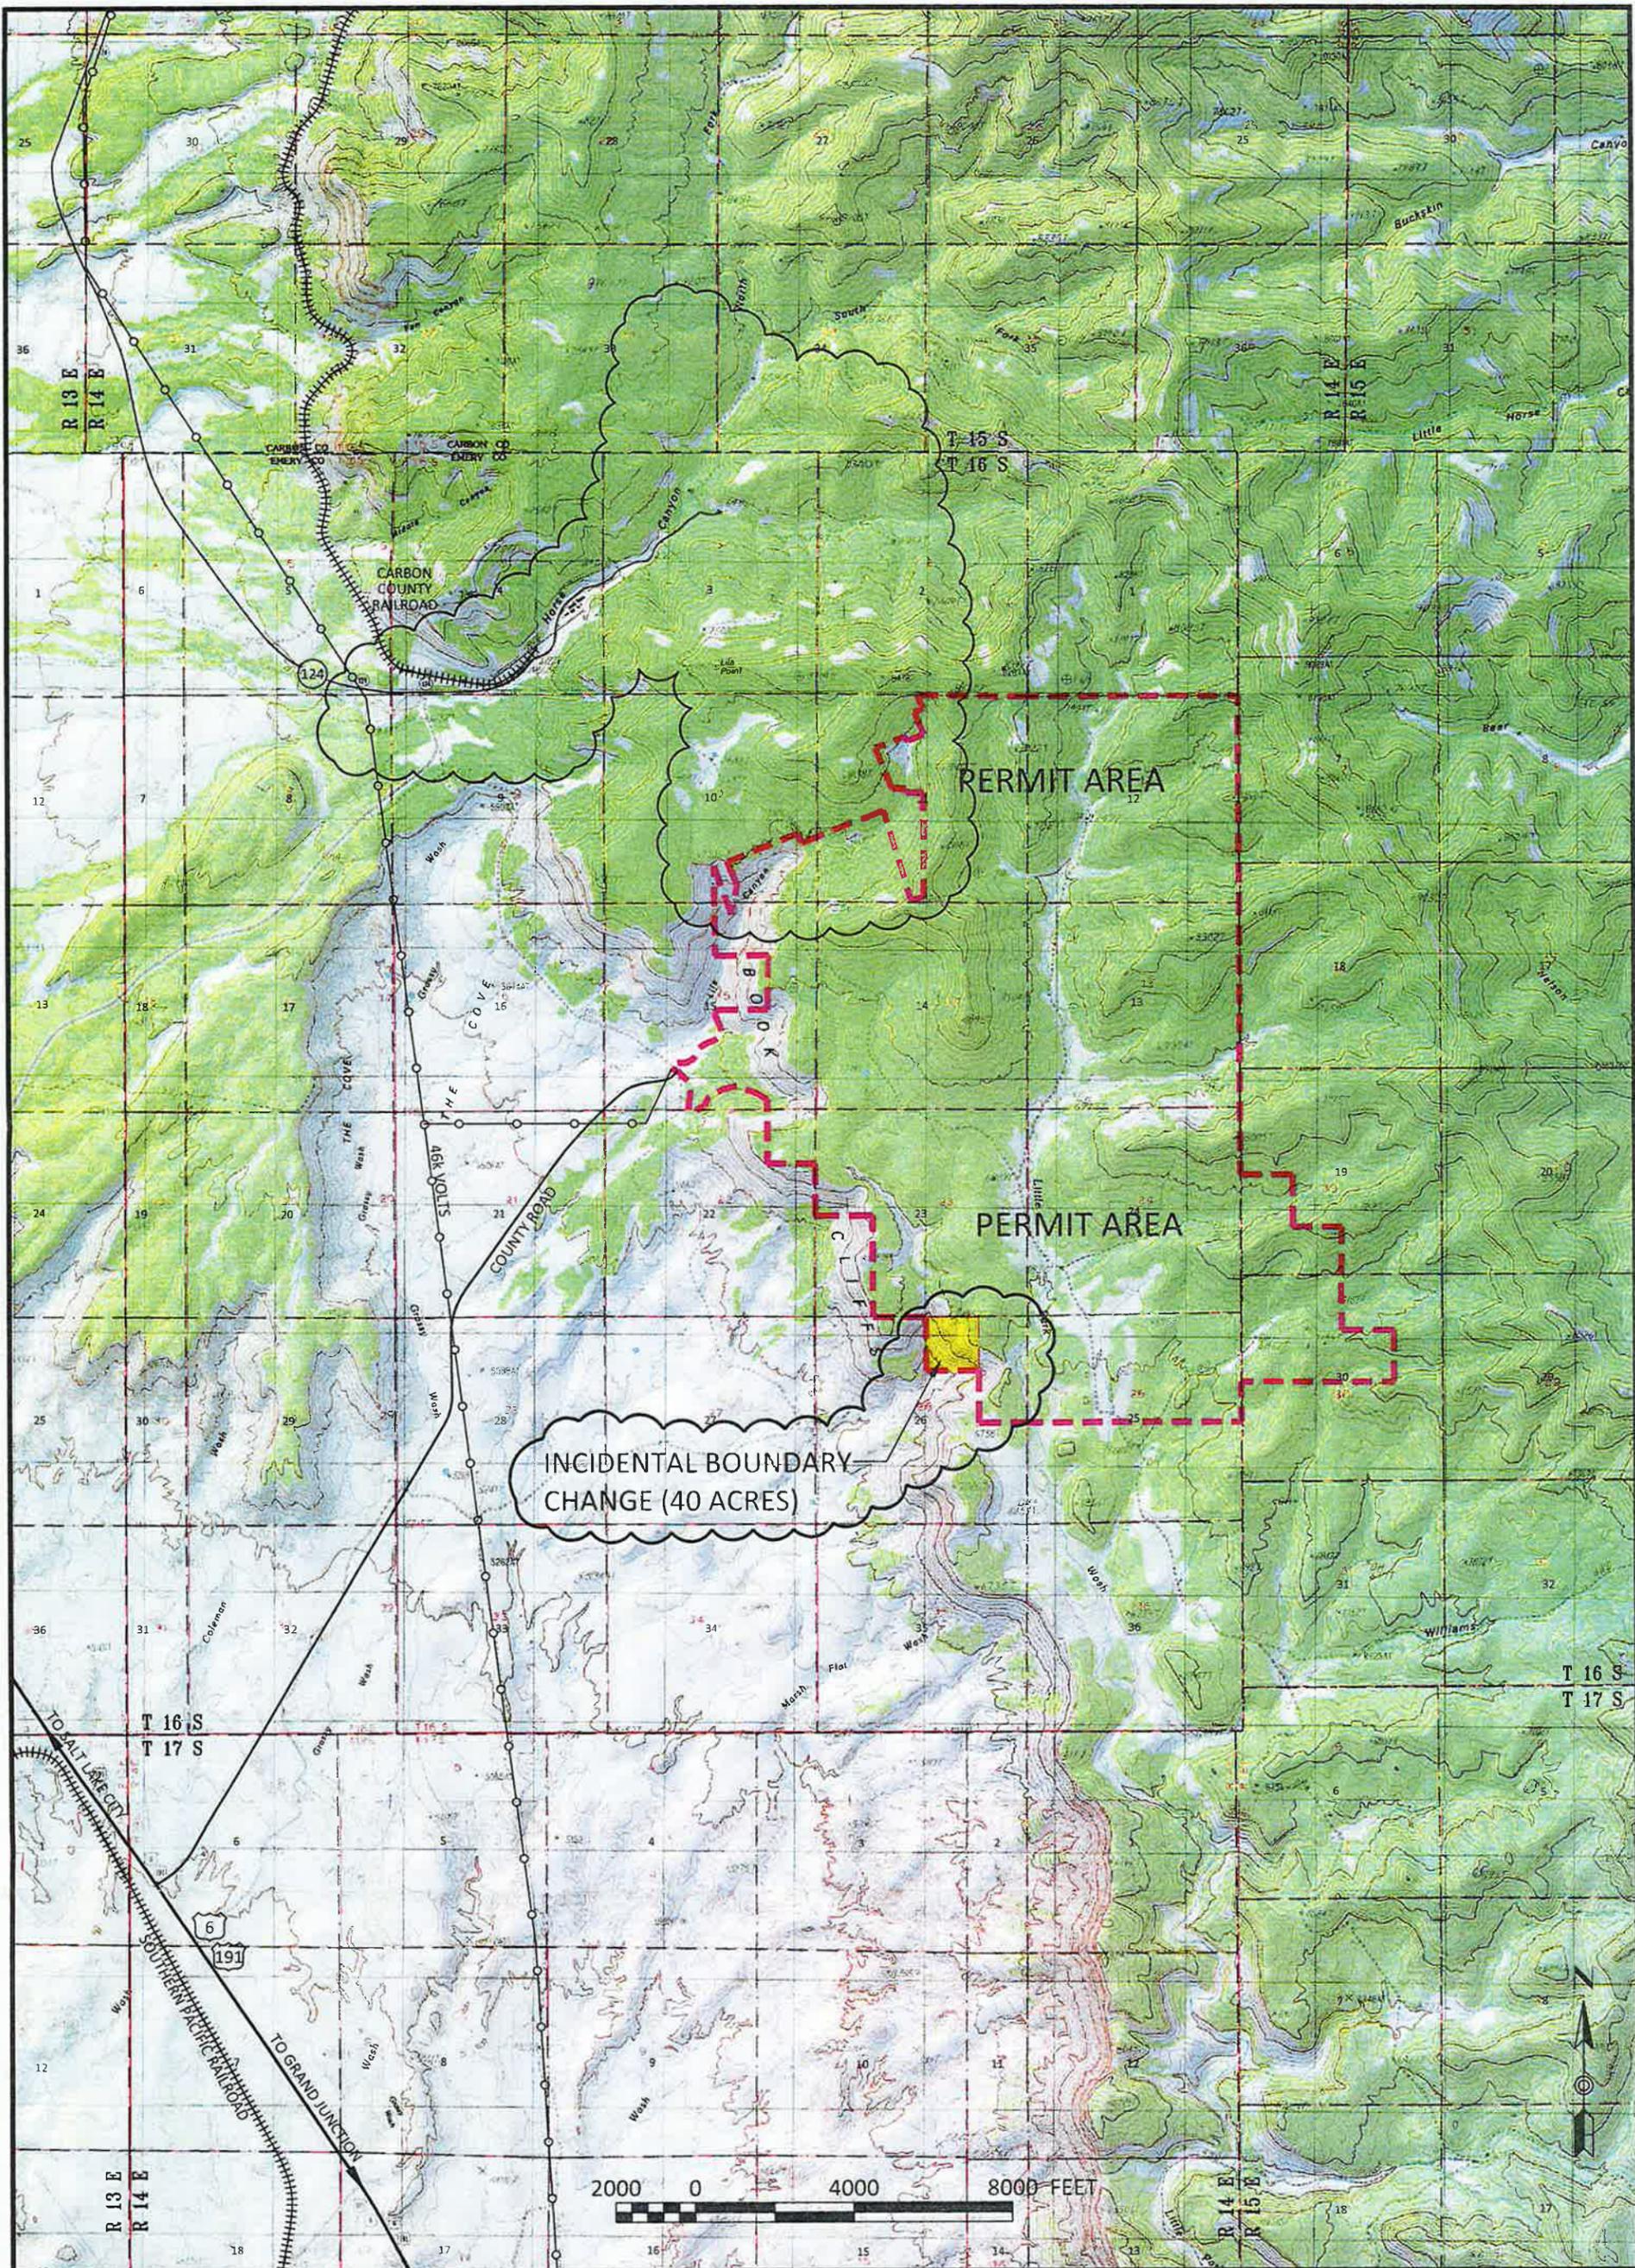

INCIDENTAL BOUNDARY CHANGE (40 ACRES)


PERMIT AREA

PERMIT AREA

LEGEND:


PERMIT AREA :

INCIDENTAL BOUNDARY CHANGE AREA : (40 ACRES)

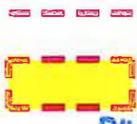

NOTE: Plate 1-1 is the official permit boundary map and it will be used to clarify any questions about the permit boundaries.

RECEIVED
FEB 09 2016
 DIV. OF OIL, GAS & MINING

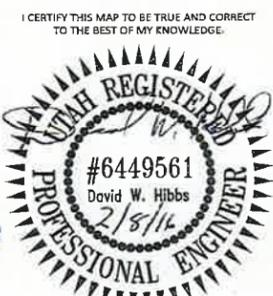


REVISIONS

DATE	BY
12/13/2000	BJ
10/02/2002	RJM
02/08/2016	PJJ

PERMIT AREA MAP

LILA CANYON MINE
 23415 North Lila Canyon Road
 Green River, Utah 84525
 DOGM PERMIT# C0070013
 DESIGN BY: **EIS** SCALE: 1" = 4,000'
 ORIGINAL DATE: SEPT. 2000

G:\Current Drawings\MPR Maps\Lila Canyon\IBC Sect 26 Breakouts\Plate 1-1 Permit Area Map 01-2016.dwg, Plate 1-1, 2/5/2016 12:36:38 PM, 1:1

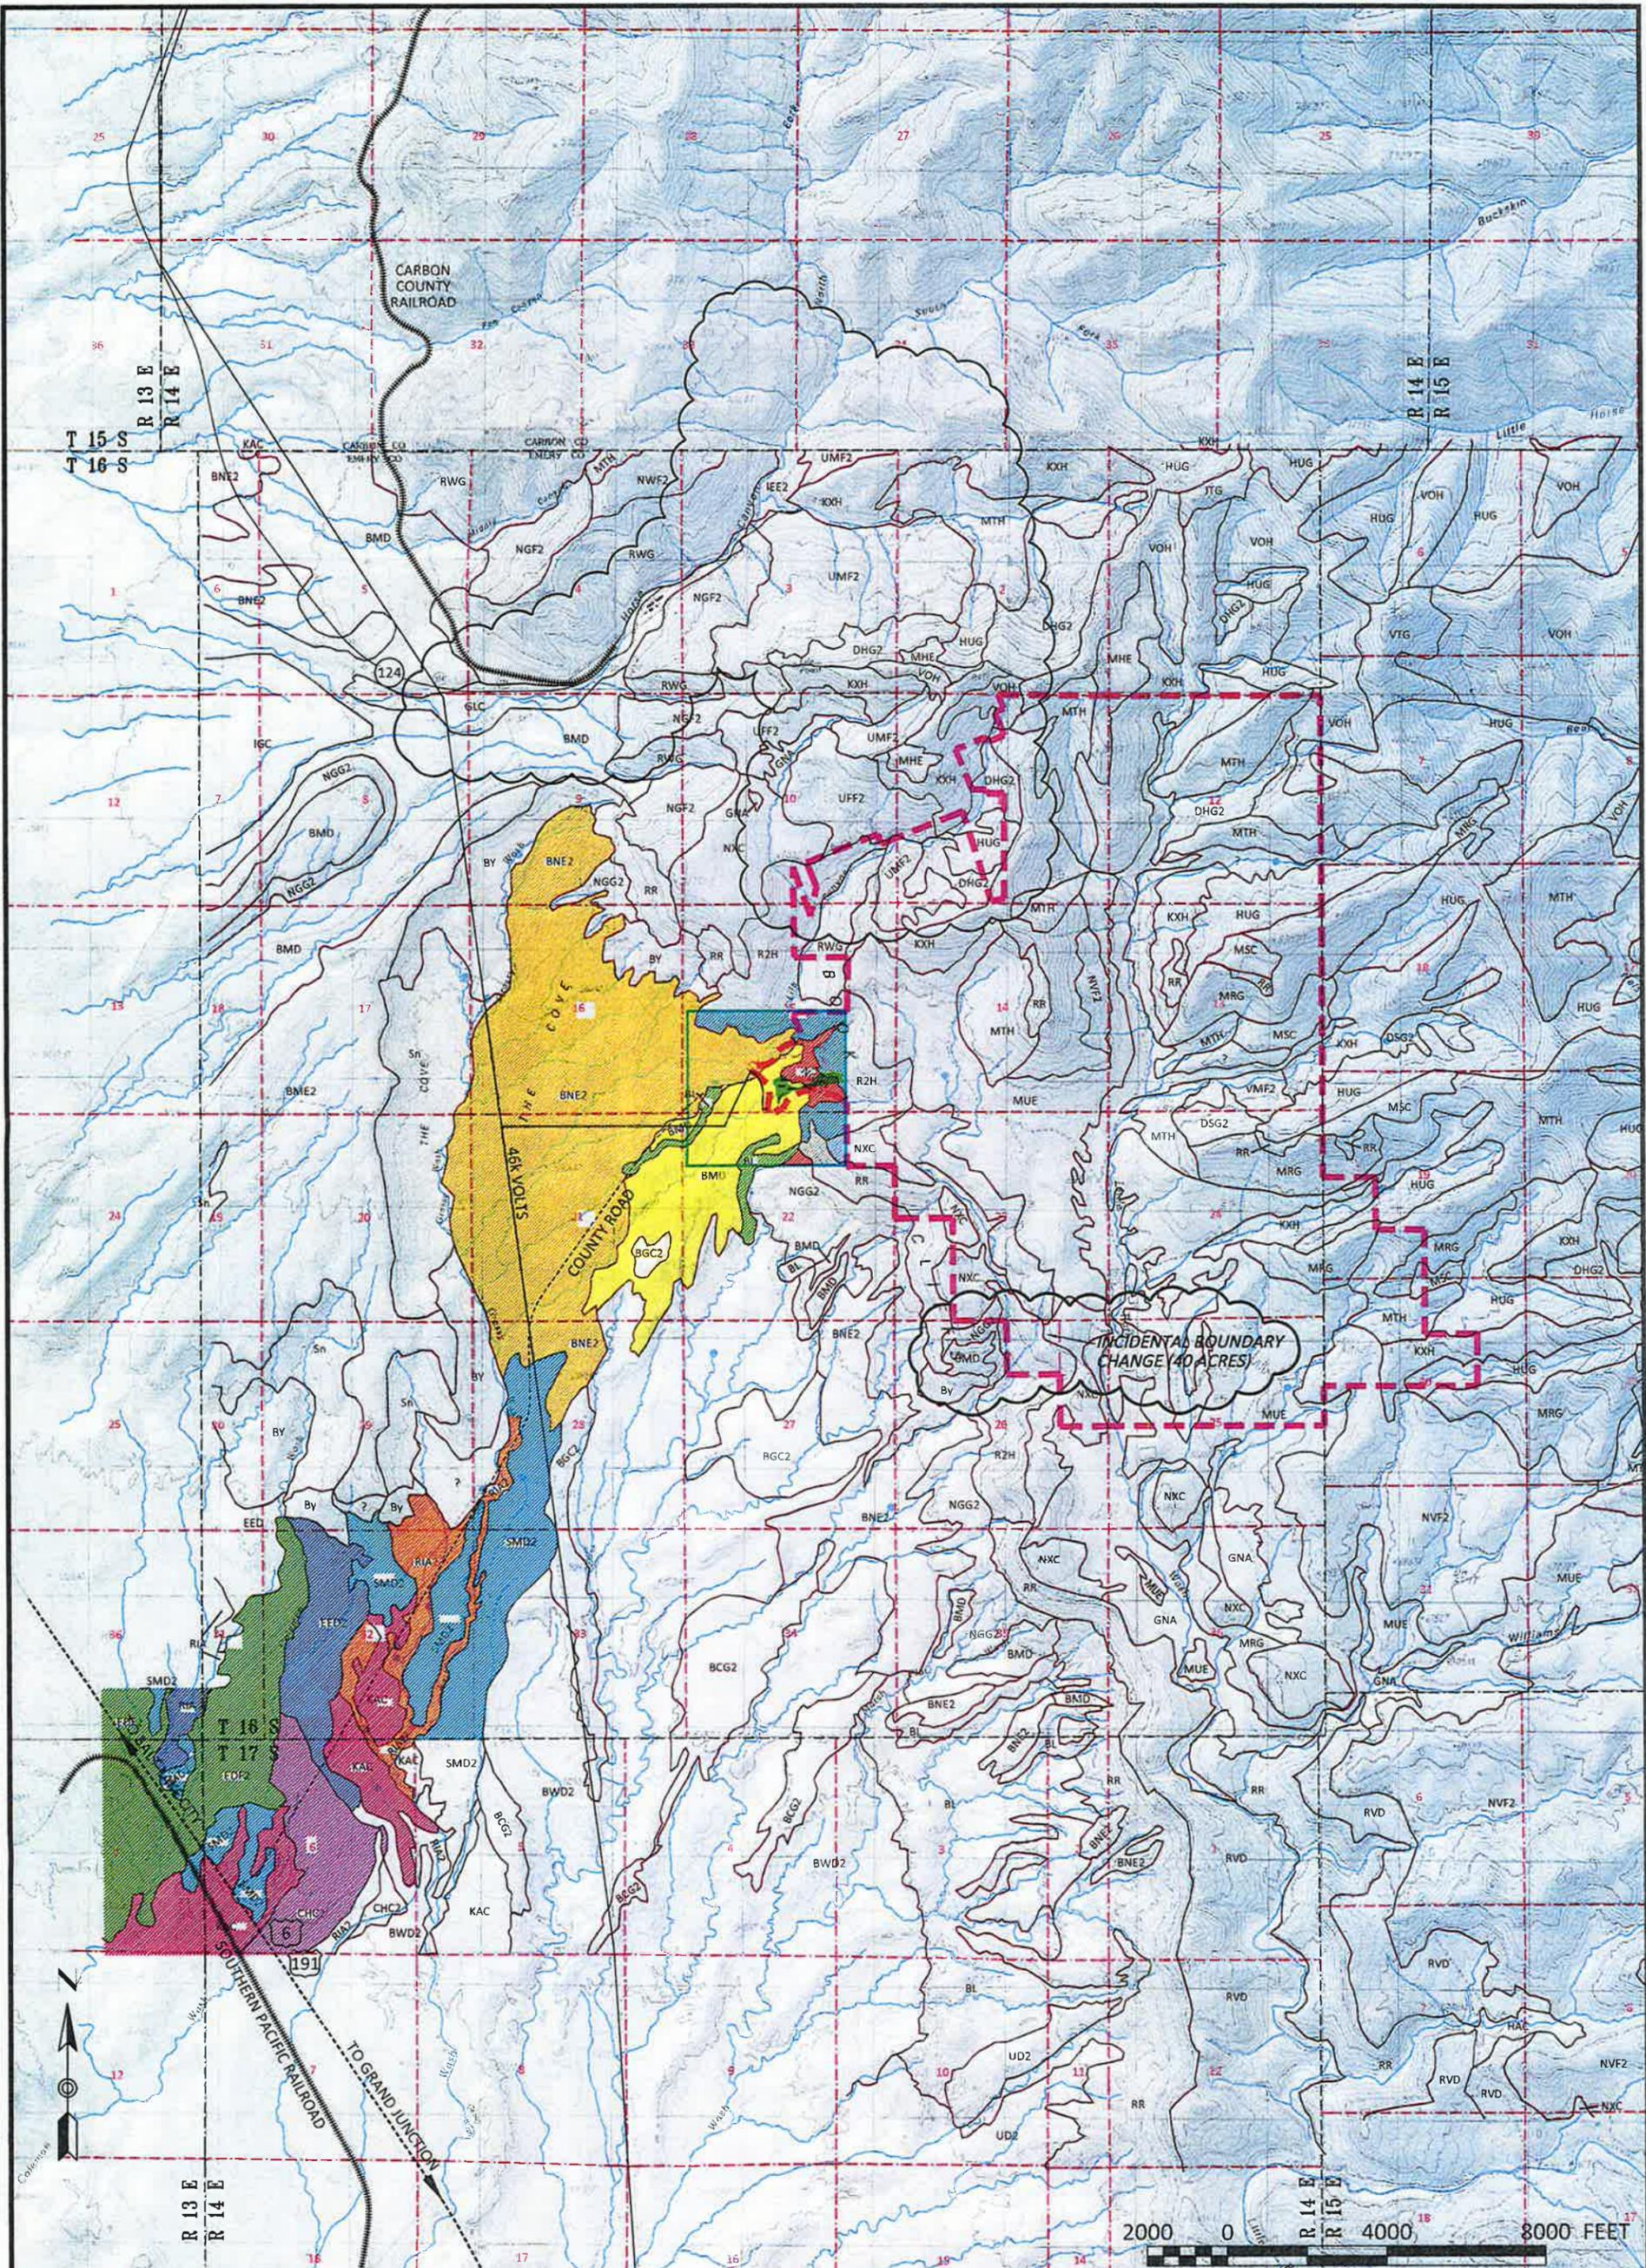

LEGEND: PERMIT AREA : Disturbed Area
 Area of Undisturbed within Disturbed Area

SOILS WITHIN THE DISTURBED SURFACE FACILITIES:

- RR Senchert loam, 3-15% slopes
- NGG2 Gerst-Strych-Badland Complex, 30-70% slopes
- NXC Travessilla sandy loam, 1-8% slopes
- R2H Travessilla family-Rock outcrop complex
- BMD Strych very stony fine sandy loam, 3-30% slopes
- BL Persao-Chipeta Badland, 3-20% slopes
- BNE2 Strych, very bouldery fine sandy loam, 3-20% slopes

RECEIVED
FEB 09 2016
 DIV. OF OIL, GAS & MINING



REVISIONS	
DATE	BY
JAN. 2008	RJM
DEC. 2010	RJM
02/08/2016	PJJ

SOILS MAP

LILA CANYON MINE
 23415 North Lila Canyon Road
 Green River, Utah 84525


DOGM PERMIT# C0070013

DESIGN BY:	SCALE: 1" = 4,000'
	ORIGINAL DATE: MAY 1998

PLATE 2-1

G:\Current Drawings\MP Maps\Lila Canyon\IBC Sect 26 Breakouts\Plate 2-1 Soils Map 01-2016.dwg, Plate 2-1, 2/5/2016 12:40:12 PM, 1:1

2000 0 4000 8000 FEET

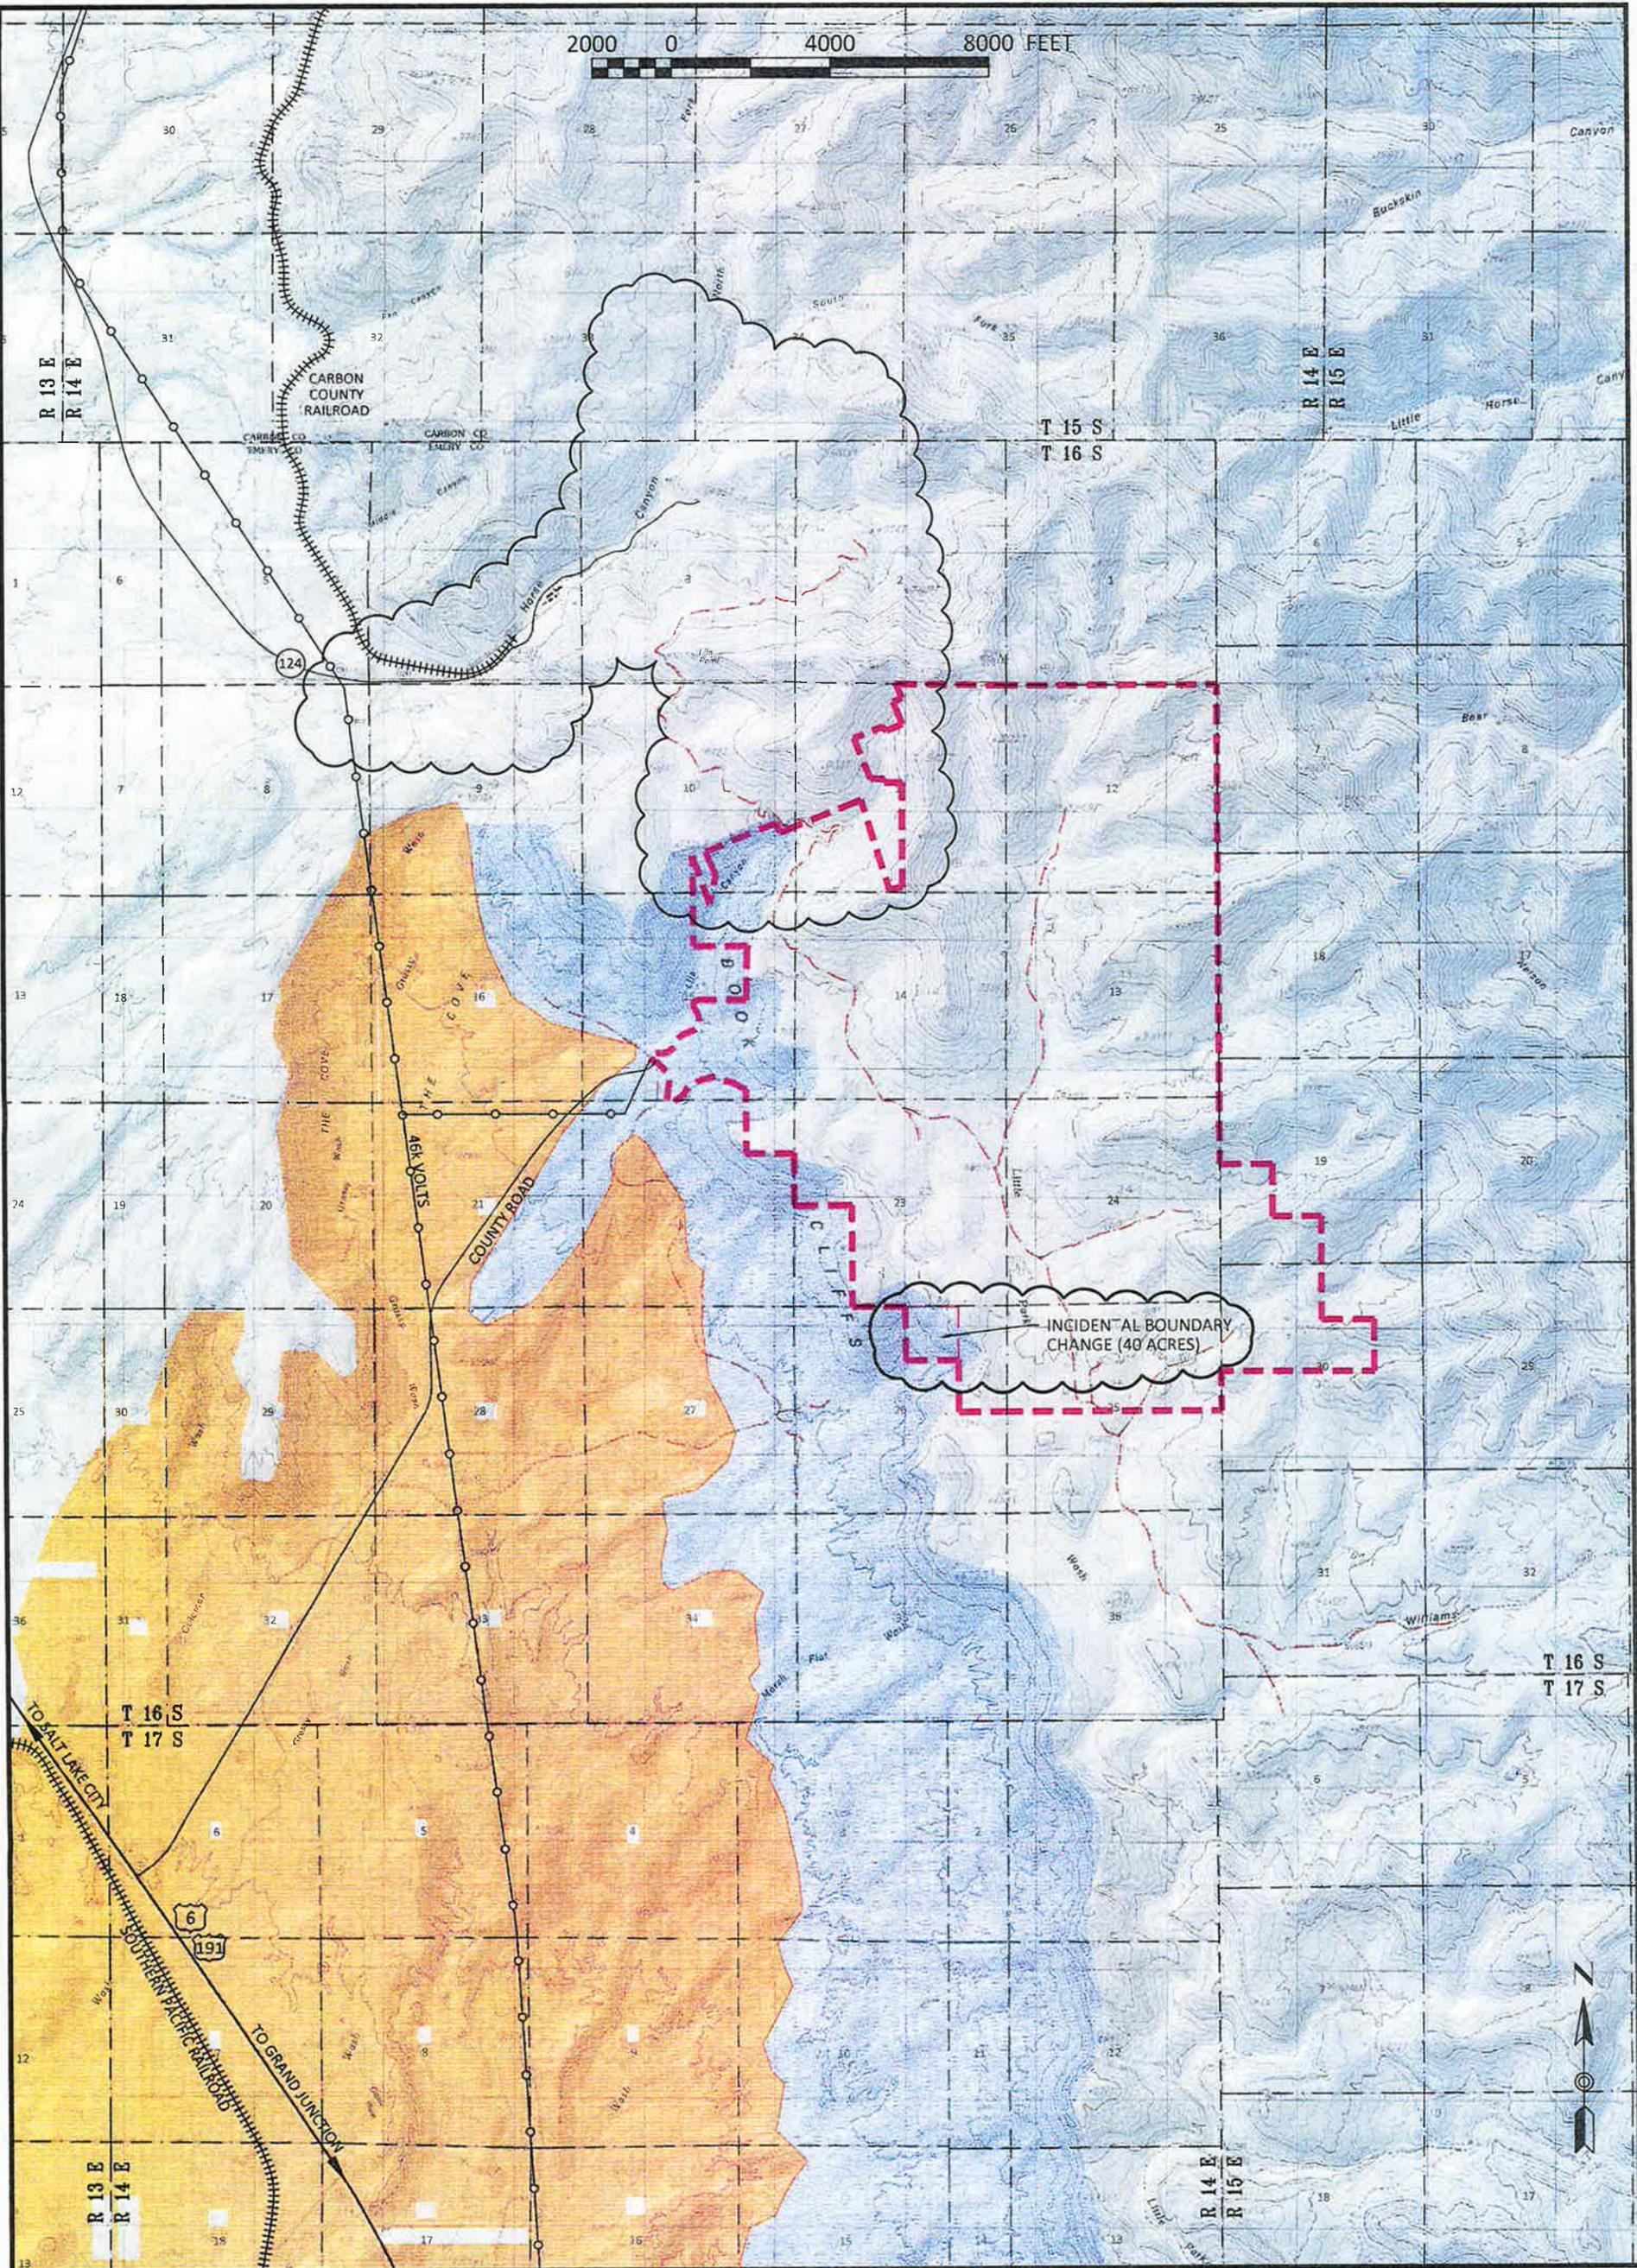

LEGEND:

-  Rocky Mountain Big Horn Sheep Habitat
-  Pronghorn Antelope Yearlong Habitat
-  Permit Line



RECEIVED
FEB 09 2016



DIV. OF OIL, GAS & MINING

REVISIONS

DATE	BY
11 NOV. 1999	RJM
29 AUG. 2000	BJ
14 DEC. 2000	BJ
SEPT. 2002	RJM
APR. 2003	RJM
FEB. 8, 2016	PJJ

**WILDLIFE HABITAT:
BIG HORN SHEEP /
PRONGHORN ANTELOPE**


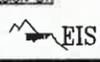
 LILA CANYON MINE
 23415 North Lila Canyon Road
 Green River, Utah 84525
 DOGM PERMIT# C0070013
 DESIGN BY:  EIS
 SCALE: 1" = 4,000'
 ORIGINAL DATE: SEPT. 2000

PLATE 3-1B

2000 0 4000 8000 FEET

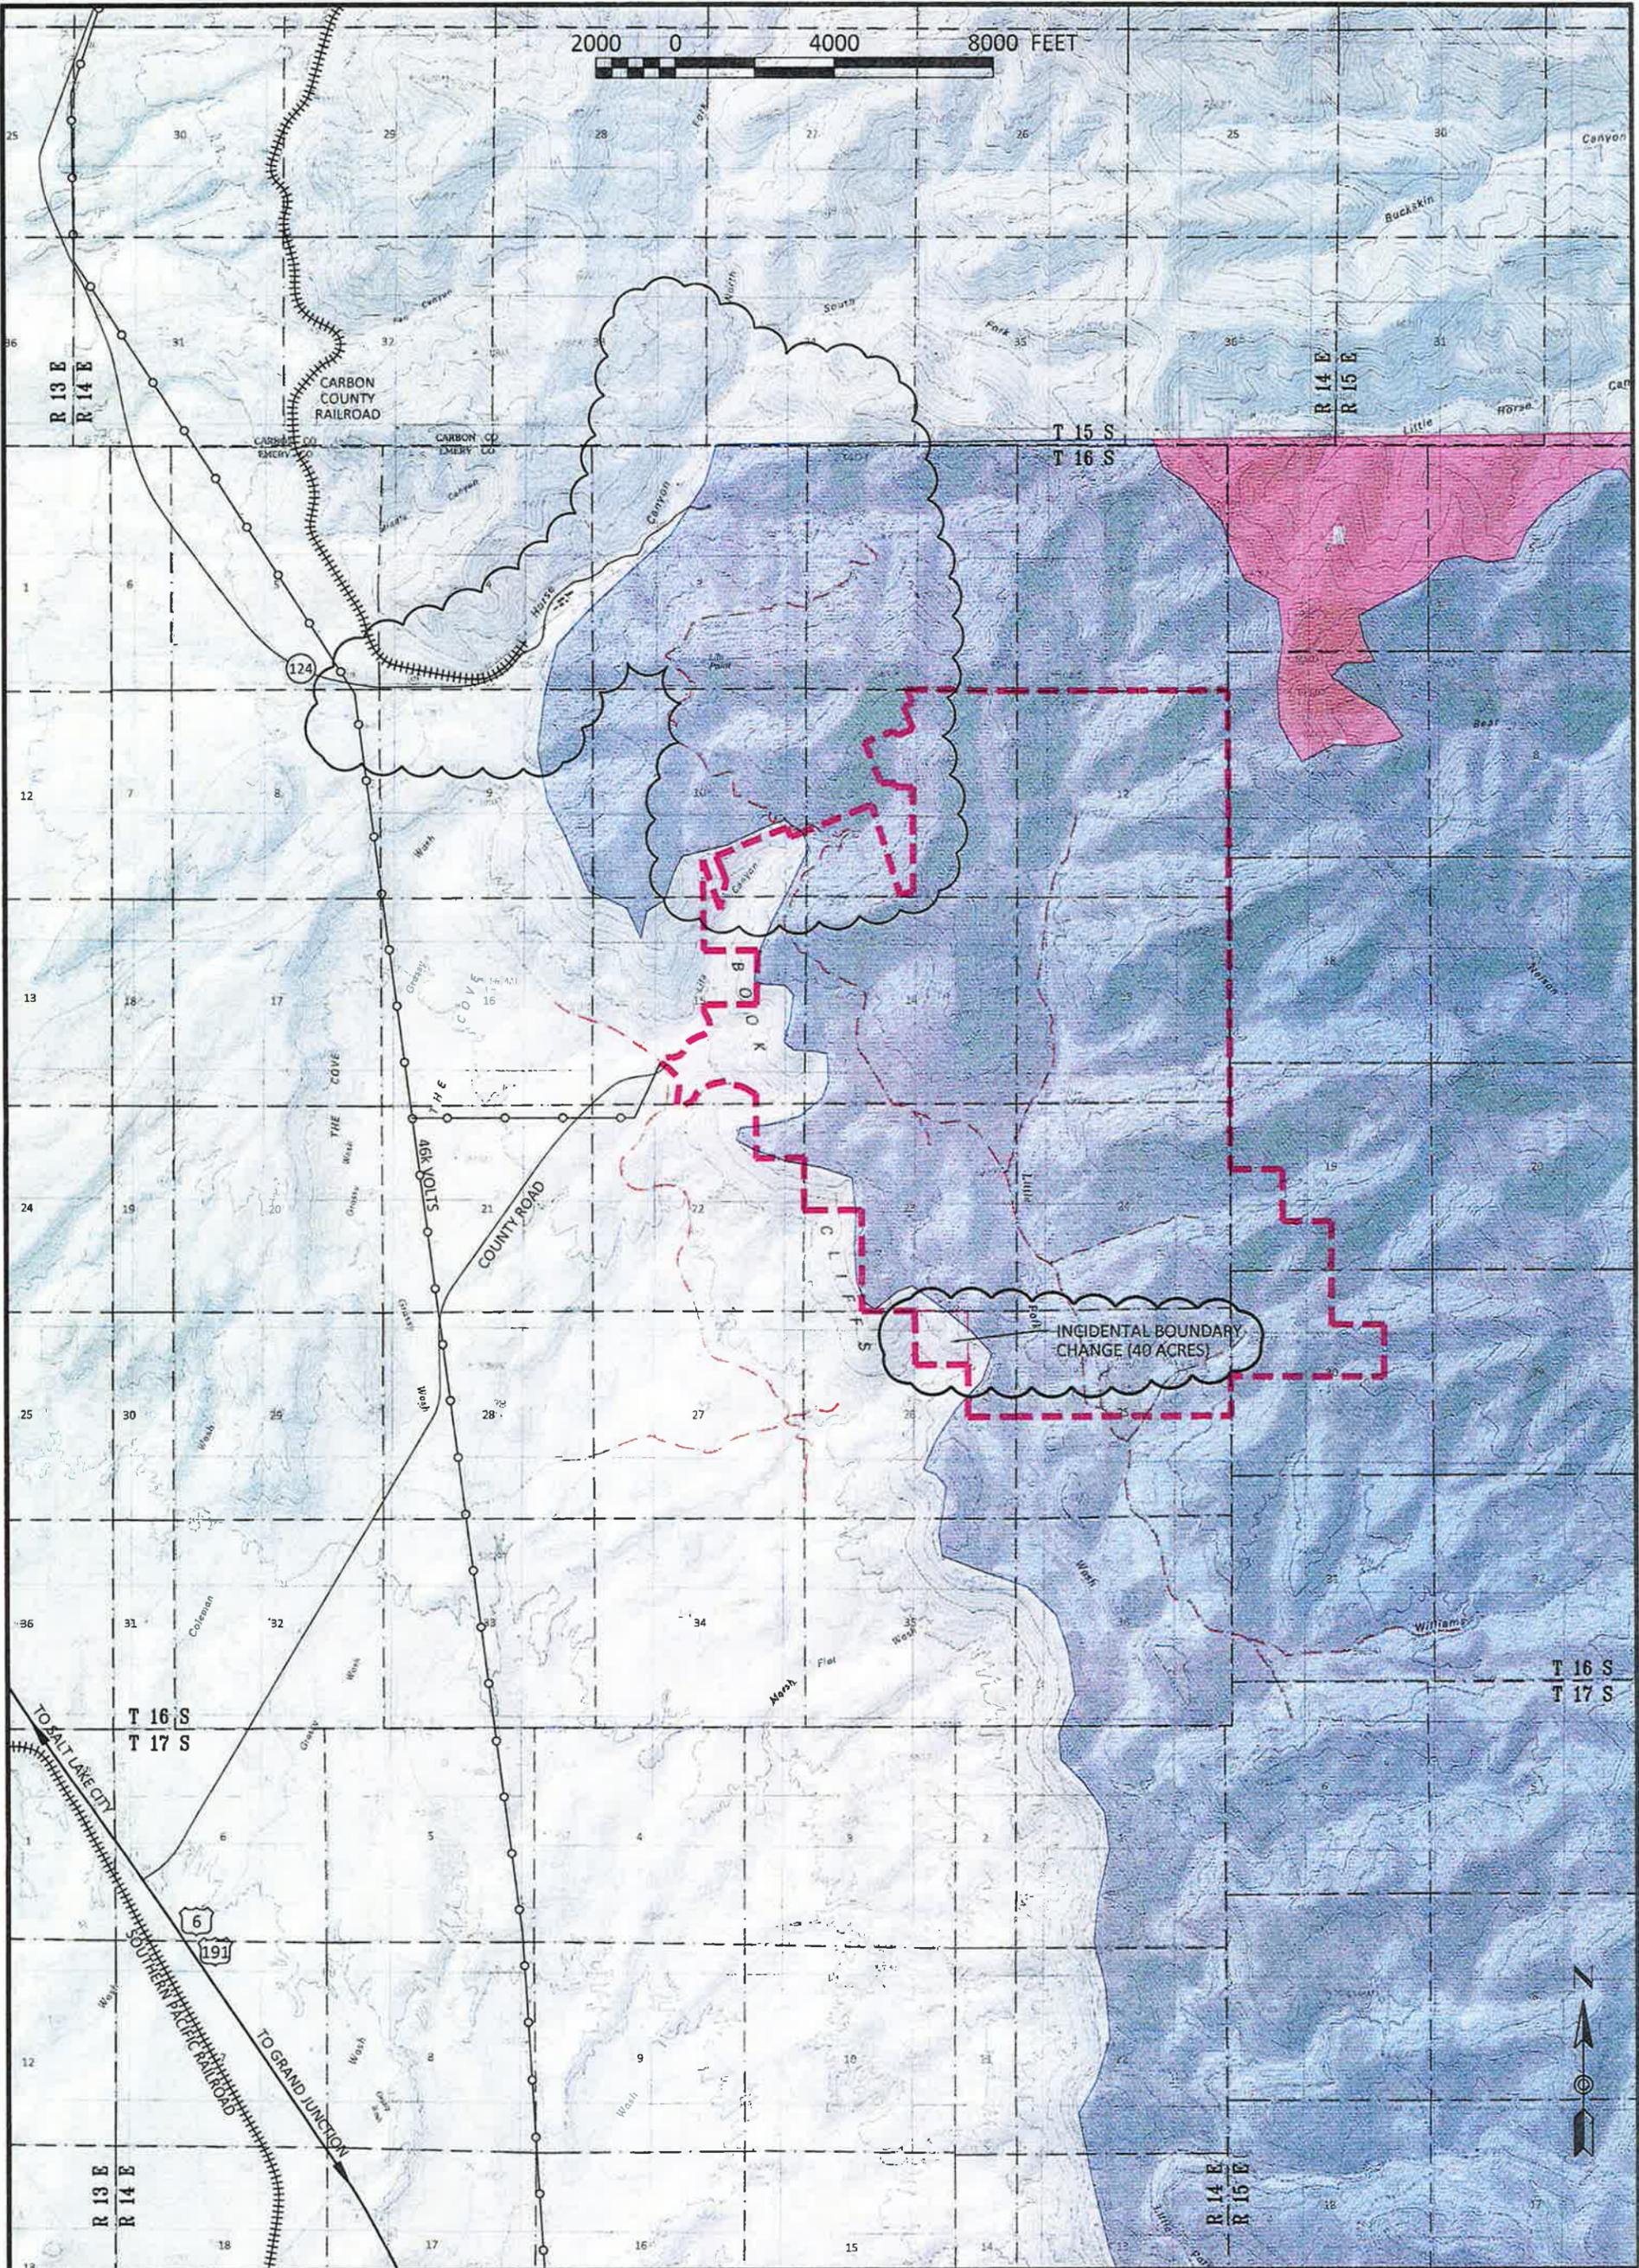

INCIDENTAL BOUNDARY CHANGE (40 ACRES)

LEGEND:

- Elk Winter Habitat
- Elk Summer Habitat
- Permit Line

2000 0 4000 8000 FEET

RECEIVED

FEB 09 2016

DIV. OF OIL, GAS & MINES



REVISIONS

DATE	BY
11 NOV. 1999	RJM
29 AUG. 2000	BJ
14 DEC. 2000	BJ
SEPT. 2002	RJM
APR. 2003	RJM
FEB. 8, 2016	PJJ

**WILDLIFE HABITAT:
ELK**




LILA CANYON MINE
23415 North Lila Canyon Road
Green River, Utah 84525

DOG M PERMIT# C0070013

DESIGN BY: EIS
SCALE: 1" = 4,000'
ORIGINAL DATE: SEPT. 2000

PLATE 3-1C

2000 0 4000 8000 FEET

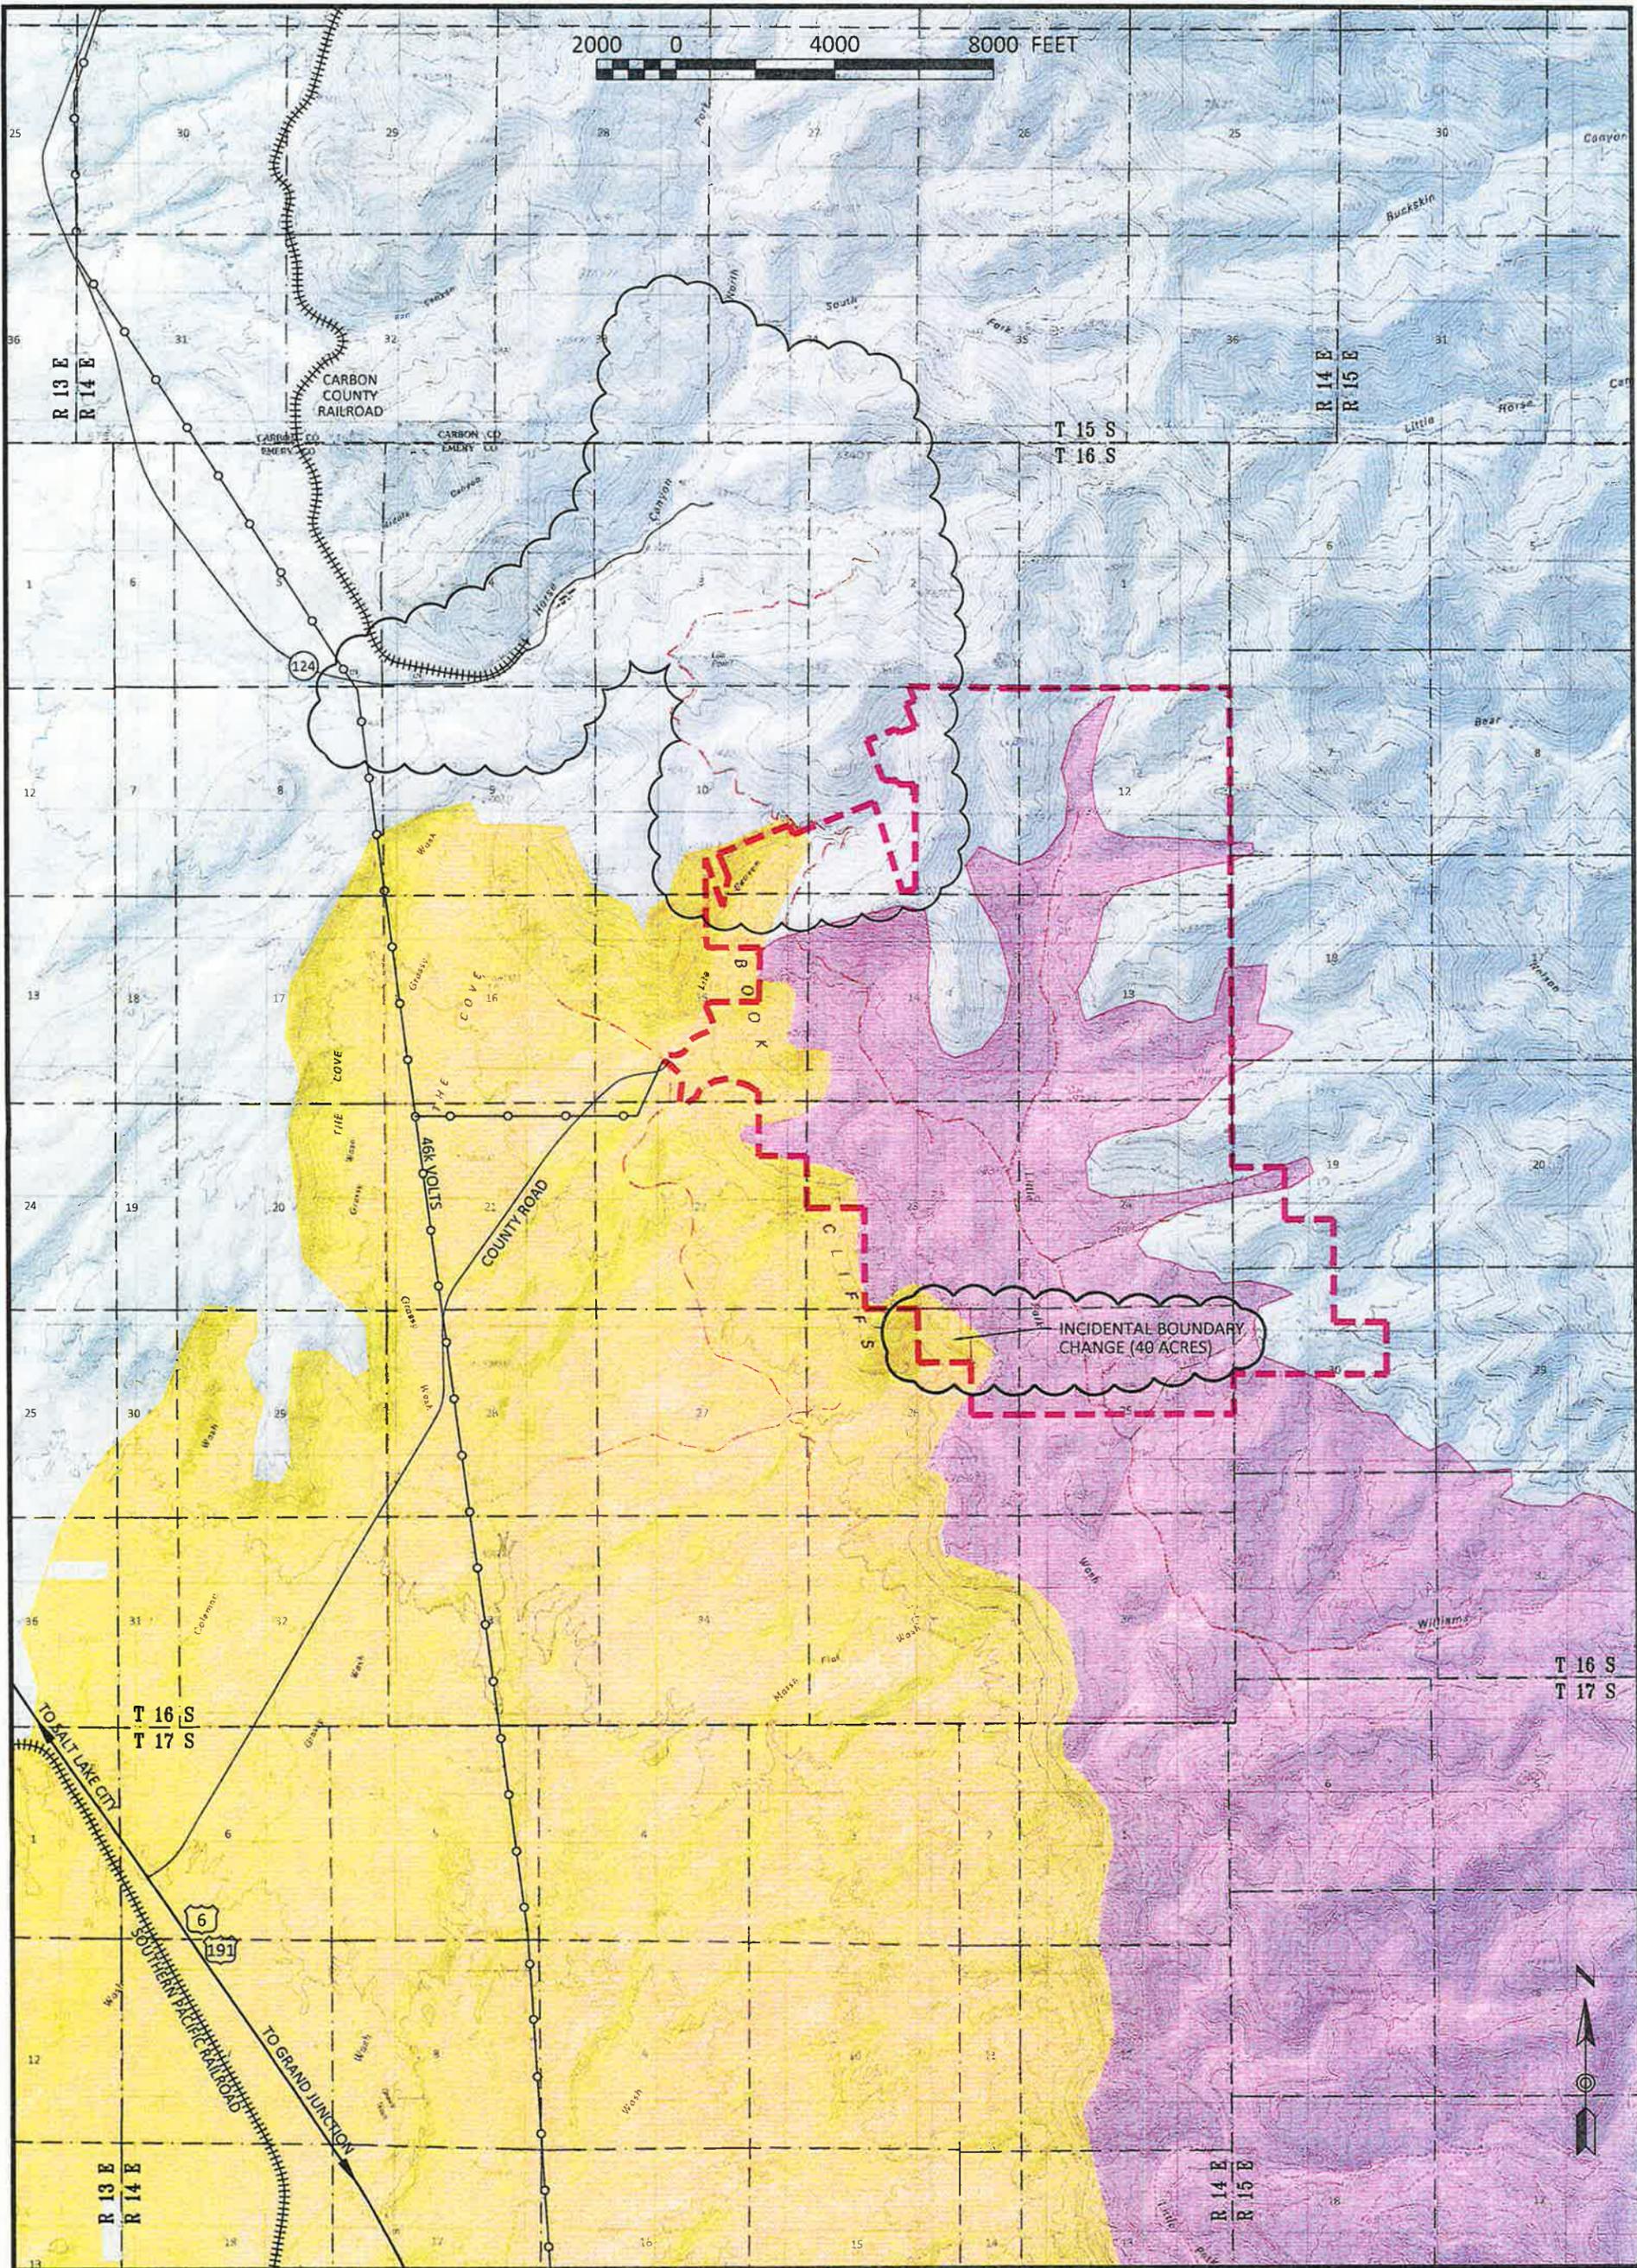

G:\Current Drawings\Map Maps\Uta Canyon\IBC Sect 26 Breakouts\Plate 3-1 Wildlife Habitat Confidential 01-2016.dwg, 3-10 DEER, 2/5/2016 12:42:10 PM, 1:1

LEGEND:

- Mule Deer Critical Habitat
- Mule Deer Yearlong Habitat
- Permit Line

RECEIVED

FEB 09 2016

DIV. OF OIL, GAS & MINING



REVISIONS


DATE	BY
11 NOV. 1999	RJM
29 AUG. 2000	BJ
14 DEC. 2000	BJ
SEPT. 2002	RJM
APR. 2003	RJM
FEB. 8, 2016	PJJ

**WILDLIFE HABITAT
MULE DEER**

LILA CANYON MINE
 23415 North Lila Canyon Road
 Green River, Utah 84525
 DOGM PERMIT# C0070013
 DESIGN BY: **EIS** SCALE: 1" = 4,000'
 ORIGINAL DATE: SEPT. 2000

2000 0 4000 8000 FEET

PLATE 3-1D

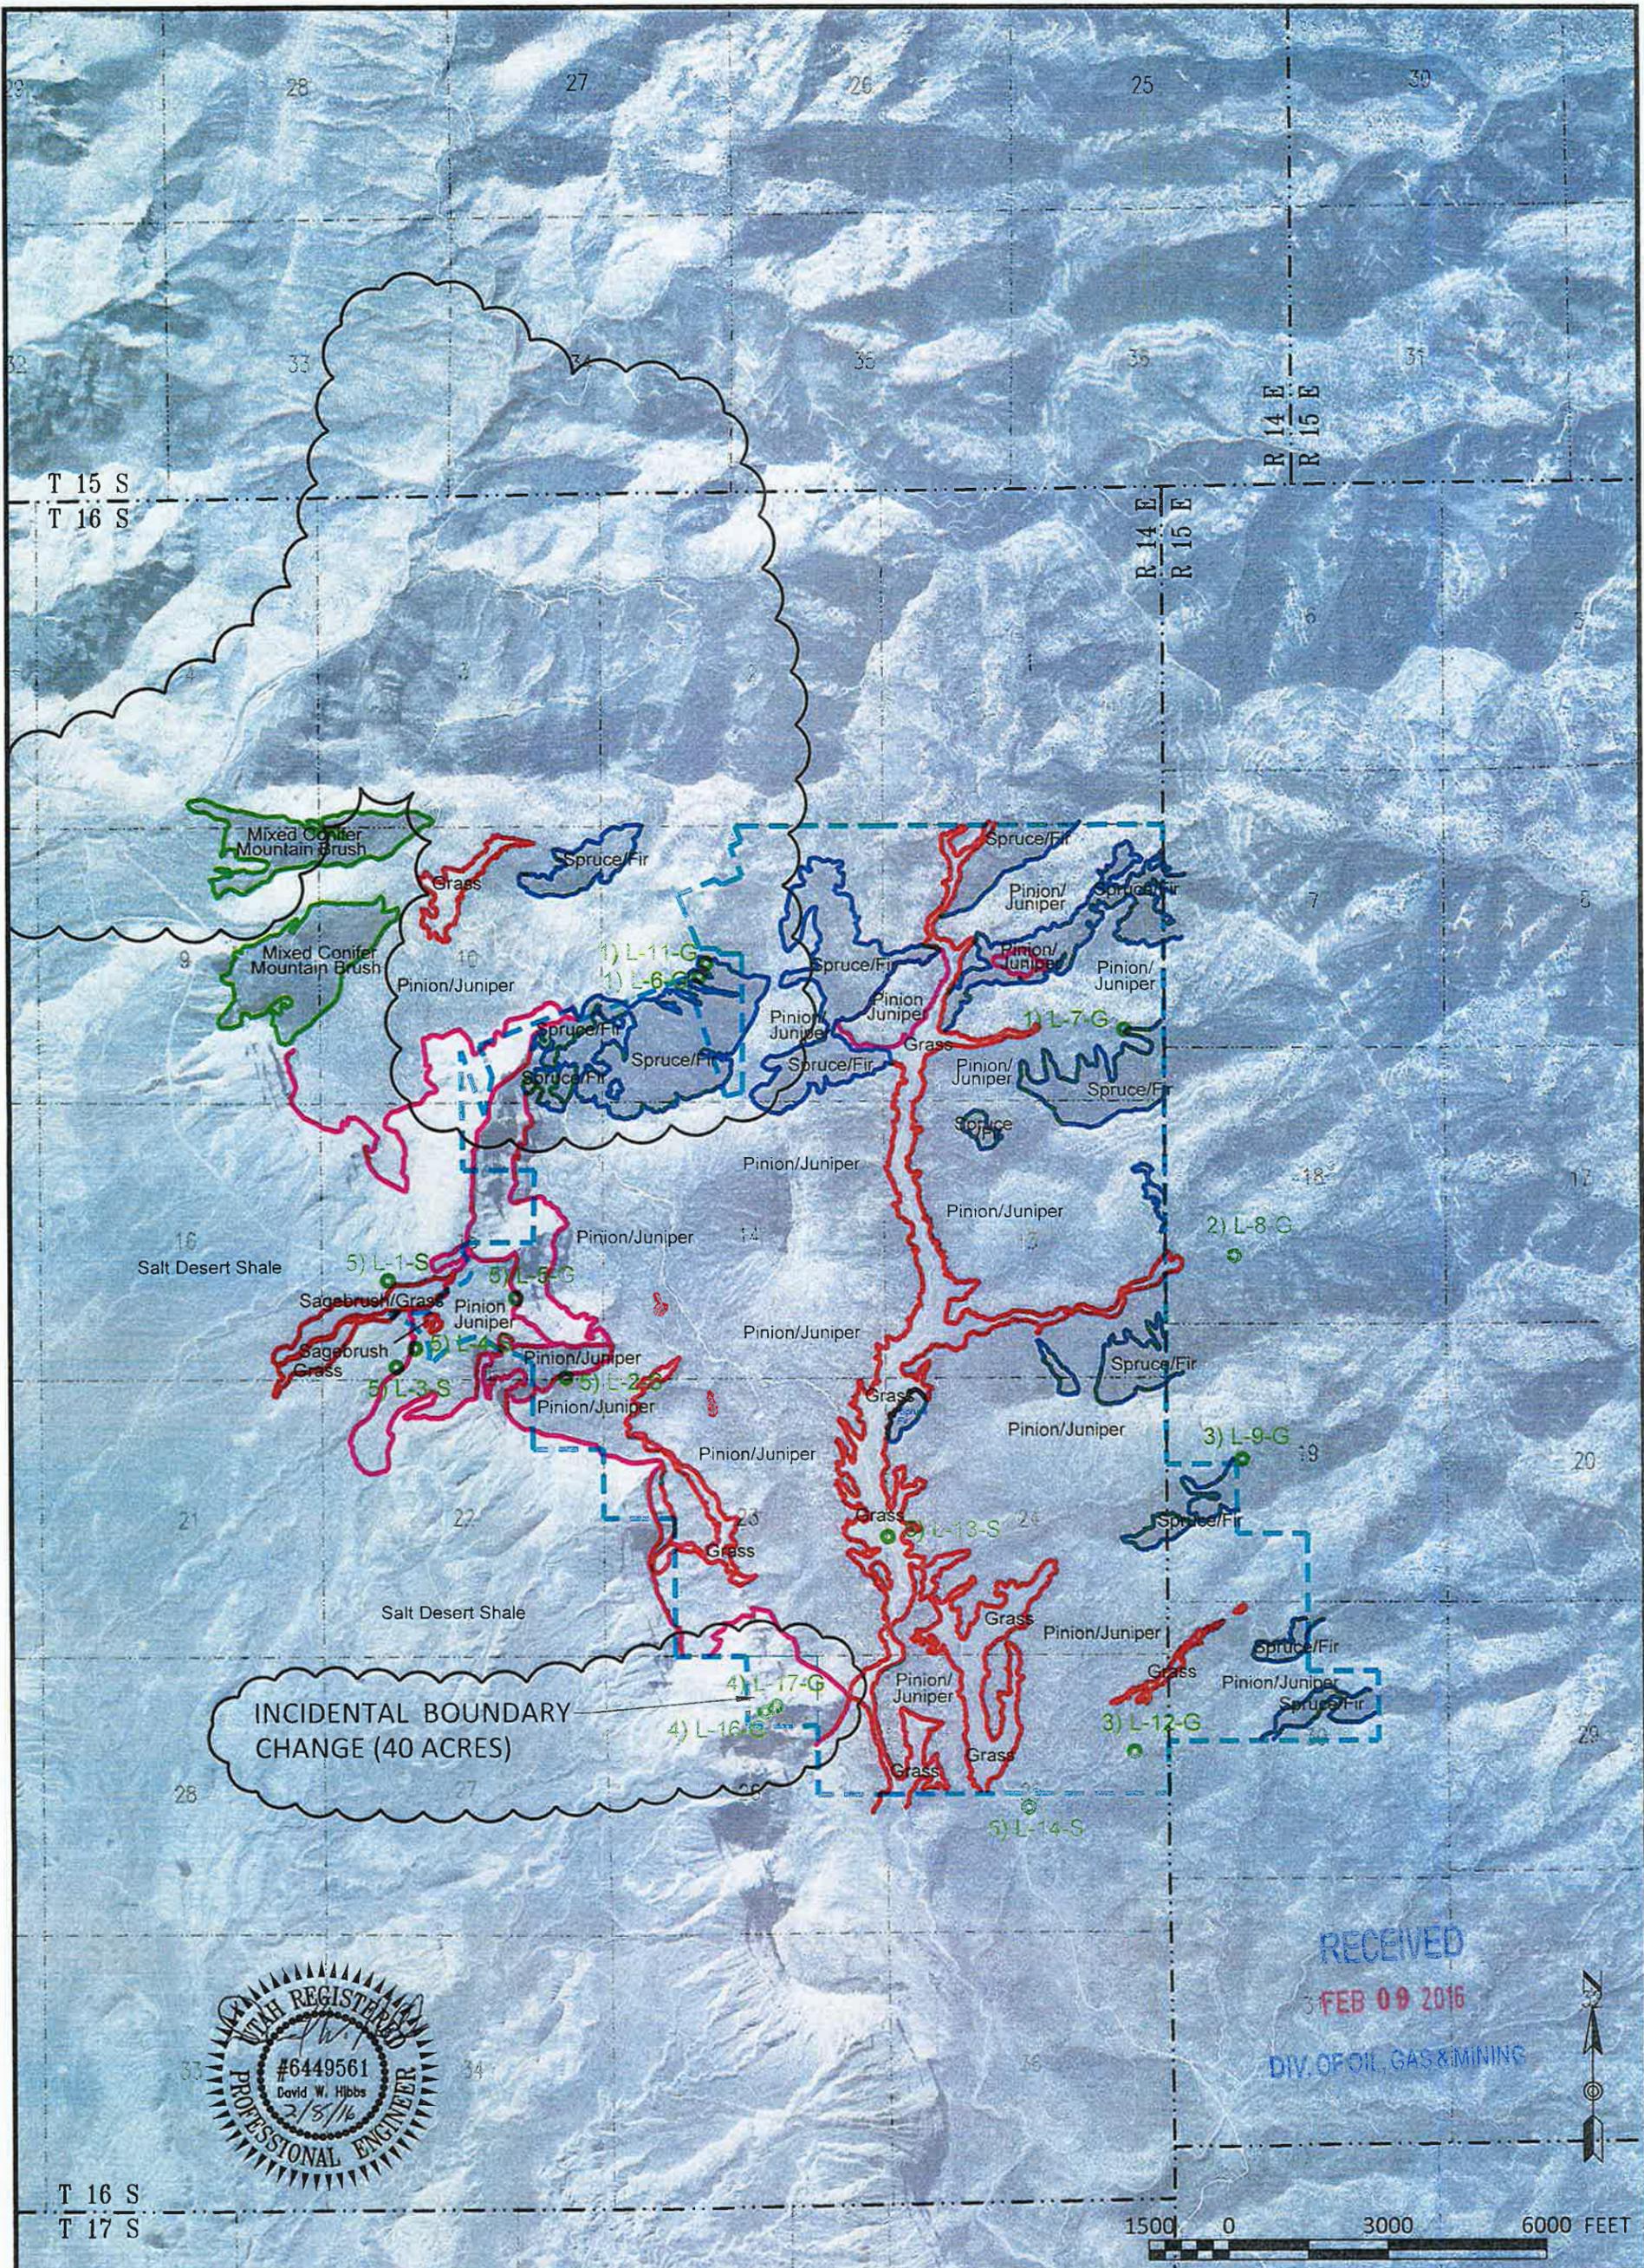

LEGEND:

- Salt Desert Shale / Grass
- Pinion/Juniper
- Spruce/Fir
- Mountain Brush
- Permit Boundary
- Spring Vegetation Key and Water Monitoring Location 2) L-15-G

Spring Vegetation Key

- (See Appendix 7-8 for Additional Details)
- 1) Habitat overstory is Douglas Fir-Mountain Brush association.
 - 2) Habitat is predominantly Pinyon-Juniper and sagebrush grass associations.
 - 3) Wet meadow habitat with an overstory of Pinyon-Juniper and sagebrush grass associations.
 - 4) Habitat is a mix of grasses and salt desert shrub habitat and invasive tamarisk.
 - 5) Habitat is a sagebrush with Pinyon-Juniper overstory.

REVISIONS

DATE	BY
02/08/2016	PJJ

VEGETATION MAP

LILA CANYON MINE


23415 North Lila Canyon Road
Green River, Utah 84525

DOG M PERMIT# C0070013

DESIGN BY:	SCALE:
EIS	1" = 4,000'
	ORIGINAL DATE:
	OCT. 2002

PLATE 3-2

G:\Current Drawings\Map Maps\Lila Canyon\IBC Sect 26 Breakouts\Plate 3-2_Vegetation Map 01-2016.dwg, Plate 3-2, 2/5/2016 1:44:32 PM, 1:1

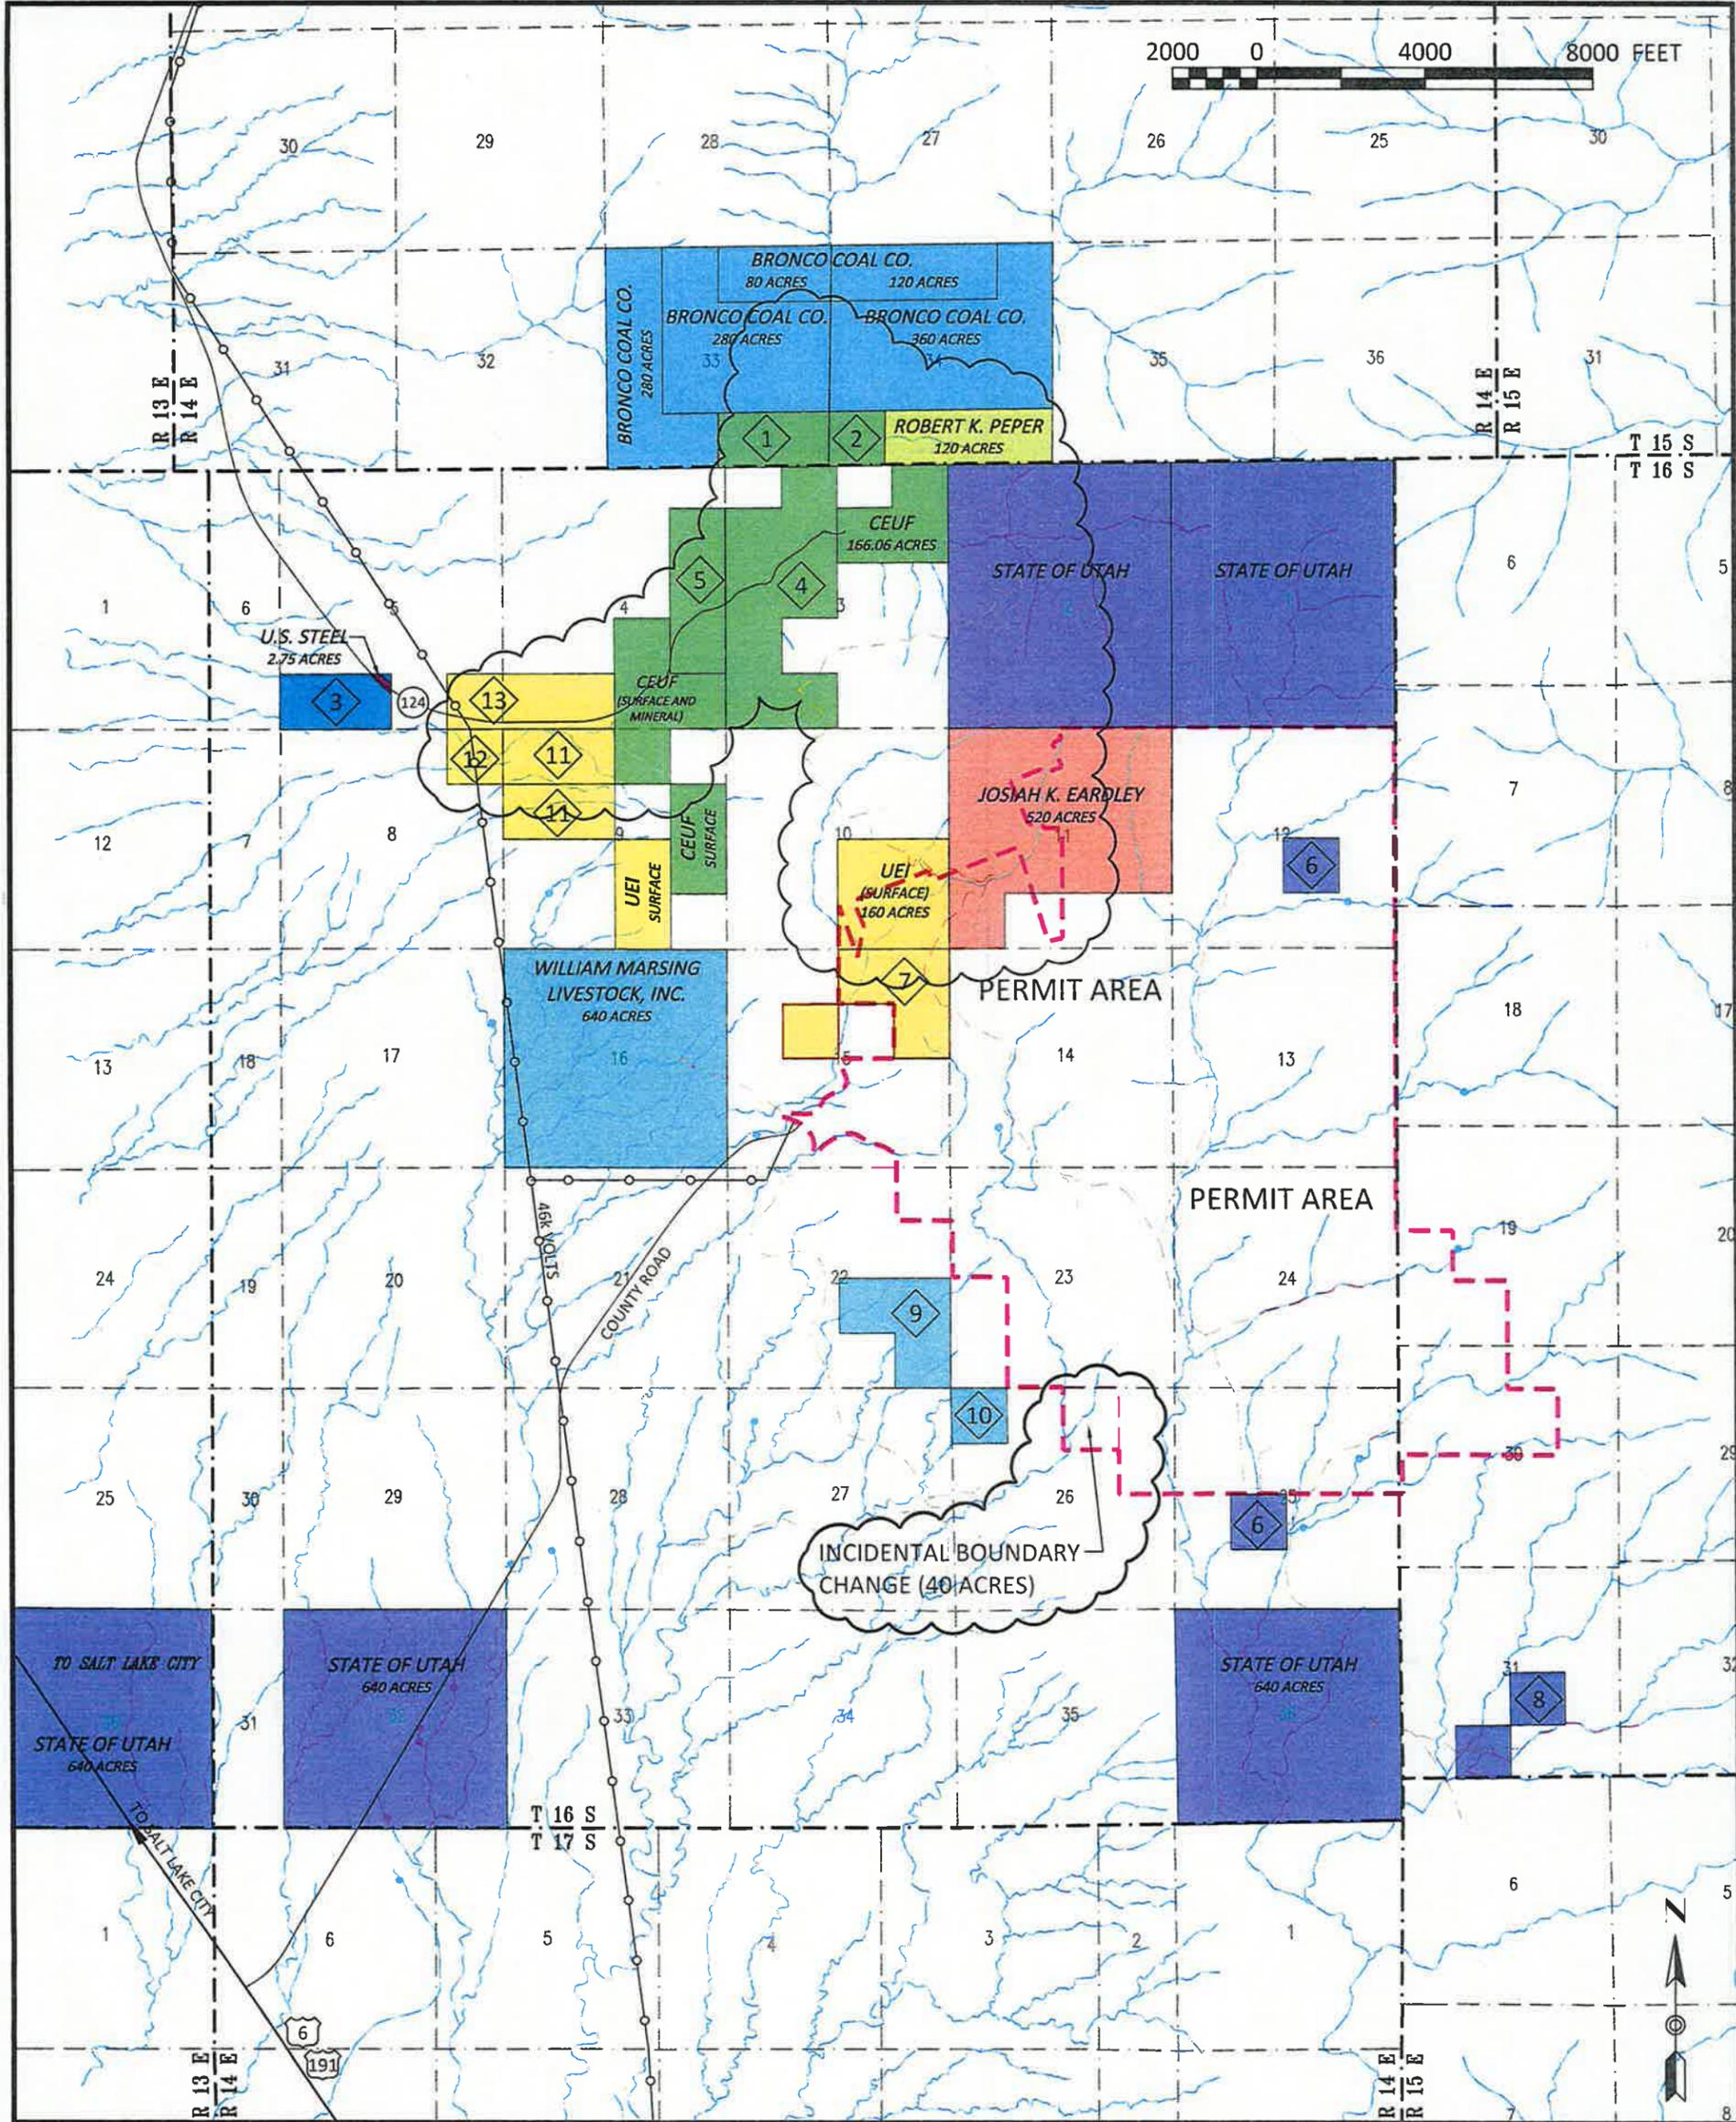

KEYED PROPERTY NOTES

- | | | | |
|--|--|---|---|
| 1 CEUF (SURFACE AND MINERAL)
80 ACRES | 5 CEUF (SURFACE AND MINERAL)
114.82 ACRES | 9 WILLIAM MARSING LIVESTOCK, INC.
120 ACRES | 13 UEI (SURFACE AND MINERAL)
35.41 ACRES |
| 2 CEUF (SURFACE AND MINERAL)
40 ACRES | 6 STATE OF UTAH
40 ACRES | 10 WILLIAM MARSING LIVESTOCK, INC.
400 ACRES | |
| 3 EMERY COUNTY
77.25 ACRES | 7 UEI (SURFACE)
160 ACRES | 11 UEI (SURFACE AND MINERAL)
80 ACRES | |
| 4 CEUF (SURFACE AND MINERAL)
231.85 ACRES | 8 STATE OF UTAH
80 ACRES | 12 UEI (SURFACE AND MINERAL)
40 ACRES | |

RECEIVED
FEB 09 2016
 DIV. OF OIL, GAS & MINING

LEGEND:

ALL LANDS OWNED BY BUREAU OF LAND MANAGEMENT UNLESS NOTED OTHERWISE.

- PERMIT AREA: - - - - -
- Emery County
 - Brent M. Davies (Bronco Coal Co.)
 - Josiah K. Eardley
 - CEUF

- UtahAmerican Energy, Inc.
- W. Marsing Livestock, Inc.
- Robert K. Peper
- U.S. Steel
- State of Utah



REVISIONS	
DATE	BY
AUG. 2000	BJ
DEC. 2000	BJ
SEPT. 2002	RJM
AUG. 2003	RJM
DEC. 2005	RJM
FEB. 8, 2016	PJJ

SURFACE OWNERSHIP

LILA CANYON MINE

23415 North Lila Canyon Road
Green River, Utah 84525

DOG M PERMIT# C0070013


DESIGN BY: EIS

SCALE: 1" = 4,000'

ORIGINAL DATE: JULY 1999

G:\Current Drawings\MPR Maps\Lila Canyon\IBC Sect 26 Breakouts\Plate 4-1 Surface Ownership 01-2016.dwg, Plate 4-1, 2/5/2016 1:45:45 PM, 1:1

2000 0 4000 8000 FEET

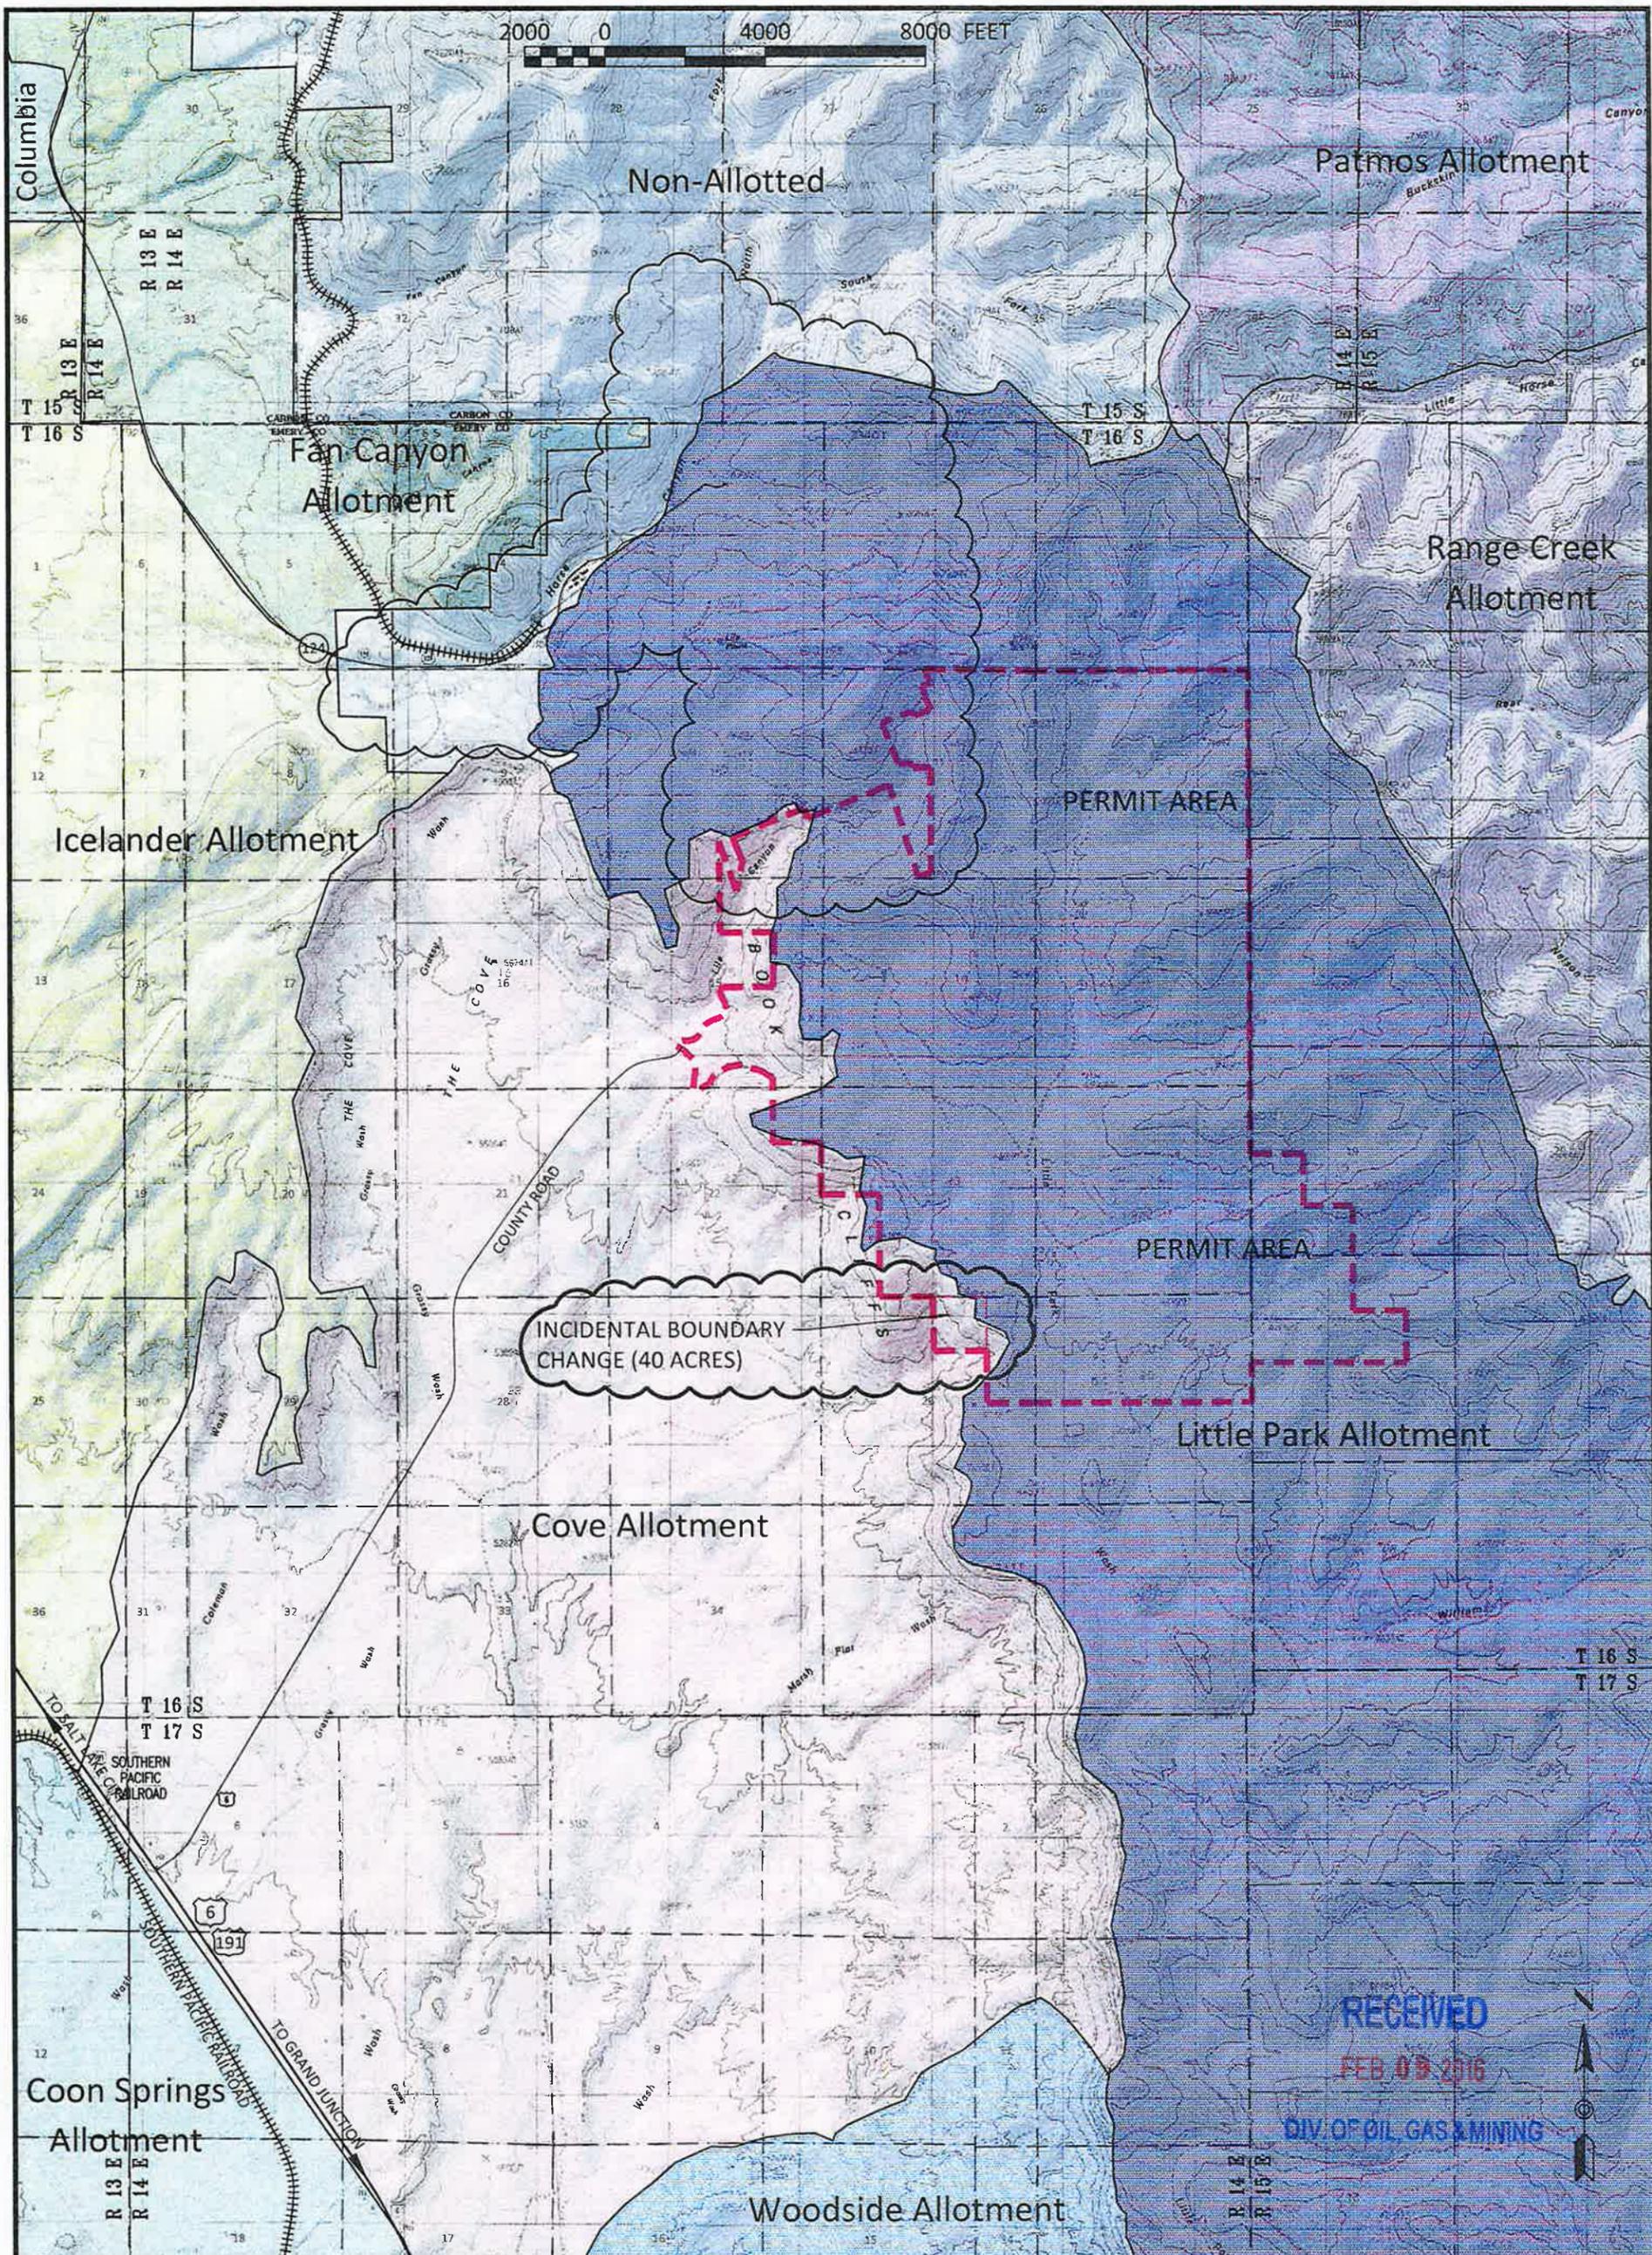

RECEIVED
FEB 09 2016
DIV. OF OIL GAS & MINING

LEGEND:

GRAZING ALLOTMENTS:

- Columbia Allotment
- Coon Springs Allotment
- Cove Allotment
- Fan Canyon Allotment
- Icelander Allotment
- Little Park Allotment
- Non-Allotted
- Patmos Allotment
- Range Creek Allotment
- Woodside Allotment

PERMIT AREA : - - - - -




REVISIONS

DATE	BY
AUG. 29, 2000	BJ
DEC. 14, 2000	BJ
SEPT. 19, 2002	RJM
FEB. 8, 2016	PJJ

GRAZING ALLOTMENTS

LILA CANYON MINE
 23415 North Lila Canyon Road
 Green River, Utah 84525
 DOGM PERMIT# C0070013
 DESIGN BY: **EIS** SCALE: 1" = 4,000'
 ORIGINAL DATE: APRIL 1998

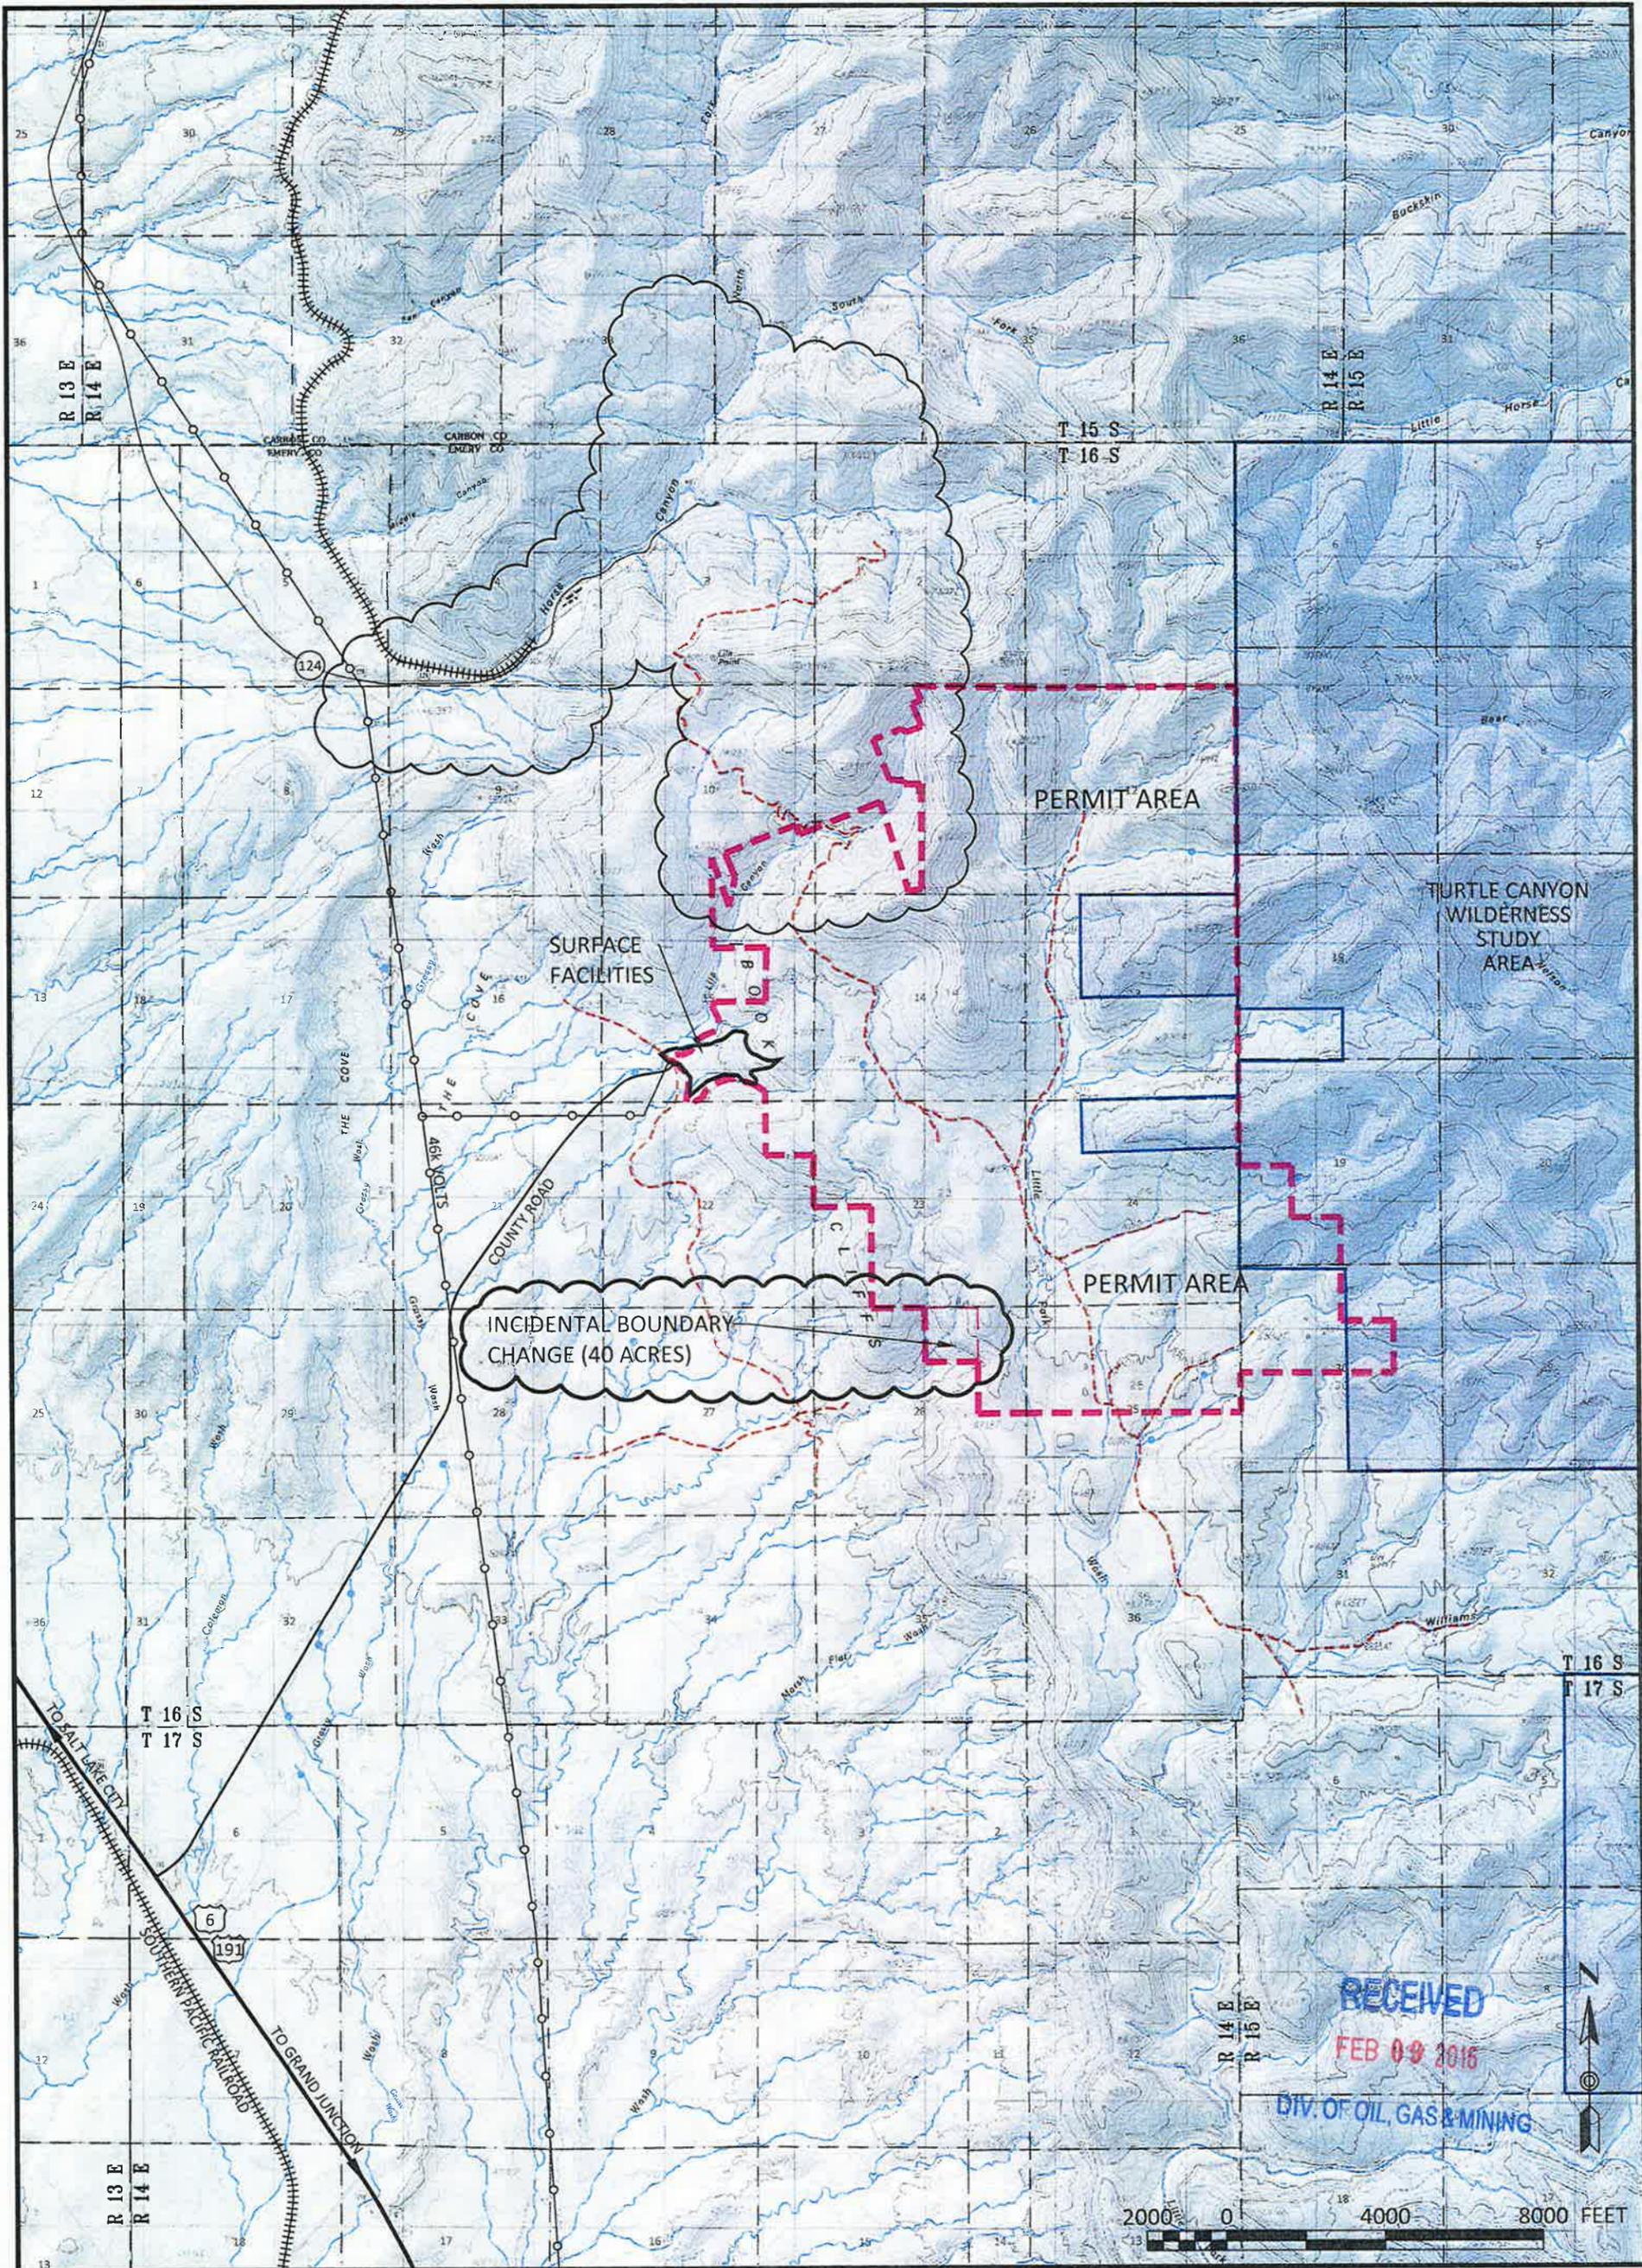

LEGEND:

- TURTLE CANYON WSA :
- PERMIT AREA :
- EPHEMERAL STREAM :




REVISIONS

DATE	BY
12/2000	BJ
09/2002	RJM
02/08/2016	PJJ

AREA OF WILDERNESS CHARACTER

LILA CANYON MINE
 23415 North Lila Canyon Road
 Green River, Utah 84525
 DOGM PERMIT# C0070013
 DESIGN BY: EIS
 SCALE: 1" = 4,000'
 ORIGINAL DATE: SEPT. 2000

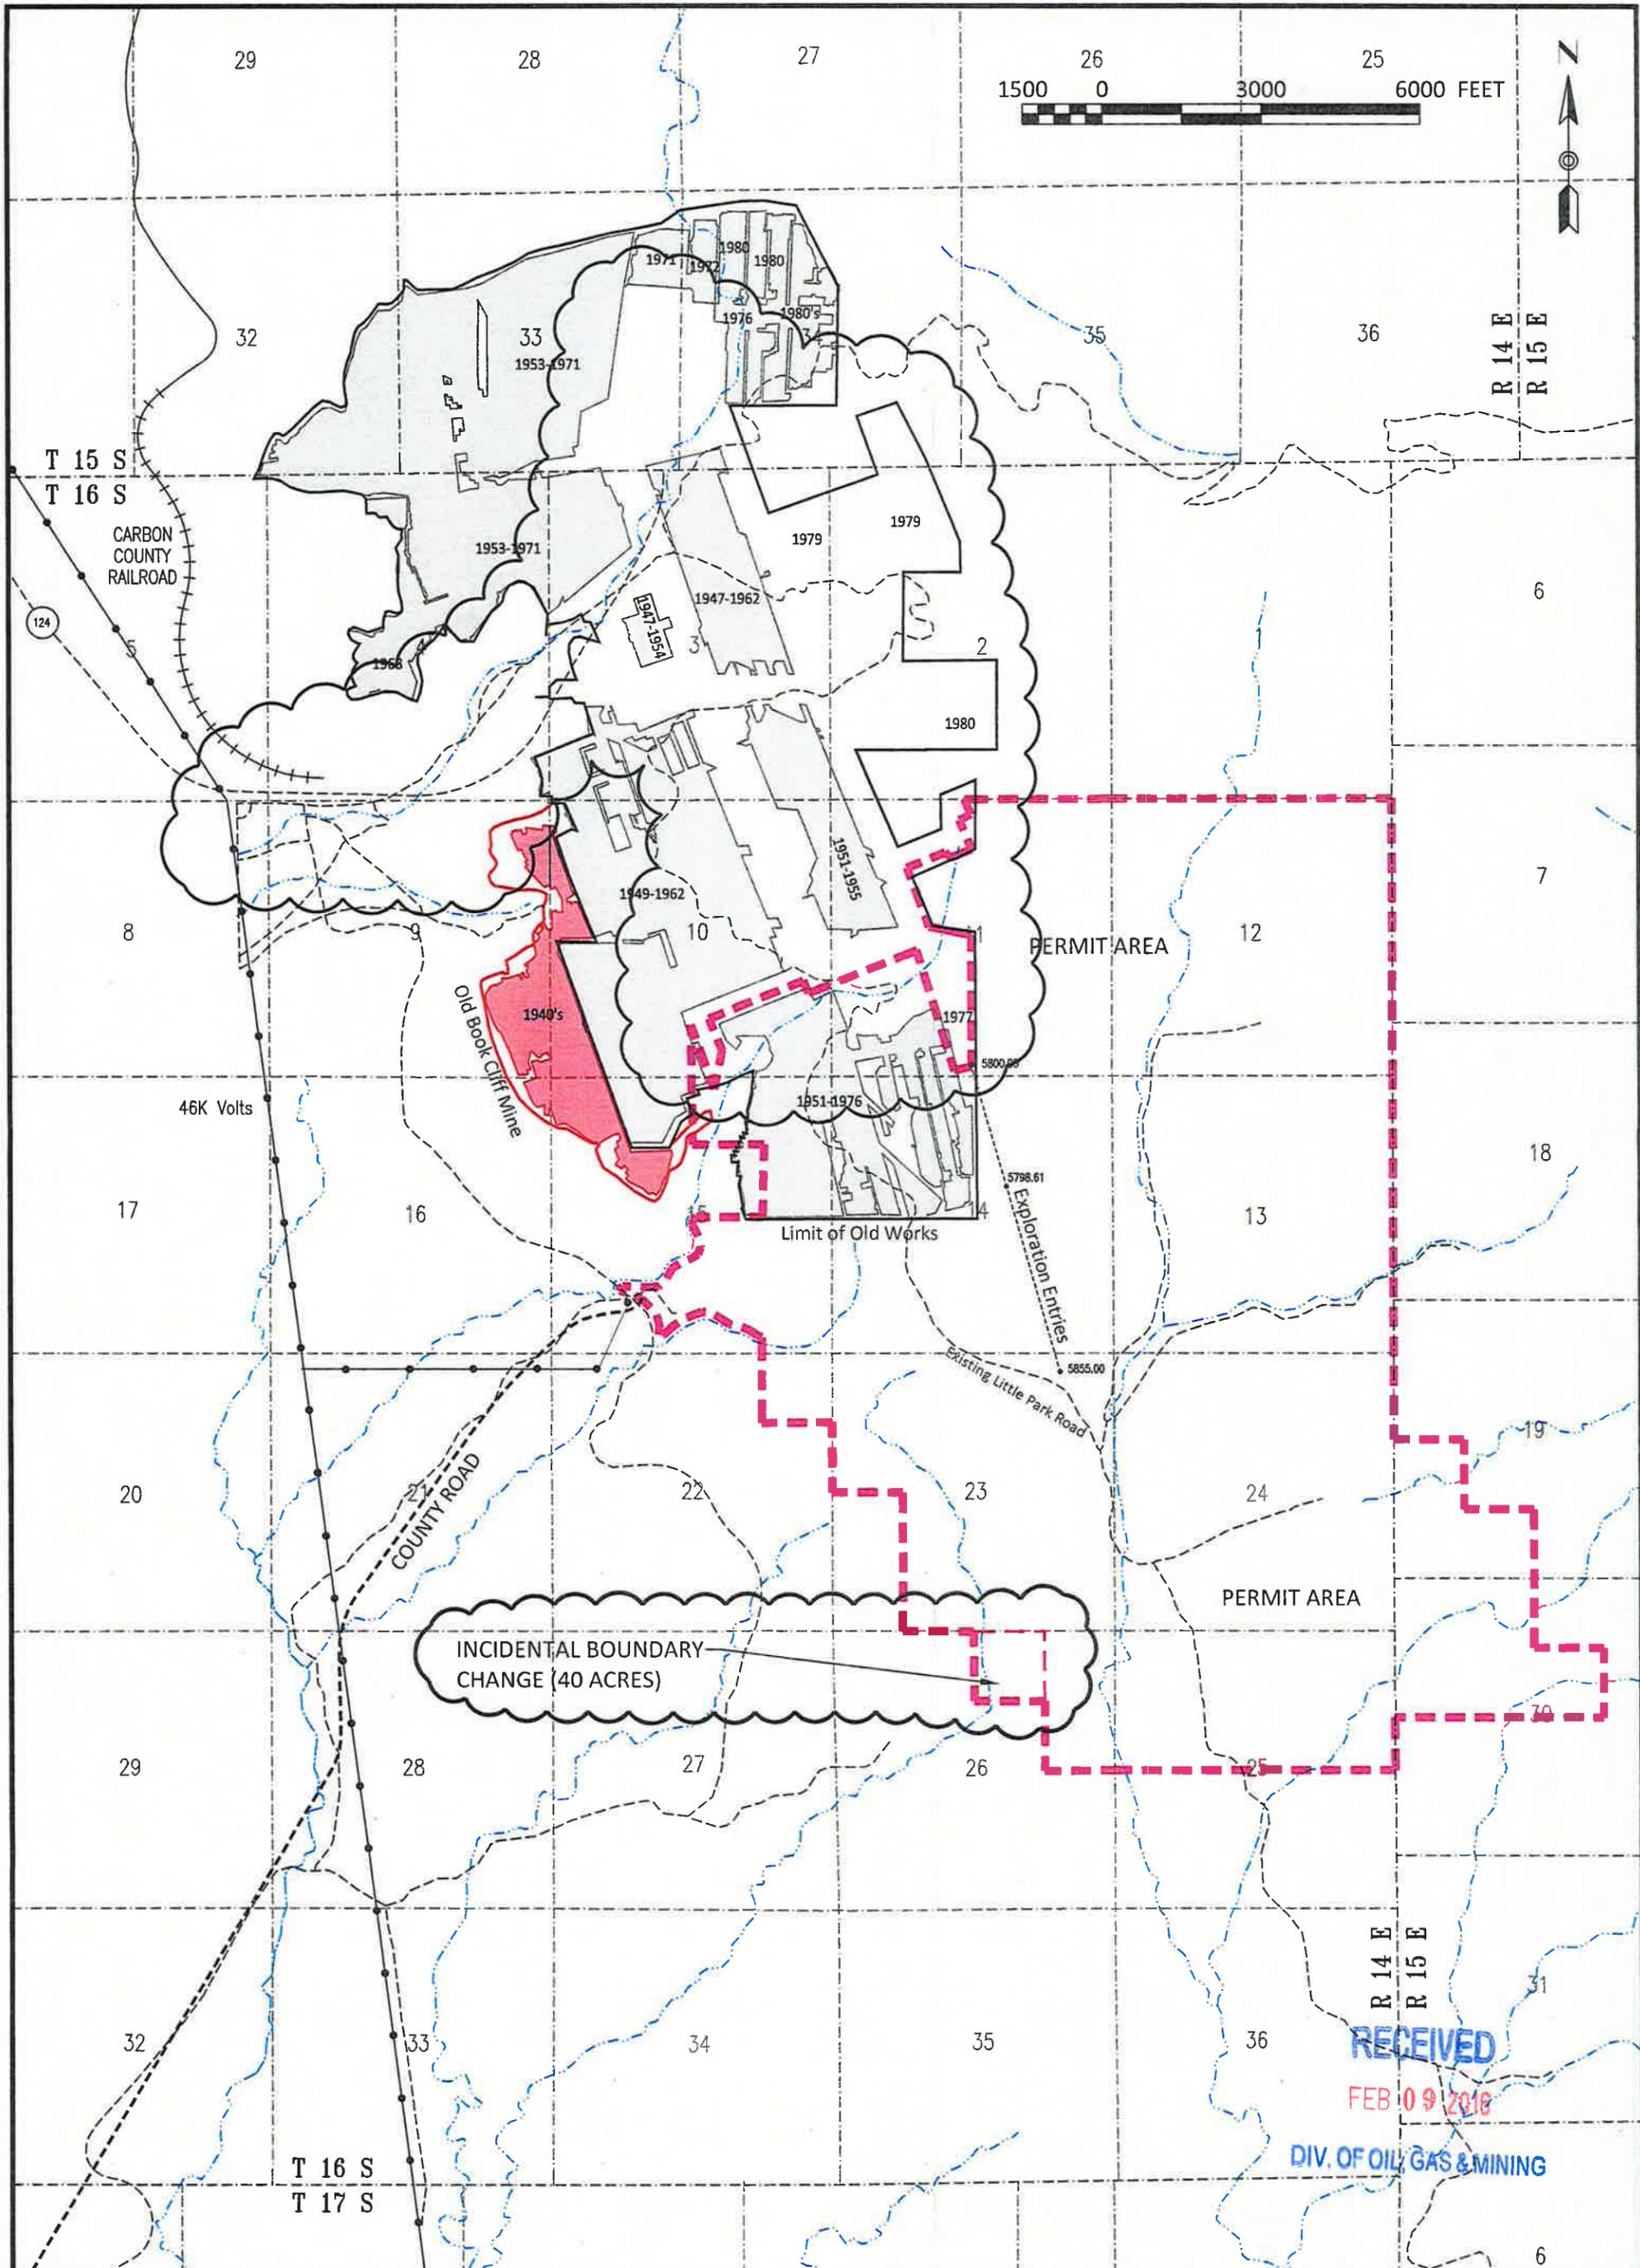

LEGEND:

- PERMIT AREA : - - - - -
- EXISTING ROADS : - - - - -
- LIMIT OF OLD WORKS : — — — — —
- BOOK CLIFFS COAL COMPANY : — — — — —
- EXPLORATION ENTRIES : - · - · - ·
- EPHEMERAL STREAMS : ~ ~ ~ ~ ~



REVISIONS	
DATE	BY
8/29/2000	BJ
12/14/2000	BJ
09/20/2002	RJM
12/29/2004	RJM
02/08/2016	PJJ

PREVIOUSLY MINED AREAS

LILA CANYON MINE
 23415 North Lila Canyon Road
 Green River, Utah 84525

DOGMM PERMIT# C0070013

DESIGN BY: EIS

SCALE: 1" = 3,000'
 ORIGINAL DATE: MAY 1998



PLATE 5-1

RECEIVED

FEB 09 2016

DIV. OF OIL, GAS & MINING

G:\Current Drawings\MPR Maps\Lila Canyon\IBC Sect 26 Breakouts\Plate 5-1 Previously Mined Areas 01-2016.dwg, Plate 5-1, 2/5/2016 1:50:39 PM, 1:1

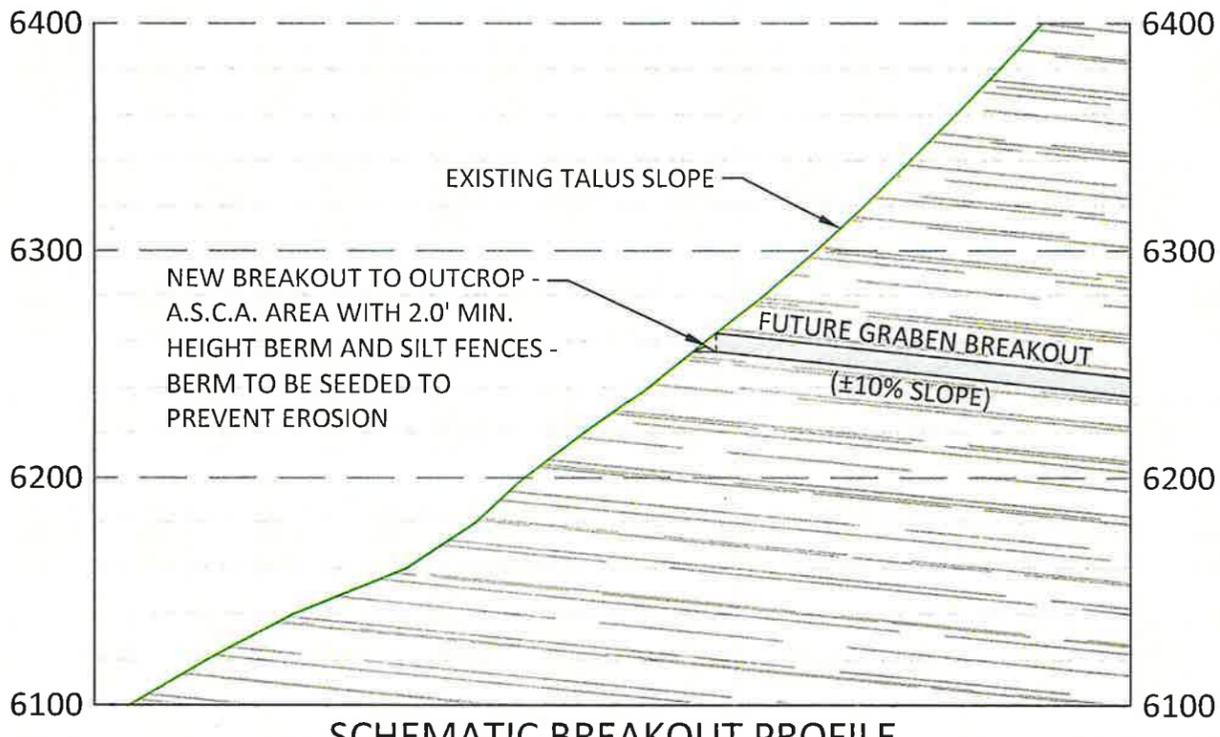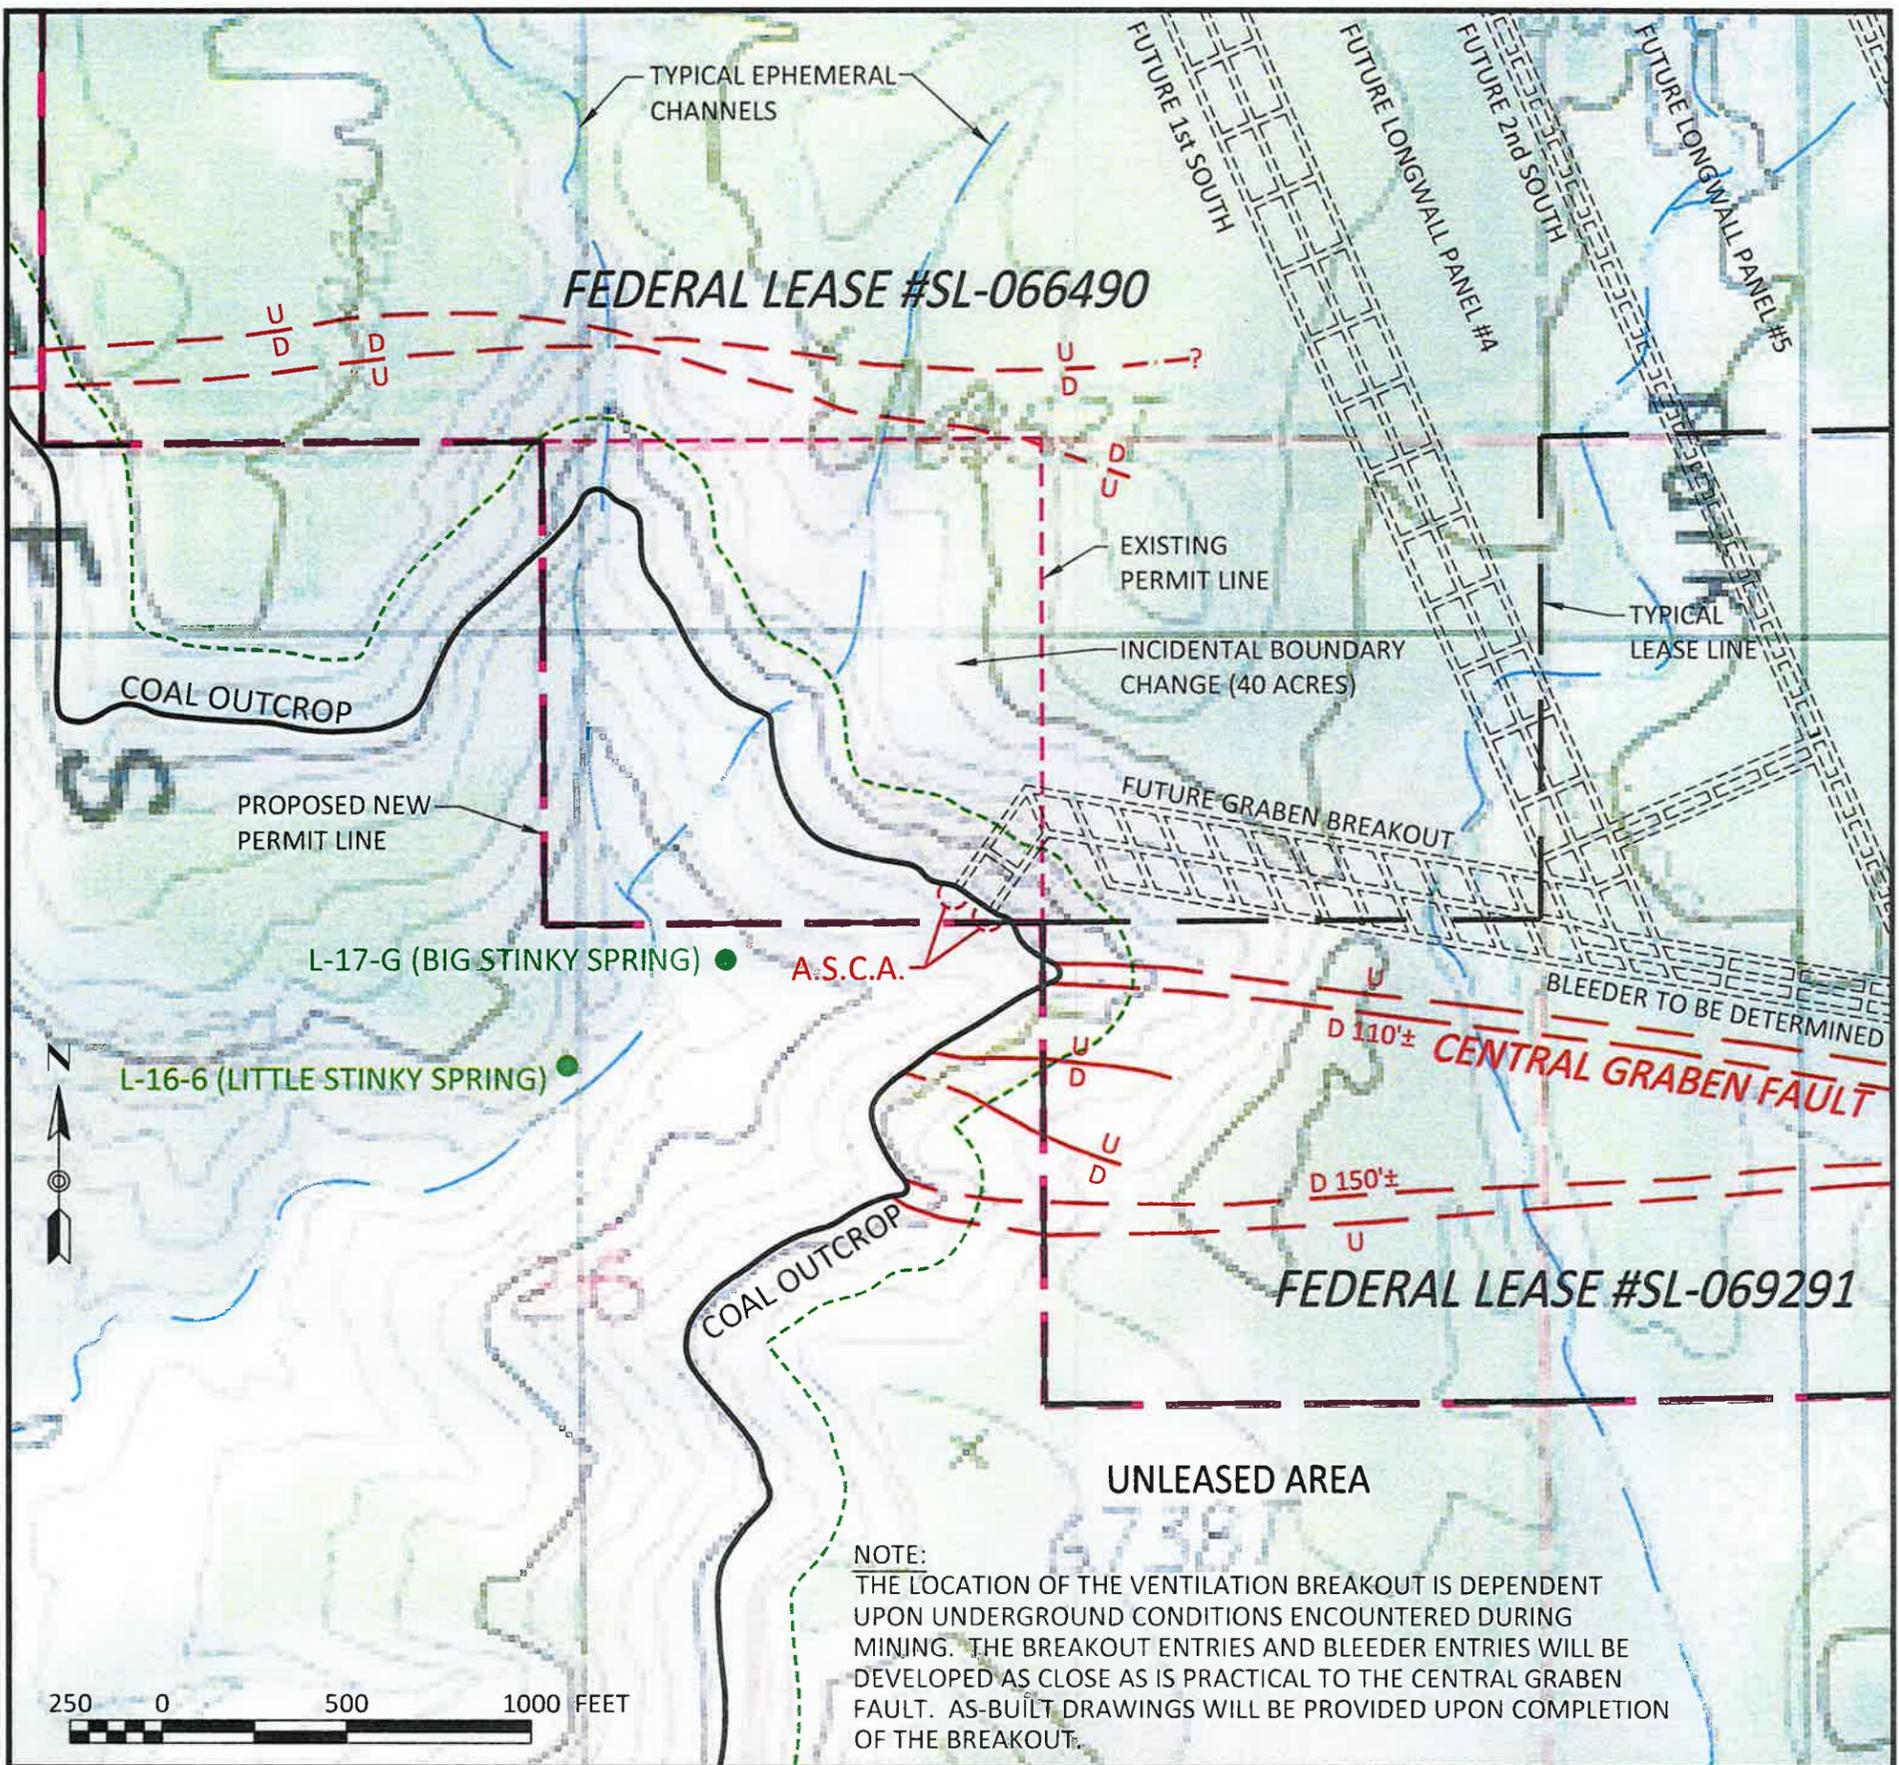

RECEIVED
FEB 09 2016
 DIV. OF OIL, GAS & MINING

SCHMATIC BREAKOUT PROFILE

- LEGEND:**
- PERMIT AREA :
 - EPHEMERAL CHANNEL :
 - COAL OUTCROP :
 - FAULTS :
 - 200' OUTCROP BARRIER :
 - SPRING LOCATION :
 - TYPICAL FUTURE MINING : (UNDERGROUND) :



REVISIONS	
DATE	BY

IBC AREA - GRABEN BREAKOUT


LILA CANYON MINE

23415 North Lila Canyon Road
 Green River, Utah 84525

DOG M PERMIT# C0070013

DESIGN BY: UEI
 SCALE: AS SHOWN
 ORIGINAL DATE: 8 FEB. 2016

PLATE 5-2a

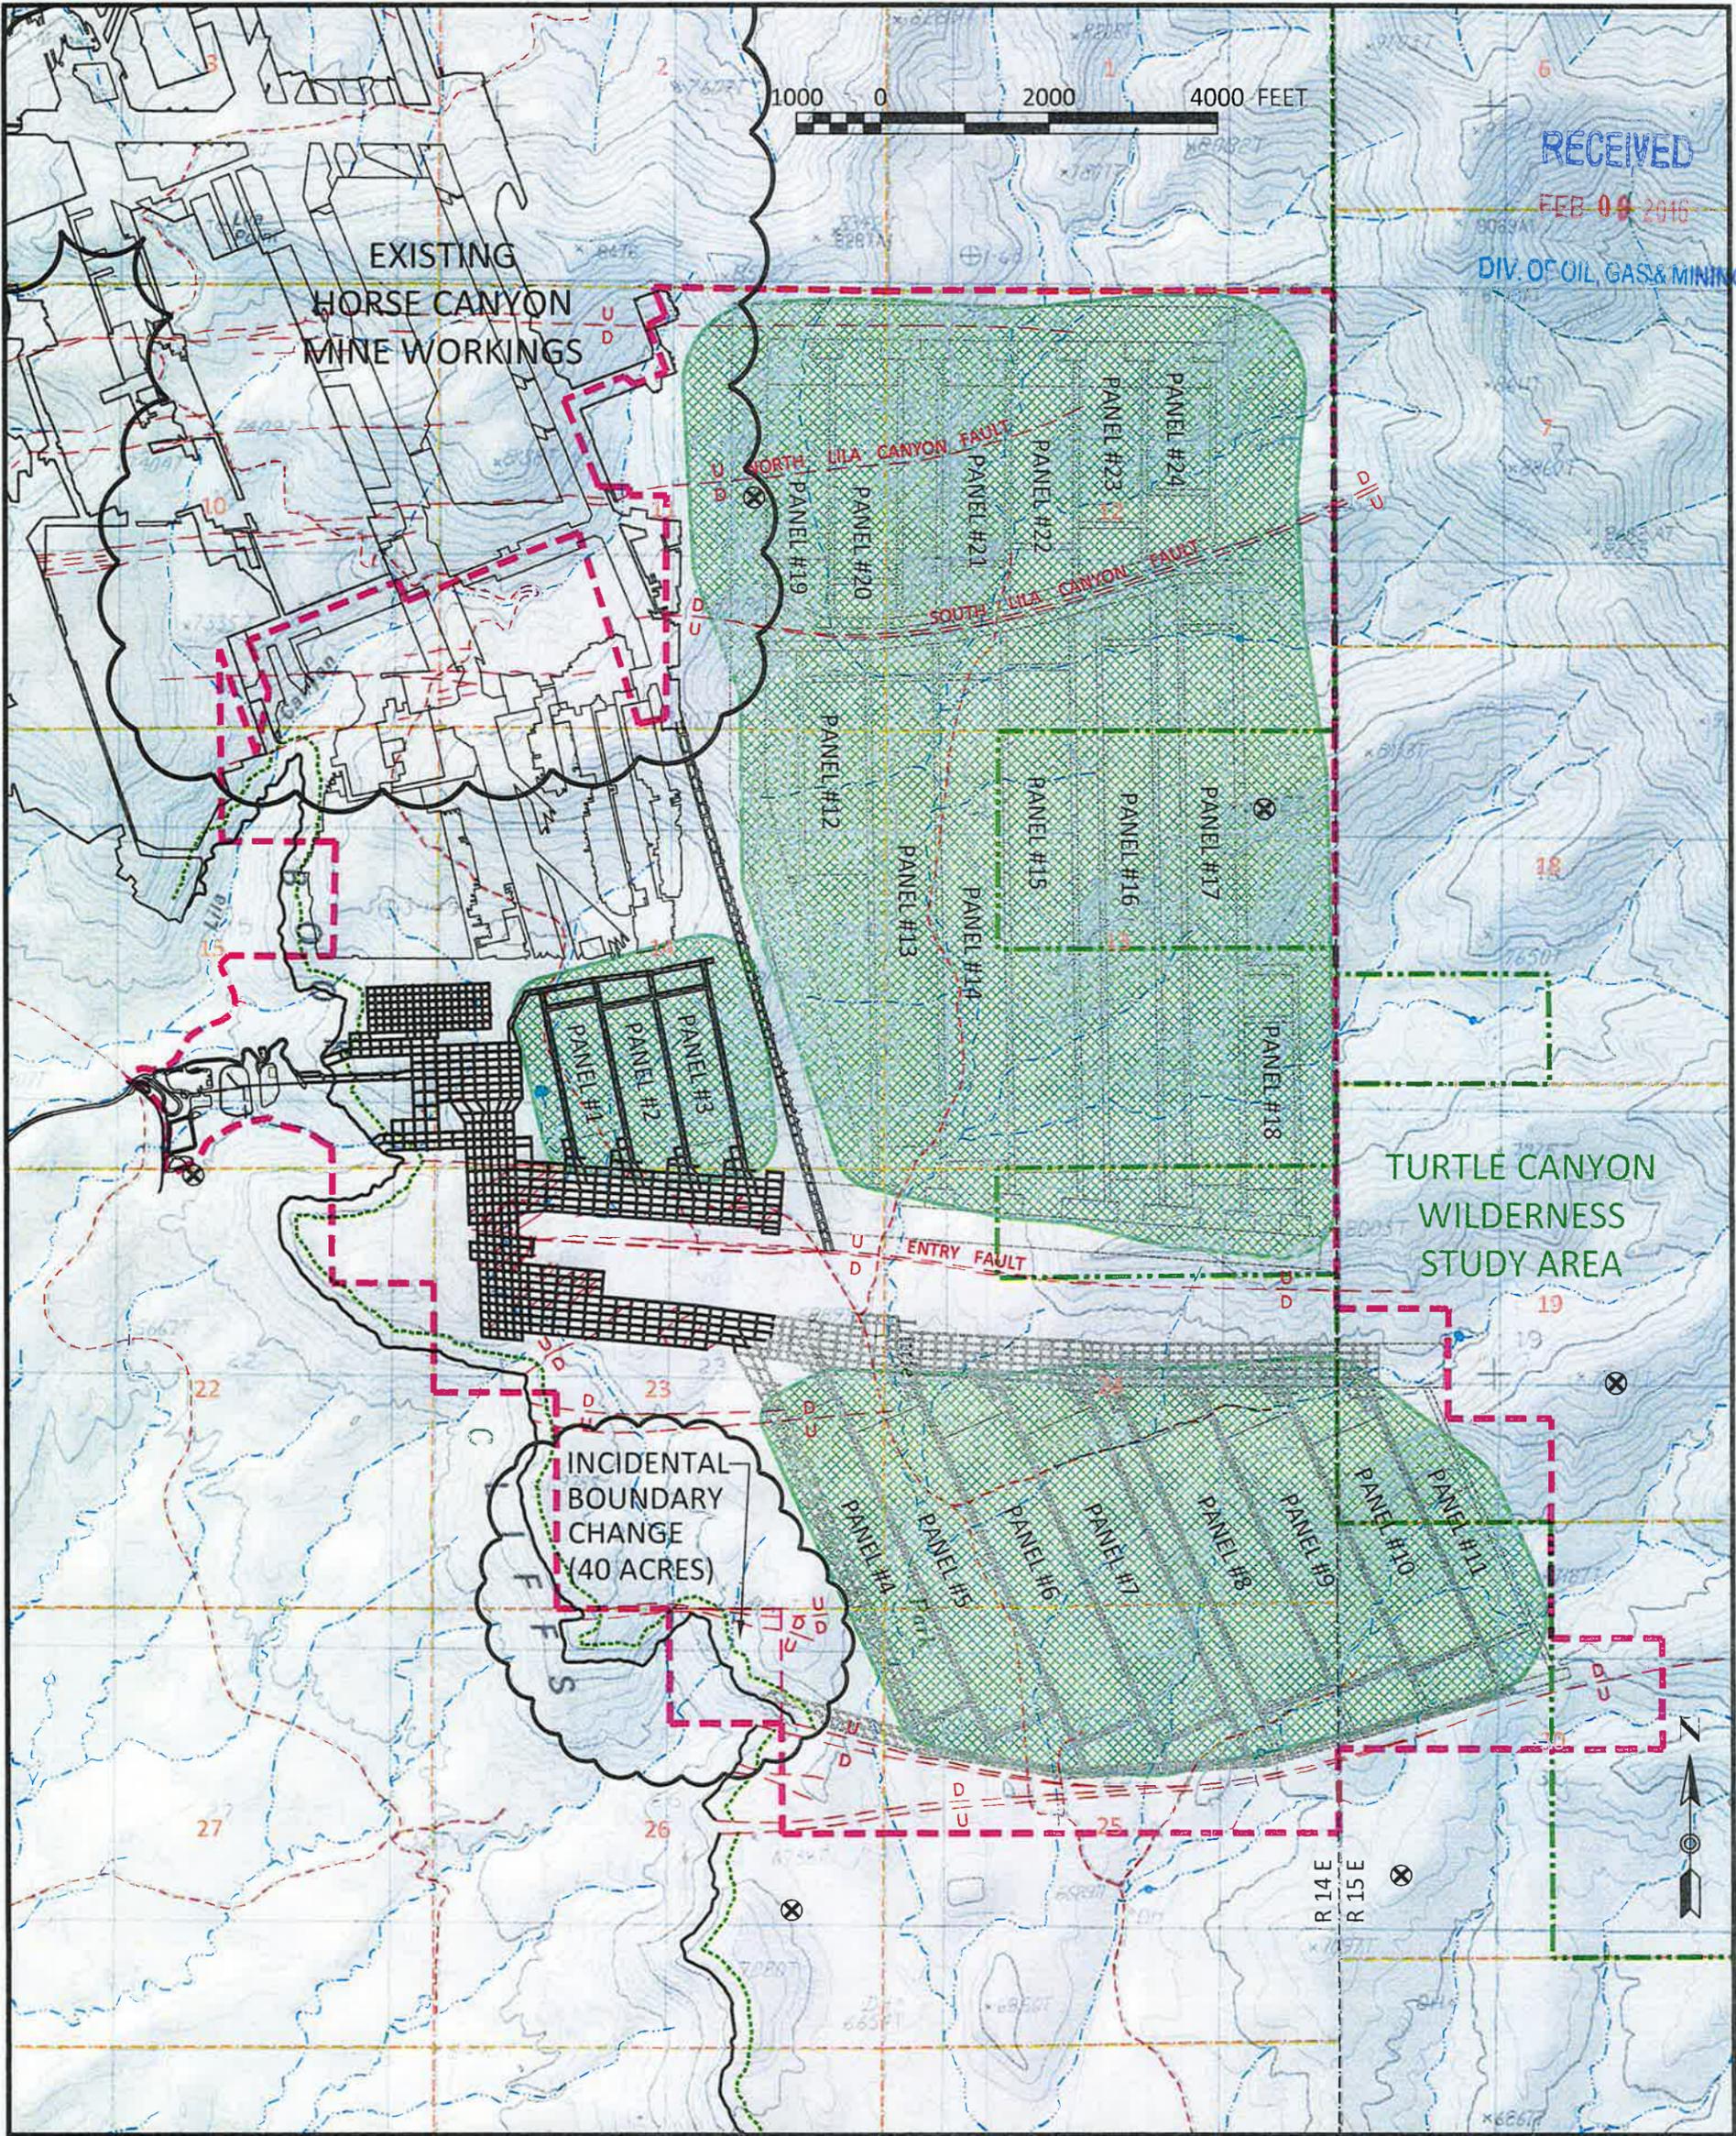

NOTES:

1. Mine projections are subject to change depending on conditions encountered in the underground mine workings.
2. Actual mine works are shown as of January 31, 2016.
3. Any mine projections depicted in the fringe areas beyond the existing permit area are speculative and based on future reserve acquisitions.
4. No mining will be conducted in these areas unless those reserves are acquired in the future and permitted according to federal, state, and local permitting requirements.
5. UtahAmerican Energy, Inc. acknowledges that permission to mine within the permit boundary does not imply permission to mine beyond the permit boundary.
6. Longwall panels will be reconfigured as needed to prevent unauthorized subsidence beyond the permit area if extended reserves are not acquired in the future.
7. Additional control points may be added as mining advances.

LEGEND:

- PERMIT AREA :
- EPHEMERAL CHANNEL :
- PAVED ROAD :
- UNPAVED ROAD :
- COAL OUTCROP :
- FAULTS :
- WILDERNESS STUDY AREA :
- OUTCROP BARRIER :
- MAXIMUM EXTENT OF SUBSIDENCE: (USING 21.5° DRAW ANGLE) :

PROPOSED SUBSIDENCE POINT :



REVISIONS


DATE	BY	DATE	BY
NOV. 20, 1999	BJ	FEBRUARY 2007	RJM
AUG. 29, 2000	BJ	FEB. 8, 2016	PJJ
JAN. 09, 2001	BJ		
MAR. 21, 2001	BJ		
SEPT. 20, 2002	RJM		
AUG. 19, 2003	RJM		
DEC. 20, 2004	RJM		
JANUARY 2005	RJM		

SUBSIDENCE CONTROL MAP

LILA CANYON MINE
 23415 North Lila Canyon Road
 Green River, Utah 84525
 DOGM PERMIT# C0070013
 DESIGN BY: UEI
 SCALE: 1" = 2,000'
 ORIGINAL DATE: NOV. 1999
 PLATE 5-3



RECEIVED
 FEB 09 2016
 DIV. OF OIL, GAS & MINING
 R 14 E
 R 15 E

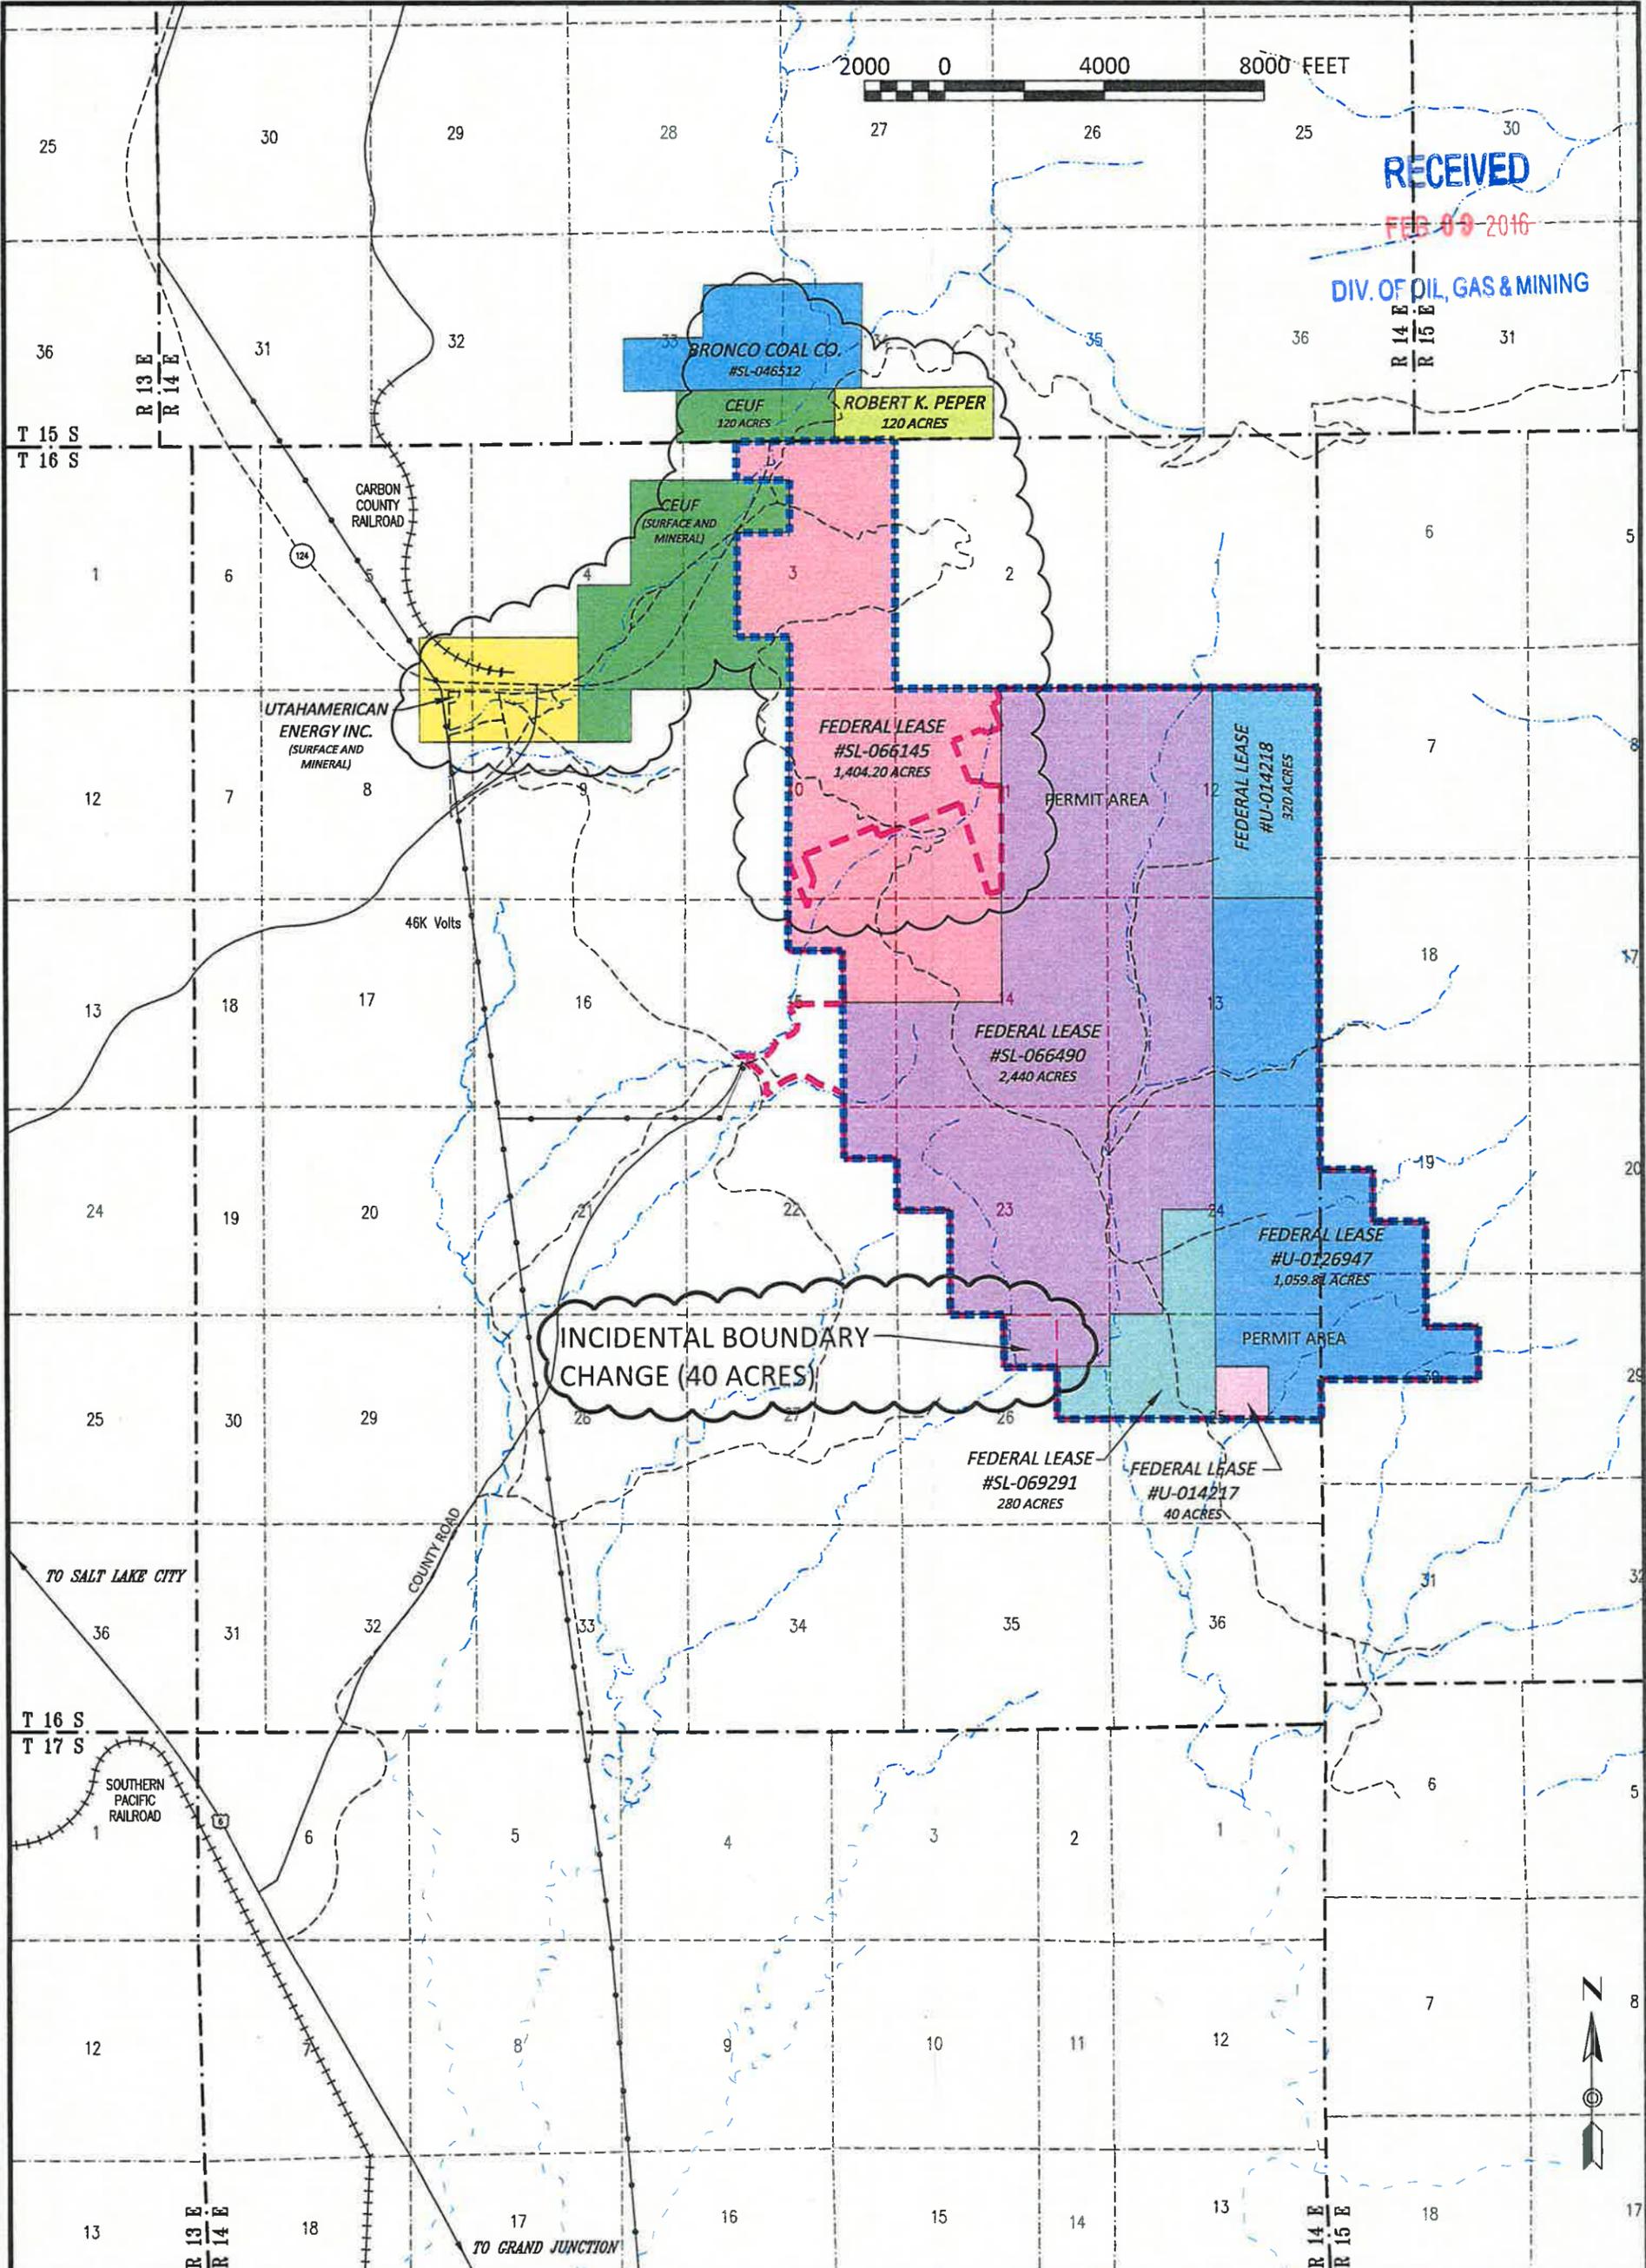

INCIDENTAL BOUNDARY CHANGE (40 ACRES)

LEGEND:

PERMIT AREA :		LMU #UTU-73516:	
LEASE SL-066490		LEASE SL-066145	
LEASE U-014218		LEASE U-014217	
LEASE U-0126947		LEASE SL-069291	
LEASE SL-046512		ROBERT K PEPER	
CEUF		UtahAmerican Energy	




REVISIONS

DATE	BY
8/29/2000	BJ
12/13/2000	BJ
09/20/2002	RJM
09/08/2003	RJM
12/01/2005	RJM
02/08/2016	PJJ

COAL OWNERSHIP

LILA CANYON MINE
 23415 North Lila Canyon Road
 Green River, Utah 84525
 DOGM PERMIT# C0070013
 DESIGN BY: EIS SCALE: 1" = 4,000'
 ORIGINAL DATE: MARCH 1998

G:\Current Drawings\MRP Maps\Lila Canyon\IBC Sect 26 Breakouts\Plate 5-4 Coal Ownership 01-2016.dwg, Layout1, 2/5/2016 1:54:50 PM, 1:1

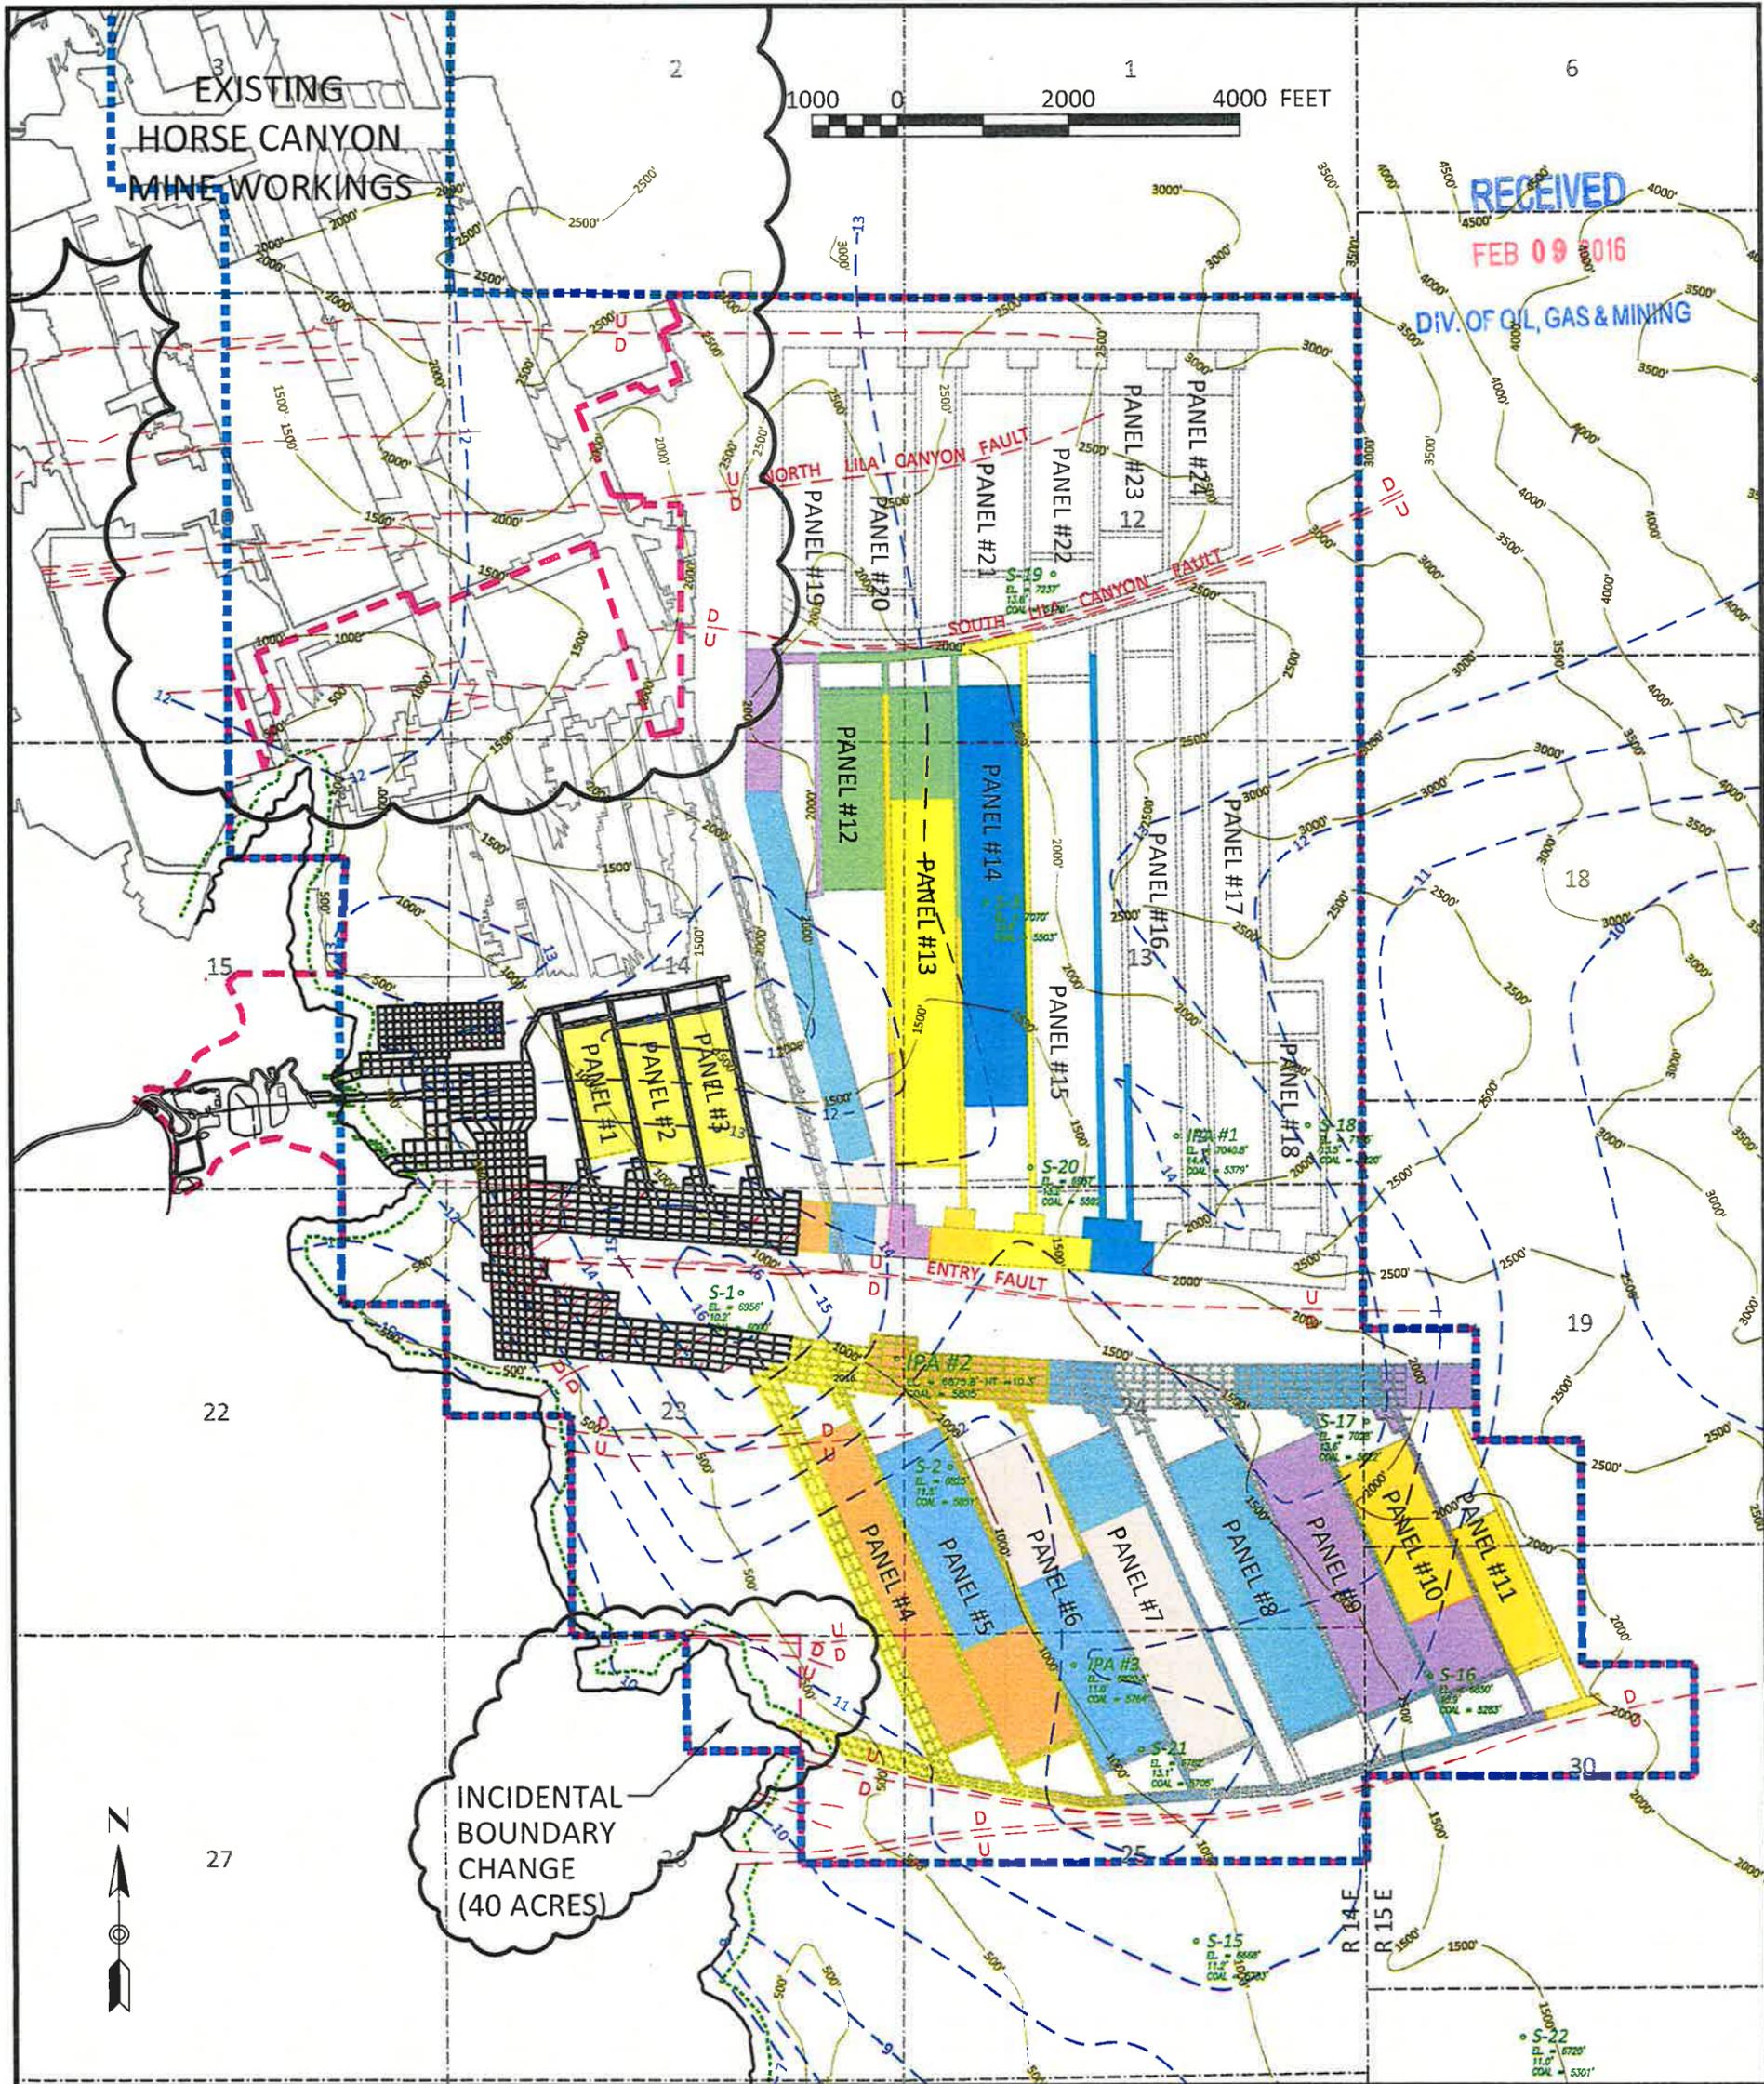

NOTES:

1. Mine projections are subject to change depending on conditions encountered in the underground mine workings.
2. Actual mine works are shown as of January 31, 2016.
3. Any mine projections depicted in the fringe areas beyond the existing permit area are speculative and based on future reserve acquisitions.
4. No mining will be conducted in these areas unless those reserves are acquired in the future and permitted according to federal, state, and local permitting requirements.
5. UtahAmerican Energy, Inc. acknowledges that permission to mine within the permit boundary does not imply permission to mine beyond the permit boundary.
6. Longwall panels will be reconfigured as needed to prevent unauthorized subsidence beyond the permit area if extended reserves are not acquired in the future.
7. Additional control points may be added as mining advances.



LEGEND:

- PERMIT AREA :
- COAL OUTCROP :
- FAULTS :
- OUTCROP BARRIER :
- SEAM THICKNESS ISOPACHS : (IN FEET)
- COVER (500' INTERVALS) :
- LMU #UTU-73516 :
- EXISTING MINE WORKINGS :

PROJECTED MINING:


- 2016
- 2017
- 2018
- 2019
- 2020
- 2021
- 2022
- 2023
- 2024
- 2025

REVISIONS

DATE	BY	DATE	BY
APR. 23, 1998	RJM		
AUG. 28, 2000	BJ		
DEC. 14, 2000	BJ		
SEPT. 20, 2002	RJM		
OCT. 15, 2003	RJM		
DEC. 29, 2004	RJM		
JAN. 14, 2005	RJM		
FEB. 8, 2016	PJ		

MINE MAP

LILA CANYON MINE
 23415 North Lila Canyon Road
 Green River, Utah 84525
 DOGM PERMIT# C0070013
 DESIGN BY: UEI
 SCALE: 1" = 2,000'
 ORIGINAL DATE: JAN.. 1999
 PLATE 5-5

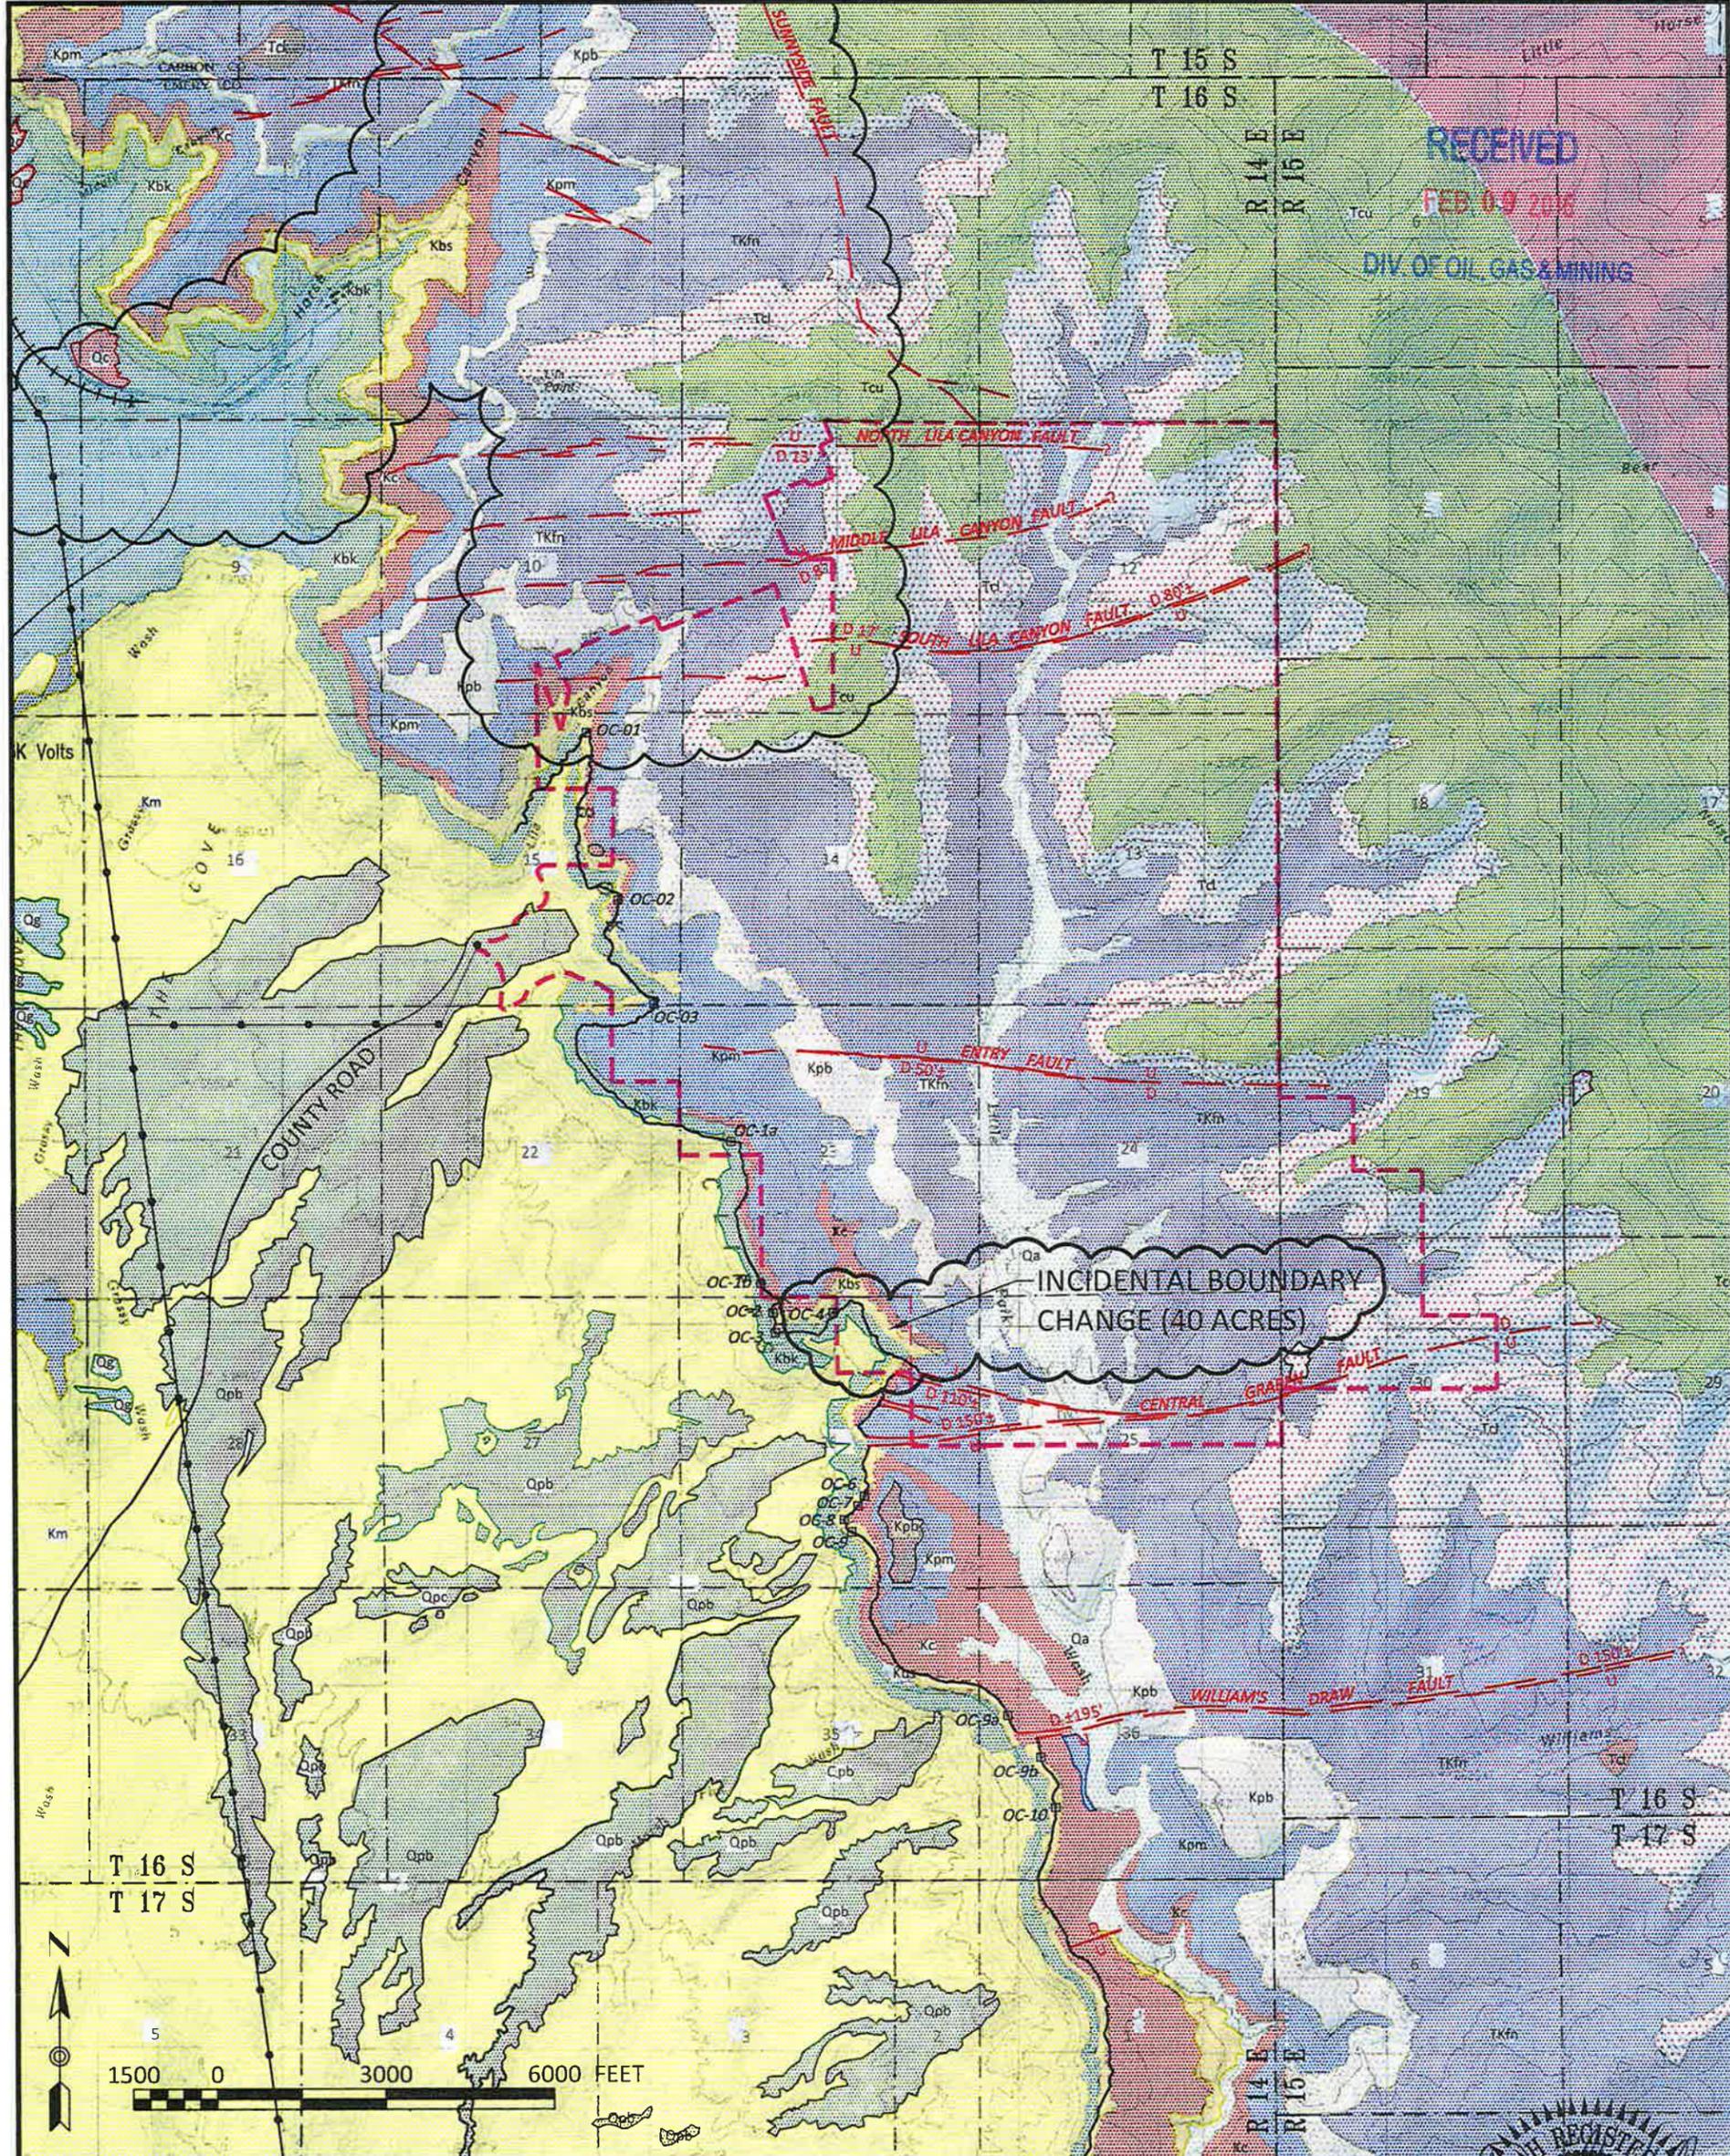


RECEIVED
FEB 09 2016
DIV OF OIL GAS & MINING

INCIDENTAL BOUNDARY CHANGE (40 ACRES)

LEGEND:

- YOUNGER SURFICIAL DEPOSITS: Stream alluvium
- YOUNGER SURFICIAL DEPOSITS: Gravel thin deposits
- OLDER SURFICIAL DEPOSITS: Colluvium & slopewash deposits
- OLDER SURFICIAL DEPOSITS: Alluvium fan deposits
- PEDIMENT DEPOSITS: Unit A
- PEDIMENT DEPOSITS: Unit B
- PEDIMENT DEPOSITS: Unit C
- COLTON FORMATION: Undivided
- COLTON FORMATION: Upper member
- COLTON FORMATION: Lower member
- FLAGSTAFF LIMESTONE AND NORTH HORN FORMATION:
- PRICE RIVER FORMATION: Bluecastle sandstone member
- PRICE RIVER FORMATION: Mudstone member
- CASTLEGATE SANDSTONE OF MESAVERDE GROUP:
- Upper mudstone member of Sunnyside member
- BLACKHAWK FORMATION OF MESAVERDE GROUP: Upper mudstone member of Kenilworth member
- MANCOS SHALE: Main body

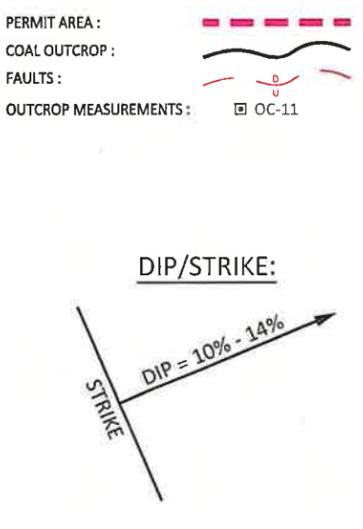

REVISIONS			
DATE	BY	DATE	BY
		11/20/99	BJ
		08/29/2000	BJ
		12/14/2000	BJ
		09/20/2002	RJM
		11/20/2006	TJS
		01/12/2007	RJM
		02/01/2007	RJM
		02/08/2016	PJJ



PROJECT AREA GEOLOGIC MAP

LILA CANYON MINE

23415 North Lila Canyon Road
Green River, Utah 84525

DOGM PERMIT# C0070013

DESIGN BY: EIS


SCALE: 1" = 3,000'

ORIGINAL DATE: MARCH 1998

PLATE 6-1

2000 0 4000 8000 FEET

RECEIVED
FEB 09 2016
DIV. OF OIL, GAS & MINING

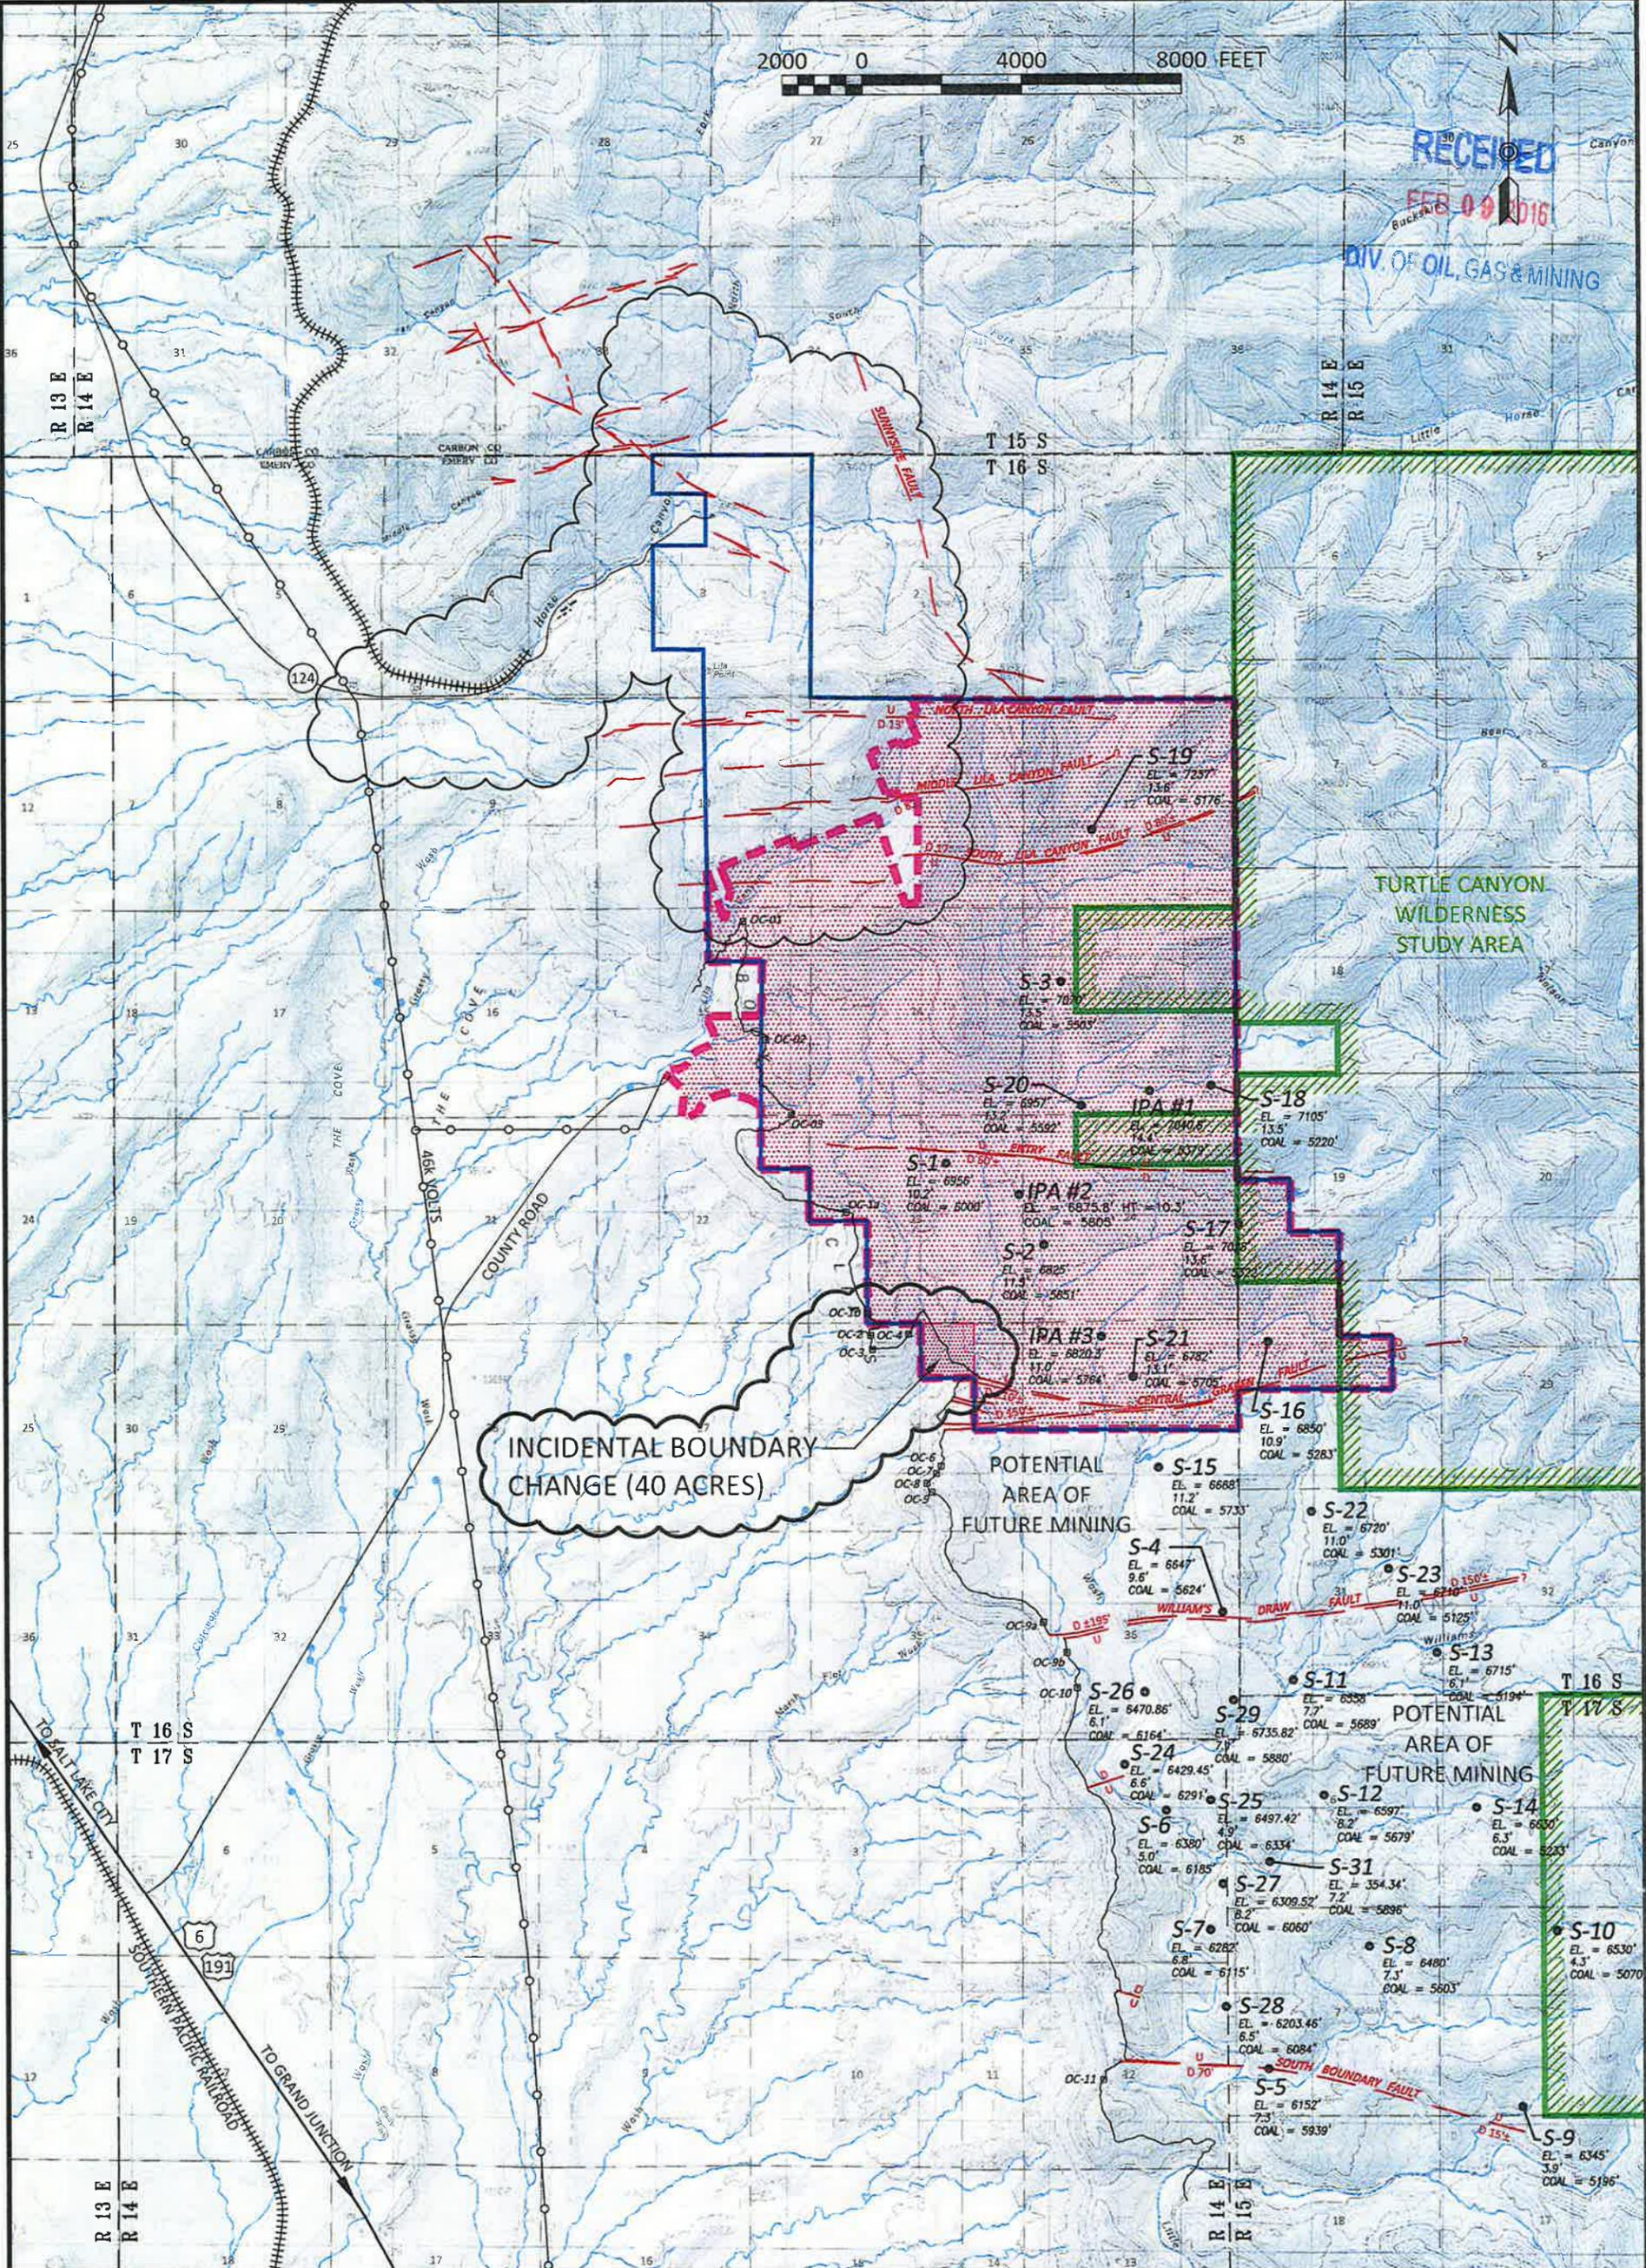

INCIDENTAL BOUNDARY CHANGE (40 ACRES)


POTENTIAL AREA OF FUTURE MINING

TURTLE CANYON WILDERNESS STUDY AREA

POTENTIAL AREA OF FUTURE MINING

LEGEND:

PERMIT AREA:	
COAL OUTCROP:	
FAULTS:	
OUTCROP MEASUREMENTS:	
LMU AREA:	
WILDERNESS STUDY AREA:	
DRILL HOLES:	
EPHEMERAL STREAMS:	

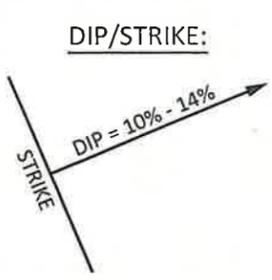

REVISIONS

DATE	BY
11/20/1999	BJ
08/29/2000	BJ
12/14/2000	BJ
APR. 19, 2002	RJM
SEPT. 20, 2002	RJM
DEC. 14, 2004	RJM
FEB. 8, 2016	PJJ

GENERAL GEOLOGY

LILA CANYON MINE	
23415 North Lila Canyon Road Green River, Utah 84525	
DOG M PERMIT# C0070013	
DESIGN BY: BLACKHAWK ENG.	SCALE: 1" = 4,000' ORIGINAL DATE: JAN. 1998


PLATE 6-2

1500 0 3000 6000 FEET

RECEIVED

FEB 09 2016

DIV. OF OIL, GAS & MINING

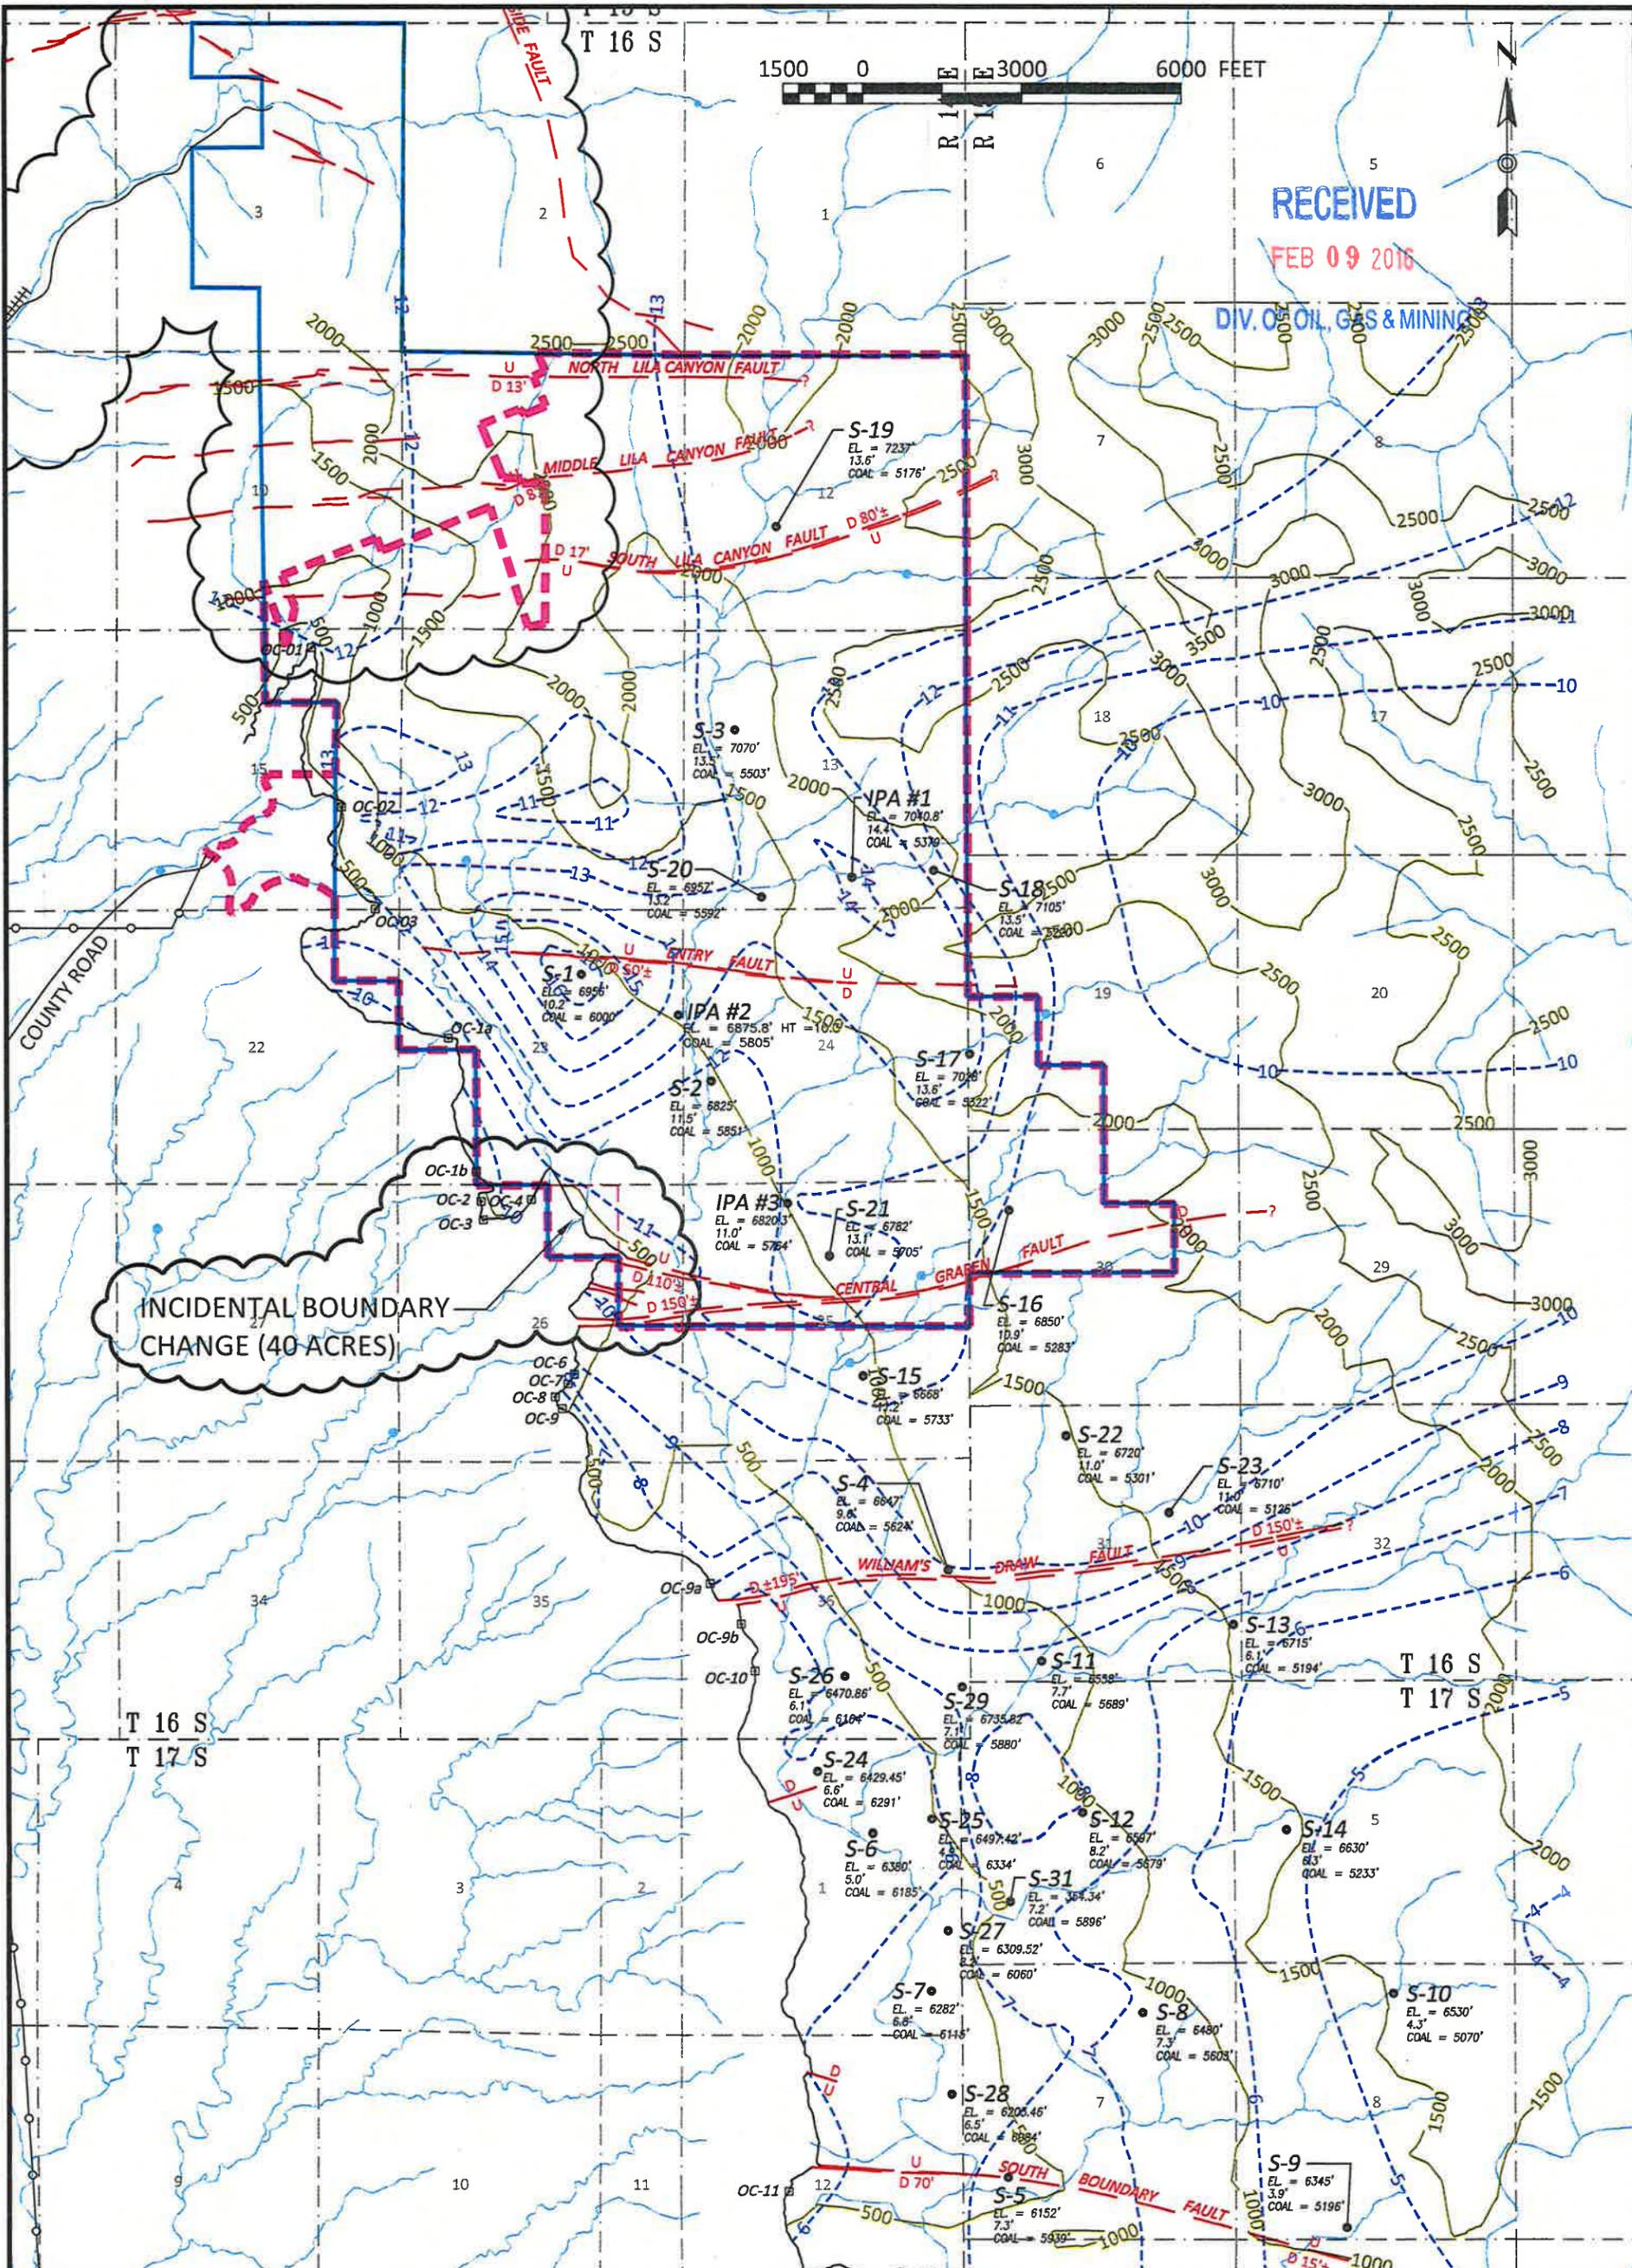


INCIDENTAL BOUNDARY CHANGE (40 ACRES)

LEGEND:

- PERMIT AREA :
- COAL OUTCROP :
- FAULTS :
- OUTCROP MEASUREMENTS :
- LMU AREA :
- DRILL HOLES :
- SEAM THICKNESS ISOPACHS :
- (IN FEET)
- COVER (500' INTERVALS) :

DIP/STRIKE:

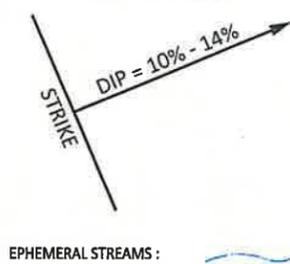

REVISIONS

DATE	BY
8/29/2000	BJ
12/14/2000	BJ
APR. 19, 2002	RJM
SEPT. 30, 2002	RJM
FEB. 8, 2016	PJJ

COAL THICKNESS ISOPACHS


LILA CANYON MINE
 23415 North Lila Canyon Road
 Green River, Utah 84525
 DOGM PERMIT# C0070013
 DESIGN BY: BLACKHAWK ENG.
 SCALE: 1" = 3,000'
 ORIGINAL DATE: JAN. 1998



1500 0 3000 6000 FEET

RECEIVED
FEB 09 2016


DIV. OF OIL, GAS & MINING

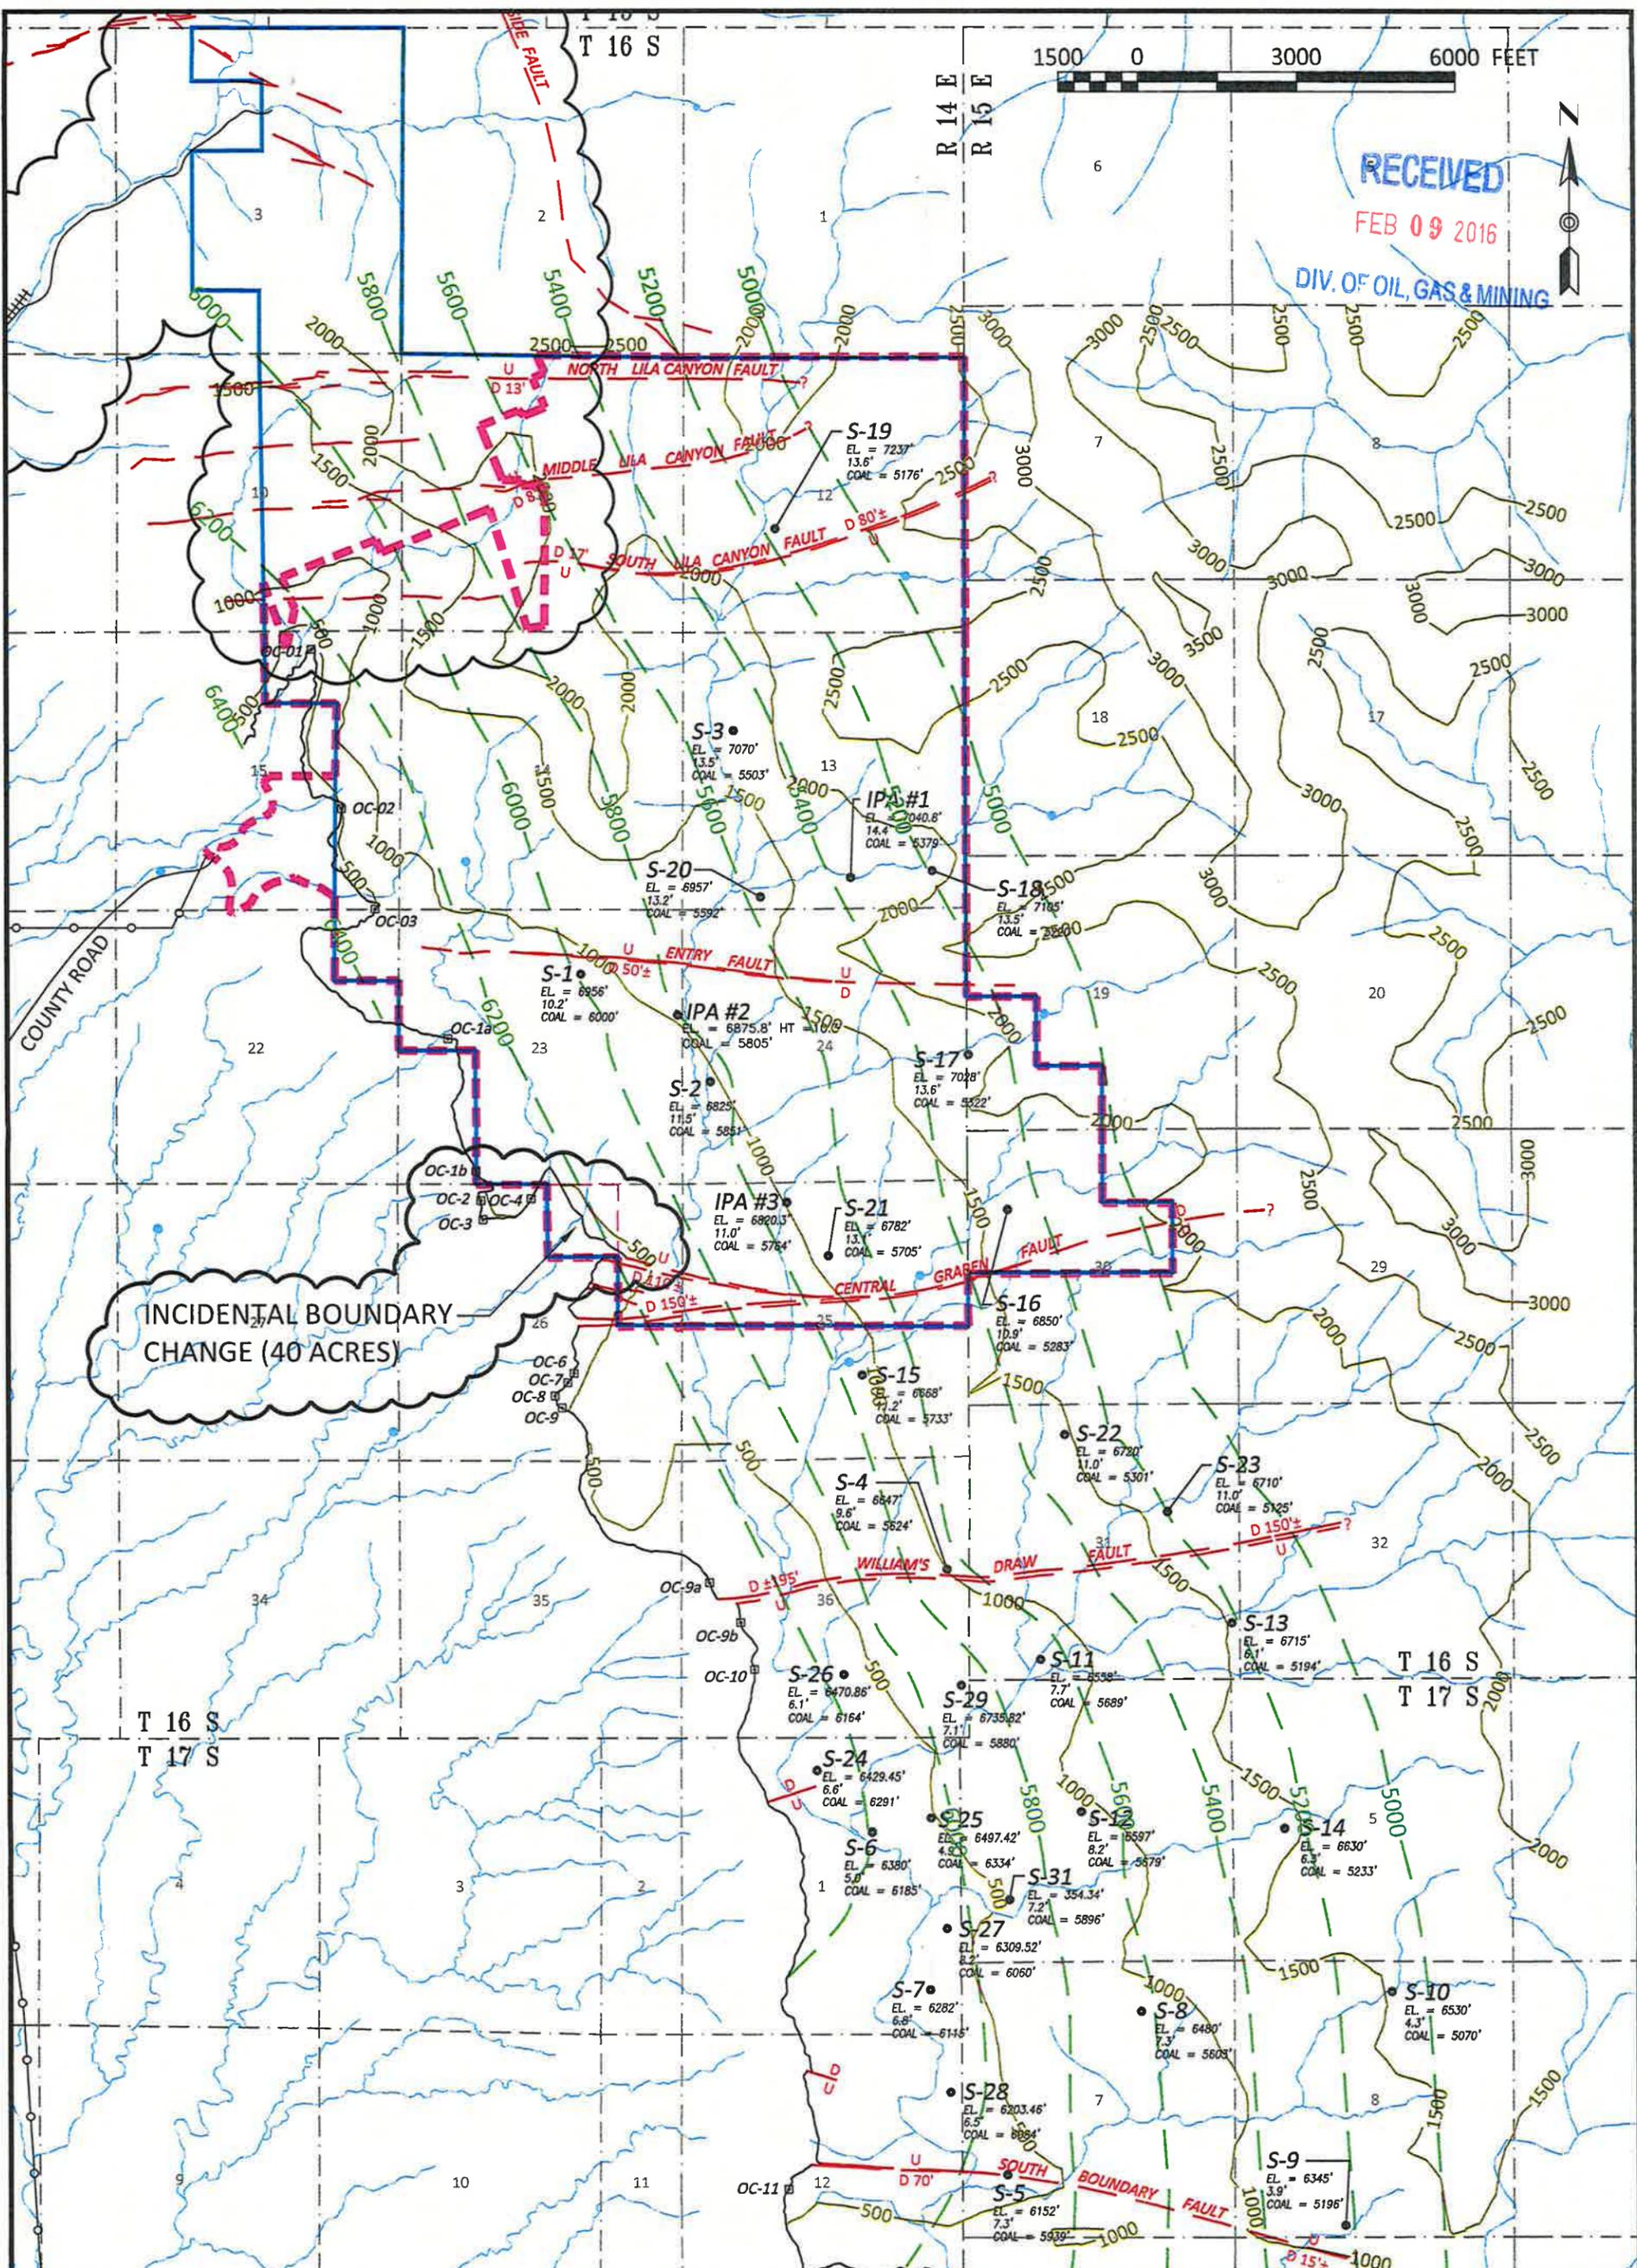

LEGEND:

- PERMIT AREA:
- COAL OUTCROP:
- FAULTS:
- OUTCROP MEASUREMENTS:
- LMU AREA:
- DRILL HOLES:
- STRUCTURE LINES:
- COVER (500' INTERVALS):
- EPHEMERAL STREAMS:

DIP/STRIKE:

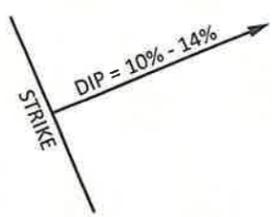

REVISIONS

DATE	BY
8/29/2000	BJ
12/14/2000	BJ
APR. 19, 2002	RJM
SEPT. 30, 2002	RJM
FEB. 8, 2016	PJJ

COVER AND STRUCTURE MAP

LILA CANYON MINE
23415 North Lila Canyon Road
Green River, Utah 84525
DOGM PERMIT# C0070013
DESIGN BY: BLACKHAWK ENG.
SCALE: 1" = 3,000'
ORIGINAL DATE: JAN. 1998







1600 0 3200 6400 FEET

RECEIVED

FEB 08 2016

DIV. OF OIL, GAS & MINING

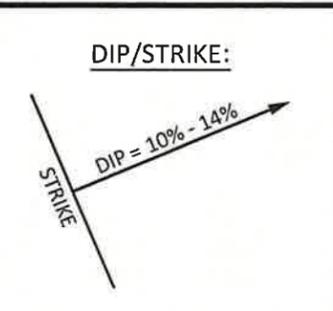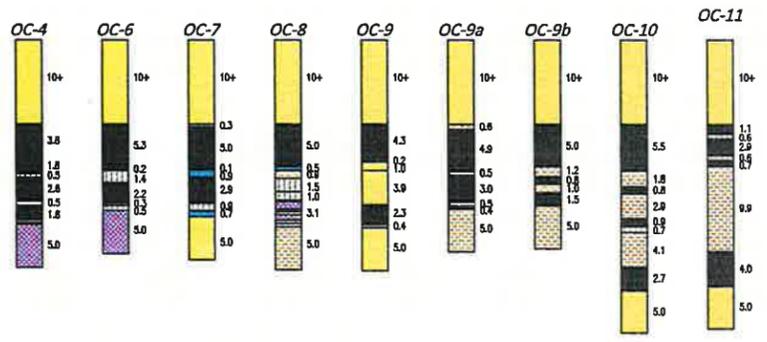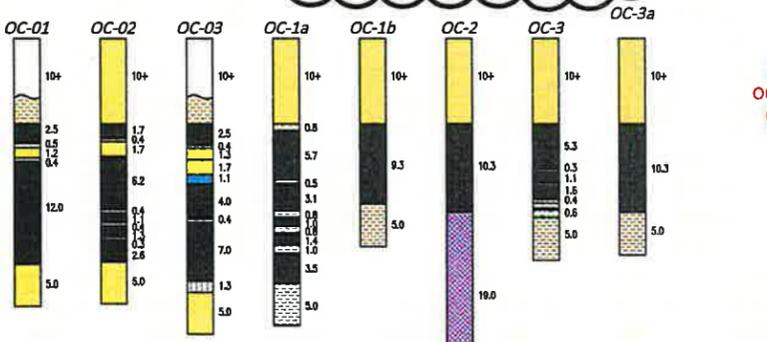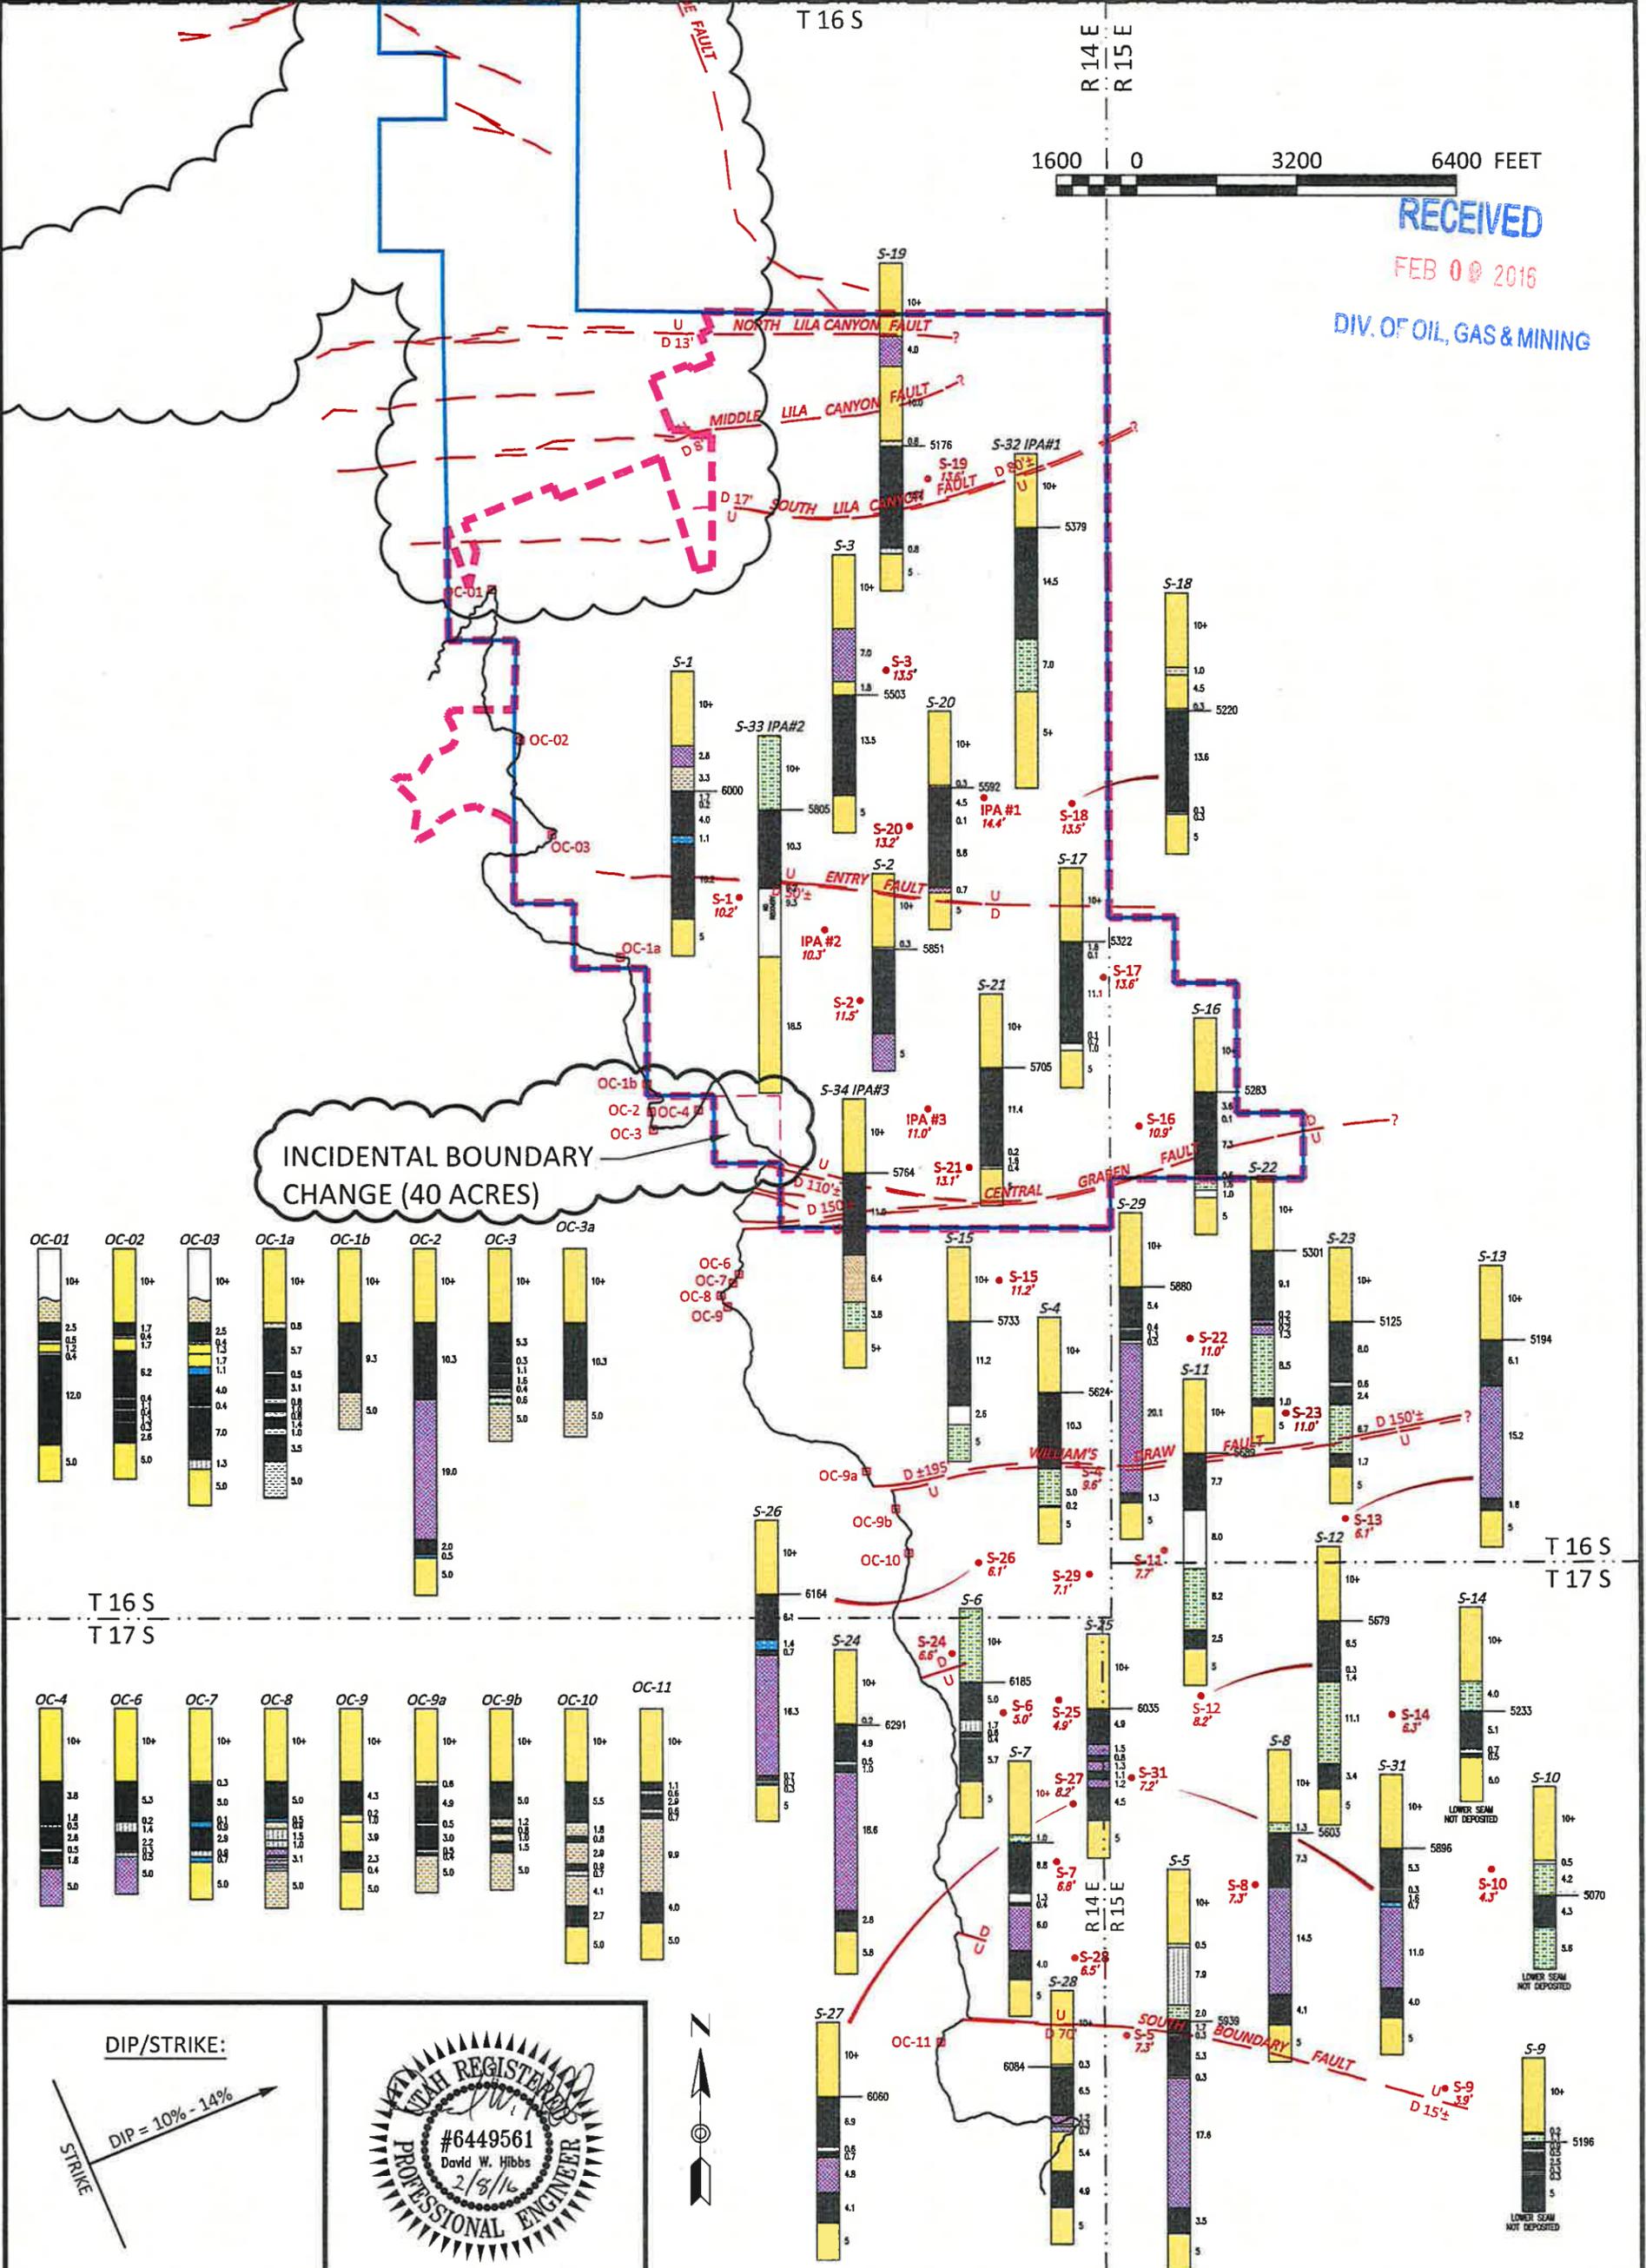

LEGEND:
 COAL: [Pattern]
 BONE COAL: [Pattern]
 CARBONACEOUS SHALE: [Pattern]
 MUDSTONE: [Pattern]
 SILTSTONE: [Pattern]
 SANDSTONE: [Pattern]
 LAMINATED SILTSTONE/SANDSTONE: [Pattern]


PERMIT AREA : [Symbol]
 COAL OUTCROP : [Symbol]
 FAULTS : [Symbol]
 OUTCROP MEASUREMENTS : [Symbol]
 LMU AREA : [Symbol]
 DRILL HOLES / SEAM HEIGHT : [Symbol]

REVISIONS	
DATE	BY
8/29/2000	BJ
9/30/2002	RJM
02/08/2016	PJJ

COAL SECTIONS
 LILA CANYON MINE
 23415 North Lila Canyon Road
 Green River, Utah 84525
 DOGM PERMIT# C0070013
 DESIGN BY: BLACKHAWK ENG.
 SCALE: AS SHOWN
 ORIGINAL DATE: FEB. 1998
PLATE 6-5

2000 0 4000 8000 FEET

RECEIVED
FEB 08 2016
DIV OF OIL, GAS & MINING

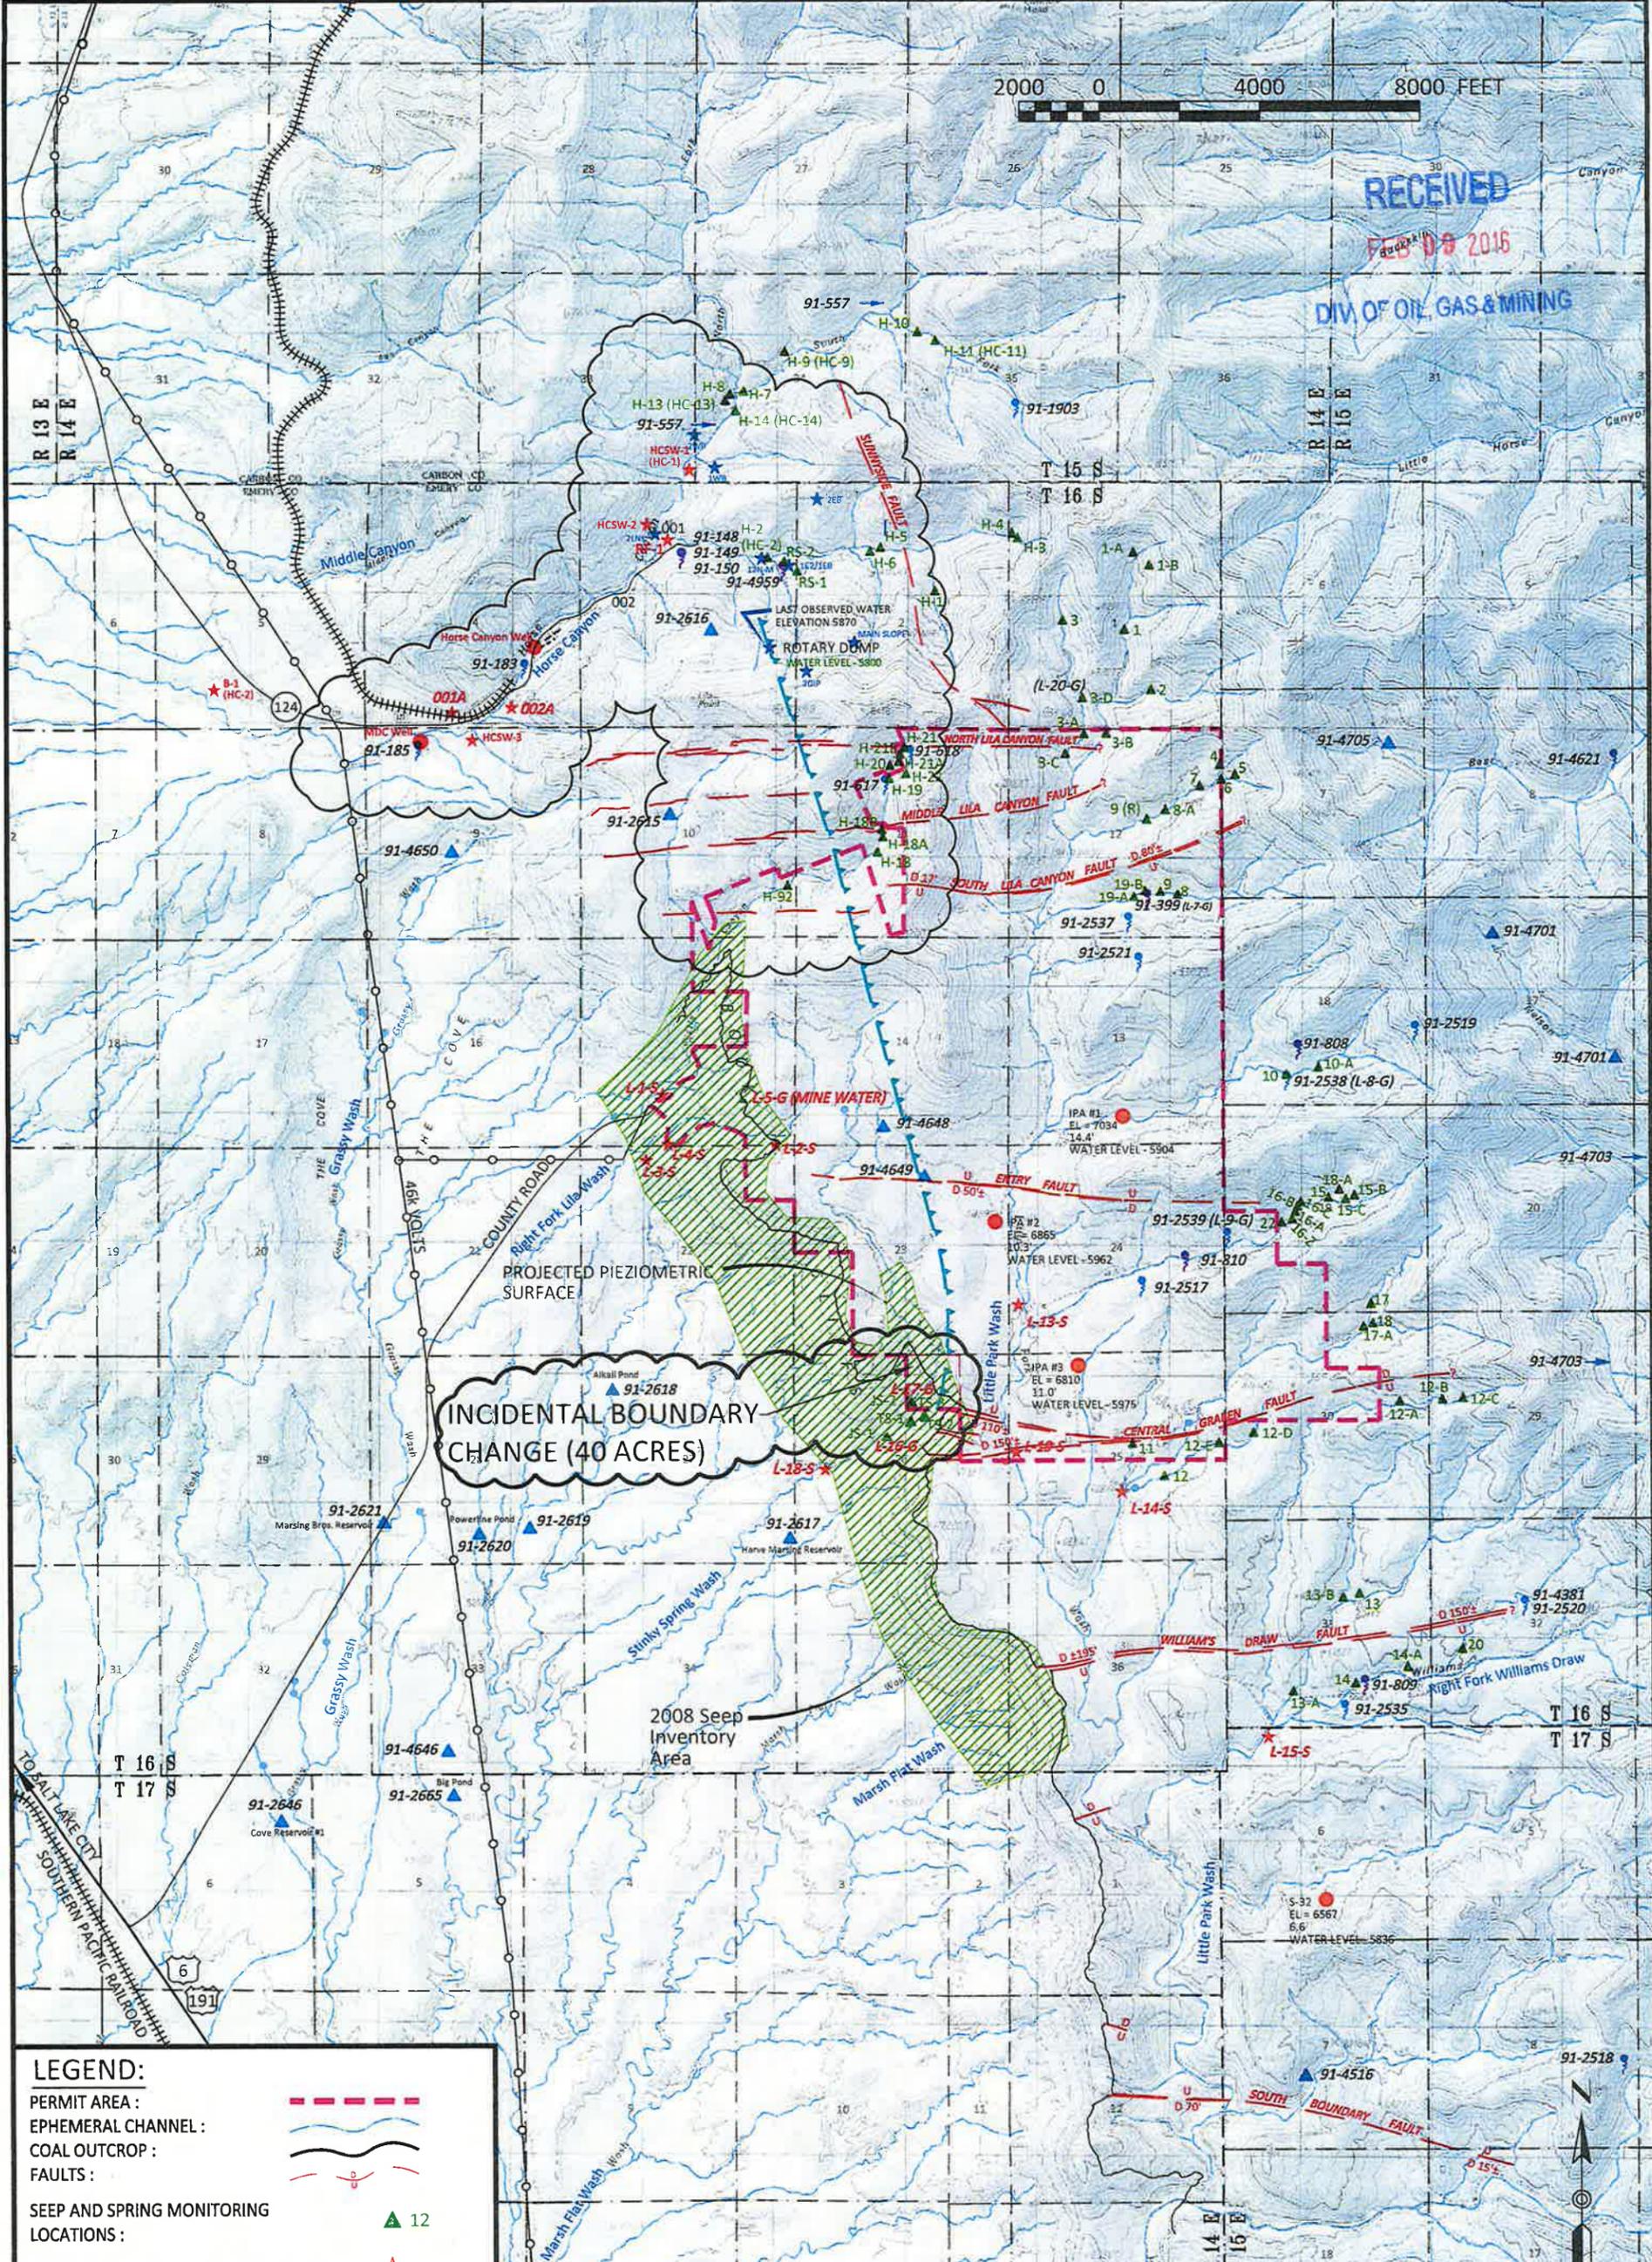

LEGEND:

- PERMIT AREA :
- EPHEMERAL CHANNEL :
- COAL OUTCROP :
- FAULTS :
- SEEP AND SPRING MONITORING LOCATIONS : 12
- SURFACE WATER MONITORING LOCATIONS :
- IN-MINE MONITORING LOCATIONS :
- WELLS / PIEZOMETERS :
- STOCK POND WATER RIGHT : 91-2646
- UTAHAMERICAN, INC. WATER RIGHT : 91-810
- NON-UTAHAMERICAN WATER RIGHT : 91-2535
- UNDERGROUND WATER RIGHT : 91-48

NOTE: SOME FAULT LINES NOT SHOWN FOR CLARITY.



REVISIONS

DATE	BY	DATE	BY
JULY 1999	WJ	DECEMBER 2006	PJJ
NOVEMBER 1999	BHE	JAN 12, 2007	RJM
MARCH 2000	BHE	FEB. 19, 2009	RJM
AUG. 2000	BJ	APRIL 2011	TJS
DEC. 2000	BJ	FEB. 8, 2016	PJJ
APRIL 2002	RJM		
SEPTEMBER 2002	RJM		
NOVEMBER 2006	TJS		

PERMIT AREA HYDROLOGY

LILA CANYON MINE
23415 North Lila Canyon Road
Green River, Utah 84525
DOG M PERMIT# C0070013


DESIGN BY: BLACKHAWK ENG.	SCALE: 1" = 4,000' ORIGINAL DATE: MAY 1998
---------------------------------	---

PLATE 7-1

RECEIVED

FEB 09 2016

DIV. OF OIL, GAS & MINING

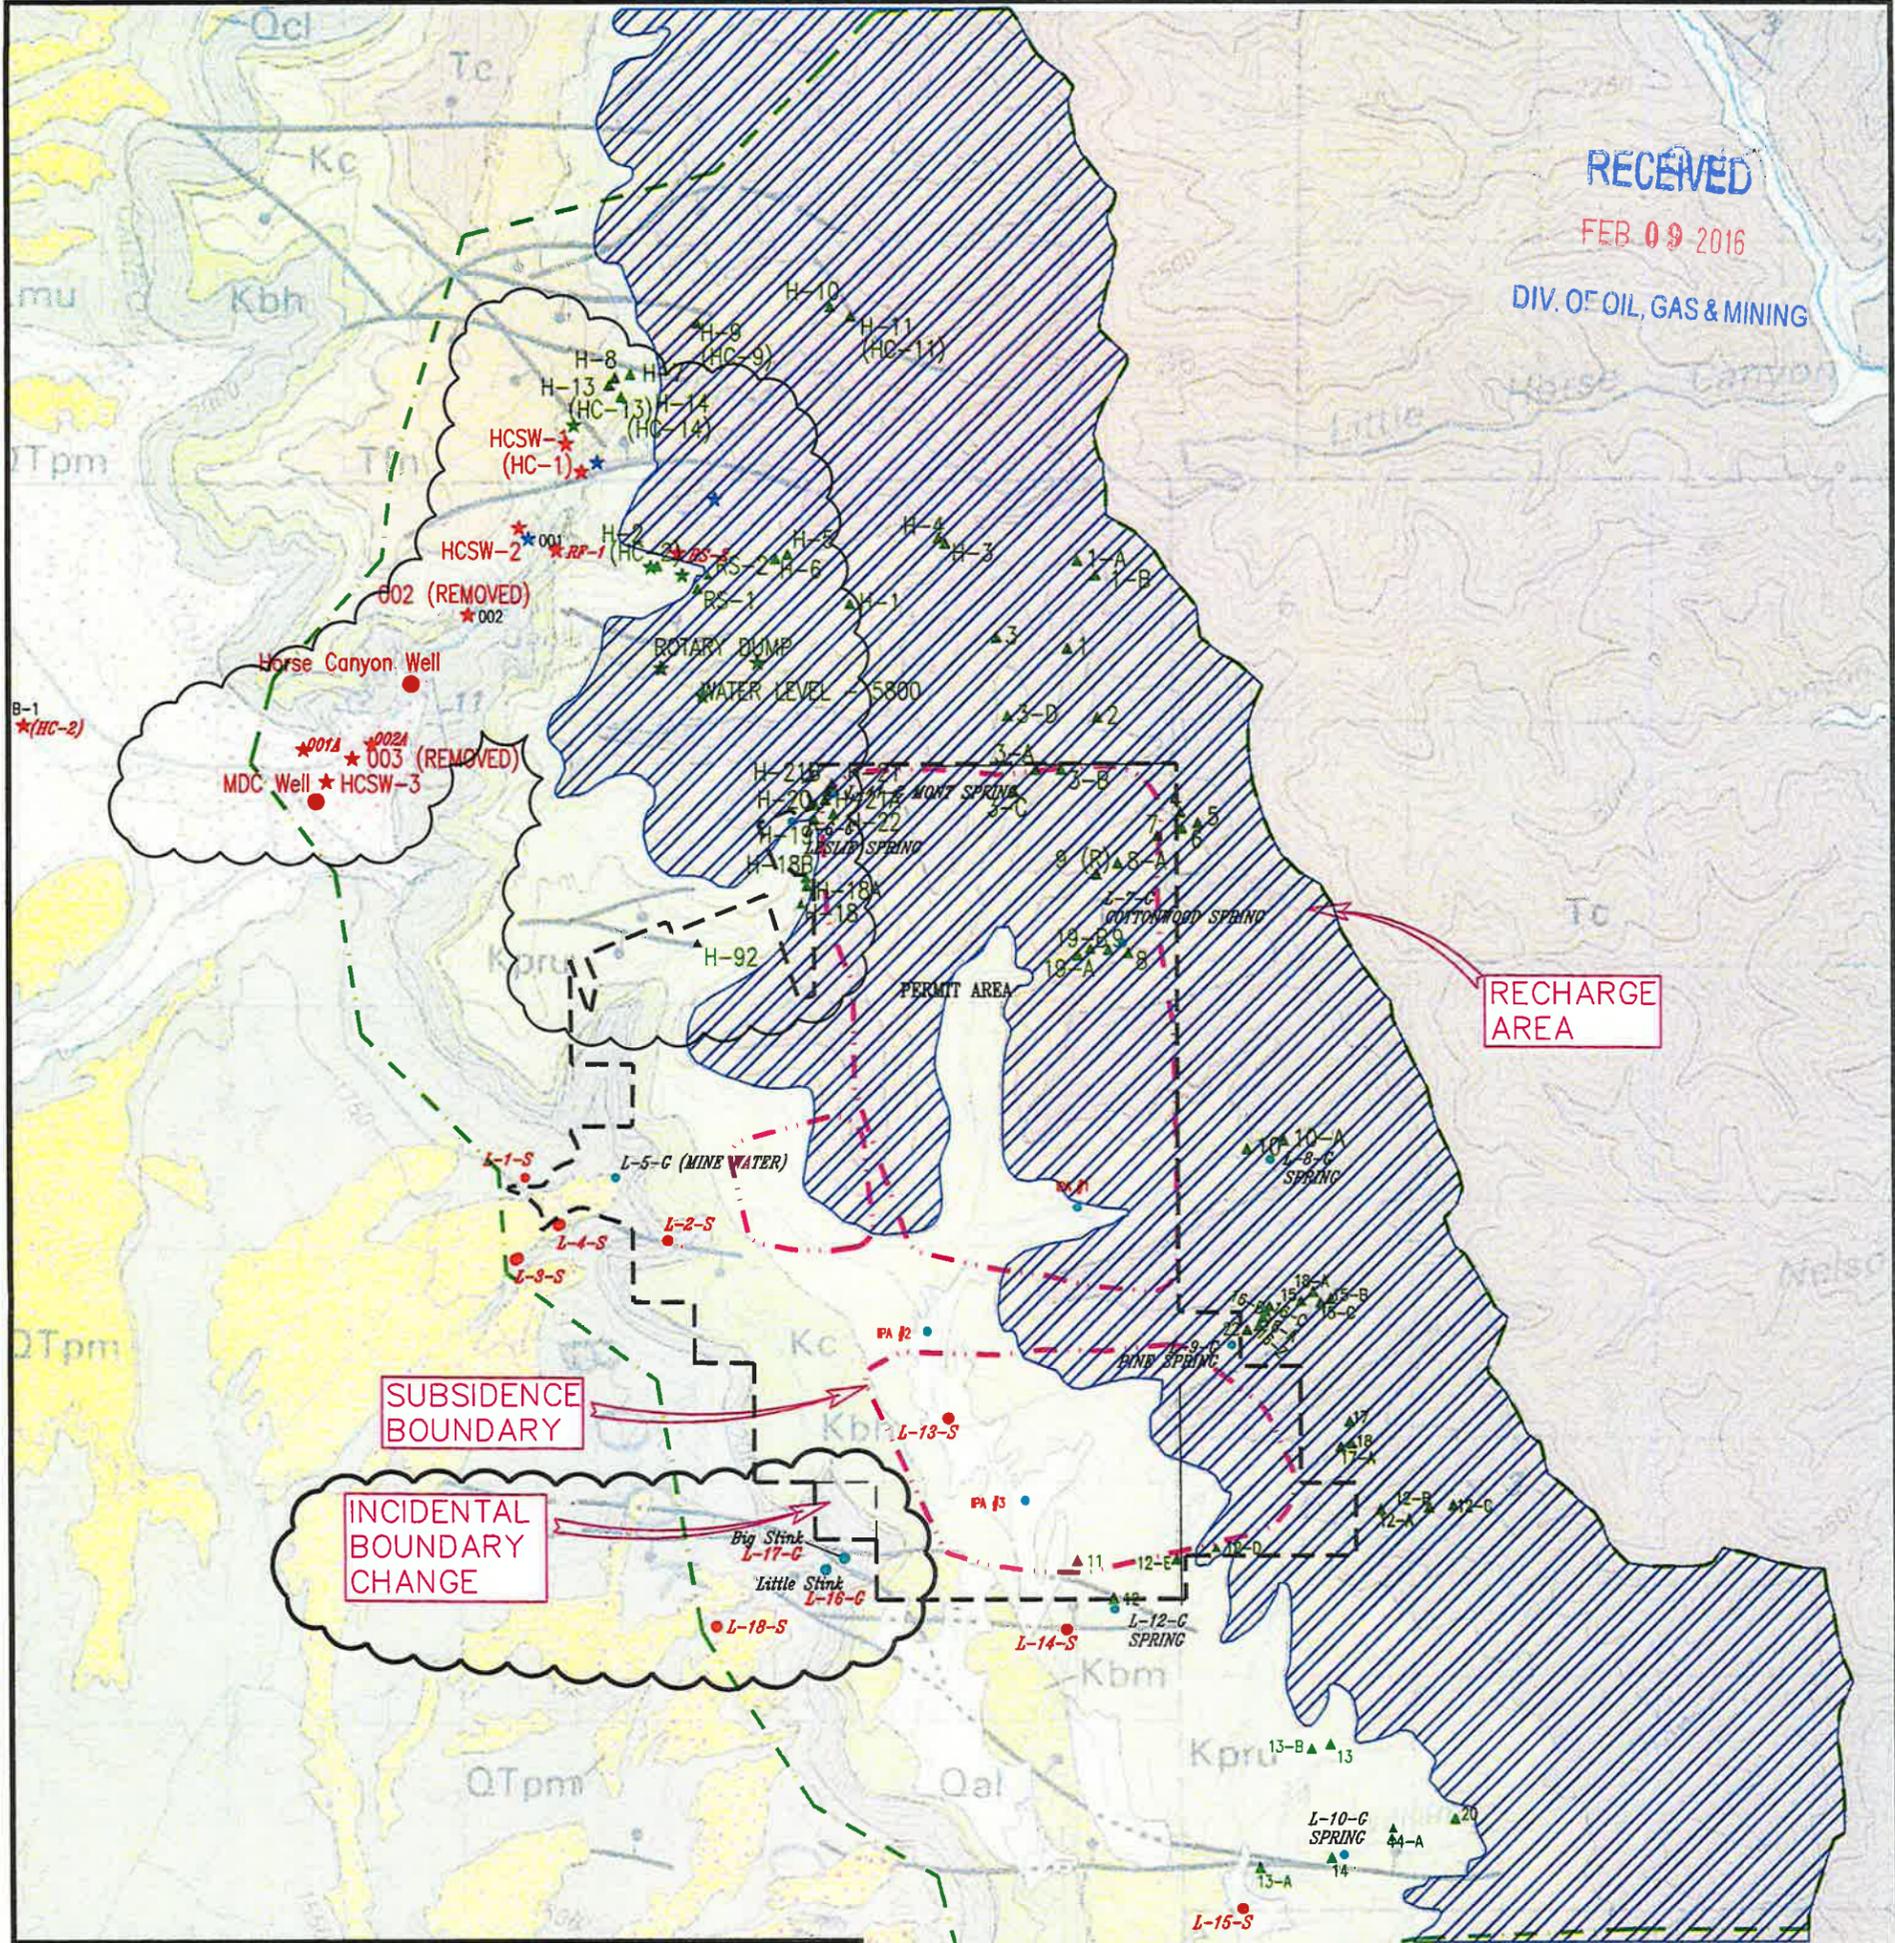

SUBSIDENCE BOUNDARY

INCIDENTAL BOUNDARY CHANGE

RECHARGE AREA

LIMITS OF EARTHFAX S&S INVENTORY

LEGEND

Qal	Alluvium	Kmeu	Upper sandstone unit
Qcl	Colluvium	Kmem	Middle shale unit
Qt	Alluvial fan deposit	Kmel	Lower sandstone unit
Qcf	Coalesced alluvial fan deposit	Kmbg	Blue Gate Member
Qsw	Slope wash	Kmbg	Garley Canyon Sandstone Member
QTpm	Pediment mantle	Kmf	Ferron Sandstone Member
Qt	Terrace deposit	Kmt	Tununk Member
Tg	Green River Formation	Kmu	Upper part of Mancos Shale, undivided
Tc	Colton Formation	Kmf	Ferron Sandstone Member
Tw	Wasatch Formation	Kmt	Tununk Member
Tfn	Flagstaff Member of Green River Formation and North Horn Formation	Jm	Morrison Formation
Kt	Tuscher Formation	Jmbb	Brushy Basin Member
Kln	Farrer and Neslen Formations	Jms	Salt Wash Sandstone Member
Kmbb	Buck Tongue of Mancos Shale	Js	Summerville Formation
Kpru	Upper Part of Price River Formation	Jcu	Curtis Formation
Kbm	Bluecastle Sandstone Member	Je	Entrada Sandstone
Kc	Castlegate Sandstone	Jc	Carmel Formation
Kbh	Blackhawk Formation and Star	Jtn	Navajo Sandstone
Kmub	Upper part of Blue Gate Member	Jk	Kayenta Formation
Kme	Emery Sandstone Member		



WATER MONITORING OLD/CURRENT

- ★ Horse Canyon Monitoring
- ★ Underground Horse Canyon Monitoring
- ▲ Baseline Springs
- Lila Canyon Ground Water Monitoring
- Lila Canyon Surface Monitoring
- ▨ Major Recharge Area
- - - EarthFax S&S Limits

REVISIONS	
DATE	BY
01/2006	
07/2006	
02/08/2016	PJJ


PERMIT AREA HYDROLOGY WITH GEOLOGIC MAP	
 LILA CANYON MINE	
23415 North Lila Canyon Road Green River, Utah 84525	
DOGM PERMIT# C0070013	
DESIGN BY:	SCALE: 1" = 4,000'
	ORIGINAL DATE: NOV. 2002
PLATE 7-1A	

2000 0 4000 8000 FEET

RECEIVED

FEB 09 2016

DIV. OF OIL GAS & MINING

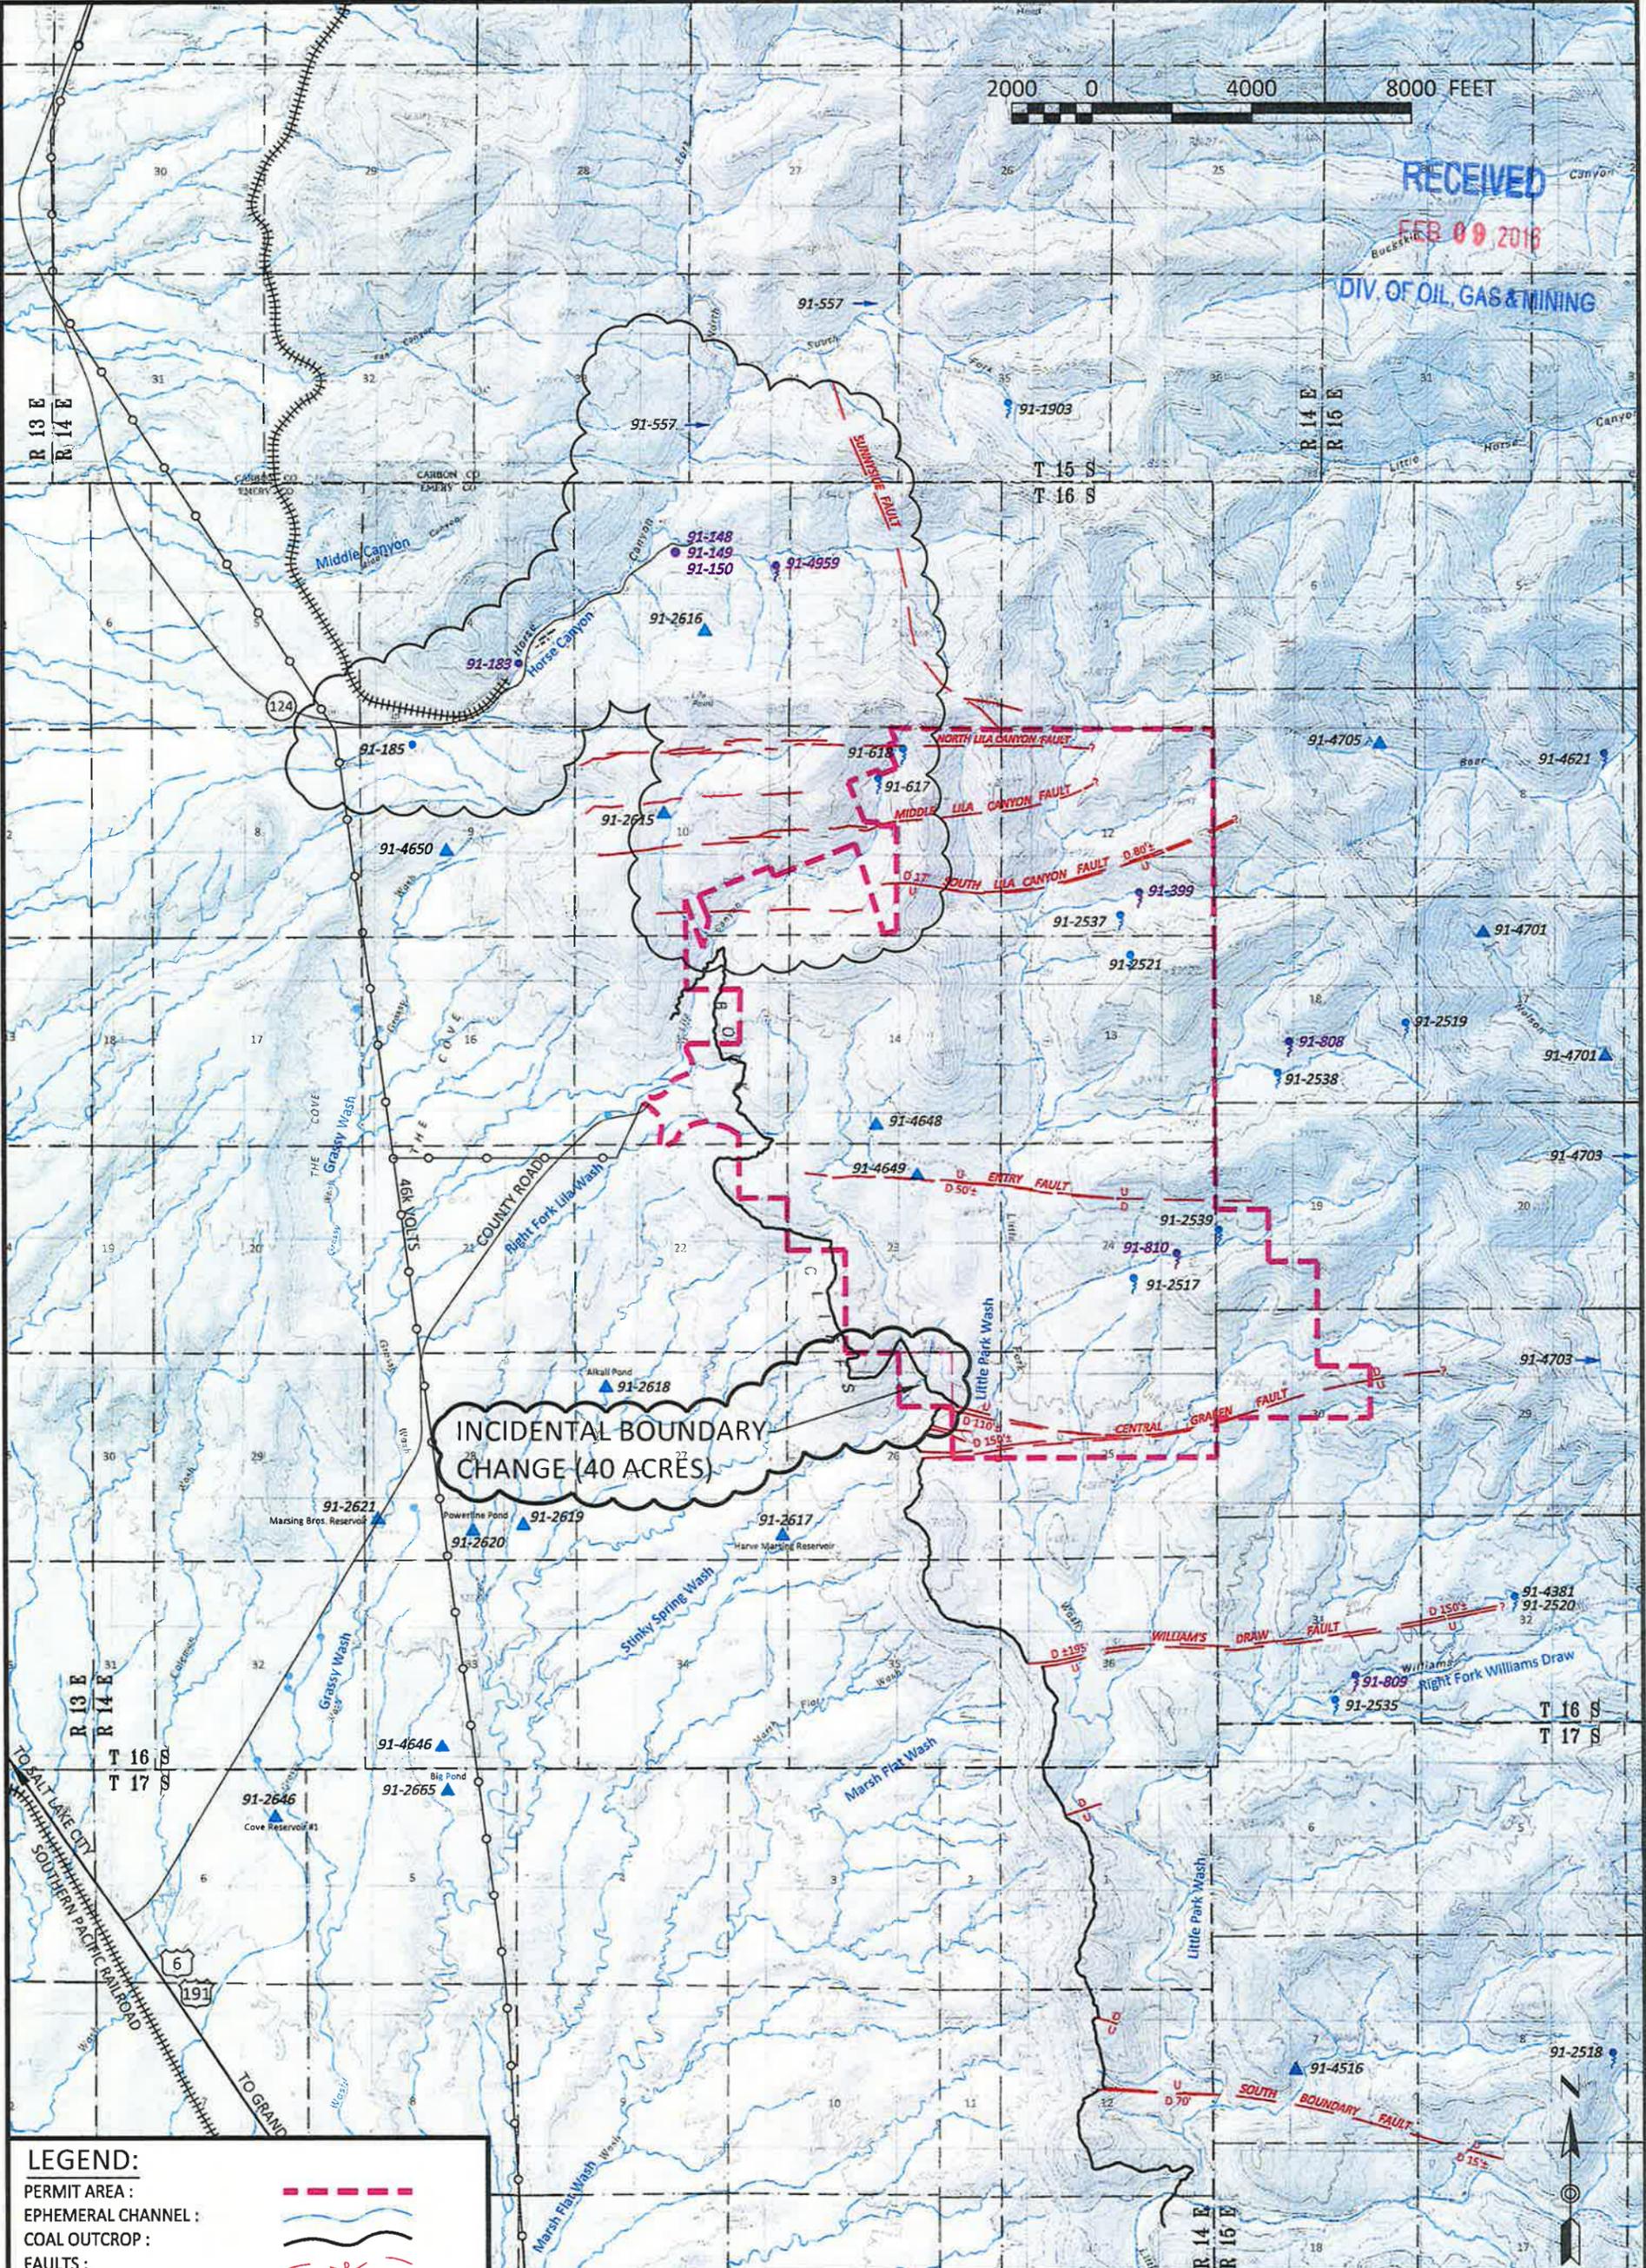

INCIDENTAL BOUNDARY CHANGE (40 ACRES)

LEGEND:

- PERMIT AREA :
 - EPHEMERAL CHANNEL :
 - COAL OUTCROP :
 - FAULTS :
 - NON-UTAHAMERICAN WATER RIGHT : 91-557
 - UTAHAMERICAN WATER RIGHT : 91-810
 - RESERVOIR / STREAM :
 - SPRING SOURCE :
 - REACH OF CREEK :
 - UNDERGROUND SOURCE :
- NOTE: SOME FAULT LINES NOT SHOWN FOR CLARITY.



REVISIONS

DATE	BY	DATE	BY
NOVEMBER 1999	BHE	FEBRUARY 2016	PJJ
AUGUST 2000	BHE		
DECEMBER 2000	BJ		
SEPTEMBER 2002	RJM		
NOVEMBER 2003	RJM		
JANUARY 2005	RJM		
NOVEMBER 2006	TJS		
NOVEMBER 2006	RJM		

WATER RIGHTS

LILA CANYON MINE
 23415 North Lila Canyon Road
 Green River, Utah 84525
 DOGM PERMIT# C0070013
 DESIGN BY: BLACKHAWK ENG.
 SCALE: 1" = 4,000'
 ORIGINAL DATE: MAY 1998


PLATE 7-3

2000 0 4000 8000 FEET

RECEIVED

FEB 09 2016

DIV OF OIL GAS & MINING

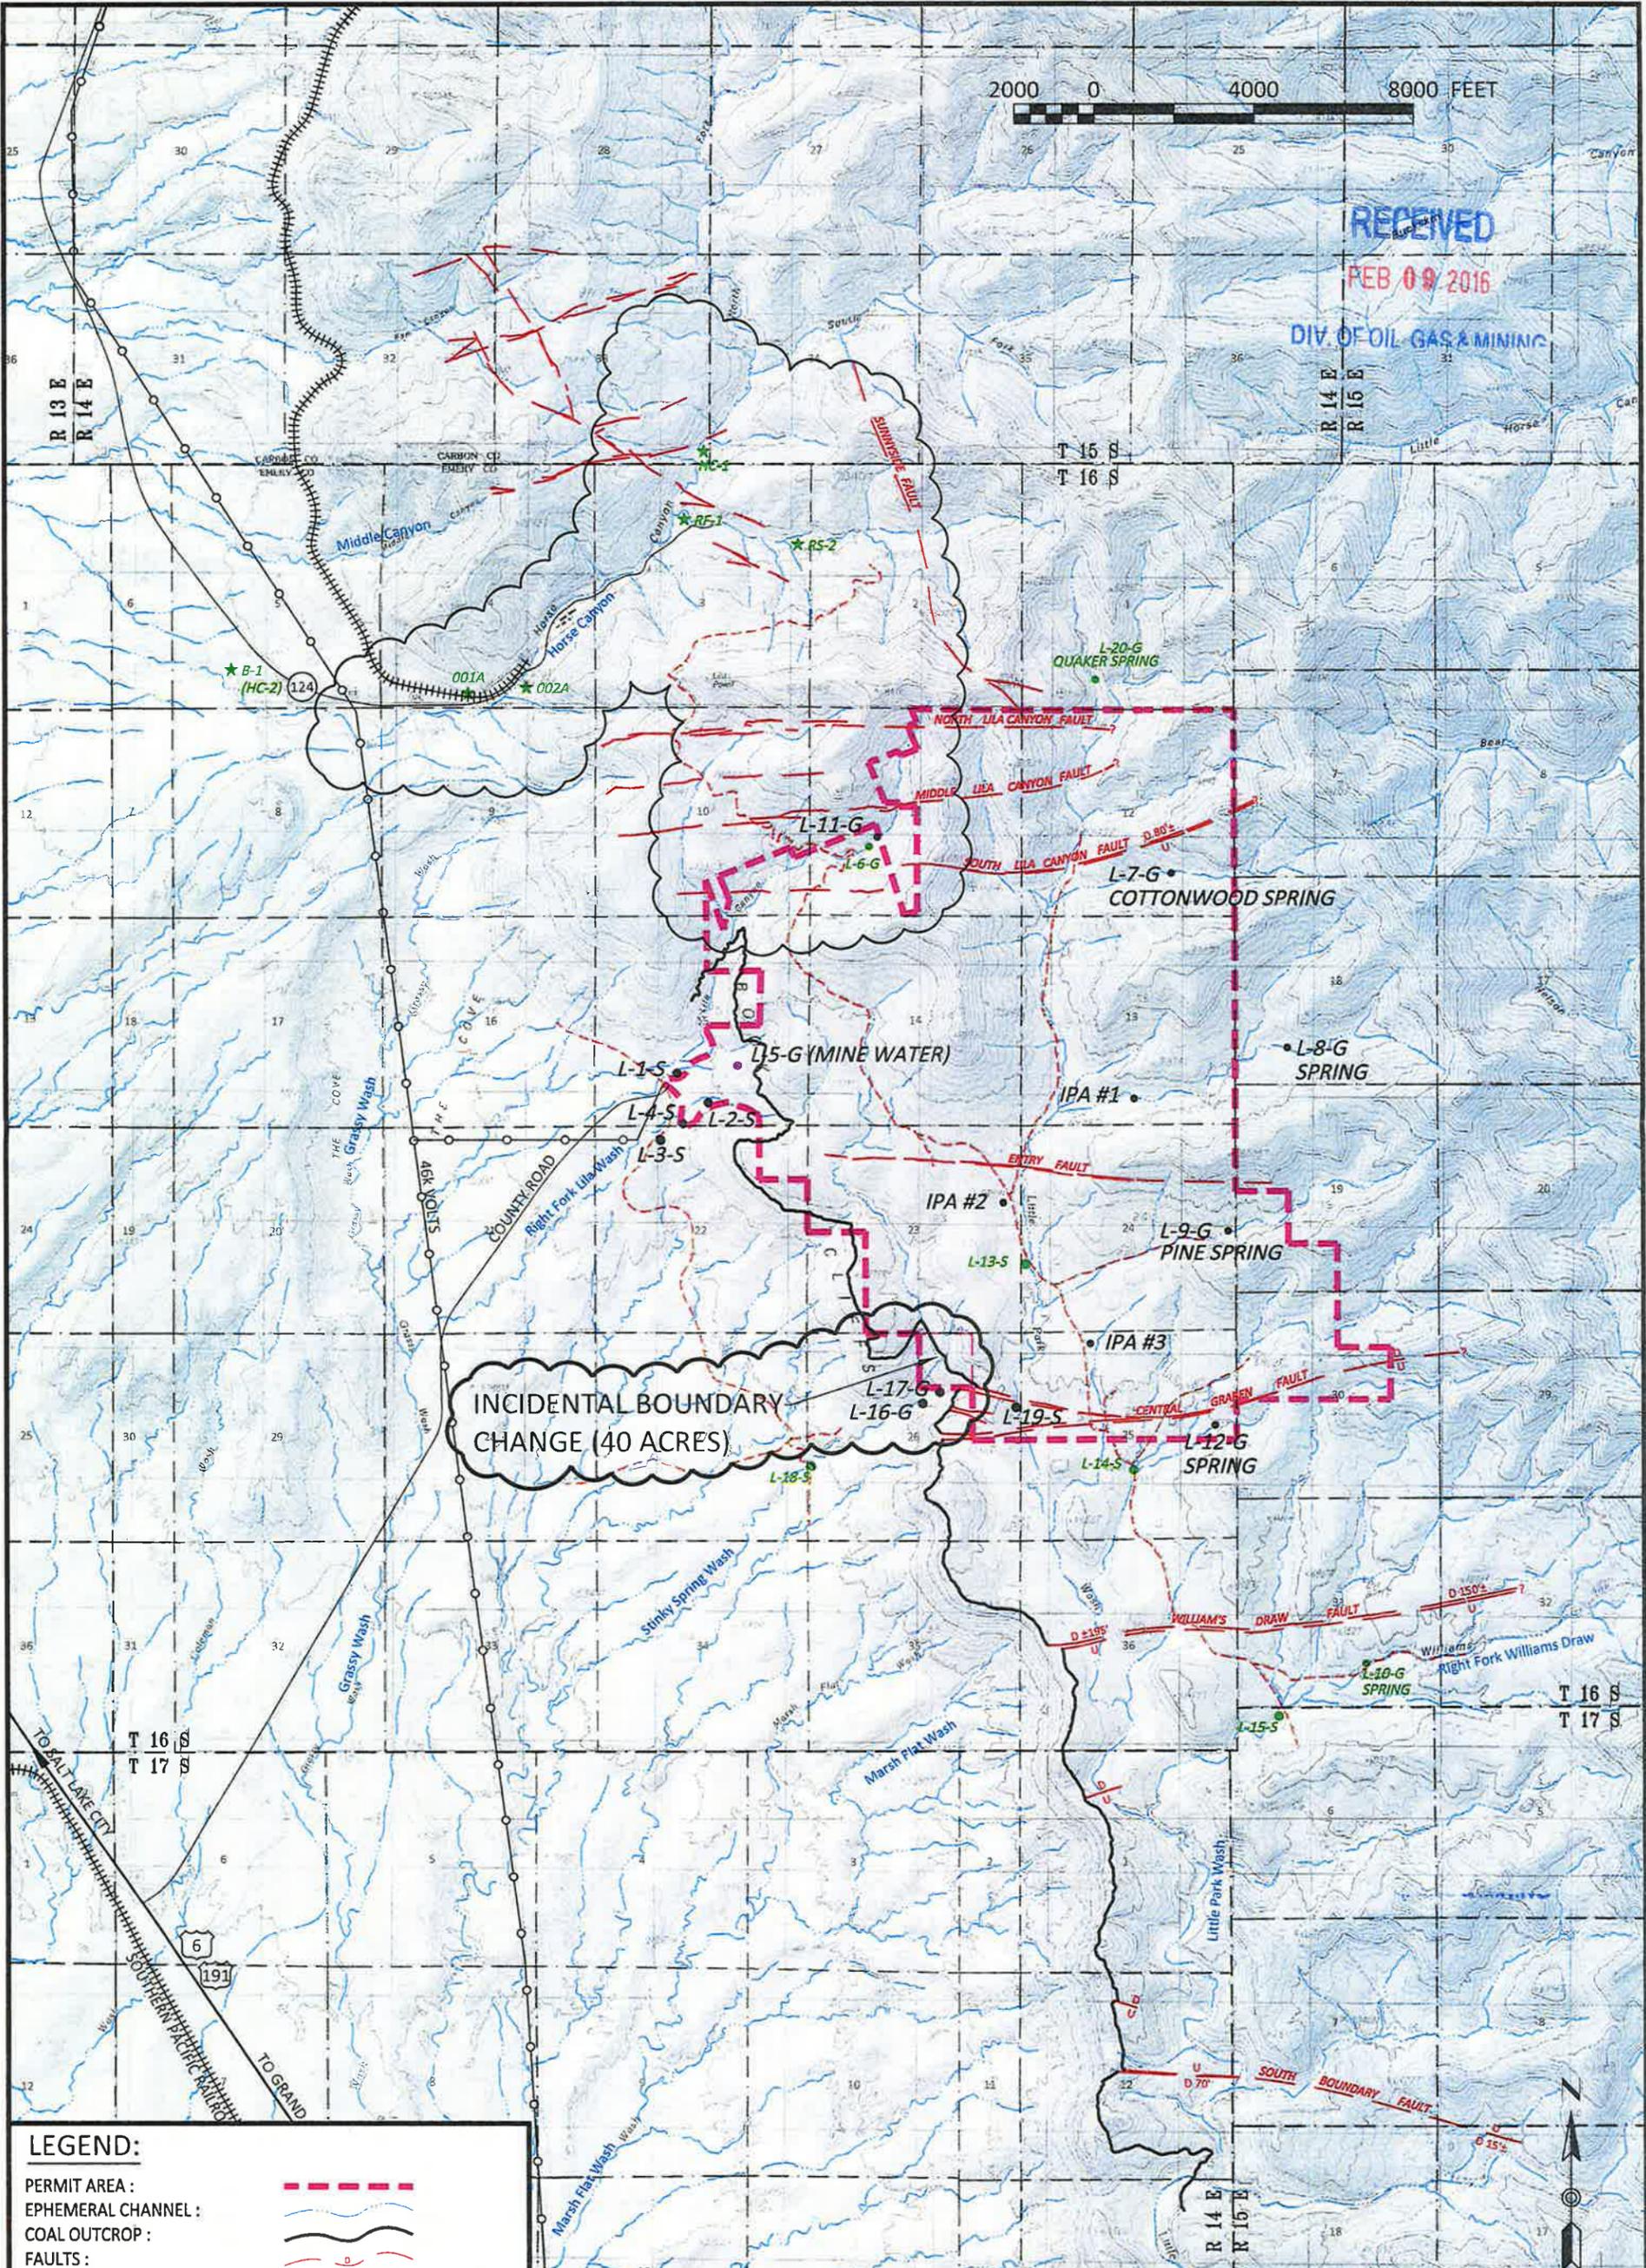

LEGEND:

- PERMIT AREA :
 - EPHEMERAL CHANNEL :
 - COAL OUTCROP :
 - FAULTS :
 - UNPAVED ROAD :
-
- | | | |
|--------------------------------------|---------------|------------------|
| | ACTIVE | SUSPENDED |
| HORSE CANYON MONITORING : | | |
| LILA CANYON SURFACE MONITORING : | | |
| LILA CANYON GROUNDWATER MONITORING : | | |
| LILA CANYON CREST GAUGE MONITORING : | | |
| LILA CANYON SEEP LOCATIONS : | | |
| LILA CANYON RAIN GAUGE : | | |

NOTE: SOME FAULT LINES NOT SHOWN FOR CLARITY.



REVISIONS

DATE	BY	DATE	BY
JULY 1999	WJ	JUNE 2011	TJS
NOVEMBER 1999	BHE	FEB. 8, 2016	PJJ
MARCH 2000	BHE		
AUGUST 2000	BJ		
DECEMBER 2000	BJ		
JULY 2001	BJ		
SEPTEMBER 2002	RJM		
NOVEMBER 2006	TJS		

WATER MONITORING LOCATIONS

LILA CANYON MINE

23415 North Lila Canyon Road
Green River, Utah 84525

DOG M PERMIT# C0070013

DESIGN BY: BLACKHAWK ENG.	SCALE: 1" = 4,000'
ORIGINAL DATE: MAY 1998	

PLATE 7-4