

**Snell & Wilmer**  
L.L.P.  
LAW OFFICES

Gateway Tower West  
15 West South Temple  
Suite 1200  
Salt Lake City, Utah 84101-1547  
801.257.1900  
801.257.1800 (Fax)  
www.swlaw.com

Denise A. Dragoo  
(801) 257-1998  
ddragoo@swlaw.com

**RECEIVED**  
**OCT 23 2015**

**DIV. OF OIL, GAS & MINING**

DENVER  
LAS VEGAS  
LOS ANGELES  
LOS CABOS  
ORANGE COUNTY  
PHOENIX  
RENO  
SALT LAKE CITY  
TUCSON

October 21, 2015

Dana Dean  
Associate Director  
Utah Division of Oil, Gas & Mining  
1594 West North Temple  
Salt Lake City, Utah 84116

Re: Hidden Splendor Resources, Inc., Horizon Mine Permit C/007/0020

Dear Associate Director Dean:

On behalf of Hidden Splendor Resources, Inc. ("HSR"), enclosed please find the "as built" diagram showing closure of the "dog hole" at the Horizon Mine pursuant to the requirements of 30 CFR Section 1711-1. The dog hole has been capped per the rule and approved by MSHA. As we discussed at the conference on September 29, 2015, per MSHA requirements, the cap was equipped with a vent pipe. HSR proposes to insert this diagram into the Horizon Mine permit at Section 3.5.3.1, Sealing of Mine Openings.

If you have any questions, please call me.


Very truly yours,

Snell & Wilmer  
  
Denise A. Dragoo

DAD:mkm

Enclosure

cc: Daron Haddock  
Steve Christensen  
Alexander H. Walker, III, Esq.

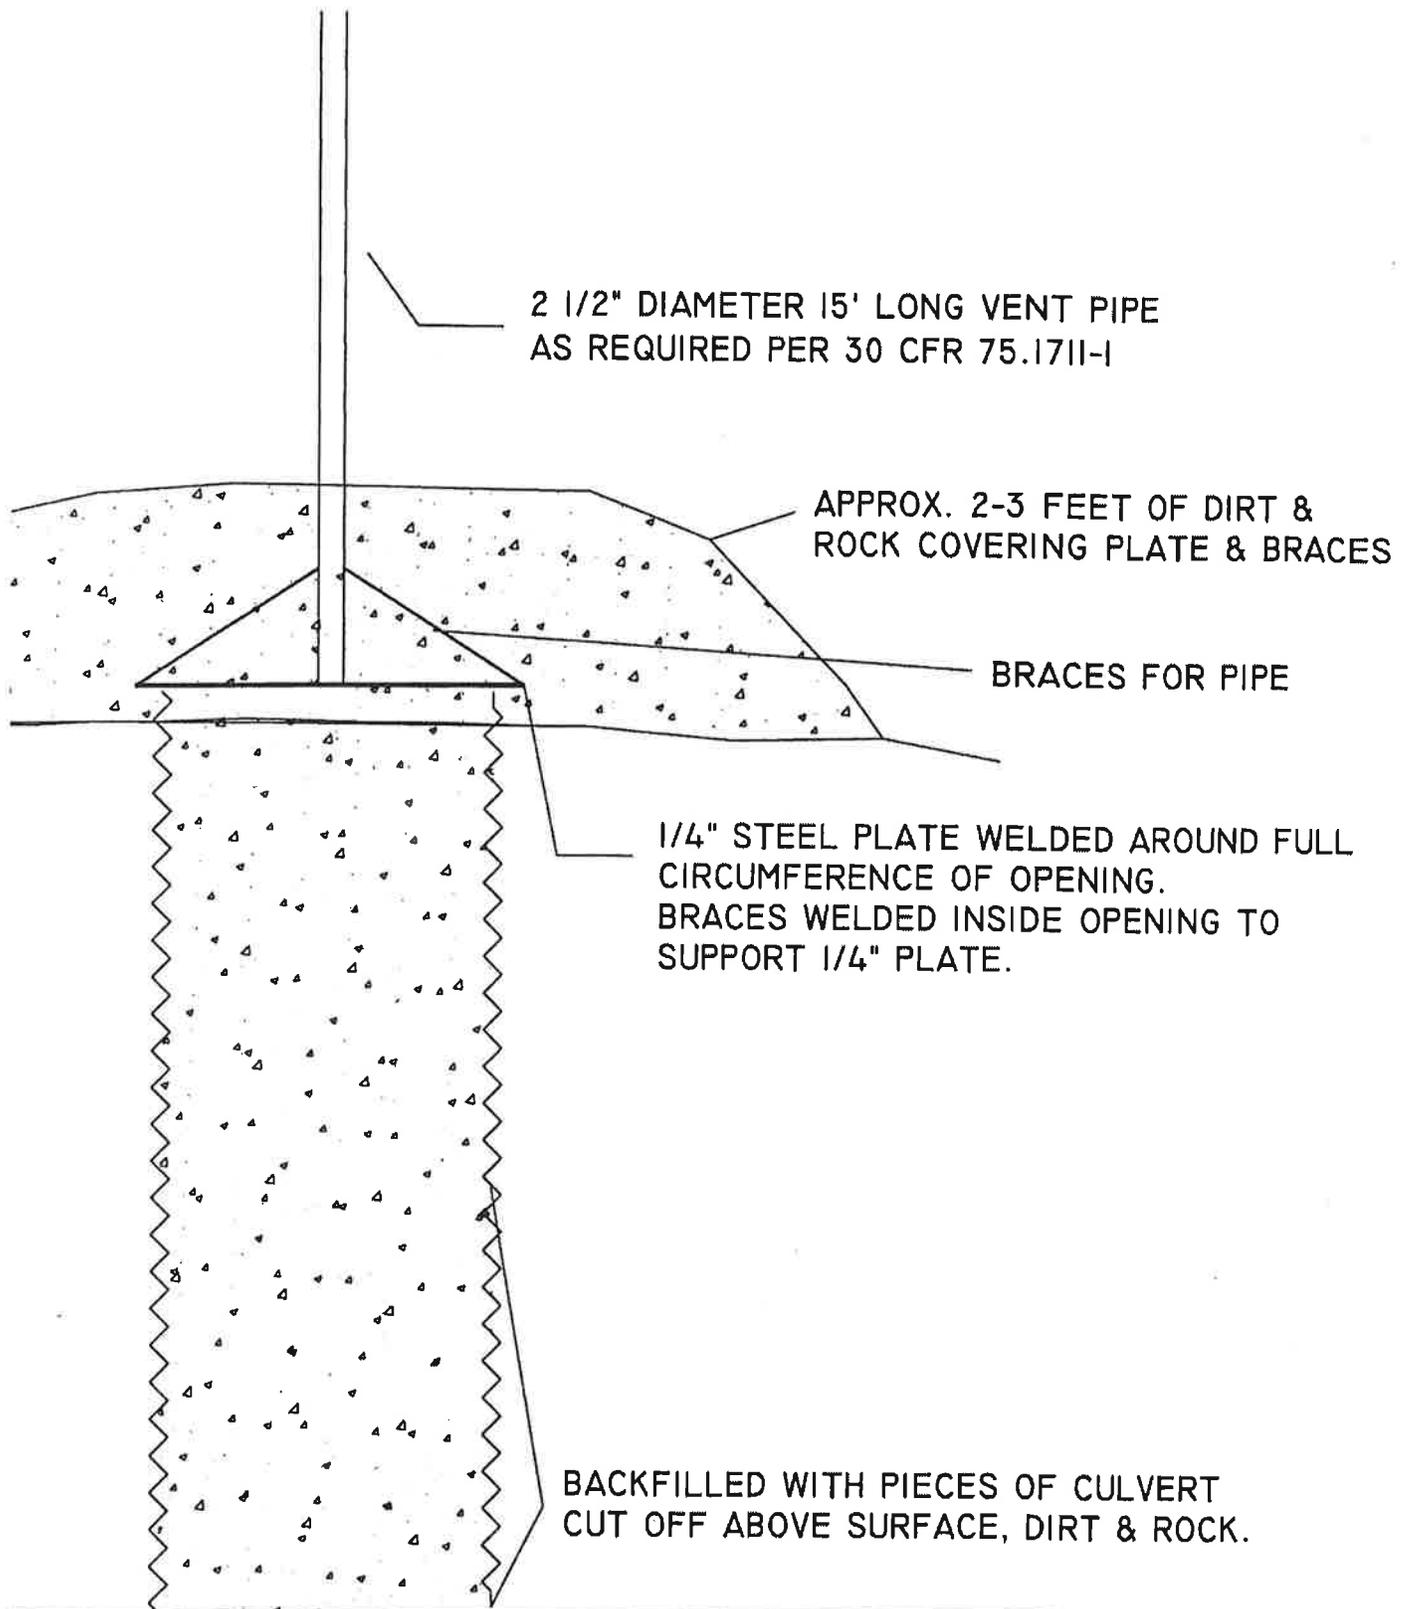

HIDDEN SPLendor RESOURCES  
HORIZON MINE  
57 WEST 200 SOUTH - SUITE 400  
SALT LAKE CITY, UTAH 84101

AWN BY	DATE	SCALE: NTS
PROJECT	FILENAME & PATH	

HORIZON MINE - "DOG HOLE" PORTAL CLOSURE  
UDOGM PERMIT C/007/0020 MSHA I.D. 42-02074  
FEDERAL COAL LEASE UTIL-74.R06