

0033



**Canyon Fuel Company, LLC**  
Soldier Canyon Mine  
P.O. Box 1029  
Wellington, Utah 84542  
(435) 637-6360 Fax: (435) 637-0108

INCOMING  
C/007/039  
AM03C

June 13, 2003

Pamela Grubaugh-Littig  
Coal Program  
Utah Division of Oil, Gas and Mining  
1594 West North Temple, Suite 1210  
Salt Lake City, Utah 84114-5801

RE: Addition of Gilson Well As-Built Drawing, Canyon Fuel Company, LLC, Dugout Mine,  
C/007/039

Dear Ms. Grubaugh-Littig:

Attached please find four copies of an as-built drawing of the Gilson Well site. The drawing is to be incorporated into Appendix 7-9 of the M&RP. A copy of this submittal has been delivered to the Price field office.

Thank you for your assistance and if you have any questions, please call me at (435) 636-2869.

Sincerely yours,

Vicky S. Miller

cc: Chris Hansen  
Dave Spillman  
Pete Hess

RECEIVED

JUN 17 2003

DIV. OF OIL, GAS & MINING

# APPLICATION FOR COAL PERMIT PROCESSING

Permit Change  New Permit  Renewal  Exploration  Bond Release  Transfer

**Permittee:** Canyon Fuel Company, LLC

**Mine:** Dugout Canyon Mine

**Permit Number:** C/007/039

**Title:** Addition of Gilson Well As-Built Drawing

**Description,** Include reason for application and timing required to implement:

**Instructions:** If you answer yes to any of the first eight (gray) questions, this application may require Public Notice publication.

- Yes  No 1. Change in the size of the Permit Area? Acres: \_\_\_\_\_ Disturbed Area: \_\_\_\_\_  increase  decrease.
- Yes  No 2. Is the application submitted as a result of a Division Order? DO# \_\_\_\_\_
- Yes  No 3. Does the application include operations outside a previously identified Cumulative Hydrologic Impact Area?
- Yes  No 4. Does the application include operations in hydrologic basins other than as currently approved?
- Yes  No 5. Does the application result from cancellation, reduction or increase of insurance or reclamation bond?
- Yes  No 6. Does the application require or include public notice publication?
- Yes  No 7. Does the application require or include ownership, control, right-of-entry, or compliance information?
- Yes  No 8. Is proposed activity within 100 feet of a public road or cemetery or 300 feet of an occupied dwelling?
- Yes  No 9. Is the application submitted as a result of a Violation? NOV # \_\_\_\_\_
- Yes  No 10. Is the application submitted as a result of other laws or regulations or policies?  
*Explain:* \_\_\_\_\_
- Yes  No 11. Does the application affect the surface landowner or change the post mining land use?
- Yes  No 12. Does the application require or include underground design or mine sequence and timing? (Modification of R2P2)
- Yes  No 13. Does the application require or include collection and reporting of any baseline information?
- Yes  No 14. Could the application have any effect on wildlife or vegetation outside the current disturbed area?
- Yes  No 15. Does the application require or include soil removal, storage or placement?
- Yes  No 16. Does the application require or include vegetation monitoring, removal or revegetation activities?
- Yes  No 17. Does the application require or include construction, modification, or removal of surface facilities?
- Yes  No 18. Does the application require or include water monitoring, sediment or drainage control measures?
- Yes  No 19. Does the application require or include certified designs, maps or calculation?
- Yes  No 20. Does the application require or include subsidence control or monitoring?
- Yes  No 21. Have reclamation costs for bonding been provided?
- Yes  No 22. Does the application involve a perennial stream, a stream buffer zone or discharges to a stream?
- Yes  No 23. Does the application affect permits issued by other agencies or permits issued to other entities?

**Please attach four (4) review copies of the application. If the mine is on or adjacent to Forest Service land please submit five (5) copies, thank you.** (These numbers include a copy for the Price Field Office)

I hereby certify that I am a responsible official of the applicant and that the information contained in this application is true and correct to the best of my information and belief in all respects with the laws of Utah in reference to commitments, undertakings, and obligations, herein.

David C. Spillman  
Print Name


David C. Spillman, Engineering Manager  
Sign Name, Position, Date

6/13/03

Subscribed and sworn to before me this 13 day of JUNE, 2003


John C. Pappas  
Notary Public

My commission Expires: 3-7, 2006 }  
Attest: State of UTAH } ss:  
County of CARBON

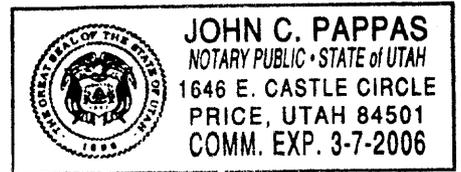


<b>For Office Use Only:</b>	<b>Assigned Tracking Number:</b>	<b>Received by Oil, Gas &amp; Mining</b>  <div style="font-size: 1.5em; font-weight: bold; margin: 10px 0;">RECEIVED</div> <div style="font-size: 1.2em; font-weight: bold; margin: 10px 0;">JUN 17 2003</div> <div style="font-size: 0.8em; margin: 10px 0;">DIV. OF OIL, GAS &amp; MINING</div>
-----------------------------	----------------------------------	---



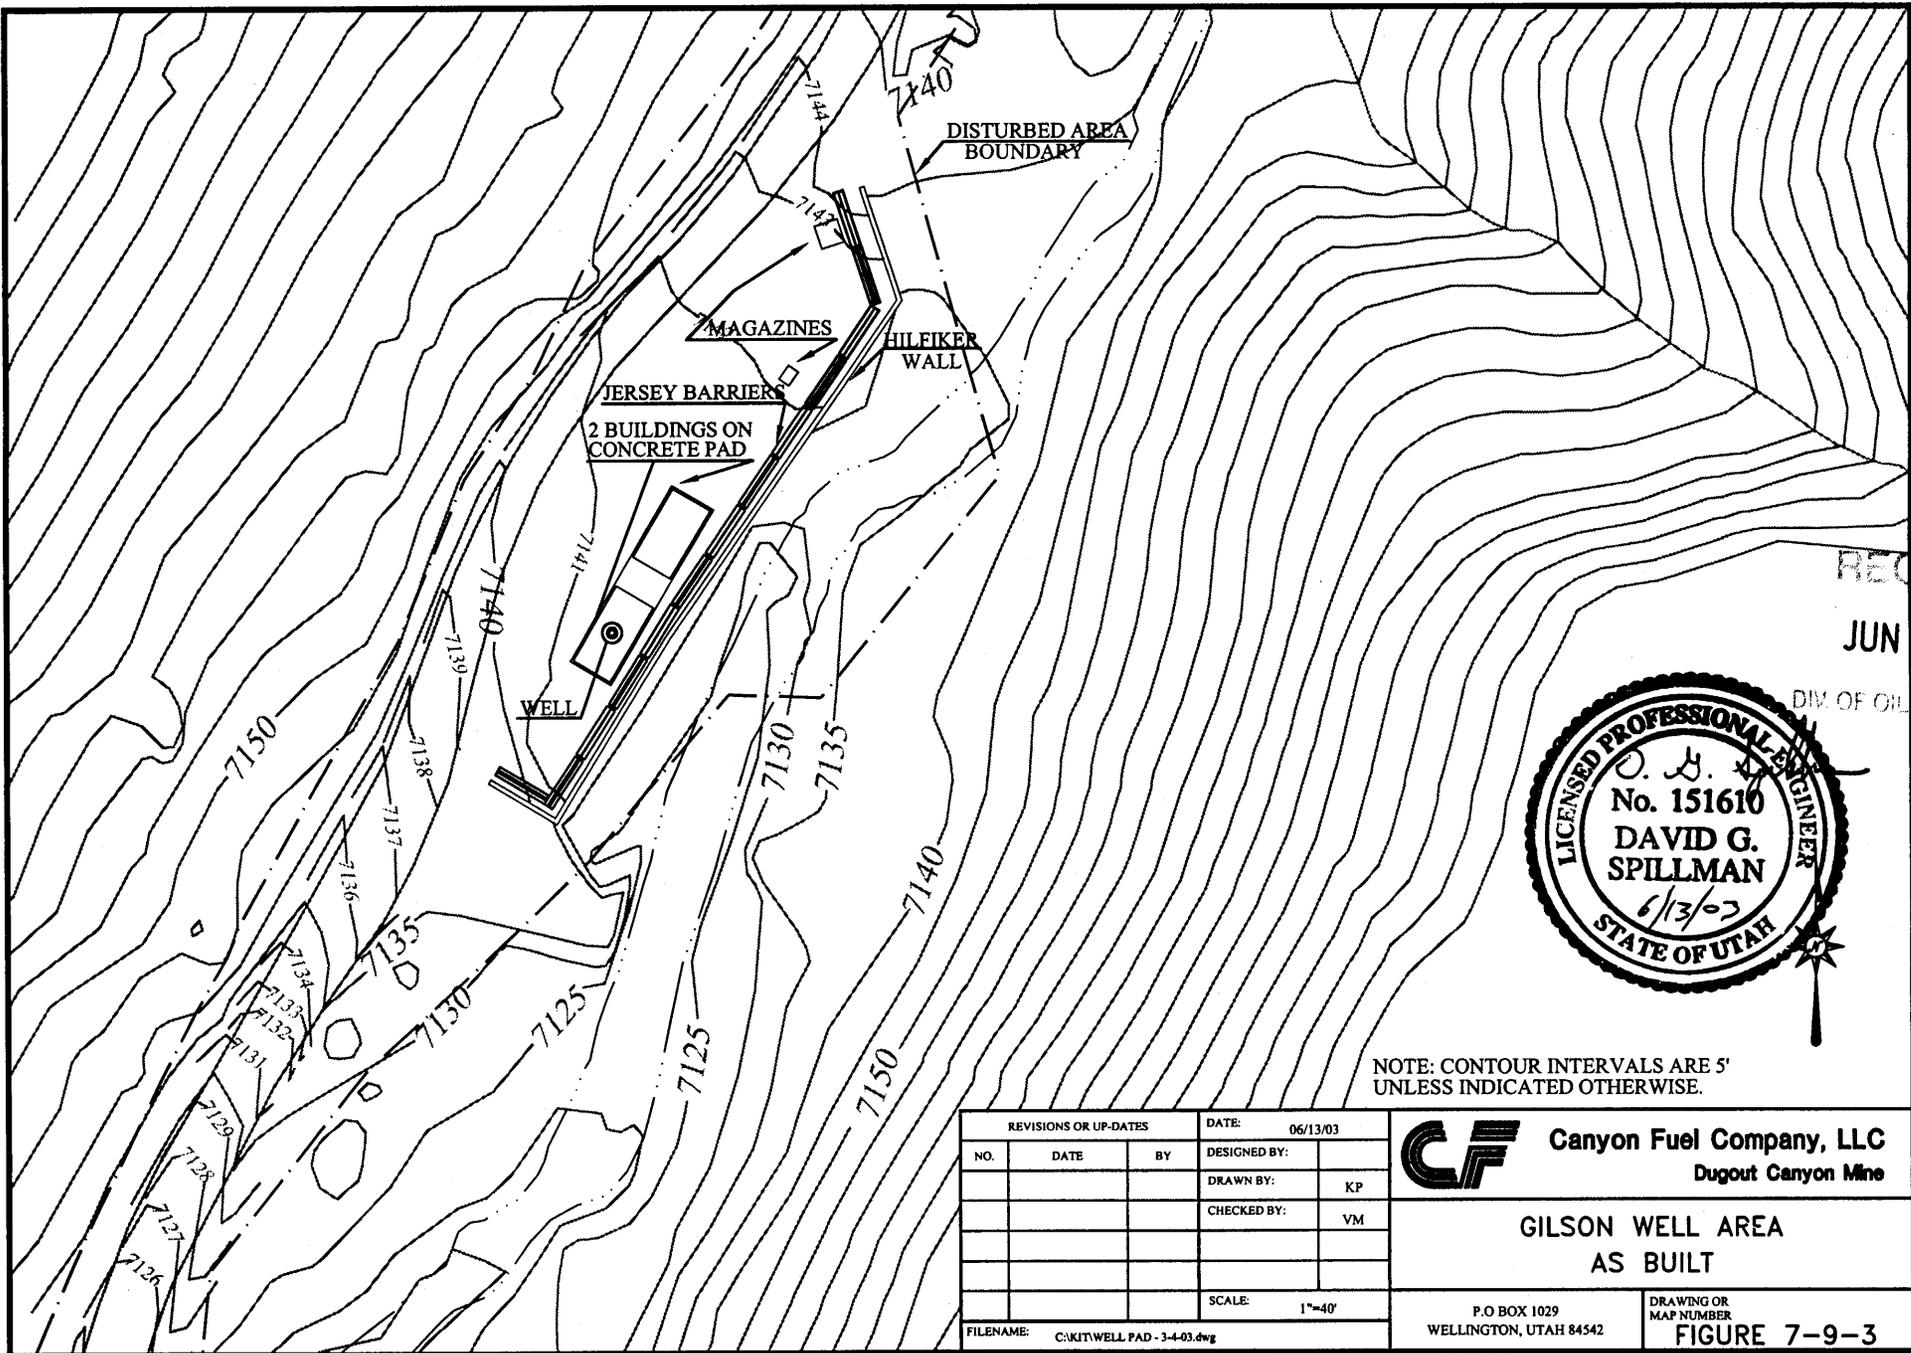

RECEIVED  
 JUN 17 2003  
 DIV. OF OIL, GAS & M.

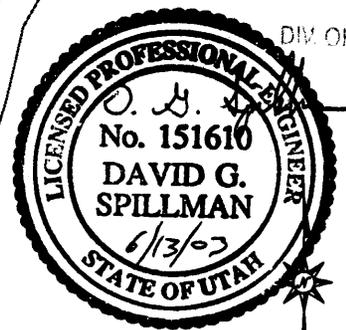

NOTE: CONTOUR INTERVALS ARE 5'  
 UNLESS INDICATED OTHERWISE.

REVISIONS OR UP-DATES			DATE:	06/13/03	
NO.	DATE	BY	DESIGNED BY:		
			DRAWN BY:	KP	
			CHECKED BY:	VM	
			SCALE:	1"=40'	
FILENAME: C:\KIT\WELL PAD - 3-4-03.dwg			P.O BOX 1029 WELLINGTON, UTAH 84542		DRAWING OR MAP NUMBER FIGURE 7-9-3

**CF** Canyon Fuel Company, LLC  
 Dugout Canyon Mine

GILSON WELL AREA  
 AS BUILT

APPENDIX 7-9