



GARY R. HERBERT
Governor

SPENCER J. COX
Lieutenant Governor

State of Utah

DEPARTMENT OF NATURAL RESOURCES

MICHAEL R. STYLER
Executive Director

Division of Oil, Gas and Mining

JOHN R. BAZA
Division Director

August 3, 2017

Kirt Tatton, General Manager
Canyon Fuel Company, LLC
P.O. Box 1029
Wellington, Utah 84542

Subject: Approval of As-Built Drawing, Task #5493, Canyon Fuel Company, LLC, Dugout Mine, C/007/0039

Dear Mr. Tatton:



The above-referenced amendment is approved effective August 3, 2017. This modification does not necessitate an update to the Technical Analysis. A stamped incorporated copy is enclosed for your copy of the Mining and Reclamation Plan.

If you have any questions, please feel free to call me at (801) 538-5325.


Sincerely,

Daron R. Haddock
Coal Program Manager


DRH/sqs
Enclosure
O:\007039.DUG\WG5493 ASBUILT\Approve.doc

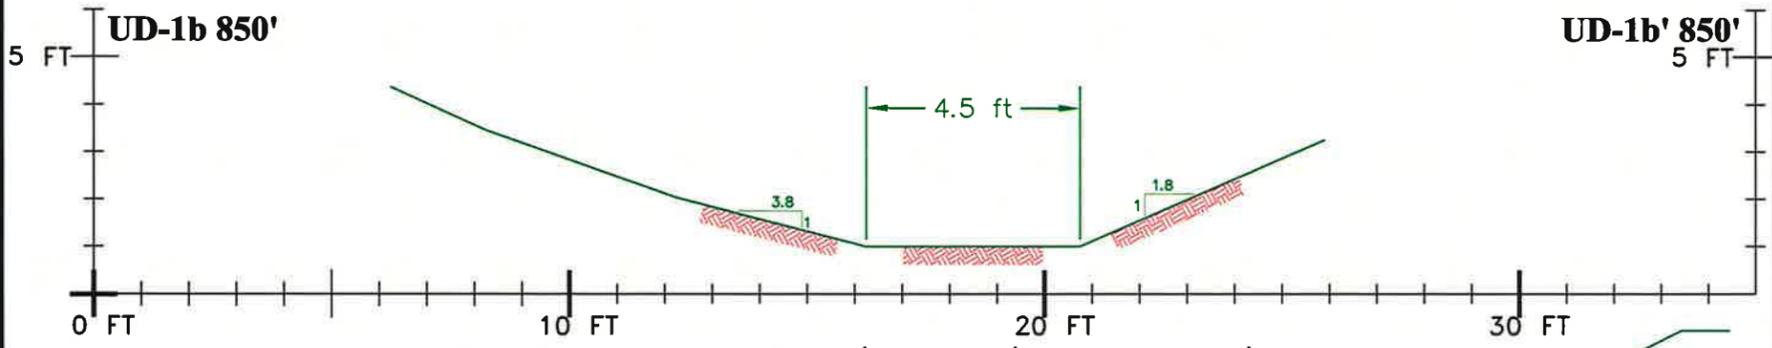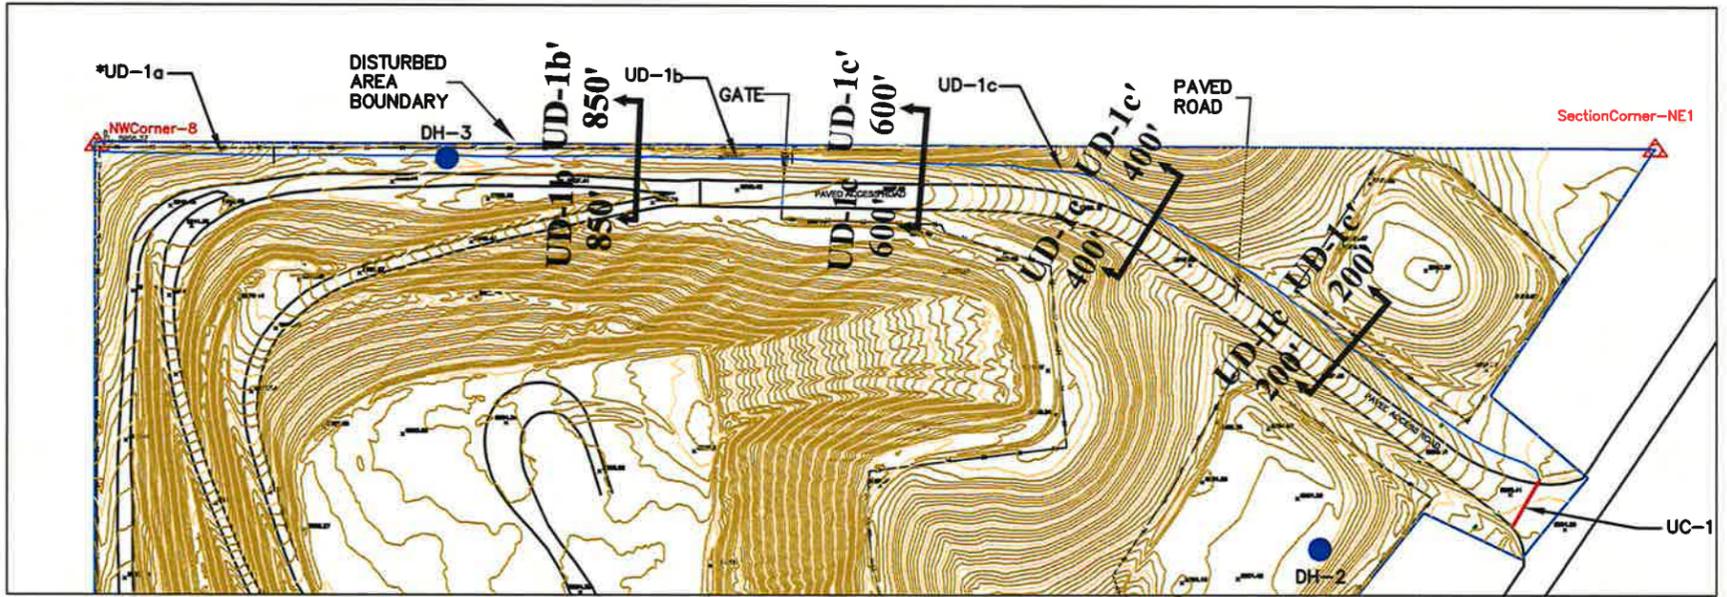


UD-1b cross section (Typical/Approximate);
844 ft from culvert UC-1

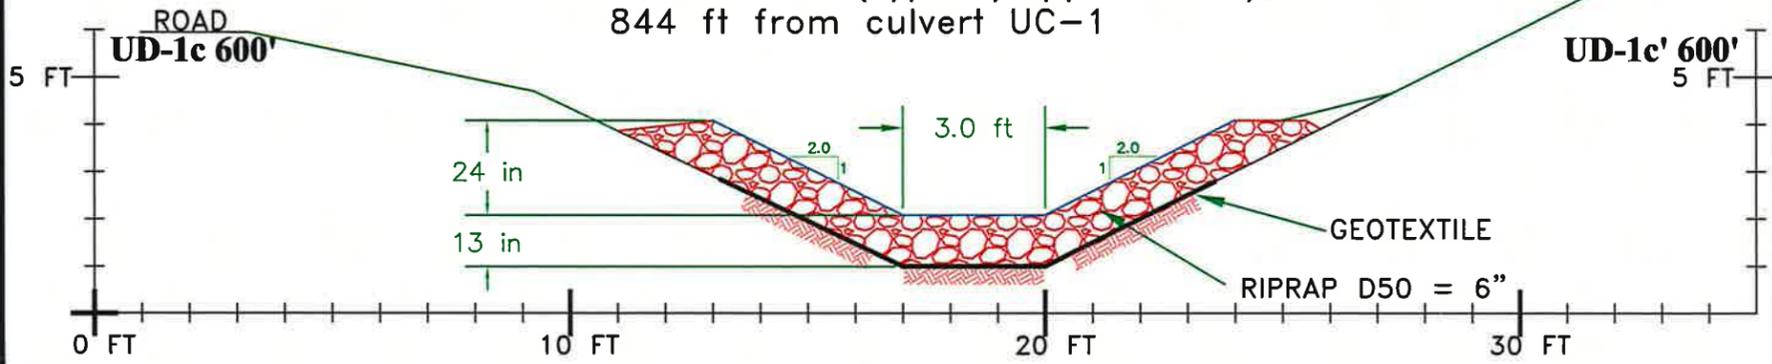


UD-1c cross section (Typical/Approximate);
600 ft from culvert UC-1

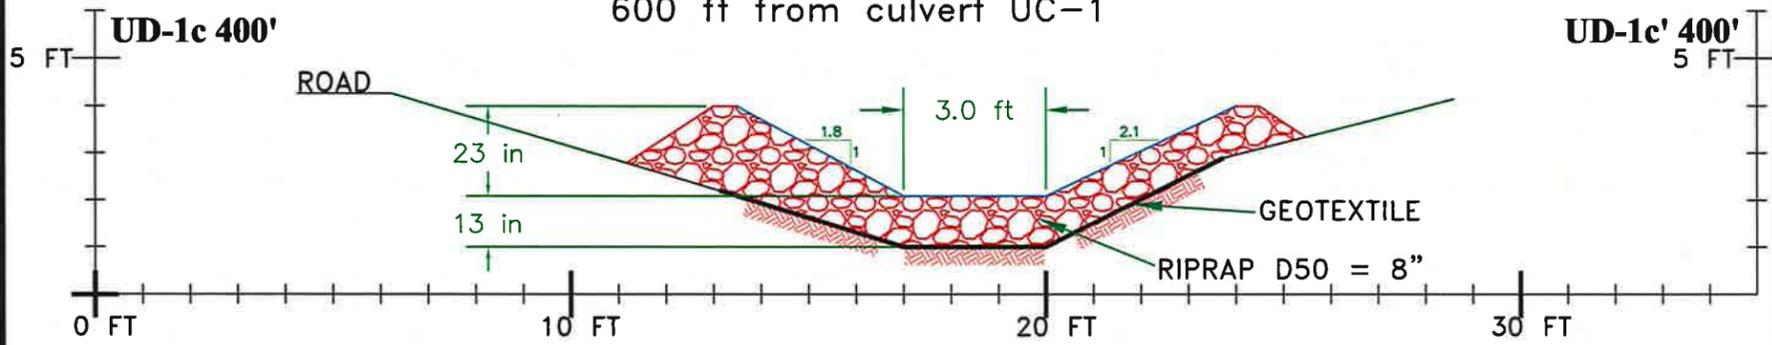

UD-1c cross section (Typical/Approximate);
400 ft from culvert UC-1

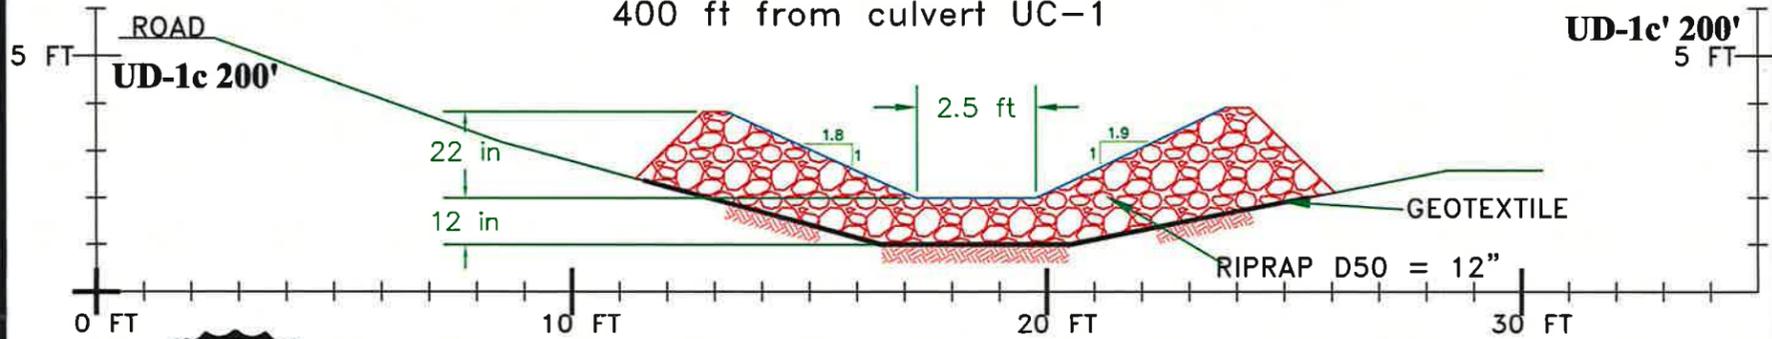

UD-1c cross section (Typical/Approximate);
200 ft from culvert UC-1

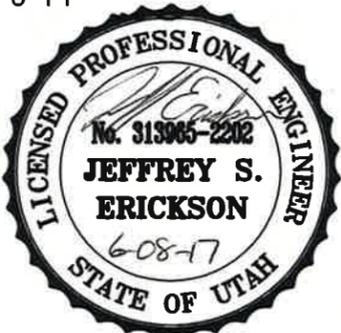

INCORPORATED

AUG 03 2017

* UD-1a was not constructed as the natural drainage conveyed the runoff properly

Div. of Oil, Gas & Mining

LEGEND 		REVISIONS OR UP-DATES NO. DATE BY	DATE: 6-08-17 DESIGNED BY:	Canyon Fuel Company, LLC Dugout Canyon Mine
		CHECKED BY:	DRAWN BY: JSE	
FILENAME: Ditches UD-1b And UD-1c AS BUILT			SCALE: 1:150	AS BUILT DITCHES UD-1B AND UD-1C WASTE ROCK SITE
				P.O. BOX 1029 WELLINGTON, UTAH 84542
				DRAWING OR MAP NUMBER #####