

0011

*JK Incoming
c/007/0045*

From: Steve Christensen
To: OGMCOAL
Date: 9/15/2008 2:21 PM
Subject: COVOL: Correspondence (September 12th, 2008)
Place: OGMCOAL
Attachments: As-Built (9-11-08).pdf

>>> Gina Rau <grau@headwaters.com> 9/12/2008 9:02 AM >>>

Hello Steve,

We have a first draft of the survey that was done on our Wellington plant. We need the surveyors to finish adding the roads to the map, but I wanted to check with you to see if you or any of the others reviewers need any additional information added to the map. One question that we have for you, do we need to show a detailed equipment layout or is what shown on this drawing sufficient?

Thank you,

Gina

From: Ron Sherbak
Sent: Thursday, September 11, 2008 4:29 PM
To: Gina Rau
Subject: FW: Wellington Plant Site Survey

Gina,
Any comments?
Ron S

Ronald S. Sherbak
Director, Project Engineering
Headwater Energy Services
10653 S. River Front Parkway, Suite #300
South Jordan, Utah 84095
P: 801-984-9464
F: 801-984-9419
C: 801-541-0256
rsherbak@headwaters.com

From: Tom Paluso [<mailto:tompaluso@preciscom.net>]
Sent: Thursday, September 11, 2008 3:47 PM
To: Ron Sherbak
Subject: Re: Wellington Plant Site Survey

Ron:

Attached is the draft copy of the survey in pdf format. Please take a look at it and see if you want any changes.

Tom

----- Original Message -----

From: Ron Sherbak (<mailto:rsherbak@headwaters.com>)

To: Tom Paluso (<mailto:tompaluso@preciscom.net>)

Cc: Gina Rau (<mailto:grau@headwaters.com>)

Sent: Thursday, September 11, 2008 9:31 AM

Subject: RE: Wellington Plant Site Survey

Tom,
Please advise on the survey progress.
Thanks,
Ron S

Ronald S. Sherbak
Director, Project Engineering
Headwater Energy Services
10653 S. River Front Parkway, Suite #300
South Jordan, Utah 84095
P: 801-984-9464
F: 801-984-9419
C: 801-541-0256
rsherbak@headwaters.com


From: Tom Paluso [<mailto:tompaluso@preciscom.net>]
Sent: Tuesday, August 19, 2008 2:43 PM
To: Ron Sherbak
Subject: Wellington Plant Site Survey

Ron:

Attached is the proposal for completing an "as-built" drawing of your Wellington site. I have instructed the surveyors to start on this project. Please let me know if you have any questions.

Tom

Tom Paluso, P. E.
Chief Engineer
EIS Environmental & Engineering Consulting
31 North Main Street
Helper, UT 84526
Phone: 435-472-3814, 800-641-2927
Fax: 435-472-8780
Email: tompaluso@preciscom.net

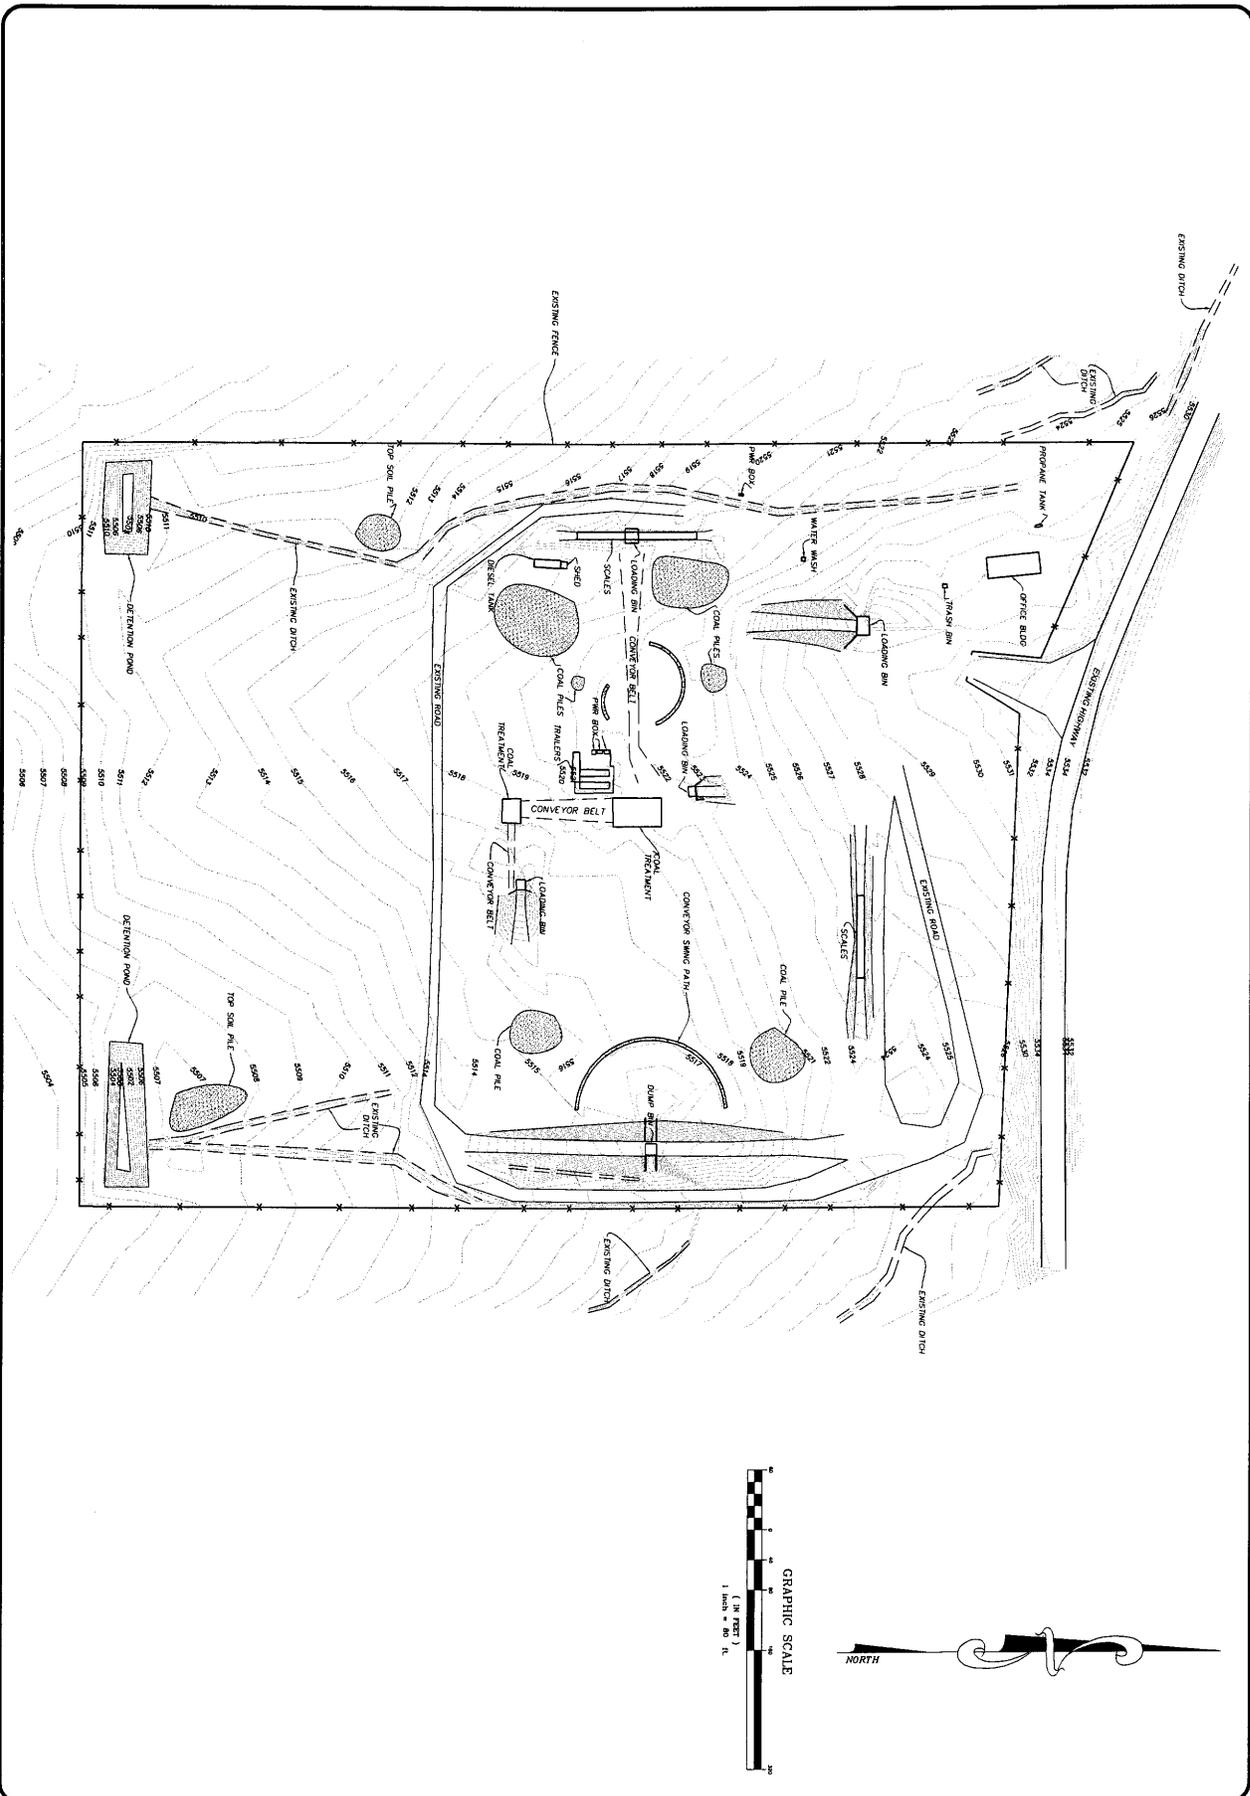

PROJECT NO. 8-306-01
DATE SCALE 9-8-08
DRAWN BY M
CHECKED BY M
ENGINEER M
VEN SCALE M
M

COVOL WASH PLANT
AS-BUILT
SEPTEMBER 2008

H&H
ENGINEERING AND SURVEYING, INC.
796 E PACIFIC DR. STE. A, AMERICAN FORK, UT 84003
TEL: (801) 756-2488 FAX: (801) 756-3499

NO.	DATE	DESCRIPTION	BY

01