

PERMIT CHANGE TRACKING FORM

DATE RECEIVED	11/29/94	PERMIT NUMBER	ACT/015/002
Title of Proposal:	Reclamation Plan	PERMIT CHANGE #	94c
Description:	Change Needs verification	PERMITTEE	Western State Mineral
		MINE NAME	J. B. King

Given to Sharon on 11/29.

	DATE DUE	DATE DONE	RESULT
<input type="checkbox"/> 15 DAY INITIAL RESPONSE TO PERMIT CHANGE APPLICATION			<input type="checkbox"/> ACCEPTED <input type="checkbox"/> REJECTED
<input type="checkbox"/> Notice of Review Status of proposed permit change sent to the Permittee.			Permit Change Classification <input type="checkbox"/> Significant Permit Revision <input type="checkbox"/> Permit Amendment <input type="checkbox"/> Incidental Boundary Change
<input type="checkbox"/> Request additional review copies prior to Division/Other Agency review.			
<input type="checkbox"/> Notice of Approval of Publication. (If change is a Significant Revision.)			
<input type="checkbox"/> Notice of request to modify proposed permit change prior to approval.			

REVIEW TRACKING	INITIAL REVIEW		MODIFIED REVIEW		FINAL REVIEW AND FINDINGS	
DOGM REVIEWER	DUE	DONE	DUE	DONE	DUE	DONE
<input type="checkbox"/> Administrative						
<input checked="" type="checkbox"/> Biology <i>SW</i>	12/16					
<input type="checkbox"/> Engineering						
<input type="checkbox"/> Geology						
<input type="checkbox"/> Soils <i>HS</i>	12/16					
<input type="checkbox"/> Hydrology <i>JM</i>	12/16					
<input type="checkbox"/> Bonding						
<input type="checkbox"/> AVS Check						

COORDINATED REVIEWS	DUE	DONE	DUE	DONE	DUE	DONE
<input type="checkbox"/> OSMRE						
<input type="checkbox"/> US Forest Service						
<input type="checkbox"/> Bureau of Land Management						
<input type="checkbox"/> US Fish and Wildlife Service						
<input type="checkbox"/> US National Parks Service						
<input type="checkbox"/> UT Environmental Quality						
<input type="checkbox"/> UT Water Resources						
<input type="checkbox"/> UT Water Rights						
<input type="checkbox"/> UT Wildlife Resources						
<input type="checkbox"/> UT State History						
<input type="checkbox"/> Other						

<input type="checkbox"/> Public Notice/Comment/Hearing Complete (If the permit change is a Significant Revision)	<input type="checkbox"/> Permit Change Approval Form signed and approved effective as of this date. <input type="checkbox"/> Permit Change Denied.
<input type="checkbox"/> Copies of permit change marked and ready for MRP.	<input type="checkbox"/> Notice of <input type="checkbox"/> Approval <input type="checkbox"/> Denial to Permittee.
<input type="checkbox"/> Special Conditions/Stipulations written for approval.	<input type="checkbox"/> Copy of Approved Permit Change to File.
<input type="checkbox"/> TA and CHIA modified as required.	<input type="checkbox"/> Copy of Approved Permit Change to Permittee.
<input type="checkbox"/> Permit Change Approval Form ready for approval.	<input type="checkbox"/> Copies to Other Agencies and Price Field Office.

APPLICATION FOR PERMIT CHANGE

94C

Title of Change: Permit Amendment
J.B. King Mine - Reclamation Plan Revision

Permit Number: ACT / 015 / 002

Mine: J.B. KING

Permittee: WSMC

Description, include reason for change and timing required to implement: Reconfiguration of reclaimed J.B. King Mine site to address remedial actions required by NOV's # 91-32-6-1, # 93-25-3-1; and # 93-25-5-1. Abatement in the field is presently underway per DOGM approval.

- | | | |
|---|--|--|
| <input type="checkbox"/> Yes | <input checked="" type="checkbox"/> No | 1. Change in the size of the Permit Area? _____ acres <input type="checkbox"/> increase <input type="checkbox"/> decrease. |
| <input type="checkbox"/> Yes | <input checked="" type="checkbox"/> No | 2. Change in the size of the Disturbed Area? _____ acres <input type="checkbox"/> increase <input type="checkbox"/> decrease. |
| <input type="checkbox"/> Yes | <input checked="" type="checkbox"/> No | 3. Will permit change include operations outside the Cumulative Hydrologic Impact Area? |
| <input type="checkbox"/> Yes | <input checked="" type="checkbox"/> No | 4. Will permit change include operations in hydrologic basins other than currently approved? |
| <input type="checkbox"/> Yes | <input checked="" type="checkbox"/> No | 5. Does permit change result from cancellation, reduction or increase of insurance or reclamation bond? |
| <input type="checkbox"/> Yes | <input checked="" type="checkbox"/> No | 6. Does permit change require or include public notice publication? |
| <input checked="" type="checkbox"/> Yes | <input type="checkbox"/> No | 7. Permit change as a result of a Violation? Violation # _____ |
| <input checked="" type="checkbox"/> Yes | <input type="checkbox"/> No | 8. Permit change as a result of a Division Order? D.O.# _____ |
| <input type="checkbox"/> Yes | <input checked="" type="checkbox"/> No | 9. Permit change as a result of other laws or regulations? Explain: _____ |
| <input checked="" type="checkbox"/> Yes | <input type="checkbox"/> No | 10. Does permit change require or include ownership, control, right-of-entry, or compliance information? |
| <input type="checkbox"/> Yes | <input checked="" type="checkbox"/> No | 11. Does the permit change affect the surface landowner or change the post mining land use? |
| <input checked="" type="checkbox"/> Yes | <input type="checkbox"/> No | 12. Does permit change require or include collection and reporting of any baseline information? |
| <input type="checkbox"/> Yes | <input checked="" type="checkbox"/> No | 13. Could the permit change have any effect on wildlife or vegetation outside the current disturbed area? |
| <input checked="" type="checkbox"/> Yes | <input type="checkbox"/> No | 14. Does permit change require or include soil removal, storage or placement? |
| <input checked="" type="checkbox"/> Yes | <input type="checkbox"/> No | 15. Does permit change require or include vegetation monitoring, removal or revegetation activities? |
| <input type="checkbox"/> Yes | <input checked="" type="checkbox"/> No | 16. Does permit change require or include construction, modification, or removal of surface facilities? |
| <input checked="" type="checkbox"/> Yes | <input type="checkbox"/> No | 17. Does permit change require or include water monitoring, sediment or drainage control measures? |
| <input checked="" type="checkbox"/> Yes | <input type="checkbox"/> No | 18. Does permit change require or include certified designs, maps, or calculations? |
| <input type="checkbox"/> Yes | <input checked="" type="checkbox"/> No | 19. Does permit change require or include underground design or mine sequence and timing? |
| <input type="checkbox"/> Yes | <input checked="" type="checkbox"/> No | 20. Does permit change require or include subsidence control or monitoring? |
| <input type="checkbox"/> Yes | <input checked="" type="checkbox"/> No | 21. Have reclamation costs for bonding been provided or revised for any change in the reclamation plan? |
| <input type="checkbox"/> Yes | <input checked="" type="checkbox"/> No | 22. Is permit change within 100 feet of a public road or perennial stream or 500 feet of an occupied dwelling? |
| <input type="checkbox"/> Yes | <input checked="" type="checkbox"/> No | 23. Is this permit change coal exploration activity <input type="checkbox"/> inside <input type="checkbox"/> outside of the permit area? |

Attach 3 complete copies of proposed permit change as it would be incorporated into the Mining and Reclamation Plan.


I hereby certify that I am a responsible official of the applicant and that the information contained in this application is true and correct to the best of my information and belief in all respects with the laws of Utah in reference to commitments, undertakings and obligations, herein.

E.M. Gerick
 Signed - Name - Position - Date
E.M. Gerick - V.P. Operations Nov. 28, 1994

Subscribed and sworn to before me this 28 day of NOVEMBER, 1994
Debra L. Butcher
 Notary Public

DEBRA L. BUTCHER
 Notary Public - State of Nevada
 Appointment Recorded in Washoe County
 MY APPOINTMENT EXPIRES MAR. 15, 1996

My Commission Expires: _____, 19____
 Attest: STATE OF _____
 COUNTY OF _____

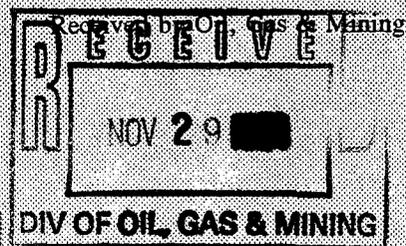

ASSIGNED PERMIT CHANGE NUMBER _____

Application for Permit Change Detailed Schedule of Changes to the Permit

Title of Change: <u>Permit Amendment</u> <u>J.B. King Mine - Reclamation Plan Revision</u>	Permit Number: <u>ACT 1015 1002</u>
	Mine: <u>J.B. King</u>
	Permittee: <u>WSMC</u>

Provide a detailed listing of all changes to the mining and reclamation plan which will be required as a result of this proposed permit change. Individually list all maps and drawings which are to be added, replaced, or removed from the plan. Include changes of the table of contents, section of the plan, pages, or other information as needed to specifically locate, identify and revise the exiting mining and reclamation plan. Include page, section and drawing numbers as part of the description.

			DESCRIPTION OF MAP, TEXT, OR MATERIALS TO BE CHANGED
<input checked="" type="checkbox"/> ADD	<input type="checkbox"/> REPLACE	<input type="checkbox"/> REMOVE	UMC 782.19 - Text and documents
<input checked="" type="checkbox"/> ADD	<input type="checkbox"/> REPLACE	<input type="checkbox"/> REMOVE	UMC 784.13 - Text and map
<input checked="" type="checkbox"/> ADD	<input type="checkbox"/> REPLACE	<input type="checkbox"/> REMOVE	UMC 784.15 - Text and documents
<input checked="" type="checkbox"/> ADD	<input type="checkbox"/> REPLACE	<input type="checkbox"/> REMOVE	UMC 784.16 - Text only
<input checked="" type="checkbox"/> ADD	<input type="checkbox"/> REPLACE	<input type="checkbox"/> REMOVE	UMC 784.18 - Text only
<input checked="" type="checkbox"/> ADD	<input type="checkbox"/> REPLACE	<input type="checkbox"/> REMOVE	UMC 805.11 - Text only
<input checked="" type="checkbox"/> ADD	<input type="checkbox"/> REPLACE	<input type="checkbox"/> REMOVE	UMC 817.22 - Text and documents
<input checked="" type="checkbox"/> ADD	<input type="checkbox"/> REPLACE	<input type="checkbox"/> REMOVE	UMC 817.25 - Text only
<input checked="" type="checkbox"/> ADD	<input type="checkbox"/> REPLACE	<input type="checkbox"/> REMOVE	UMC 817.42 - Text only
<input checked="" type="checkbox"/> ADD	<input type="checkbox"/> REPLACE	<input type="checkbox"/> REMOVE	UMC 817.116 Text only
<input type="checkbox"/> ADD	<input type="checkbox"/> REPLACE	<input type="checkbox"/> REMOVE	
<input type="checkbox"/> ADD	<input type="checkbox"/> REPLACE	<input type="checkbox"/> REMOVE	
Any other specific or special instructions required for insertion of this proposal into the Mining and Reclamation Plan?

PERMIT CHANGE TRACKING FORM

DATE RECEIVED	11/29/94	PERMIT NUMBER	ACT/015/002
Title of Proposal:	Reclamation Plan	PERMIT CHANGE #	94c
Description:	Change Needs verification	PERMITTEE	Western State Mineral
		MINE NAME	J. B. King

Given to Stan on 11/29.

	DATE DUE	DATE DONE	RESULT
<input type="checkbox"/> 15 DAY INITIAL RESPONSE TO PERMIT CHANGE APPLICATION			<input type="checkbox"/> ACCEPTED <input type="checkbox"/> REJECTED
<input type="checkbox"/> Notice of Review Status of proposed permit change sent to the Permittee.			Permit Change Classification
<input type="checkbox"/> Request additional review copies prior to Division/Other Agency review.			<input type="checkbox"/> Significant Permit Revision
<input type="checkbox"/> Notice of Approval of Publication. (If change is a Significant Revision.)			<input type="checkbox"/> Permit Amendment
<input type="checkbox"/> Notice of request to modify proposed permit change prior to approval.			<input type="checkbox"/> Incidental Boundary Change

H/2/95 submittal

REVIEW TRACKING	INITIAL REVIEW		MODIFIED REVIEW		FINAL REVIEW AND FINDINGS	
DOGM REVIEWER	DUE	DONE	DUE	DONE	DUE	DONE
<input type="checkbox"/> Administrative						
<input checked="" type="checkbox"/> Biology <i>SW</i>	12-16		5/19			
<input type="checkbox"/> Engineering						
<input type="checkbox"/> Geology						
<input checked="" type="checkbox"/> Soils <i>HS</i>	12/16		5/19			
<input checked="" type="checkbox"/> Hydrology <i>TM</i>	12/16		5/19			
<input type="checkbox"/> Bonding						
<input type="checkbox"/> AVS Check						

To be submitted by August 4/95

COORDINATED REVIEWS	DUE	DONE	DUE	DONE	DUE	DONE
<input type="checkbox"/> OSMRE						
<input type="checkbox"/> US Forest Service						
<input type="checkbox"/> Bureau of Land Management						
<input type="checkbox"/> US Fish and Wildlife Service						
<input type="checkbox"/> US National Parks Service						
<input type="checkbox"/> UT Environmental Quality						
<input type="checkbox"/> UT Water Resources						
<input type="checkbox"/> UT Water Rights						
<input type="checkbox"/> UT Wildlife Resources						
<input type="checkbox"/> UT State History						
<input type="checkbox"/> Other						


<input type="checkbox"/> Public Notice/Comment/Hearing Complete (If the permit change is a Significant Revision)	<input type="checkbox"/> Permit Change Approval Form signed and approved effective as of this date. <input type="checkbox"/> Permit Change Denied.
<input type="checkbox"/> Copies of permit change marked and ready for MRP.	<input type="checkbox"/> Notice of <input type="checkbox"/> Approval <input type="checkbox"/> Denial to Permittee.
<input type="checkbox"/> Special Conditions/Stipulations written for approval.	<input type="checkbox"/> Copy of Approved Permit Change to File.
<input type="checkbox"/> TA and CHIA modified as required.	<input type="checkbox"/> Copy of Approved Permit Change to Permittee.
<input type="checkbox"/> Permit Change Approval Form ready for approval.	<input type="checkbox"/> Copies to Other Agencies and Base Field Office.



Certified Mail
Return Receipt Requested

April 7, 1995

Mr. Daron Haddock, Permit Supervisor
State of Utah
Division of Oil, Gas and Mining
355 West North Temple
3 Triad Center, Suite 350
Salt Lake City, Utah 84180-1203

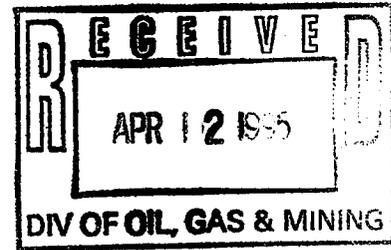

Re: J.B. King Mine, ACT/015/002, Folder #2, Emery County, Utah - As Built Drawings of 1994 Reclamation Work completed Nov-Dec. 1994

Dear Daron:

Please find attached three (3) copies of the as-built drawings of 1994 Reclamation Work completed during Nov.-Dec. 1994, at the J.B. King Reclaimed Minesite. I apologize for the delay in getting this information to you, however, I had some problems with the original survey data submitted to me and had to get that revised prior to submittal to you.

I still have not received payment for the invoice submitted to your office in February 1995 (this was for reclamation of the Vegetation Test Plot at the site); nor have I received any written response as to the completeness or acceptability of the *Permit Amendment* to the J.B. King Reclamation Plan mailed to your office on November 28, 1994. Would you please check on the status of these two subjects and respond back to me.


Please let me know if you have any questions on the information submitted; and I look forward to your response on the status of the two subjects that I have brought to your attention.

Sincerely,

E.M. Gerick
Vice President, Operations

CC:Lowell Braxton, DOGM
Pamela Grubaugh-Littig, DOGM
Joe Helfrich, DOGM

JB KING PROJECT
AS-BUILT CONSTRUCTION DETAIL
NOV-DEC 1994

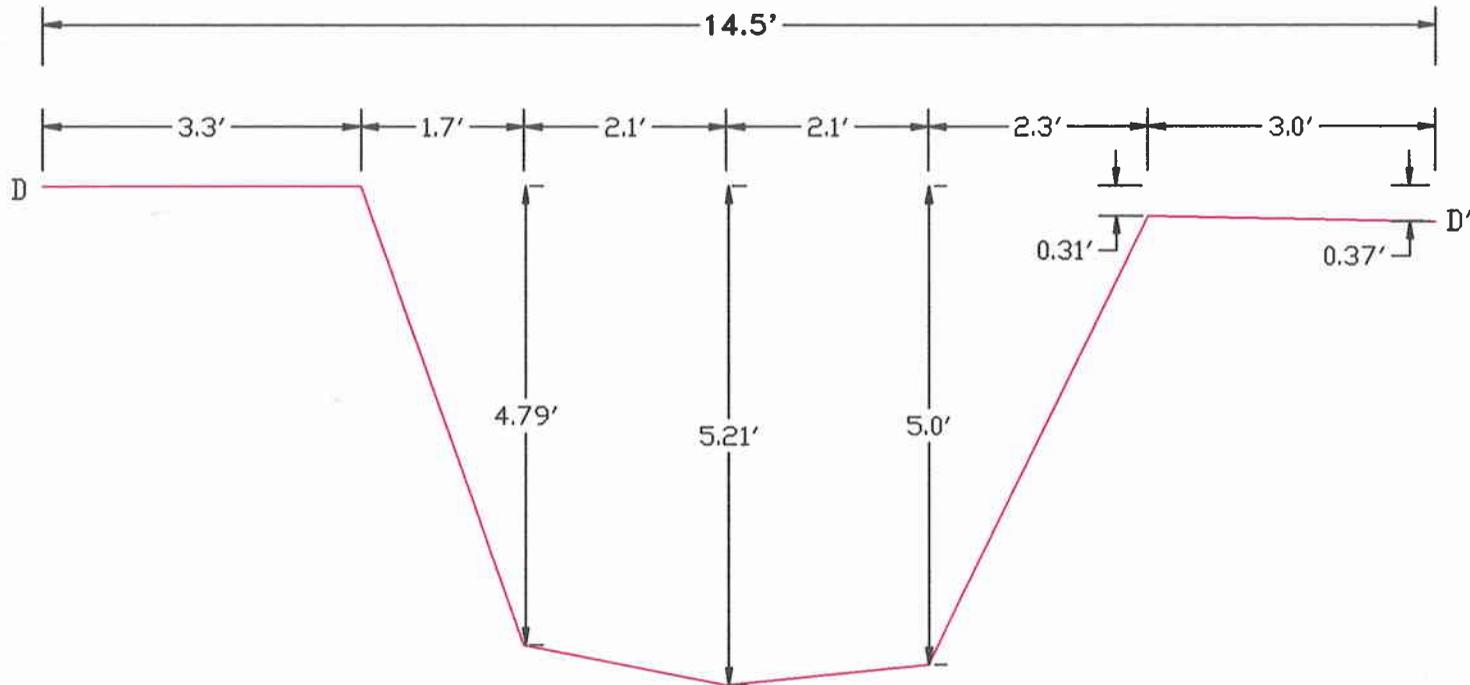


TYPICAL X-SECTION D-D' OF NEW DRAINAGE CHANNEL
Designated as Main Feeder Ditch (also Ditch #2)

Scale: 1"=2'


 WESTERN STATES MINERALS CORP.	
TITLE: 1994 Reclamation Plan Revision showing typical x-section D-D' of new drainage channel	
PROJECT: J.B.KING RECLAMATION	
STATE: UTAH	COUNTY: EMERY
SCALE: 1"=2'	DRAWING NO.:
DATE: 4-5-95	DRWN BY: DM/EG REV.:

JB KING PROJECT
AS-BUILT CONSTRUCTION DETAIL
NOV-DEC 1994

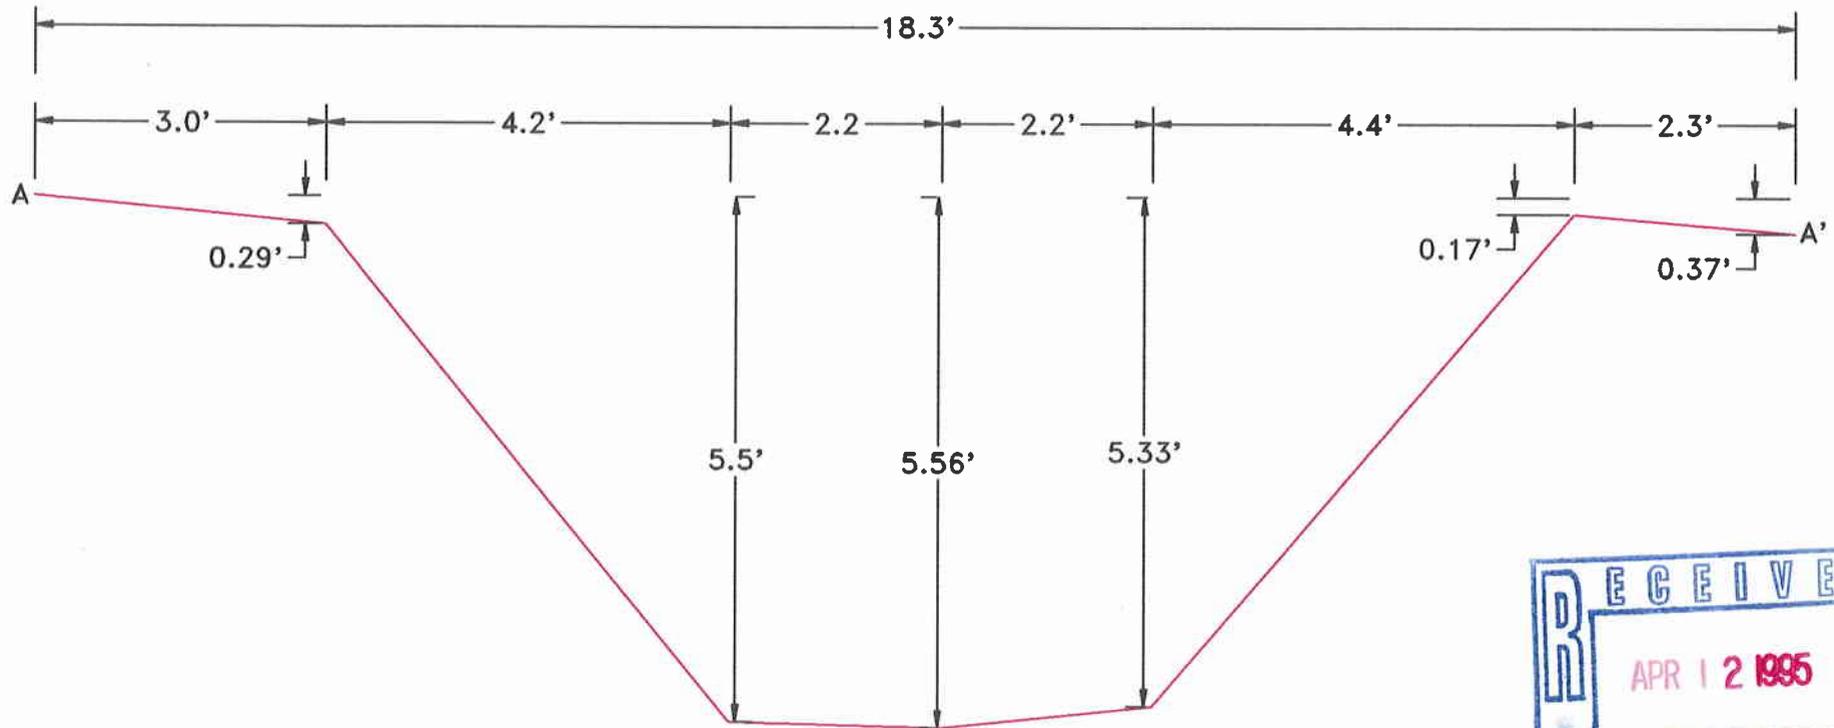


TYPICAL X-SECTION A-A' OF NEW DRAINAGE CHANNEL
Designated as Feeder Ditch (also Ditch #1)

Scale: 1"=2'

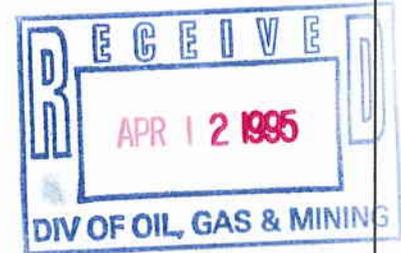

 WESTERN STATES MINERALS CORP.	
TITLE: 1994 Reclamation Plan Revision showing typical x-section A-A' of new drainage channel	
PROJECT: J.B.KING RECLAMATION	
STATE: UTAH	COUNTY: EMERY
SCALE: 1"=2'	DRAWING NO.:
DATE: 4-5-95	DRWN BY:DM/EG REV.:

JB KING PROJECT
 AS-BUILT CONSTRUCTION DETAIL
 NOV-DEC 1994

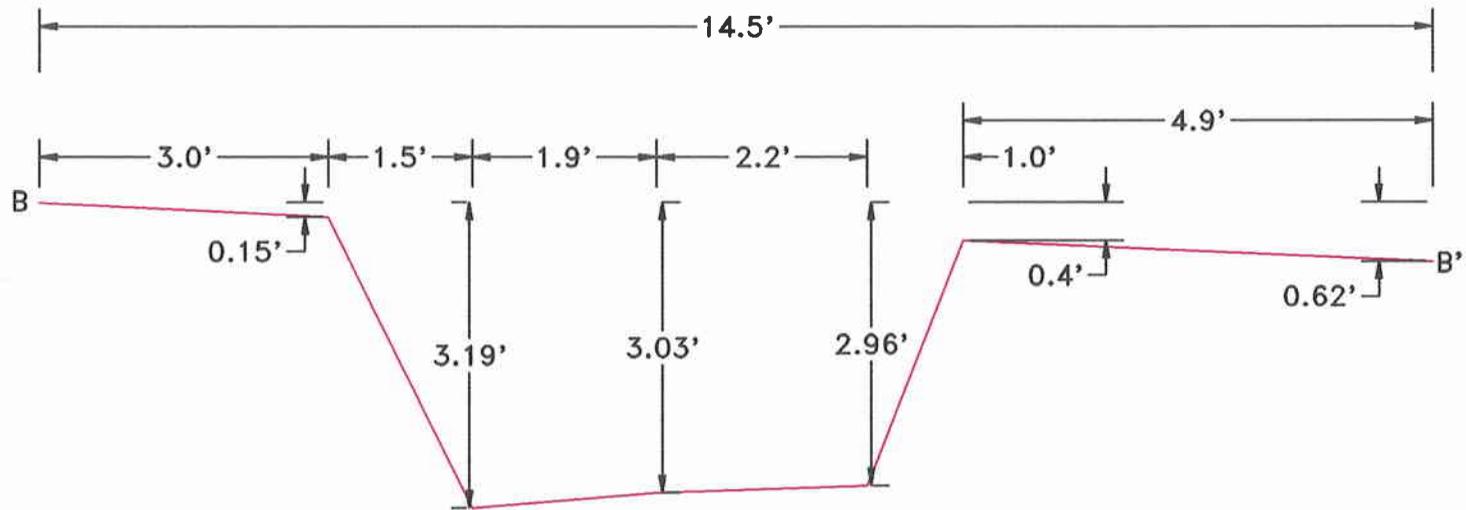


TYPICAL X-SECTION B-B' OF NEW DRAINAGE CHANNEL
 Designated as Feeder Ditch (also Ditch#1)

Scale: 1"=2'

 WESTERN STATES MINERALS CORP.	
TITLE: 1994 Reclamation Plan Revision showing typical x-section B-B' of new drainage channel	
PROJECT: J.B.KING RECLAMATION	
STATE: UTAH	COUNTY: EMERY
SCALE: 1"=2'	DRAWING NO.:
DATE: 4-5-95	DRWN BY:DM/EG REV.:

JB KING PROJECT
 AS-BUILT CONSTRUCTION DETAIL
 NOV-DEC 1994

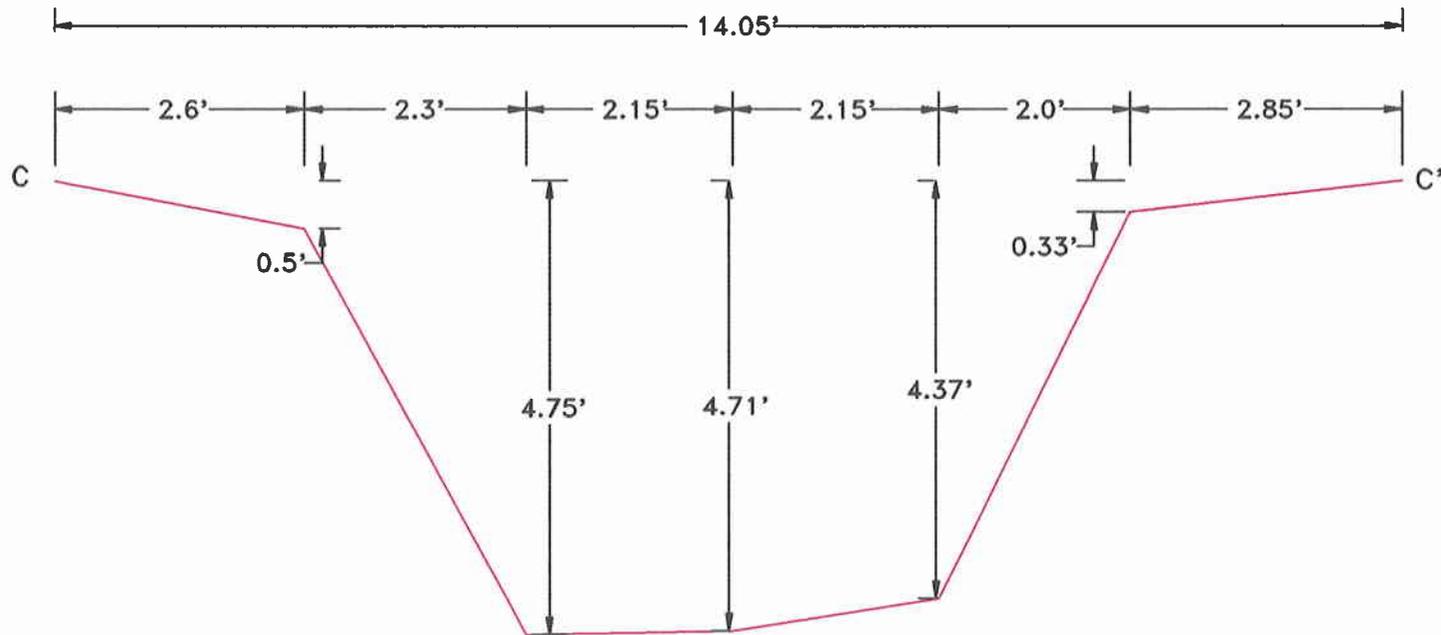

TYPICAL X-SECTION C-C' OF NEW DRAINAGE CHANNEL
 Designated as Main Feeder Ditch (also Ditch #2)

Scale: 1"=2'

		WESTERN STATES MINERALS CORP.
TITLE: 1994 Reclamation Plan Revision showing typical x-section C-C' of new drainage channel		
PROJECT: J.B.KING RECLAMATION		
STATE: UTAH	COUNTY: EMERY	
SCALE: 1"=2'	DRAWING NO.:	
DATE: 4-5-95	DRWN BY: DM/EG	REV.:

PERMIT CHANGE TRACKING FORM

DATE RECEIVED	11/29/94	PERMIT NUMBER	ACT/015/002
Title of Proposal:	Reclamation Plan	PERMIT CHANGE #	94C
Description:	Change Needs verification	PERMITTEE	Western State Mineral
		MINE NAME	J. B. King

<i>gone to start on 11/29</i>	DATE DUE	DATE DONE	RESULT	
<input type="checkbox"/> 15 DAY INITIAL RESPONSE TO PERMIT CHANGE APPLICATION			<input type="checkbox"/> ACCEPTED	<input type="checkbox"/> REJECTED
<input type="checkbox"/> Notice of Review Status of proposed permit change sent to the Permittee.			Permit Change Classification	
<input type="checkbox"/> Request additional review copies prior to Division/Other Agency review.			<input type="checkbox"/> Significant Permit Revision	
<input type="checkbox"/> Notice of Approval of Publication. (If change is a Significant Revision.)			<input type="checkbox"/> Permit Amendment	
<input type="checkbox"/> Notice of request to modify proposed permit change prior to approval.			<input type="checkbox"/> Incidental Boundary Change	

REVIEW TRACKING	INITIAL REVIEW		MODIFIED REVIEW		FINAL REVIEW AND FINDINGS	
DOGM REVIEWER	DUE	DONE	DUE	DONE	DUE	DONE
<input type="checkbox"/> Administrative						
<input checked="" type="checkbox"/> Biology <i>SW</i>	12-16					
<input type="checkbox"/> Engineering						
<input type="checkbox"/> Geology						
<input checked="" type="checkbox"/> Soils <i>HS</i>	12/16					
<input checked="" type="checkbox"/> Hydrology <i>JM</i>	12/16					
<input type="checkbox"/> Bonding						
<input type="checkbox"/> AVS Check						

COORDINATED REVIEWS	DUE	DONE	DUE	DONE	DUE	DONE
<input type="checkbox"/> OSMRE						
<input type="checkbox"/> US Forest Service						
<input type="checkbox"/> Bureau of Land Management						
<input type="checkbox"/> US Fish and Wildlife Service						
<input type="checkbox"/> US National Parks Service						
<input type="checkbox"/> UT Environmental Quality						
<input type="checkbox"/> UT Water Resources						
<input type="checkbox"/> UT Water Rights						
<input type="checkbox"/> UT Wildlife Resources						
<input type="checkbox"/> UT State History						
<input type="checkbox"/> Other						

<input type="checkbox"/> Public Notice/Comment/Hearing Complete (If the permit change is a Significant Revision)	<input type="checkbox"/> Permit Change Approval Form signed and approved effective as of this date. <input type="checkbox"/> Permit Change Denied.
<input type="checkbox"/> Copies of permit change marked and ready for MRP.	<input type="checkbox"/> Notice of <input type="checkbox"/> Approval <input type="checkbox"/> Denial to Permittee.
<input type="checkbox"/> Special Conditions/Stipulations written for approval.	<input type="checkbox"/> Copy of Approved Permit Change to File.
<input type="checkbox"/> TA and CHIA modified as required.	<input type="checkbox"/> Copy of Approved Permit Change to Permittee.
<input type="checkbox"/> Permit Change Approval Form ready for approval.	<input type="checkbox"/> Copies to Other Agencies and Price Field Office.



QAC

November 28, 1994

Ms. Pamela Grubaugh-Littig
Permit Supervisor
State of Utah
Division of Oil, Gas and Mining
355 West North Temple
3 Triad Center, Suite 350
Salt Lake City, Utah 84180-1203

*Copy Sarah,
Amendment file
Copy app. for permit amend
of Susan, Tom, Henry*

Re: Permit Amendment- J.B. King Mine, ACT/015/002, Folder #2, Emery Country, Utah
Reclamation Plan Revision

Dear Ms. Grubaugh-Littig:

Please accept the contents herein as a *Permit Amendment* to the J.B. King Reclamation Plan. As we discussed, I'm sending you one copy of the completed revisions that would be inserted into the existing permit. Upon completing your review, I will send you the additional copies that you require (I believe we agreed that you would need 7 total), with any additions or deletions that you may request or need.

If you have any questions as to the contents, please call me at your earliest convenience.

Sincerely,

E.M. (Buzz) Gerick
V. P. Operations

cc: D. Haddock, DOGM - wo/ Attachments
J. Helfrich, DOGM - wo/ Attachments

