





COUNTY ROAD 907

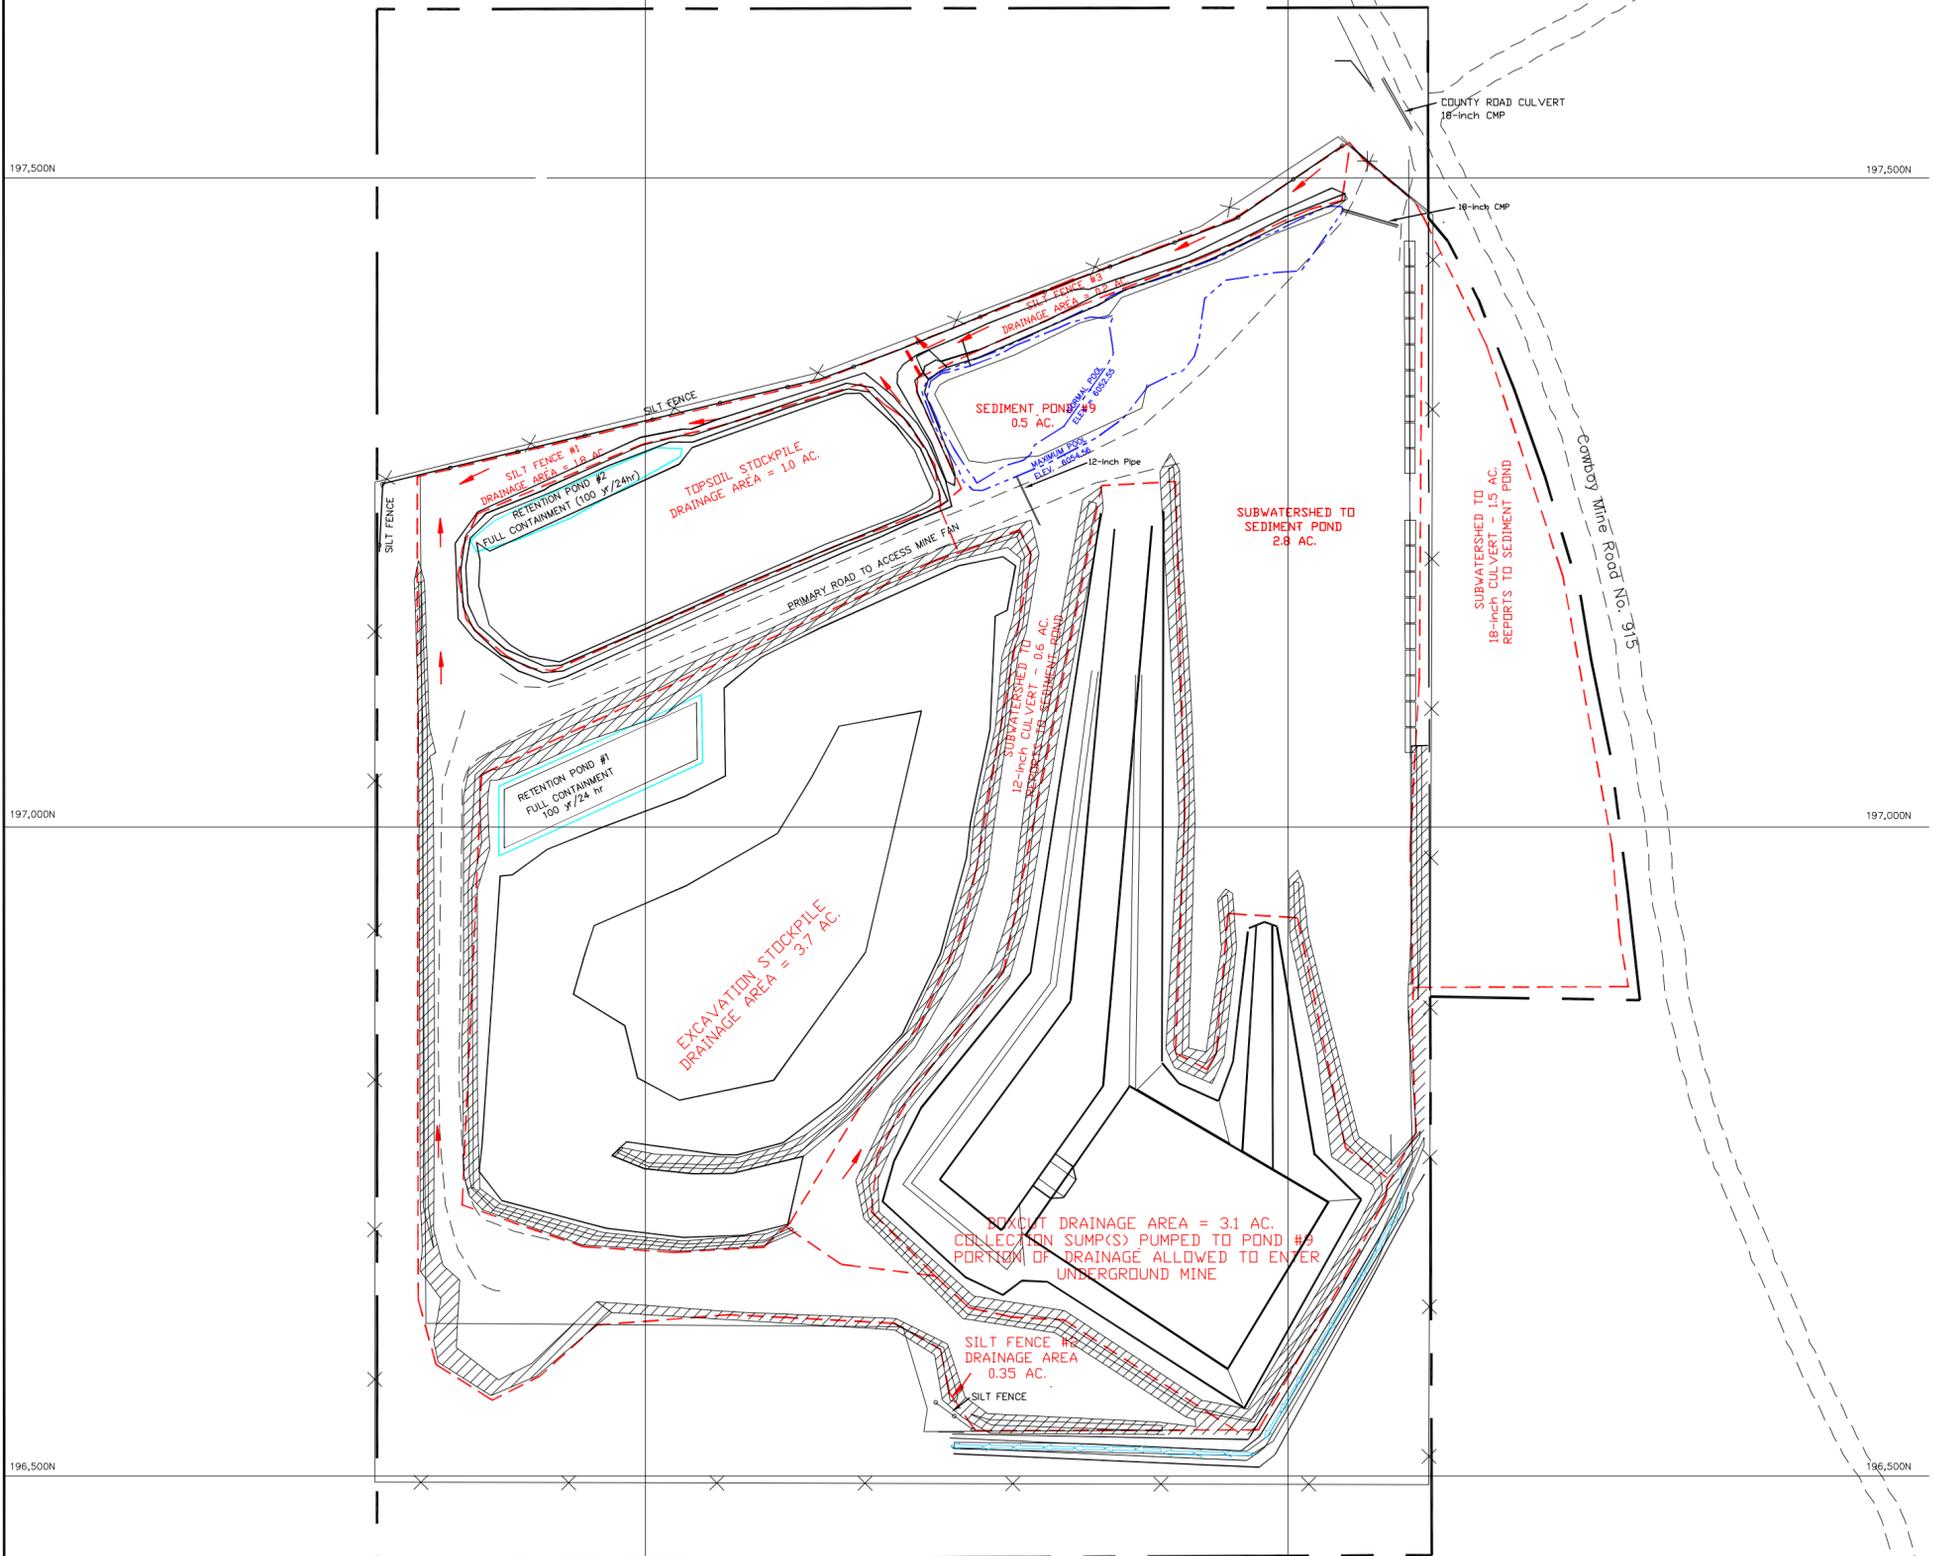

LEGEND

- PERMIT BOUNDARY
- ==== STRAW/HAY BALES
- //// BERMS
- SILT FENCE
- - - ROADWAY
- == DRAINAGE CULVERT
- - - - SUBWATERSHED OF SEDIMENT CONTROL STRUCTURES
- FULL CONTAINMENT BASIN 25 YR/24 HR EVENT
- SEDIMENT POND CONTAINMENT 10 YR/24 HR EVENT
- ← UNAFFECTED DRAINAGE DIRECTED BY BERM
- FLOW DIRECTION ALONG SILT FENCE

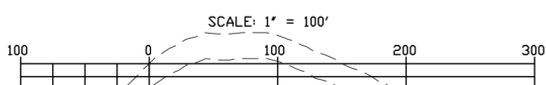

REV.	DATE	COMMENTS
1	8/03	ADD 1.5 AC. OF PERMIT AREA OF WHICH 1.0 AC. IS SURFACE DISTURBED AMEND 4th EAST PORTAL CONFIGURATION & STRUCTURES WITH AS-BUILT DRAWING

**CONSOLIDATION COAL COMPANY**  
 SESSER ENGINEERING  
 P.O. BOX 566, SESSER, IL 62884

4 EAST PORTAL SITE  
 SURFACE DRAINAGE  
 CONTROL PLAN

MINE EMERY MINE	DATE 10-16-02	REV. 03-06-03
CHKD. TDK	SCALE AS NOTED	
APPD.	DRAWING NO.	FILE
DRAWN TDK	SHEET 1 OF 1	PLATE VI-10a SurfaceDrainage.dwg