


- 1 CRUSHER/SCREEN BUILDING
  - 2 10,000 TON COAL STOCKPILE
  - 3 2,600 TON COAL STOCKPILE
  - 4
  - 5 42-inch STACKER CONVEYOR
  - 6 42-inch CONVEYOR
  - 7 54-inch CONVEYOR
  - 8 EXCAVATION MATERIAL STOCKPILE
  - 9 TOPSOIL STOCKPILE
  - 10 SEDIMENT BASIN #9
  - 11 RETENTION BASIN #2
  - 12 RETENTION BASIN #1
  - 13 ROCK DUST BIN
  - 14 TRUCK SCALE
  - 15 TRUCK LOADOUT
  - 16 COAL FEED HOPPER
  - 17 BELTLINE TRANSFER POINT
  - 18 POWERLINE
  - 19 WATER TANK
  - 20 AIRSHAFT (16' Dia.)
  - 21 TEMPORARY STREAM DIVERSION
  - 22 CORRUGATED METAL PIPE (18-inch diam.)
  - 23 CORRUGATED METAL PIPE (12-inch diam.)
  - 24 3- ENTRY PORTALS
  - 25 CATTLE GUARD
  - 26 PRIMARY ACCESS ROAD TO FAN
  - 27 SUPPLY YARD
- PERMIT BOUNDARY
  - STREAM DIVERSION (UNAFFECTED DRAINAGE)
  - BERM
  - DISTURBANCE AREA (SURFACE AFFECTED)
  - FENCE
  - SILT FENCE
  - STRAW/HAY BALES
  - WIND FENCE (APPROXIMATE)
  - CONCRETE BARRIERS (MOVABLE)
  - WATER CANNON (PROPOSED LOCATION NDRWEST)

RECEIVED  
 JAN 27 2004  
 DIV. OF OIL, GAS & MINING

STATE OF UTAH  
 WILLIAM W. FULLER  
 318563  
 1/9/04  
 PROFESSIONAL ENGINEER

CONSOLIDATION COAL COMPANY  
 SESSER ENGINEERING  
 P.O. BOX 566, SESSER, IL 62884

4 EAST PORTAL  
 SURFACE FACILITIES

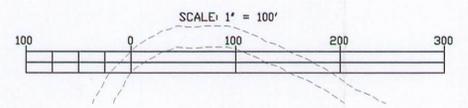

PLAN VIEW

REV.	DATE	COMMENTS
3	01/04	MODIFICATION RESPONSE TO BOEM DEFICIENCIES 12/10/03
2	10/03	MODIFICATION RESPONSE TO BOEM DEFICIENCIES 10-08-03
1	8/03	ADD 1.5 AC. OF PERMIT AREA OF WHICH 1.0 AC. IS SURFACE DISTURBED AMEND 4th EAST PORTAL CONFIGURATION & STRUCTURES WITH AS-BUILT DRAWING

MINE EMERY MINE	DATE 10-16-02	REV. 9-04-03
CHKD, TDK	SCALE AS NOTED	
APPD.	DRAWING NO.	FILE
DRAWNTDK	SHEET 1 OF 1	PLATE II-3 II-3 4thEastFacilities.dwg