



- 1 COAL TRANSFER BUILDING
- 2 10,000 TON COAL STOCKPILE
- 3 2,600 TON COAL STOCKPILE
- 4 COAL SAMPLE BUILDING AND CONVEYOR BELT
- 5 48-inch STACKER CONVEYOR
- 6 48-inch CONVEYOR
- 7 54-inch CONVEYOR
- 8 EXCAVATION MATERIAL STOCKPILE
- 9 TOPSOIL STOCKPILE
- 10 SEDIMENT BASIN #9
- 11 RETENTION BASIN #2
- 12 RETENTION BASIN #1
- 13 ROCK DUST BIN
- 14 TRUCK SCALE
- 15 CRUSHER/TRUCK LOADOUT
- 16 COAL FEED HOPPER
- 17 BELTLINE TRANSFER POINT
- 18 POWERLINE
- 19 WATER TANK
- 20 AIRSHAFT (16' Dia.)
- 21 TEMPORARY STREAM DIVERSION
- 22 CORRUGATED METAL PIPE (18-inch diam.)
- 23 CORRUGATED METAL PIPE (12-inch diam.)
- 24 3- ENTRY PORTALS
- 25 CATTLE GUARD
- 26 PRIMARY ACCESS ROAD TO FAN
- 27 SUPPLY YARD

- PERMIT BOUNDARY
- STREAM DIVERSION (UNAFFECTED DRAINAGE)
- BERM
- DISTURBANCE AREA (SURFACE AFFECTED)
- FENCE
- SILT FENCE
- STRAW/HAY BALES
- WIND FENCE (APPROXIMATE)
- CONCRETE BARRIERS (MOVABLE)
- WATER CANNON (PROPOSED LOCATION NORWEST)

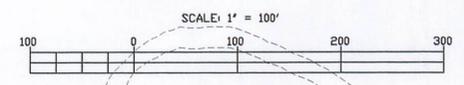

PLAN VIEW

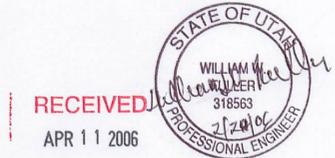

RECEIVED  
APR 11 2006  
DIV. OF OIL, GAS & MINING  
THIS STAMP ATTESTS TO THE COMPLETION OF REVISION 4 DATED 2/06/06

**CONSOLIDATION COAL COMPANY**  
SESSER ENGINEERING  
P.O. BOX 566, SESSER, IL 62884

**4 EAST PORTAL  
SURFACE FACILITIES**

REV.	DATE	COMMENTS	MINE	DATE	REV.
△	02/06	INSIGNIFICANT REVISION (COAL SAMPLE BUILDING)	EMERY MINE	10-16-02	2-06-06
△	01/04	MODIFICATION RESPONSE TO DQDN DEFICIENCIES 12/10/03	CHKD, TDK	SCALE AS NOTED	
△	10/03	MODIFICATION RESPONSE TO DQDN DEFICIENCIES 10-08-03	APPD,	DRAWING NO. FILE	
△	8/03	ADD 1.5 AC. OF PERMIT AREA OF WHICH 1.0 AC. IS SURFACE DISTURBED AND 0.5 AC. EAST PORTAL CONTOURIZATION & STRUCTURES WITH AS-BUILT DRAWING	DRAWNTDK	PLATE II-3	II-3 4thEastFacilities.dwg
			SHEET 1 OF 1		