

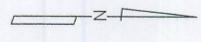


Confidential
 Not Confidential
 Referential to
CONSOLIDATION COAL COMPANY
 For additional information

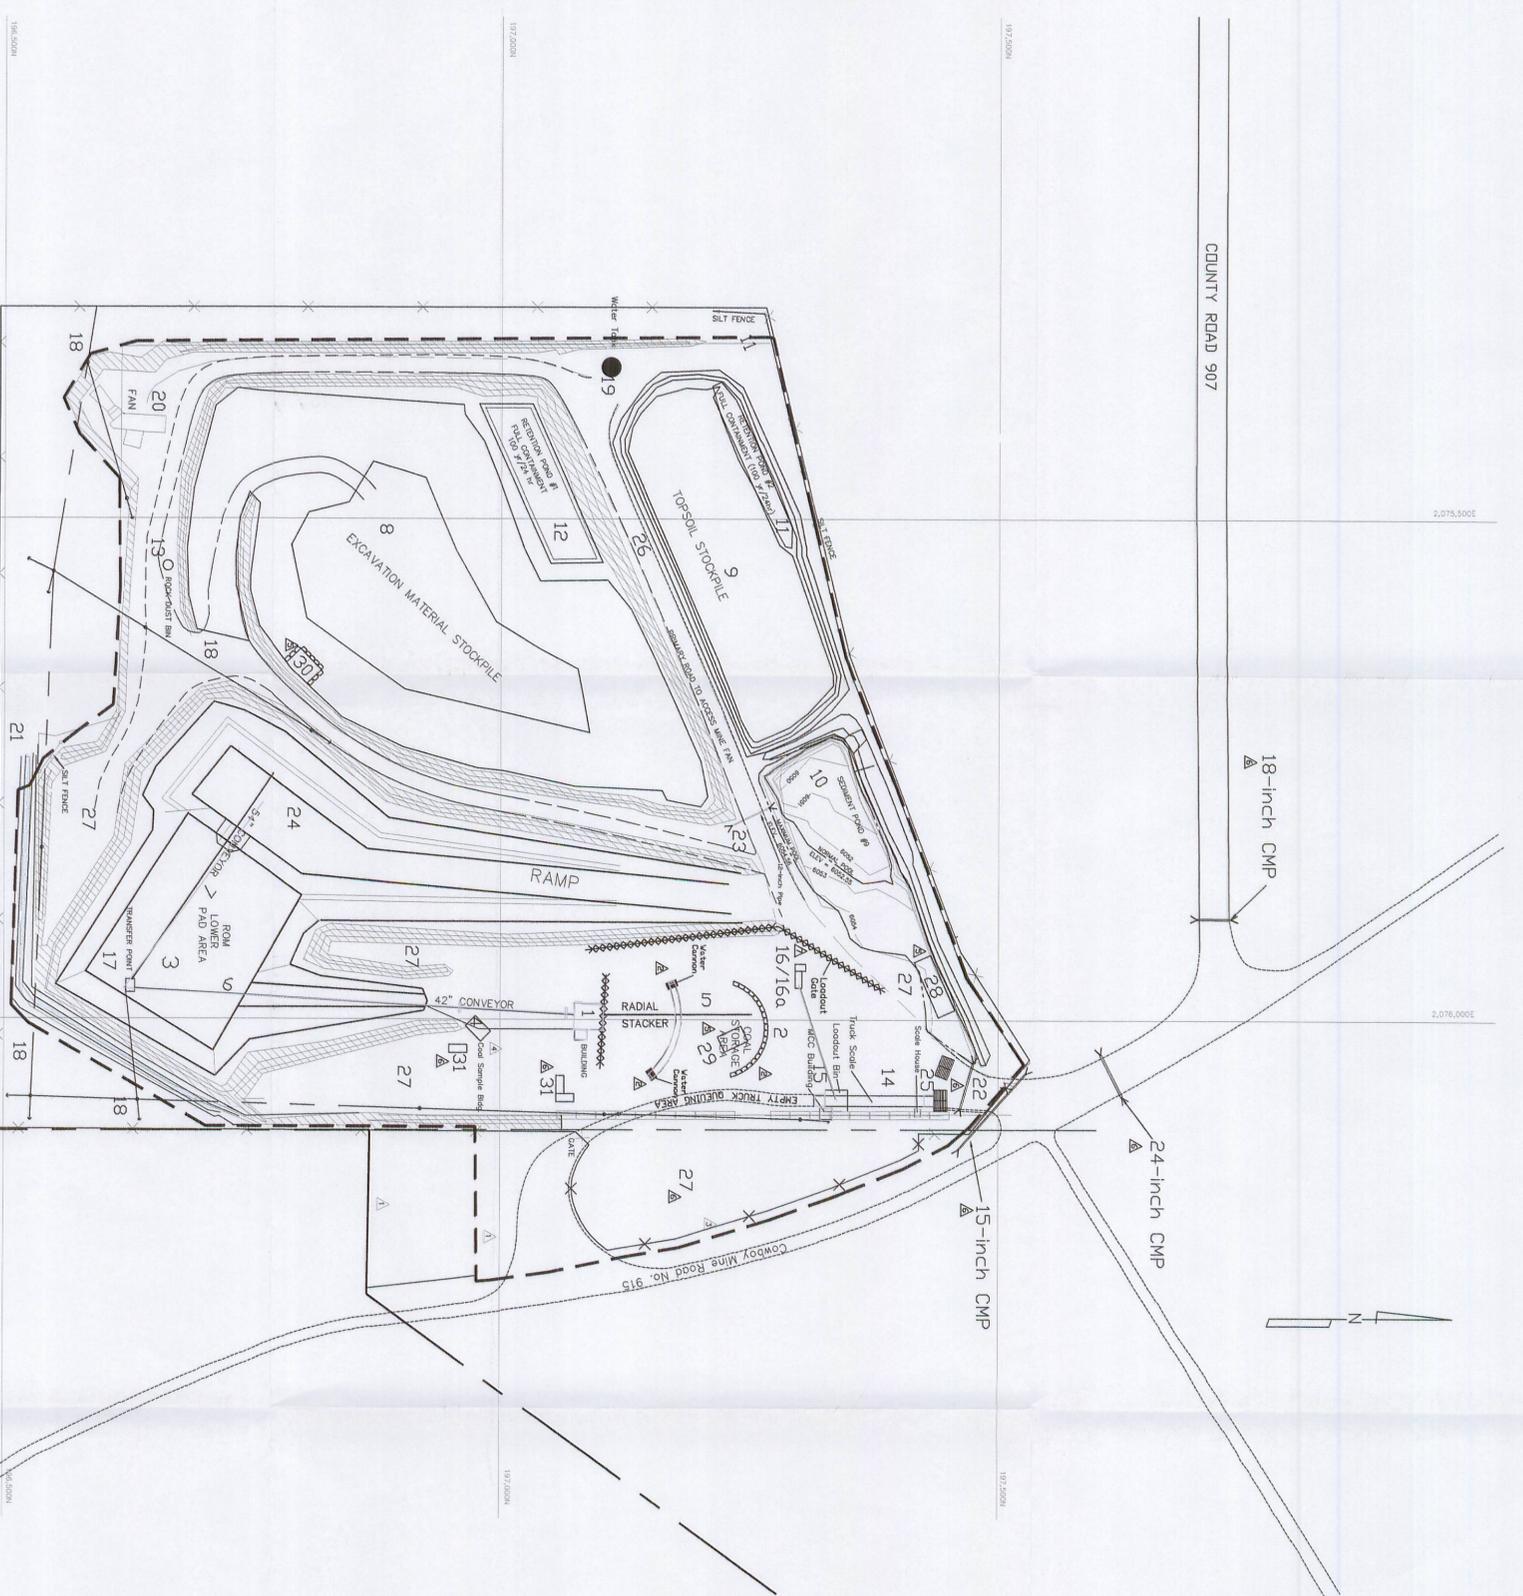


PLAN VIEW

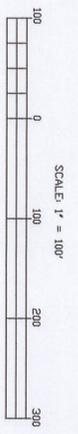

THIS STATE ATTESTS TO THE COMPLETION OF REVISIONS 5 AND 6

REV.	DATE	COMMENTS
1	09/18	USE COAL LOADOUT PAD AND GATE
2	02/08	FENCE AND STORAGE AREA, AND NEW UPDATE AND VARIOUS DEF. RESPONSE
3	10/06	ADDED DIL STORAGE, RECESSED FEEDER AND TRASH PIT
4	02/06	INSTRUMENT REVISION COAL SAMPLE BUILDING
5	01/04	IDENTIFICATION RESPONSE TO 3000 REFERENCE 20/0/03
6	10/03	IDENTIFICATION RESPONSE TO 3000 REFERENCE 20-08-03
7	01/03	ADD 15 AC OF PERMIT AREA OF WHICH 10 AC IS SURFACE DISTURBED AREA 15 AC EAST PERMIT, CONSTRUCTION & STRUCTURES WITH AS-BUILT DRAWINGS

- 1 CRUSHER/SCREEN BUILDING
- 2 10,000 TDN COAL STOCKPILE
- 3 2,600 TDN COAL STOCKPILE
- 4 COAL SAMPLE BUILDING AND CONVEYOR BELT
- 5 42-inch STACKER CONVEYOR
- 6 42-inch CONVEYOR
- 7 54-inch CONVEYOR
- 8 EXCAVATION MATERIAL STOCKPILE
- 9 TOPSOIL STOCKPILE
- 10 SEDIMENT BASIN #9
- 11 RETENTION BASIN #2
- 12 RETENTION BASIN #1
- 13 ROCK DUST BIN
- 14 TRUCK SCALE
- 15 TRUCK LOADOUT
- 16 COAL FEED HOPPER
- 16a LUMP COAL PAD
- 17 BELTLINE TRANSFER POINT
- 18 POWERLINE
- 19 WATER TANK
- 20 AIRSHAFT (16' Dia.)
- 21 TEMPORARY STREAM DIVERSION
- 22 CORRUGATED METAL PIPE (18-inch diam.)
- 23 CORRUGATED METAL PIPE (12-inch diam.)
- 24 3-ENTRY PORTALS
- 25 CATTLE GUARD
- 26 PRIMARY ACCESS ROAD TO FAN
- 27 SUPPLY YARD
- 28 DIL STORAGE
- 29 RECESSED FEEDER
- 30 TRASH PIT
- 31 SKID-MOUNTED SHED

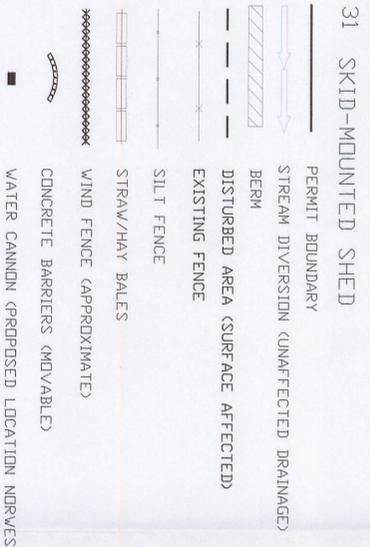

CONSOLIDATION COAL COMPANY

SESSER ENGINEERING
P.O. BOX 366, SESSER, IL 62884

4 EAST PORTAL
SURFACE FACILITIES

MINE	EMERY MINE	DATE	10-16-02	REV.	2-16-06
CHKD	TKK	SCALE	AS NOTED		
APPD.		DRAWING NO.	FILE		
DRAWN/TKK		SHEET	II-3	PLATE	II-3

RECEIVED
 NOV 20 2008
 DIV. OF OIL, GAS & MINING