




SECT 29

U.S. NATIONAL FOREST
U-06039

DEER CREEK MINE PERMIT BOUNDARY

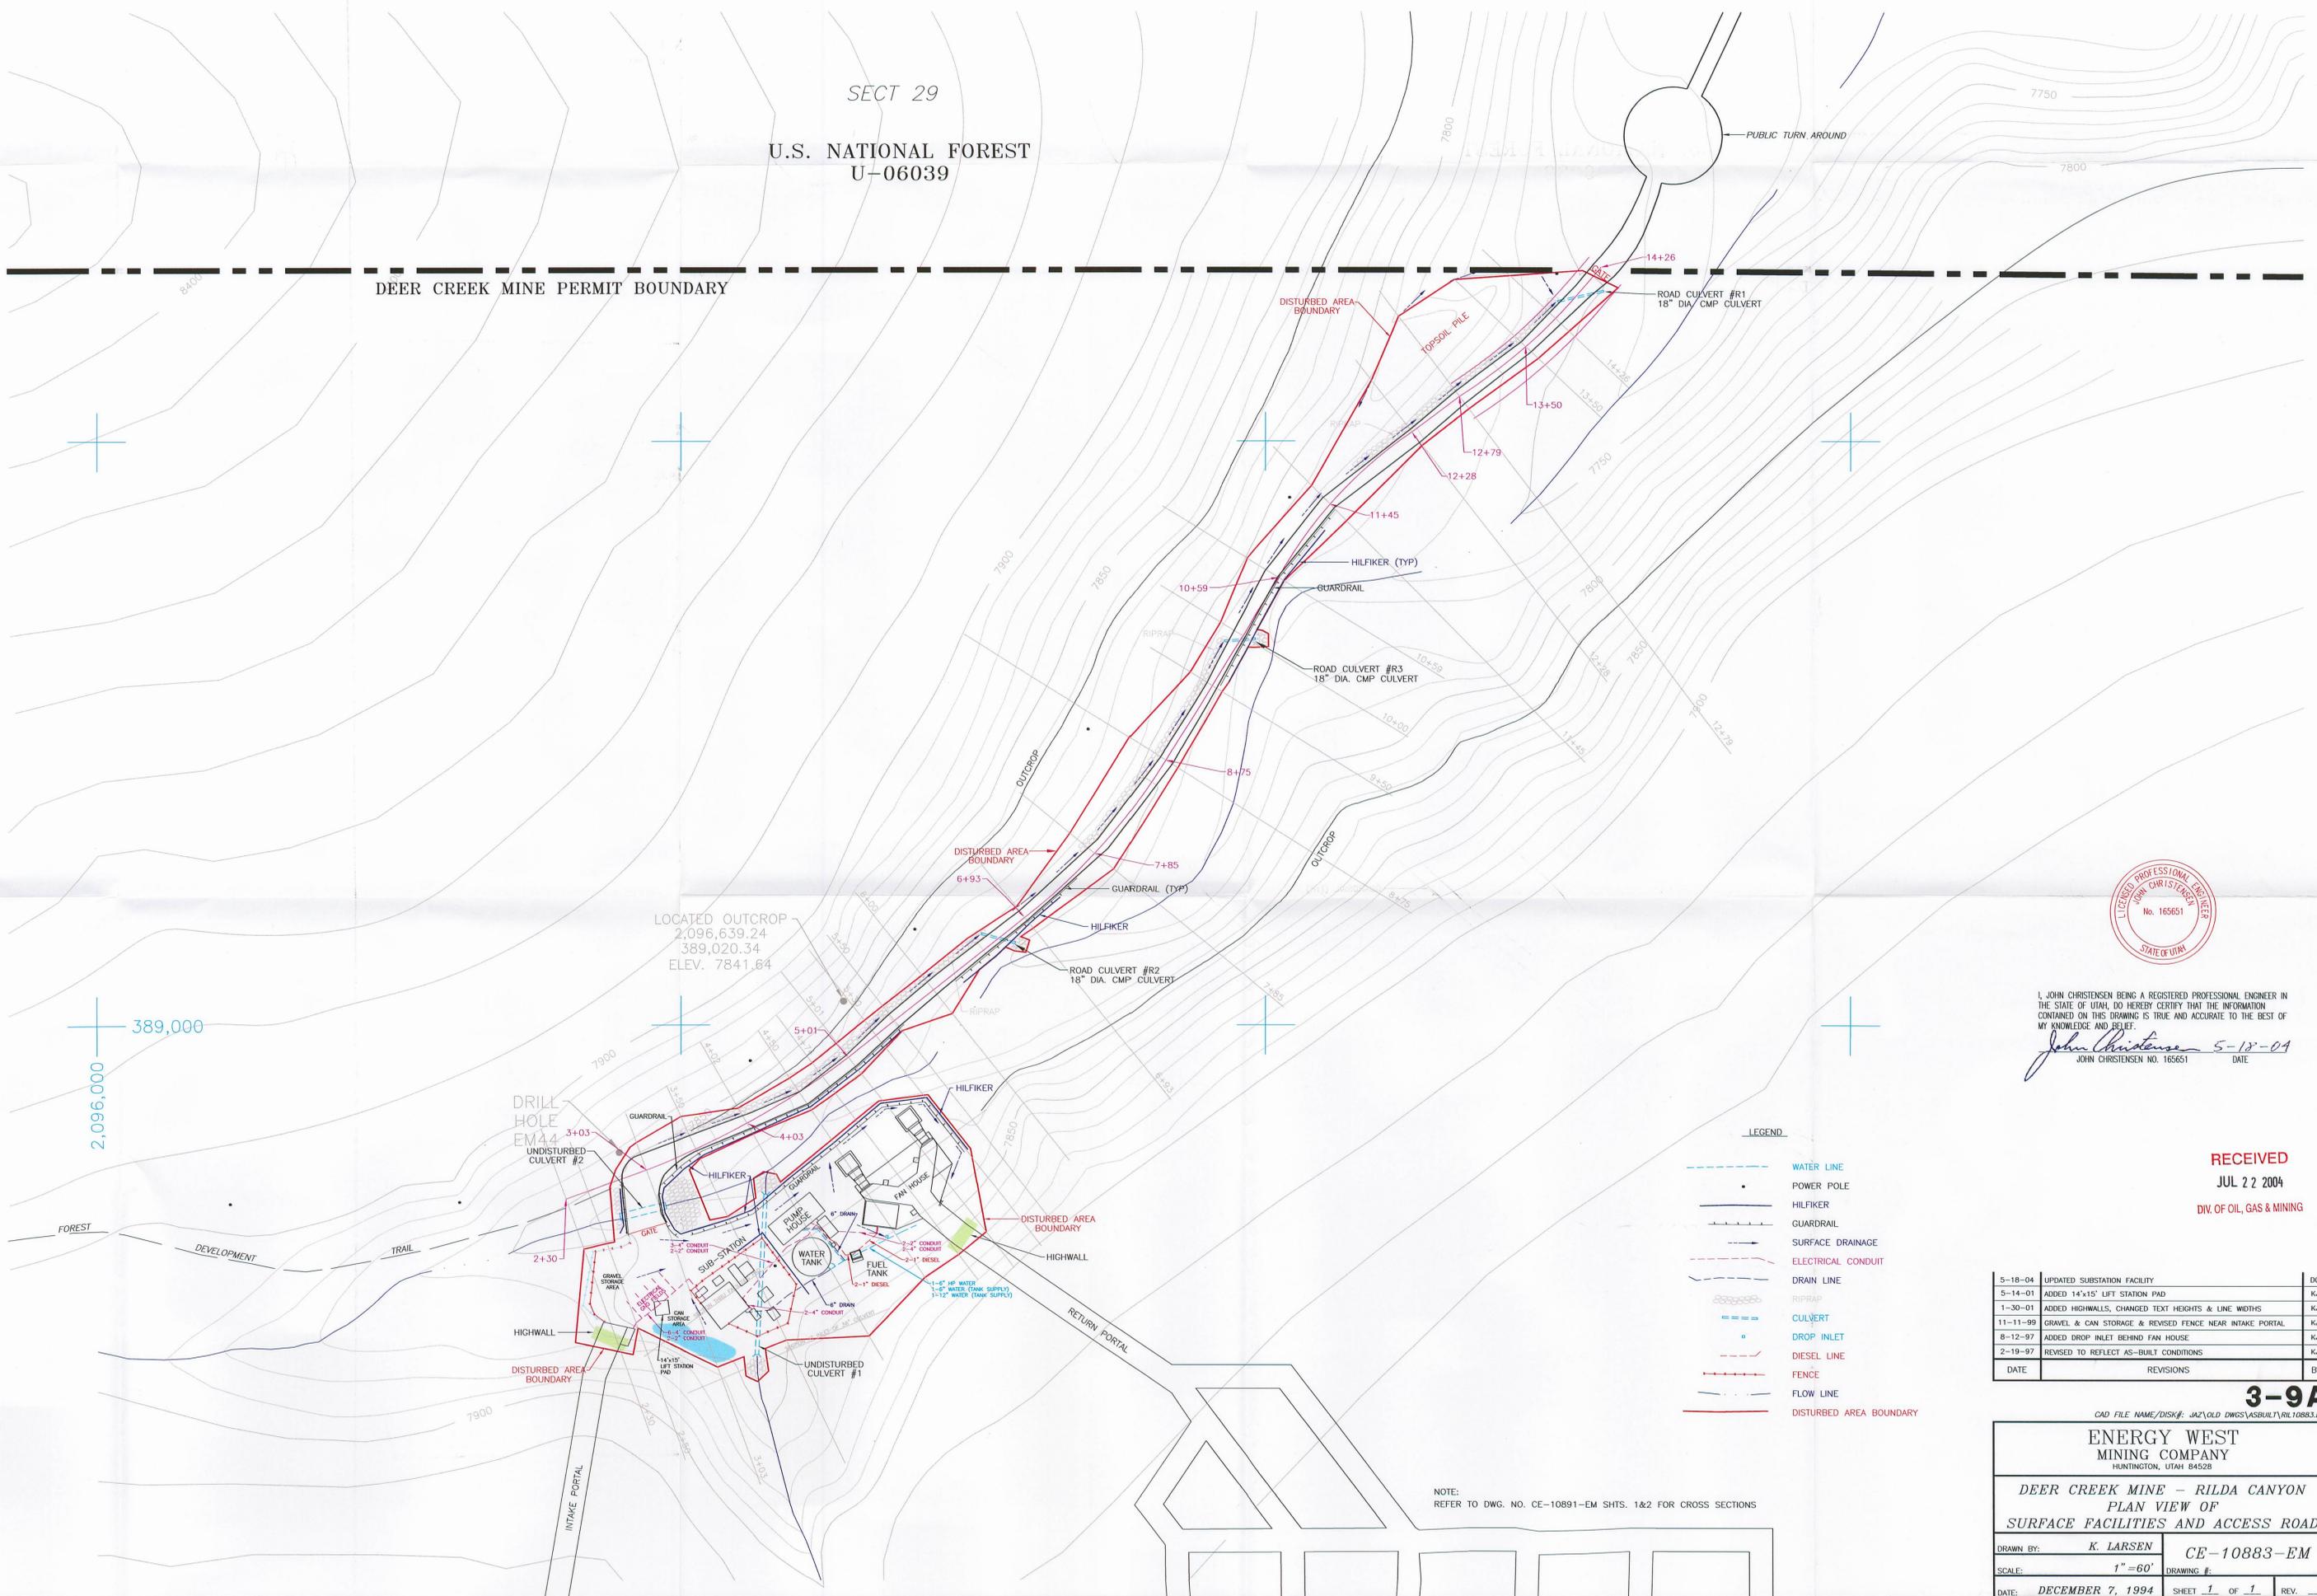

I, JOHN CHRISTENSEN BEING A REGISTERED PROFESSIONAL ENGINEER IN THE STATE OF UTAH, DO HEREBY CERTIFY THAT THE INFORMATION CONTAINED ON THIS DRAWING IS TRUE AND ACCURATE TO THE BEST OF MY KNOWLEDGE AND BELIEF.
John Christensen 5-18-04
JOHN CHRISTENSEN NO. 165651 DATE

LEGEND

	WATER LINE
	POWER POLE
	HILFIKER
	GUARDRAIL
	SURFACE DRAINAGE
	ELECTRICAL CONDUIT
	DRAIN LINE
	RIPRAP
	CULVERT
	DROP INLET
	DIESEL LINE
	FENCE
	FLOW LINE
	DISTURBED AREA BOUNDARY

RECEIVED
JUL 22 2004
DIV. OF OIL, GAS & MINING

DATE	REVISIONS	BY
5-18-04	UPDATED SUBSTATION FACILITY	DCO
5-14-01	ADDED 14'x15' LIFT STATION PAD	KJL
1-30-01	ADDED HIGHWALLS, CHANGED TEXT HEIGHTS & LINE WIDTHS	KJL
11-11-99	GRAVEL & CAN STORAGE & REVISED FENCE NEAR INTAKE PORTAL	KJL
8-12-97	ADDED DROP INLET BEHIND FAN HOUSE	KJL
2-19-97	REVISED TO REFLECT AS-BUILT CONDITIONS	KJL

3-9A

CAD FILE NAME/DISK#: JAZ\OLD DWGS\ASBUILT\RL10883.DWG
ENERGY WEST
MINING COMPANY
HUNTINGTON, UTAH 84528

DEER CREEK MINE - RILDA CANYON
PLAN VIEW OF
SURFACE FACILITIES AND ACCESS ROAD

DRAWN BY:	K. LARSEN	CE-10883-EM
SCALE:	1" = 60'	DRAWING #:
DATE:	DECEMBER 7, 1994	SHEET 1 OF 1 REV. ___

NOTE:
REFER TO DWG. NO. CE-10891-EM SHTS. 1&2 FOR CROSS SECTIONS