
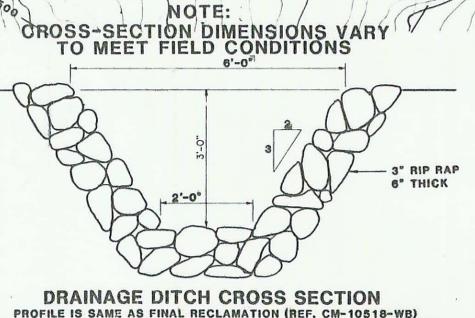


**U-37642**  
48.62 ACRES  
DISPOSAL SITES 1 thru 8 = 15.88 ACRES

**LEGEND**

[Hatched pattern]	REFERENCE AREA
[White box]	CELL 1 & BERM 1 - 1983
[White box]	CELL 2 & BERM 2 - 1984
[Dotted pattern]	CELL 3 & BERM 3 - 1985
[Horizontal lines]	CELL 4 & BERM 4 - 1986
[Vertical lines]	CELL 5 - 1989
[Diagonal lines]	CELL 6 - 1989

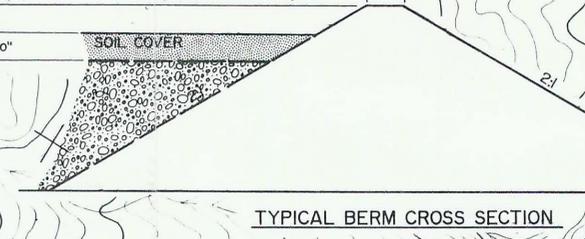

**ENGINEERS CERTIFICATE**

I, Willie J. Whitney, Jr., hereby certify that I am a Registered Professional Engineer, licensed in the State of Utah, and that I hold Certificate No. 4904. I also certify that the design shown has been prepared under my general direction and review, and further, that it conforms to good engineering practice according to the best of my knowledge and belief.

DATE: 12/20/90 NAME: Willie J. Whitney, Jr.

**REGISTERED PROFESSIONAL ENGINEER**  
No. 4904  
Willie J. Whitney, Jr.  
State of Utah

NOTE: SEE DRAWING NO. CM-10359-WB FOR CROSS SECTION DETAILS.

DATE	REVISIONS	BY	CHK.
4-20-92	ADDED CELLS 5 AND 6	KJL	
1-10-90	ADDED OUTSLOPE ASCA 1.3 ACRES	KJL	
2/11/89	REVISED TO REFLECT AS BUILT CONDITIONS	KJL	LSG
6-3-87	AS BUILT SITES 1 THRU 8 - ADDED BERM X-SECT	KA	DLB
5/1/84	REVISED DRAINAGE DITCH AS BUILT	AWB	CEC
8-3-83	ADDED PROPOSED DISPOSAL SITES 3 THRU 8	SMC	
2-18-83	CHANGED EPHEMERAL DRAINAGE DIVERSION	SMC	CEC
2-8-83	AS BUILT SITE # 1 & PROPOSED SITE # 2	SMC	CEC

**AS BUILT CONDITION**

I do hereby certify that I am a Registered Professional Engineer in the State of Utah, and do also certify that this drawing represents the as built condition of the Waste Storage Site Facility, to the best of my knowledge.

SIGNATURE: Larry J. Guymon DATE: 6-3-91

REGISTERED PROFESSIONAL ENGINEER  
No. 5214  
LARRY J. GUYMON  
State of Utah

T. 17 S., R. 7 E. S. 1 B. & M.

**COTTONWOOD/WILBERG & DES-BEE-DOVE MINES WASTE ROCK SITE**

**1991 REVEGETATION MONITORING MAP**

**UTAH POWER & LIGHT COMPANY**  
DEPARTMENT OF MINING & EXPLORATION

DATE: APRIL 20, 1992 DRAWN BY: KJL DRAWING NUMBER: CM-10876-WB

SCALE: 1" = 100' CHECKED BY: CEC

RECEIVED  
JUN 03 1992  
DIVISION OF OIL, GAS & MINING