
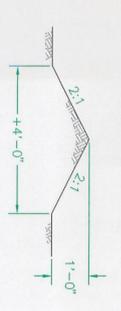


**LEGEND**

[Yellow box]	REFERENCE AREA
[Orange box]	CELL 1 & BERM 1 - 1983
[Light orange box]	CELL 2 & BERM 2 - 1984
[Purple box]	CELL 3 & BERM 3 - 1985
[Blue box]	CELL 4 & BERM 4 - 1986
[Green box]	CELL 5 - 1993
[Brown box]	CELL 6 - 1993
[Dark brown box]	CELL 7 - 1992 & 1993

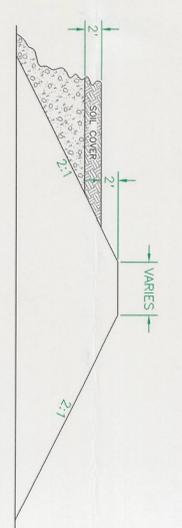

JOHN CHRISTENSEN P.E. #168551  
 AS BUILT CONDITION  
 I do hereby certify that I am a Registered Professional Engineer in the State of Utah, and do also certify that the information furnished herein is true and correct to the best of my knowledge.  
 WASTE STORAGE SITE FACILITY

DATE: \_\_\_\_\_

LICENSED PROFESSIONAL ENGINEER  
 JOHN CHRISTENSEN  
 No. 168551  
 STATE OF UTAH

UTU-065027  
 WASTE ROCK STORAGE SITE

NOTE:  
 REFER TO DWG. CM-10518-WB FOR  
 DRAINAGE DITCH CROSS SECTION

DATE	REVISIONS	BY	CHK
2-12-97	ADDED AREA TO BE RELINQUISHED (1.08 ACRES)	KLL	
2-4-97	REVISED PINYON/JUNIPER AREA. ADDED AREA TO BE RELINQUISHED	KLL	
12-11-96	ADDED PROPERTY DESCRIPTION TO PINYON/JUNIPER REFERENCE AREA	KLL	
11-27-96	REVISED TO REFLECT CURRENT CONDITIONS FOR RELINQUISHMENT	KLL	
8-28-96	REVISED TO REFLECT CURRENT CONDITIONS	KLL	
1-10-90	ADDED OUTSLOPE ASQA 1.3 ACRES	KLL	
2-11-85	REVISED TO REFLECT AS BUILT CONDITIONS	KLL	
6-3-87	AS BUILT SITES 1 THRU 8 - ADDED BERM CROSS SECTION	AMB	
5-3-83	REVISED DRAINAGE DITCH AS BUILT	SJC	
2-18-83	ADDED PROPOSED DISPOSAL SITES 3 THRU 8	SJC	
2-8-83	CHANGED EPIHEMERAL DRAINAGE DIVERSION	SJC	
2-8-83	AS BUILT SITE #1 & PROPOSED SITE #2	SJC	

1996 WASTE STORAGE MONITORING MAP  
 K. LARSEN  
 1" = 100'  
 KSI1650D  
 FEBRUARY 19, 1997



ENERGY WEST  
 MINING COMPANY  
 HUNTINGTON, UTAH 84528  
 COTTONWOOD/WILBERG & DES-BEE DOVE MINES  
 1996 WASTE STORAGE MONITORING MAP  
 K. LARSEN  
 1" = 100'  
 KSI1650D  
 FEBRUARY 19, 1997