



E 1/4 CORNER  
SECTION 34  
E. 2110130.928  
N. 352,642.212

U-37642  
WASTE ROCK STORAGE SITE  
47.54 TOTAL ACRES

PINYON/JUNIPER  
REFERENCE AREA

RECLAIMED AREA

SOIL PILE  
SOIL PILE  
SOIL PILE

TOP OF BERM

FENCE

18" CONVEYER


DIVERSION DITCH

STATE ROAD 87

PROPERTY BOUNDARY (U-37642)

PROPERTY BOUNDARY (U-065027)

LEGEND	
[Yellow box]	REFERENCE AREA
[Orange box]	CELL 1 & BERM 1 - 1983
[Light blue box]	CELL 2 & BERM 2 - 1984
[Dark blue box]	CELL 3 & BERM 3 - 1985
[Purple box]	CELL 4 & BERM 4 - 1986
[Green box]	CELL 5 - 1993
[Light green box]	CELL 6 - 1993
[Dark green box]	CELL 7 - 1992 & 1993

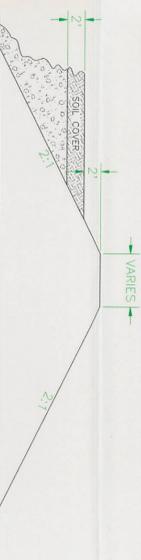

JOHN CHRISTENSEN, P.E. #16561 DATE

AS BUILT CONDITION  
I do hereby certify that I am a Registered Professional Engineer and that this drawing represents the as built condition of the Waste Storage Site Facility to the best of my knowledge.

UTU-065027  
WASTE ROCK STORAGE SITE

NOTE:  
REFER TO DWG. CM-10518-WR FOR  
DRAINAGE DITCH CROSS SECTION

DATE	REVISIONS	BY	CHK
2-12-97	ADDED AREA TO BE RELINQUISHED (1.08 ACRES)	KLL	
2-4-97	REVISED PINYON/JUNIPER AREA, ADDED AREA TO BE RELINQUISHED	KLL	
12-11-96	ADDED PROPERTY DESCRIPTION TO PINYON/JUNIPER REFERENCE AREA	KLL	
11-27-96	REVISED TO REFLECT CURRENT CONDITIONS FOR RELINQUISHMENT	KLL	
8-26-96	REVISED TO REFLECT CURRENT CONDITIONS FOR RELINQUISHMENT	KLL	
1-10-96	ADDED OUTSIDE ASQA 1.3 ACRES	KLL	
1-10-96	REVISED TO REFLECT AS BUILT CONDITIONS	KLL	
6-3-87	REVISED TO REFLECT AS BUILT CONDITIONS	KLL	
5-1-87	REVISED TO REFLECT AS BUILT CONDITIONS	KLL	
5-3-83	ADDED PROPOSED DISPOSAL SITES 3 THRU 8	KLL	
2-18-83	CHANGED EPIHEMERAL DRAINAGE DIVERSION	KLL	
2-8-83	AS BUILT SITE #1 & PROPOSED SITE #2	KLL	

OWNER	ENERGY WEST MINING COMPANY
DESIGNER	COTTONWOOD/WILBERG & DSS-BEE DOVE MINES
DRAWN BY	R. LARSEN
SCALE	1"=100'
DATE	FEBRUARY 13, 1997
SHEET	1 OF 1
REV.	