

CO-OP MINING CO.

HUNTINGTON, UTAH

SURFACE FACILITIES


SCALE: 1" = 50'
 DRAWN BY: C. Reynolds
 DATE: 8/26/91
 BEAR CANYON PLATE 5-2C

REV.	DATE	REMARKS	APPR.
1	12/02/95	Fuel Line Added/Coal Recovery Bin Removed (95N)	12/18/95
2	2/23/96	Plate Updated With Tank Seam As-Builts (96A)	7/05/96
3	6/23/97	Scalehouse Pavement Added (97B)	11/03/97
4	3/18/98	Lower Culvert C-2D Removed (98A)	4/15/98
5	6/18/98	Corrections For Midterm Review 1998 (98MT)	12/03/98
6	6/25/01	WHR surface facilities added (SR98-1)	7/03/01
7	11/04/01	Corrected dst bndry, removed permit bndry (AM01a)	11/13/01
8	7/08/02	Added Fan, Moved Powder House/Water Tank (AM02H)	8/14/02
9	5/10/02	Added fule containment Enclosure (AM02E)	8/15/02
10	8/01/02	Changed name from 2-4C to 5-2C	12/8/05

SCALE 1" = 50'
 CONTOUR INTERVAL 2'
 PHOTOGRAPHY DATE NOV. 11, 1990

LEGEND

PERMIT BOUNDARY	-----	CONTOUR LINE	~ 6980 ~	WATER LINES	— W —
DISTURBED AREA	-----	UNPAVED ROADS	====	DRAINAGE	---
PRE-1977 DISTURBANCE	-----	SECTION LINE	---	POWER POLES	* * *
CULVERTS	====	SEE PLATES 7-1 FOR HYDROLOGY		STREAM BUFFER ZONE MARKERS	⊕

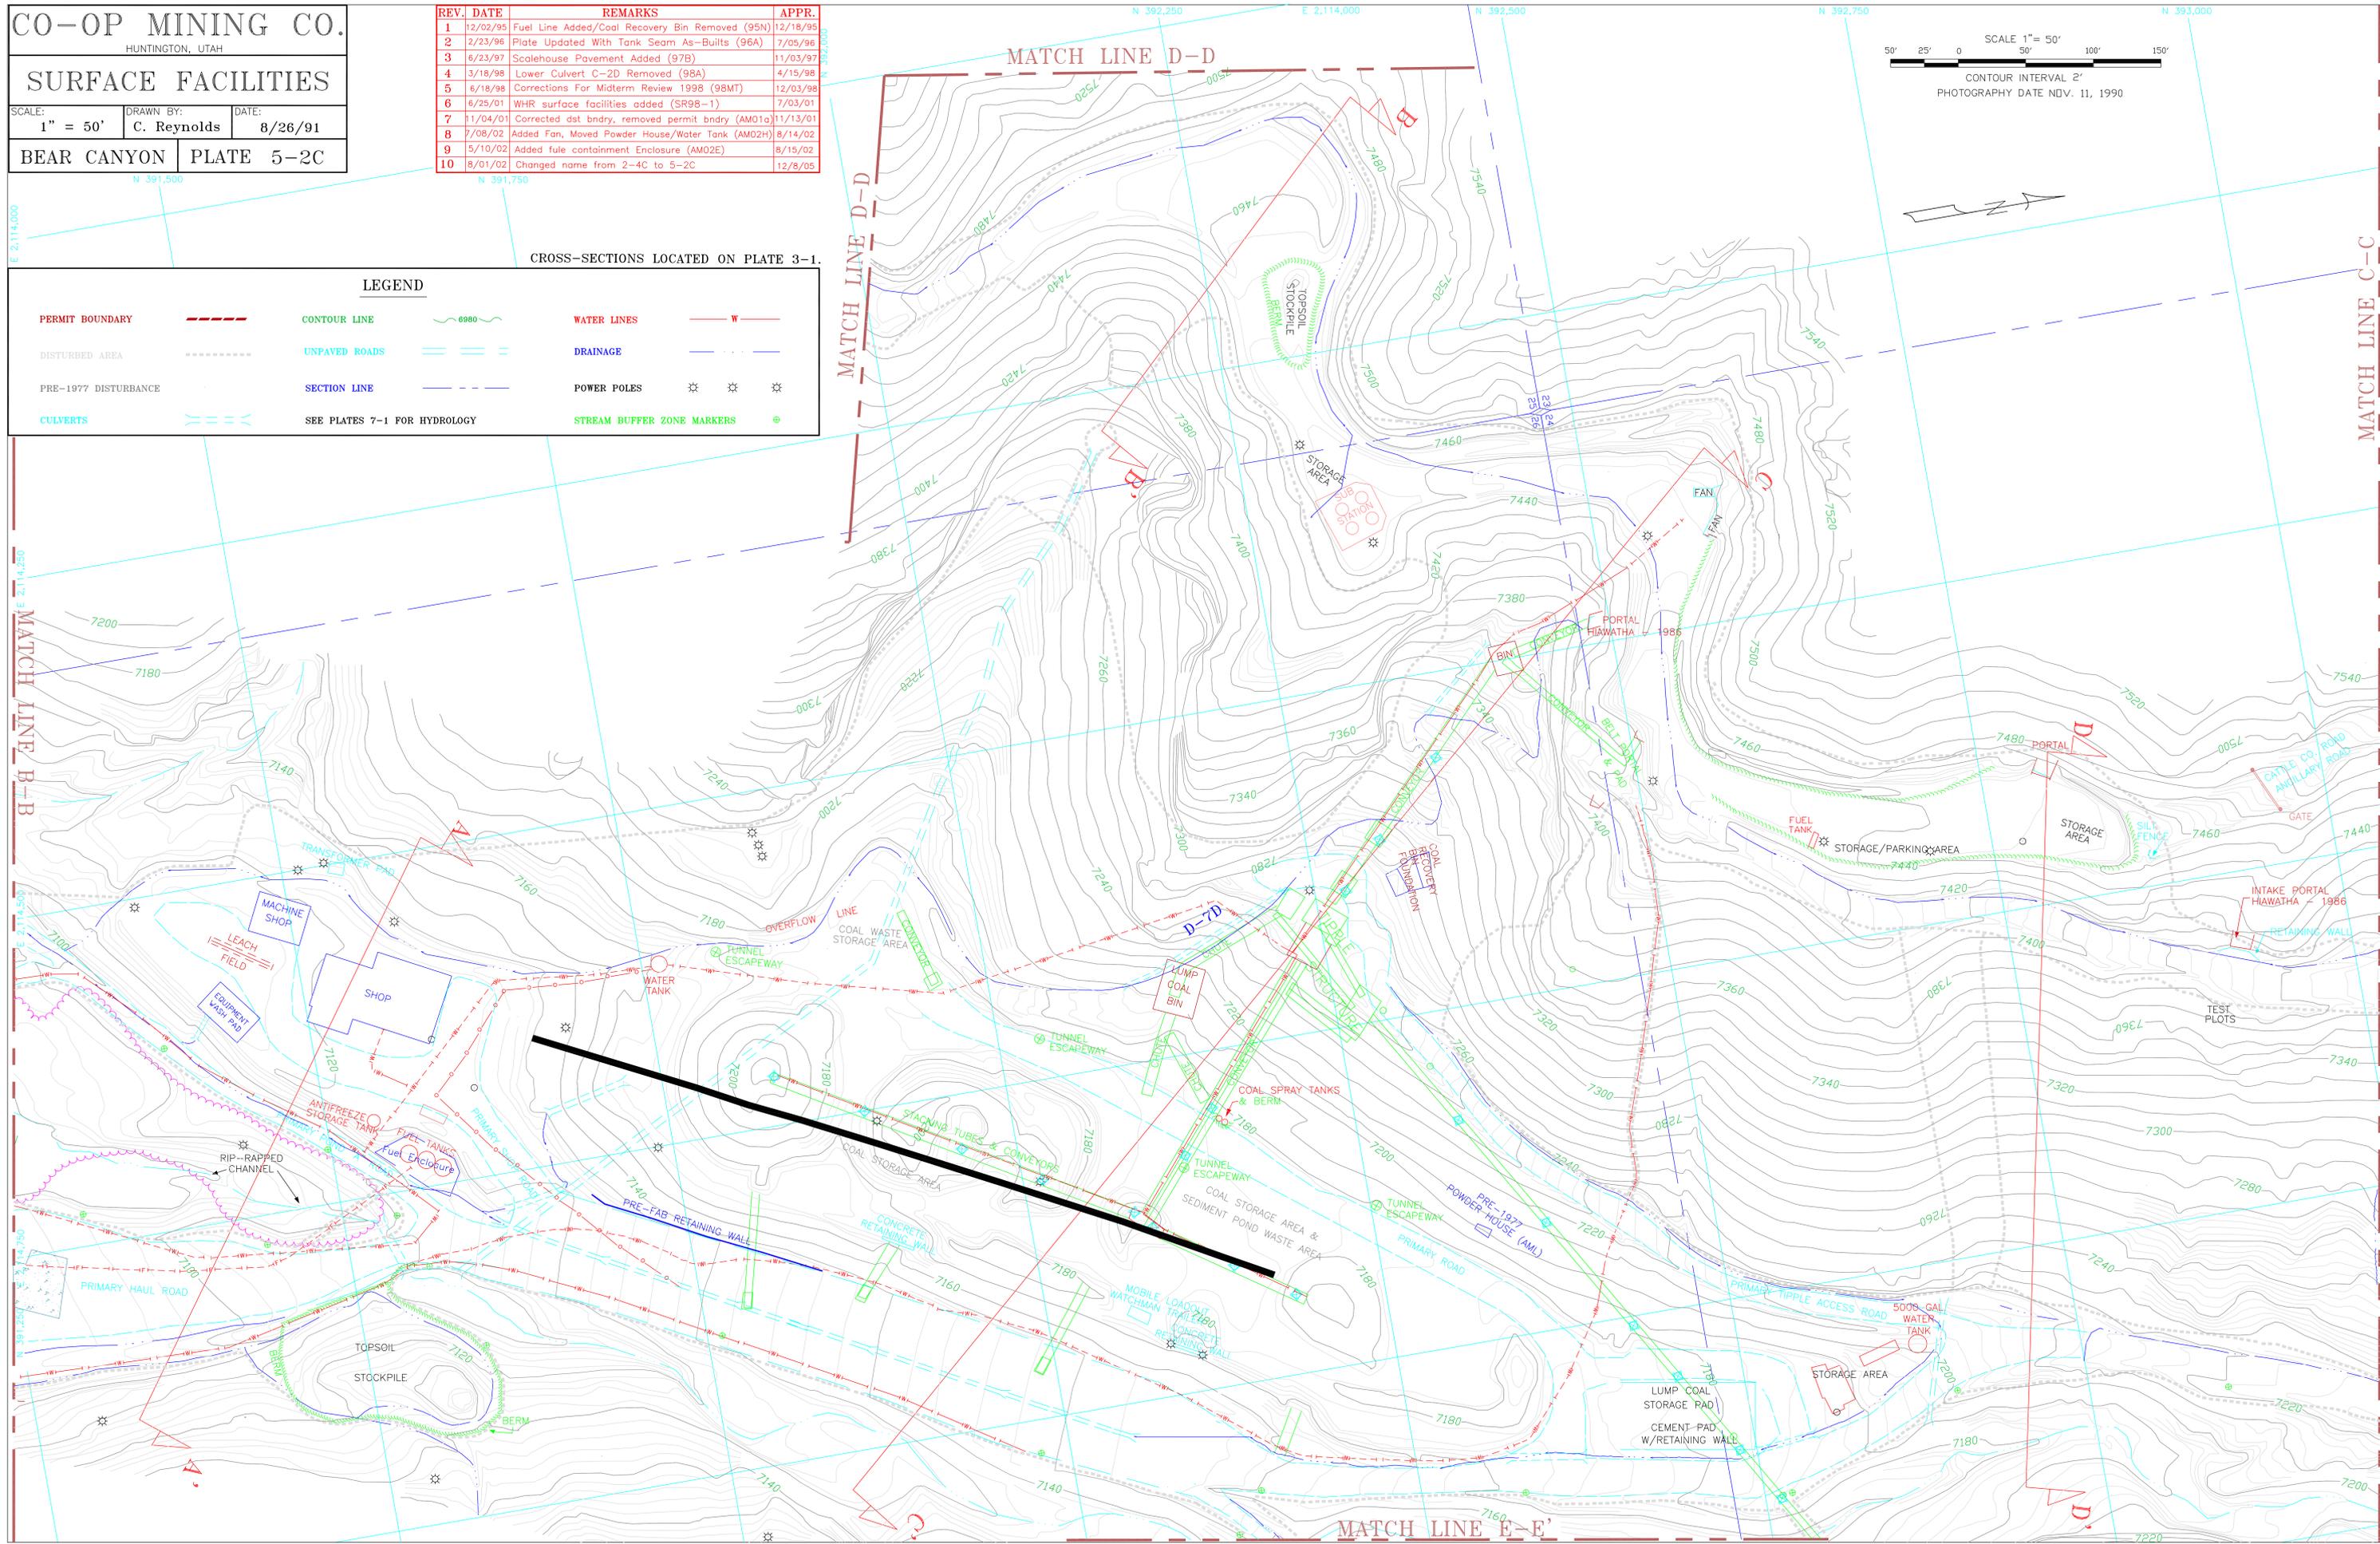

CROSS-SECTIONS LOCATED ON PLATE 3-1.

MATCH LINE B-B

MATCH LINE D-D

MATCH LINE D-D

MATCH LINE C-C

MATCH LINE E-E'