

LEGEND


- DISTURBED AREA DISTURBED AREA DRAINAGE
- SECTION LINE
- PERMIT BOUNDARY
- DRAINAGE
- CONTOUR LINE
- CULVERT
- UNDISTURBED AREA DRAINAGE

\* AD-1 indicates drainage areas that are diverted through sediment ponds or alternate approved sediment control structures.

AU-1 indicates drainage areas that are diverted by ditch and/or culvert to off-site with limited or no sediment control.

REFER TO PLATES 7-1 FOR WATERSHEDS CONTRIBUTING TO SEDIMENTATION PONDS

SEE PLATES 2-4 FOR SURFACE FACILITIES

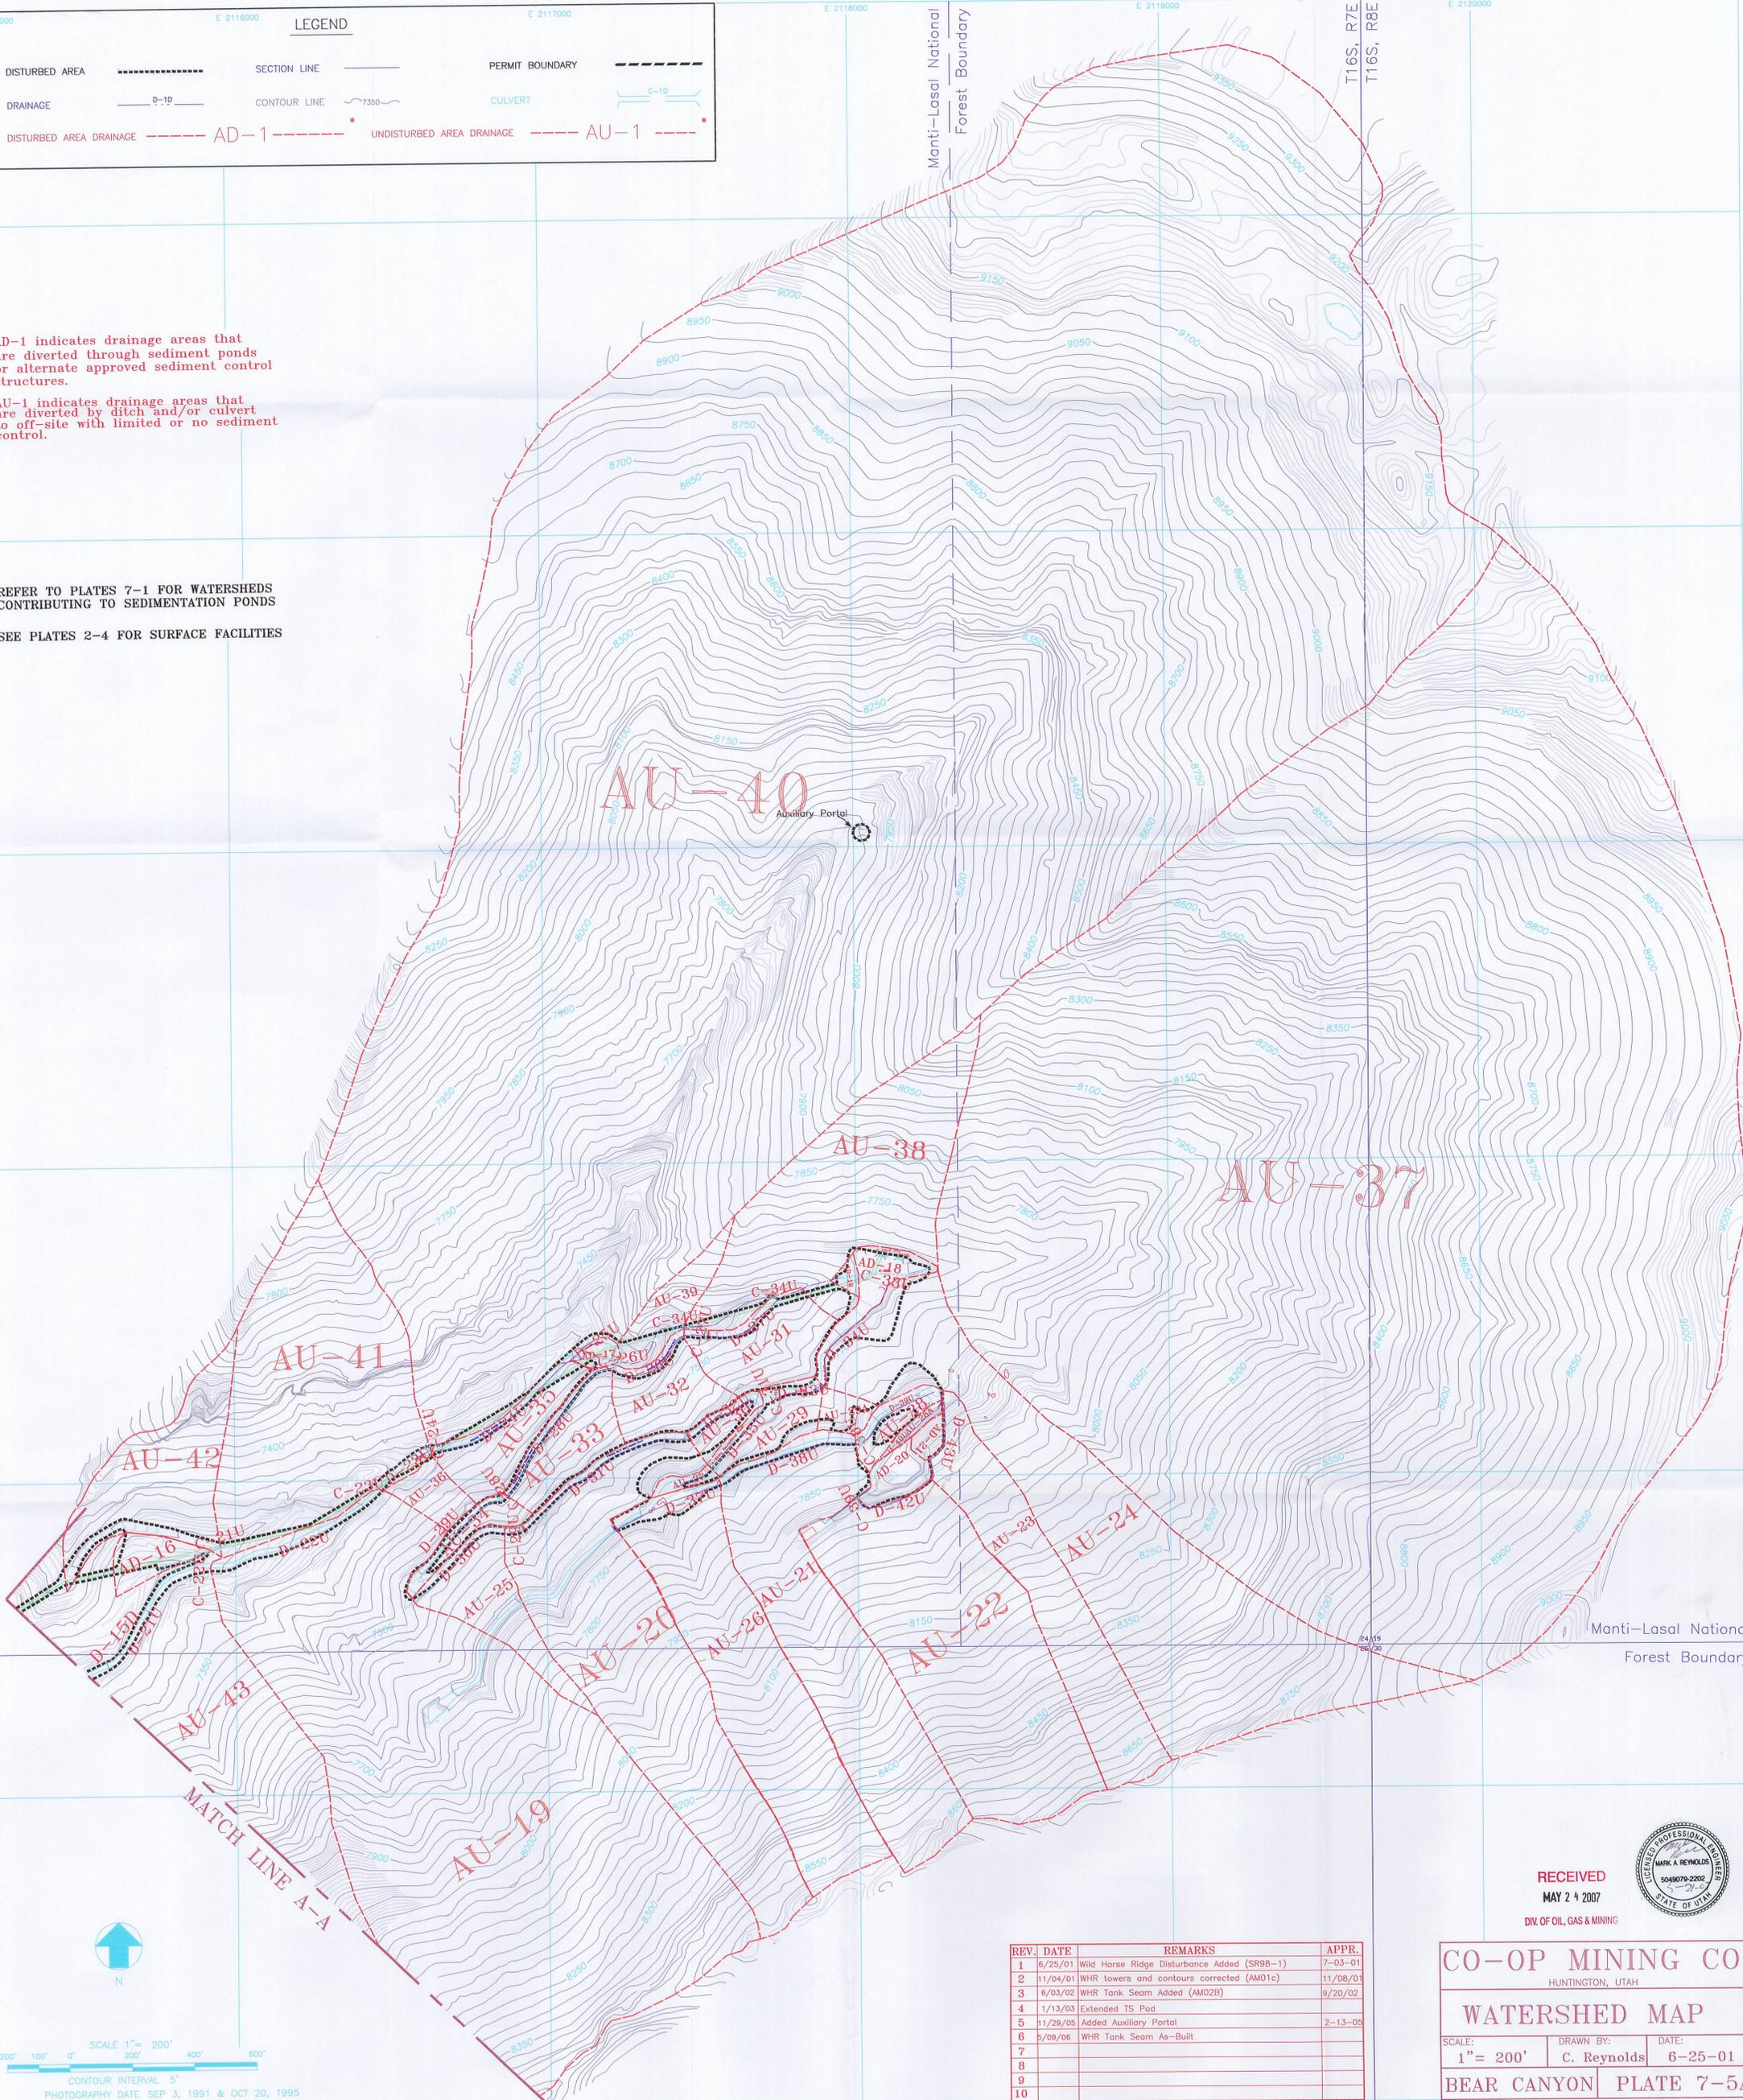

SCALE 1" = 200'  
 200' 100' 0' 200' 400' 600'  
 CONTOUR INTERVAL 5'  
 PHOTOGRAPHY DATE SEP 3, 1991 & OCT 20, 1995

REV.	DATE	REMARKS	APPR.
1	6/25/01	Wild Horse Ridge Disturbance Added (SR98-1)	7-03-01
2	11/04/01	WHR towers and contours corrected (AM01c)	11/08/01
3	6/03/02	WHR Tank Seam Added (AM02B)	9/20/02
4	1/13/03	Extended TS Pod	
5	1/29/05	Added Auxiliary Portal	2-13-05
6	5/09/06	WHR Tank Seam As-Built	
7			
8			
9			
10			

RECEIVED  
 MAY 24 2007  
 DIV. OF OIL, GAS & MINING



**CO-OP MINING CO.**  
 HUNTINGTON, UTAH

**WATERSHED MAP**

SCALE: 1" = 200'      DRAWN BY: C. Reynolds      DATE: 6-25-01

**BEAR CANYON**      **PLATE 7-5A**