


**LEGEND**

-  DISTURBED AREA
-  SOIL BOUNDARY
-  SECTION LINE
-  CONTOUR LINE
-  PERMIT BOUNDARY
-  SURVEY BOUNDARY
  
- PC**      PATHHEAD-CABBA COMPLEX, 30 TO 70% SLOPES
- WIN**     WINETTI, HIGH ELEVATION, 5 TO 30% SLOPES
- WR**      WINETTI, HIGH ELEVATION-ROCK OUTCROP, 10 TO 30% SLOPES
- DON**     DONEY, DEEP, 10 TO 30% SLOPES
- DG**      DATINO-GUBEN COMPLEX, 30 TO 80% SLOPES
- GP**      GUBEN-PATHHEAD COMPLEX, 30 TO 80% SLOPES
- DCP (UFF2)**    DONEY-CABBA-PODO COMPLEX, 30 TO 80% SLOPES
  
- CW-1** ○    SOIL PEDON DESCRIPTIONS
- T1-1** ●    TRANSECT DATA POINTS

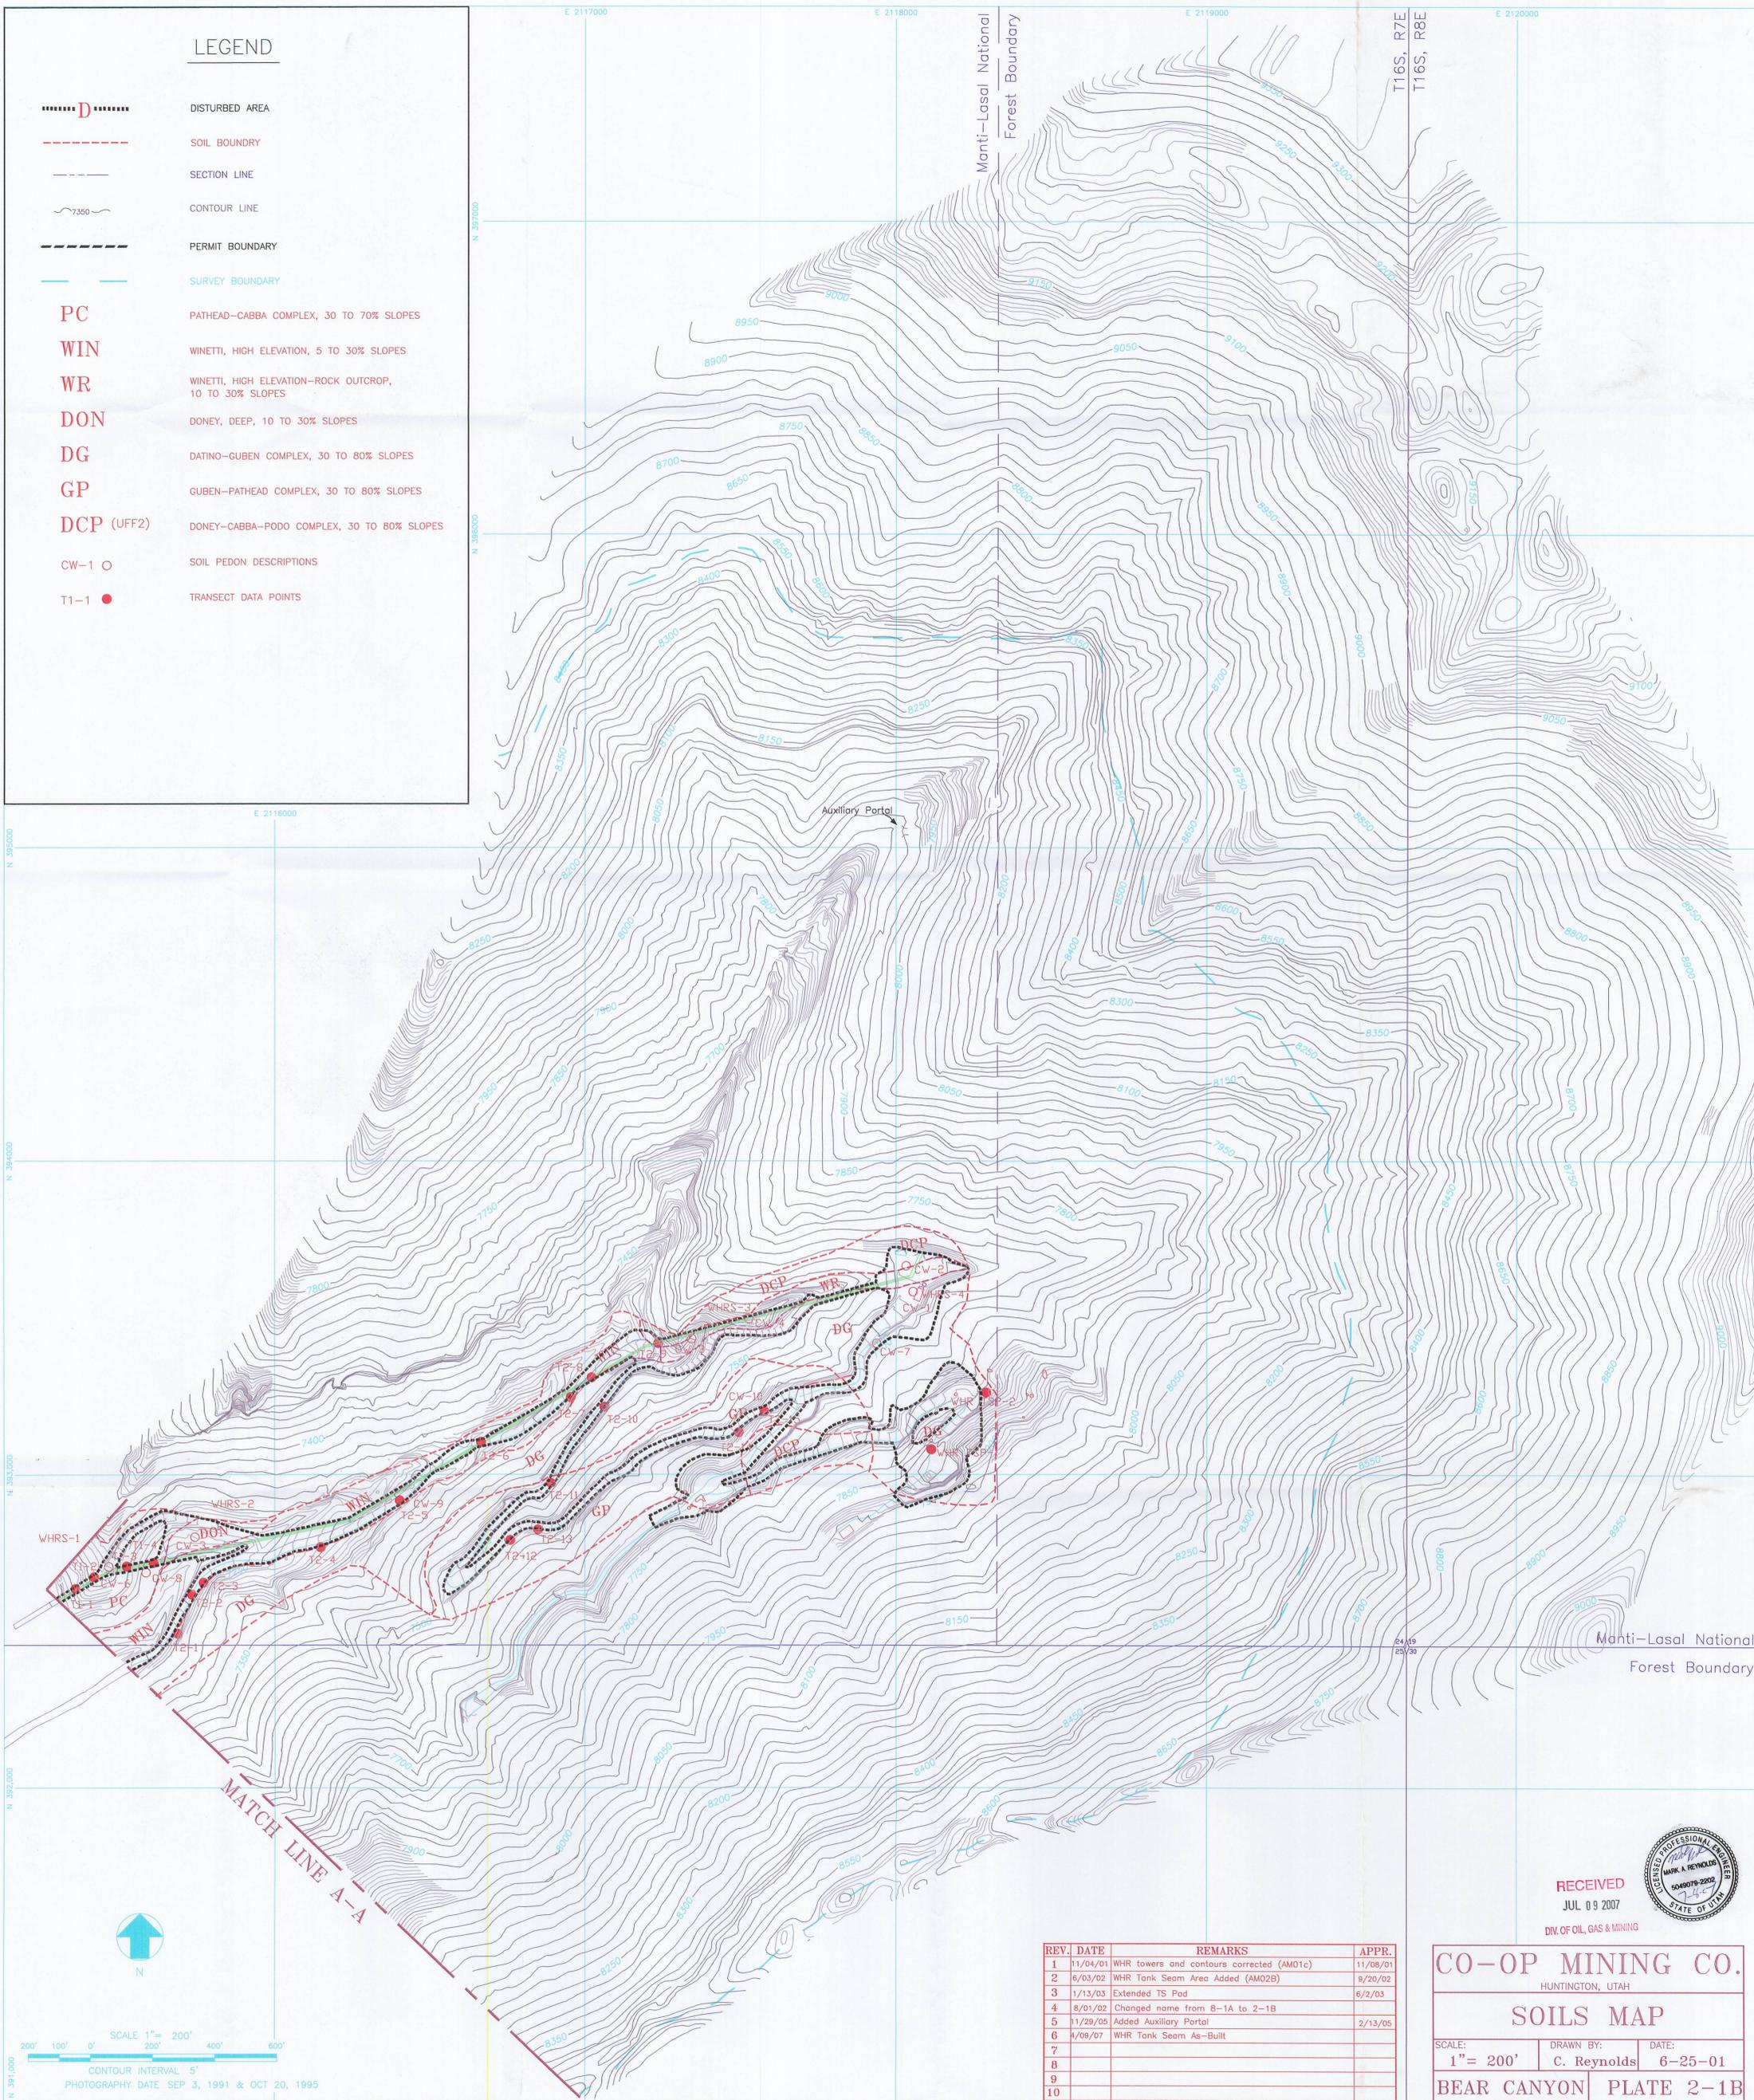

REV.	DATE	REMARKS	APPR.
1	11/04/01	WHR towers and contours corrected (AM01c)	11/08/01
2	6/03/02	WHR Tank Seam Area Added (AM02B)	9/20/02
3	1/13/03	Extended TS Pad	6/2/03
4	8/01/02	Changed name from B-1A to 2-1B	
5	11/29/05	Added Auxiliary Portal	2/13/05
6	4/09/07	WHR Tank Seam As-Built	
7			
8			
9			
10			

RECEIVED  
JUL 09 2007  
DIV. OF OIL, GAS & MINING



**CO-OP MINING CO.**  
HUNTINGTON, UTAH

**SOILS MAP**

SCALE: 1" = 200'  
DRAWN BY: C. Reynolds  
DATE: 6-25-01  
BEAR CANYON PLATE 2-1B