

LEGEND





* AD-1 indicates drainage areas that are diverted through sediment ponds or alternate approved sediment control structures.

AU-1 indicates drainage areas that are diverted by ditch and/or culvert to off-site with limited or no sediment control.

REFER TO PLATES 7-1 FOR WATERSHEDS CONTRIBUTING TO SEDIMENTATION PONDS

SEE PLATES 2-4 FOR SURFACE FACILITIES

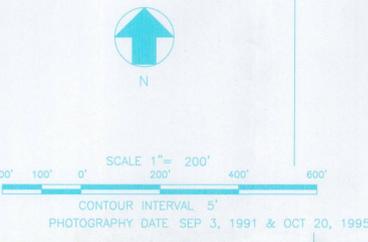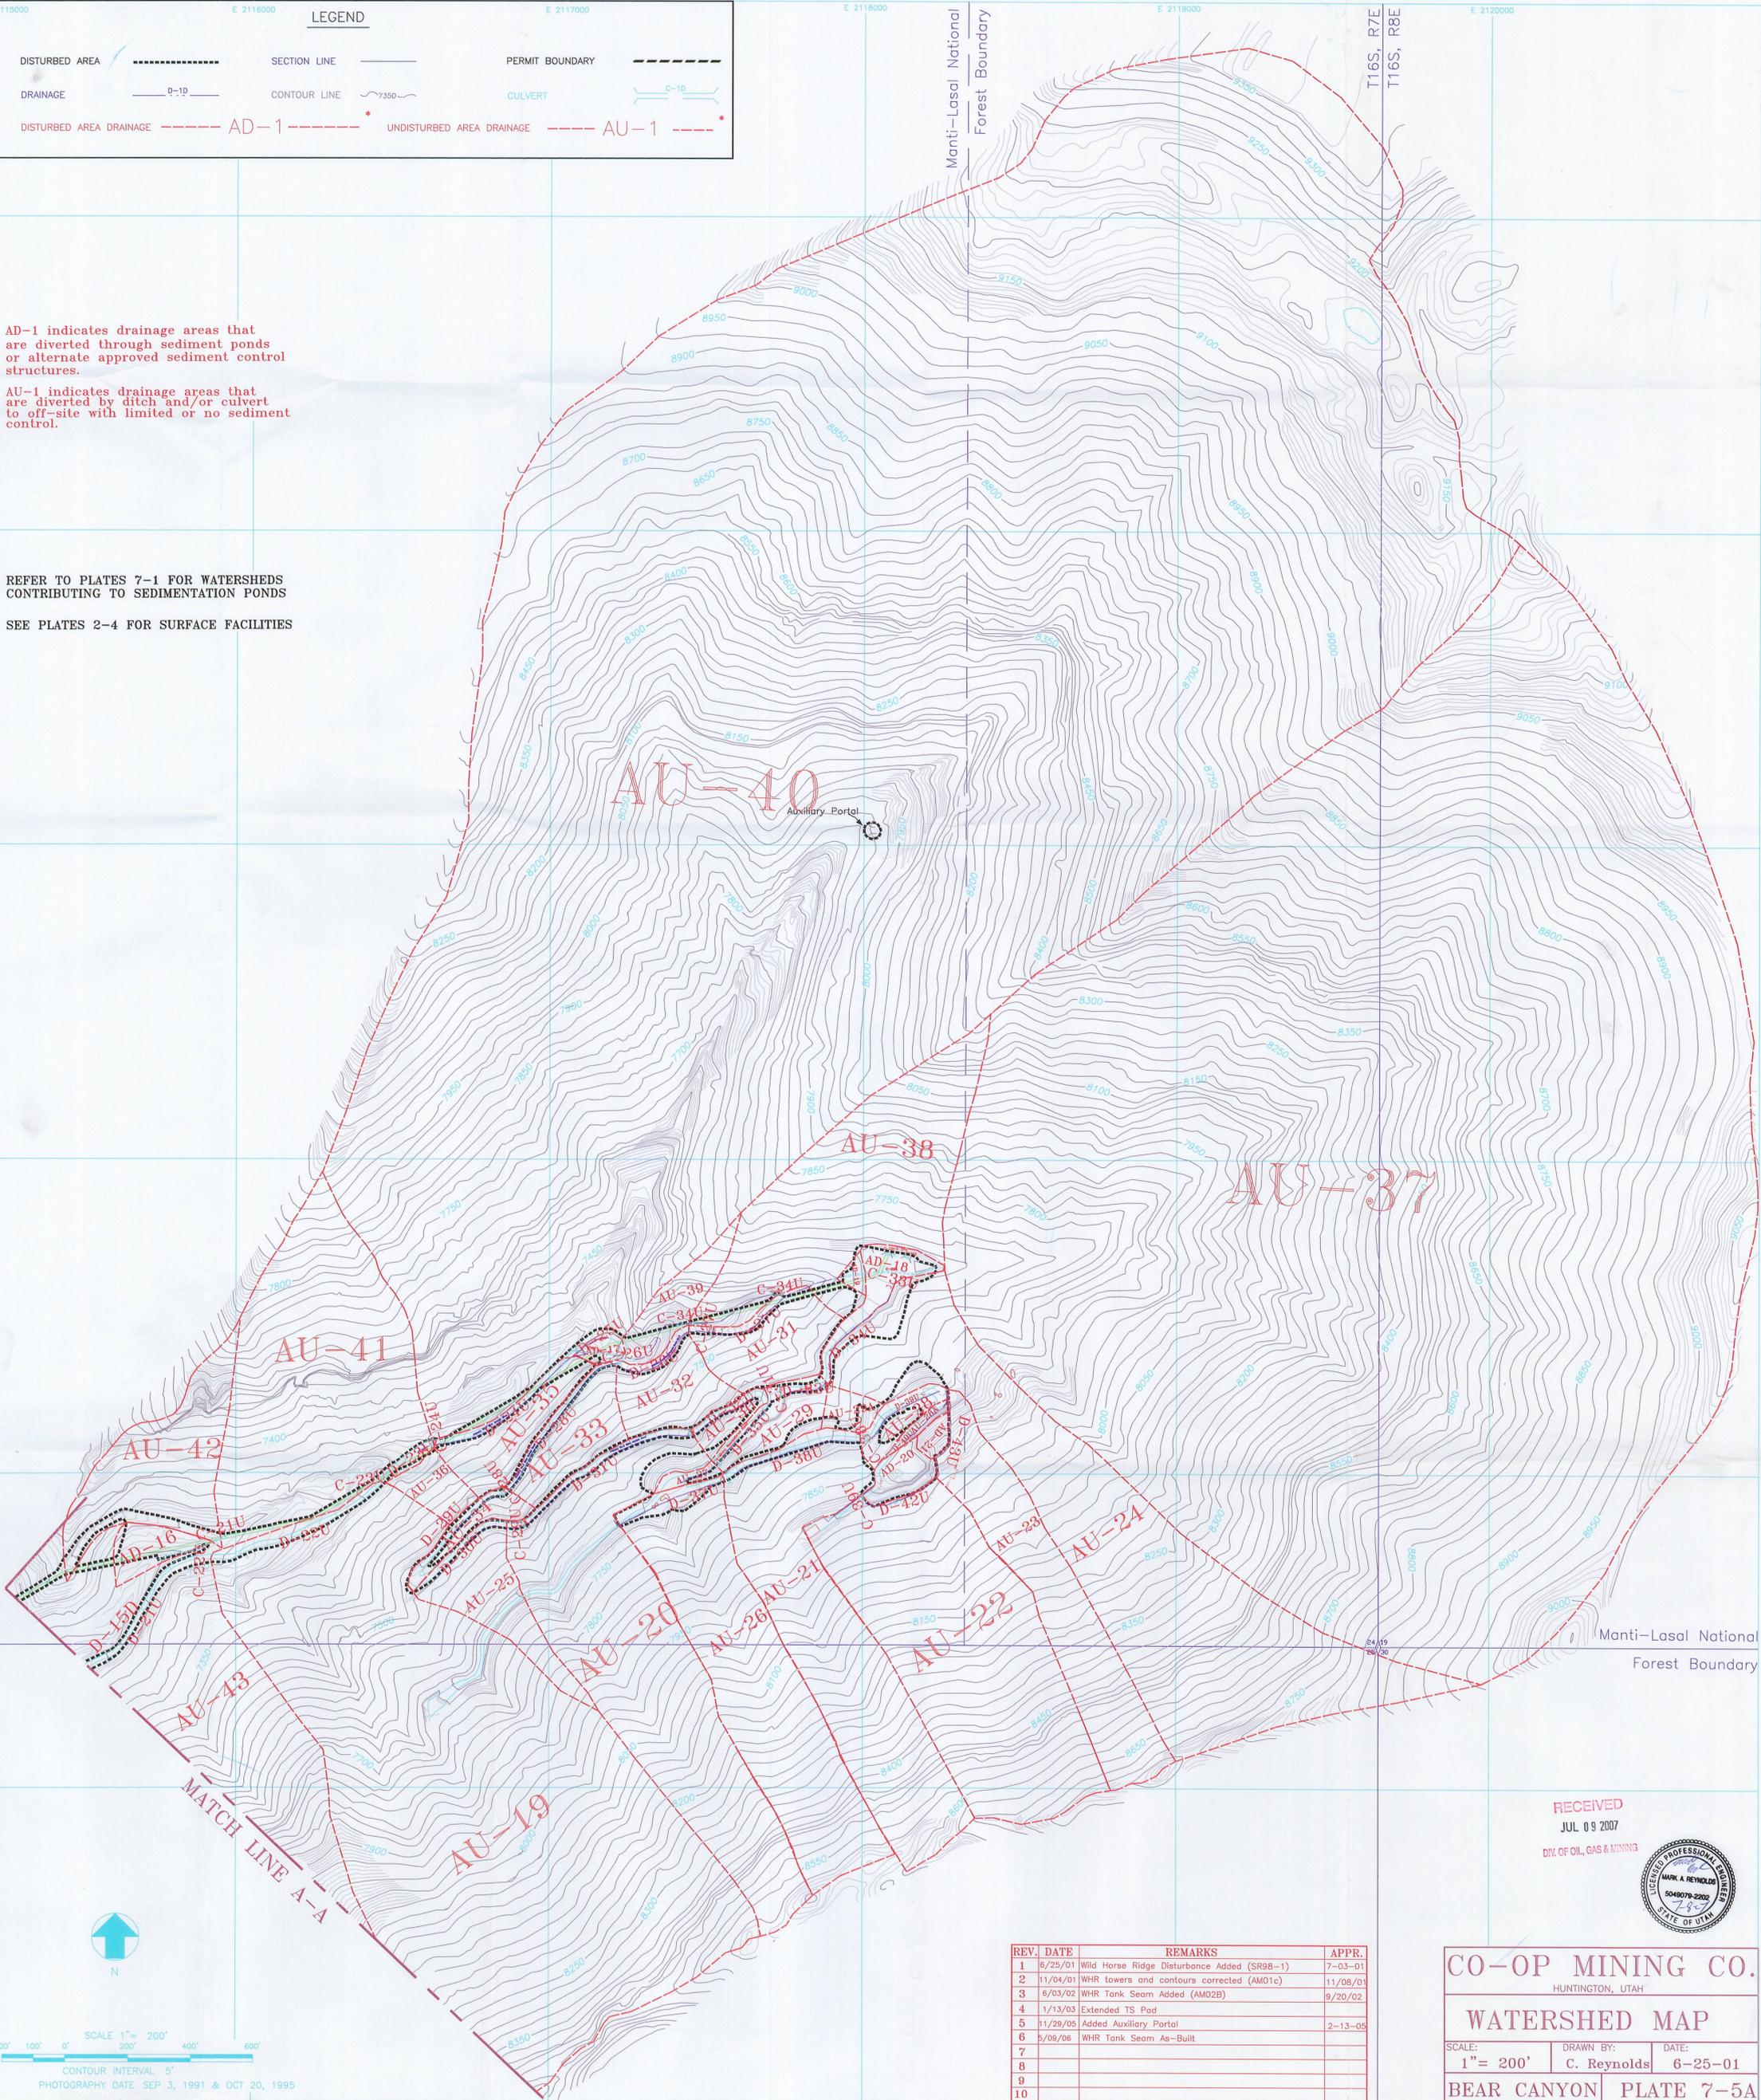

| REV. | DATE | REMARKS | APPR. |
|------|----------|---|----------|
| 1 | 6/25/01 | Wild Horse Ridge Disturbance Added (SR98-1) | 7-03-01 |
| 2 | 11/04/01 | WHR towers and contours corrected (AM01c) | 11/08/01 |
| 3 | 6/03/02 | WHR Tank Seam Added (AM02B) | 9/20/02 |
| 4 | 1/13/03 | Extended TS Pad | |
| 5 | 11/29/05 | Added Auxiliary Portal | 2-13-05 |
| 6 | 5/09/06 | WHR Tank Seam As-Built | |
| 7 | | | |
| 8 | | | |
| 9 | | | |
| 10 | | | |

RECEIVED
JUL 09 2007
DIV. OF OIL, GAS & MINING



CO-OP MINING CO.
HUNTINGTON, UTAH

WATERSHED MAP

SCALE: 1" = 200' DRAWN BY: C. Reynolds DATE: 6-25-01

BEAR CANYON PLATE 7-5A