


LEGEND

DISTURBED AREA	-----	CONTOUR LINE	~ 6880 ~	DRAINAGE	---
PERMIT BOUNDARY	-----	RECLAIMED ROADS	---	CULVERTS	---
SECTION LINE	---	POST-MINING ROADS	---	POST-MINING CUT SLOPES TO REMAIN IN PLACE	---

RECONTOURED AREAS ARE DRAWN TYPICALLY AT 5 FT. AND 10 FT. CONTOUR INTERVALS

SEE PLATE 7-7 FOR POST-MINING DRAINAGE

SEE PLATES 2-4 FOR PRE-1977 DISTURBANCE
SEE APPENDIX 7-K FOR BTCA DESIGNS
SEE APP. 3-0 & 3-P FOR CROSS SECTION PROFILES

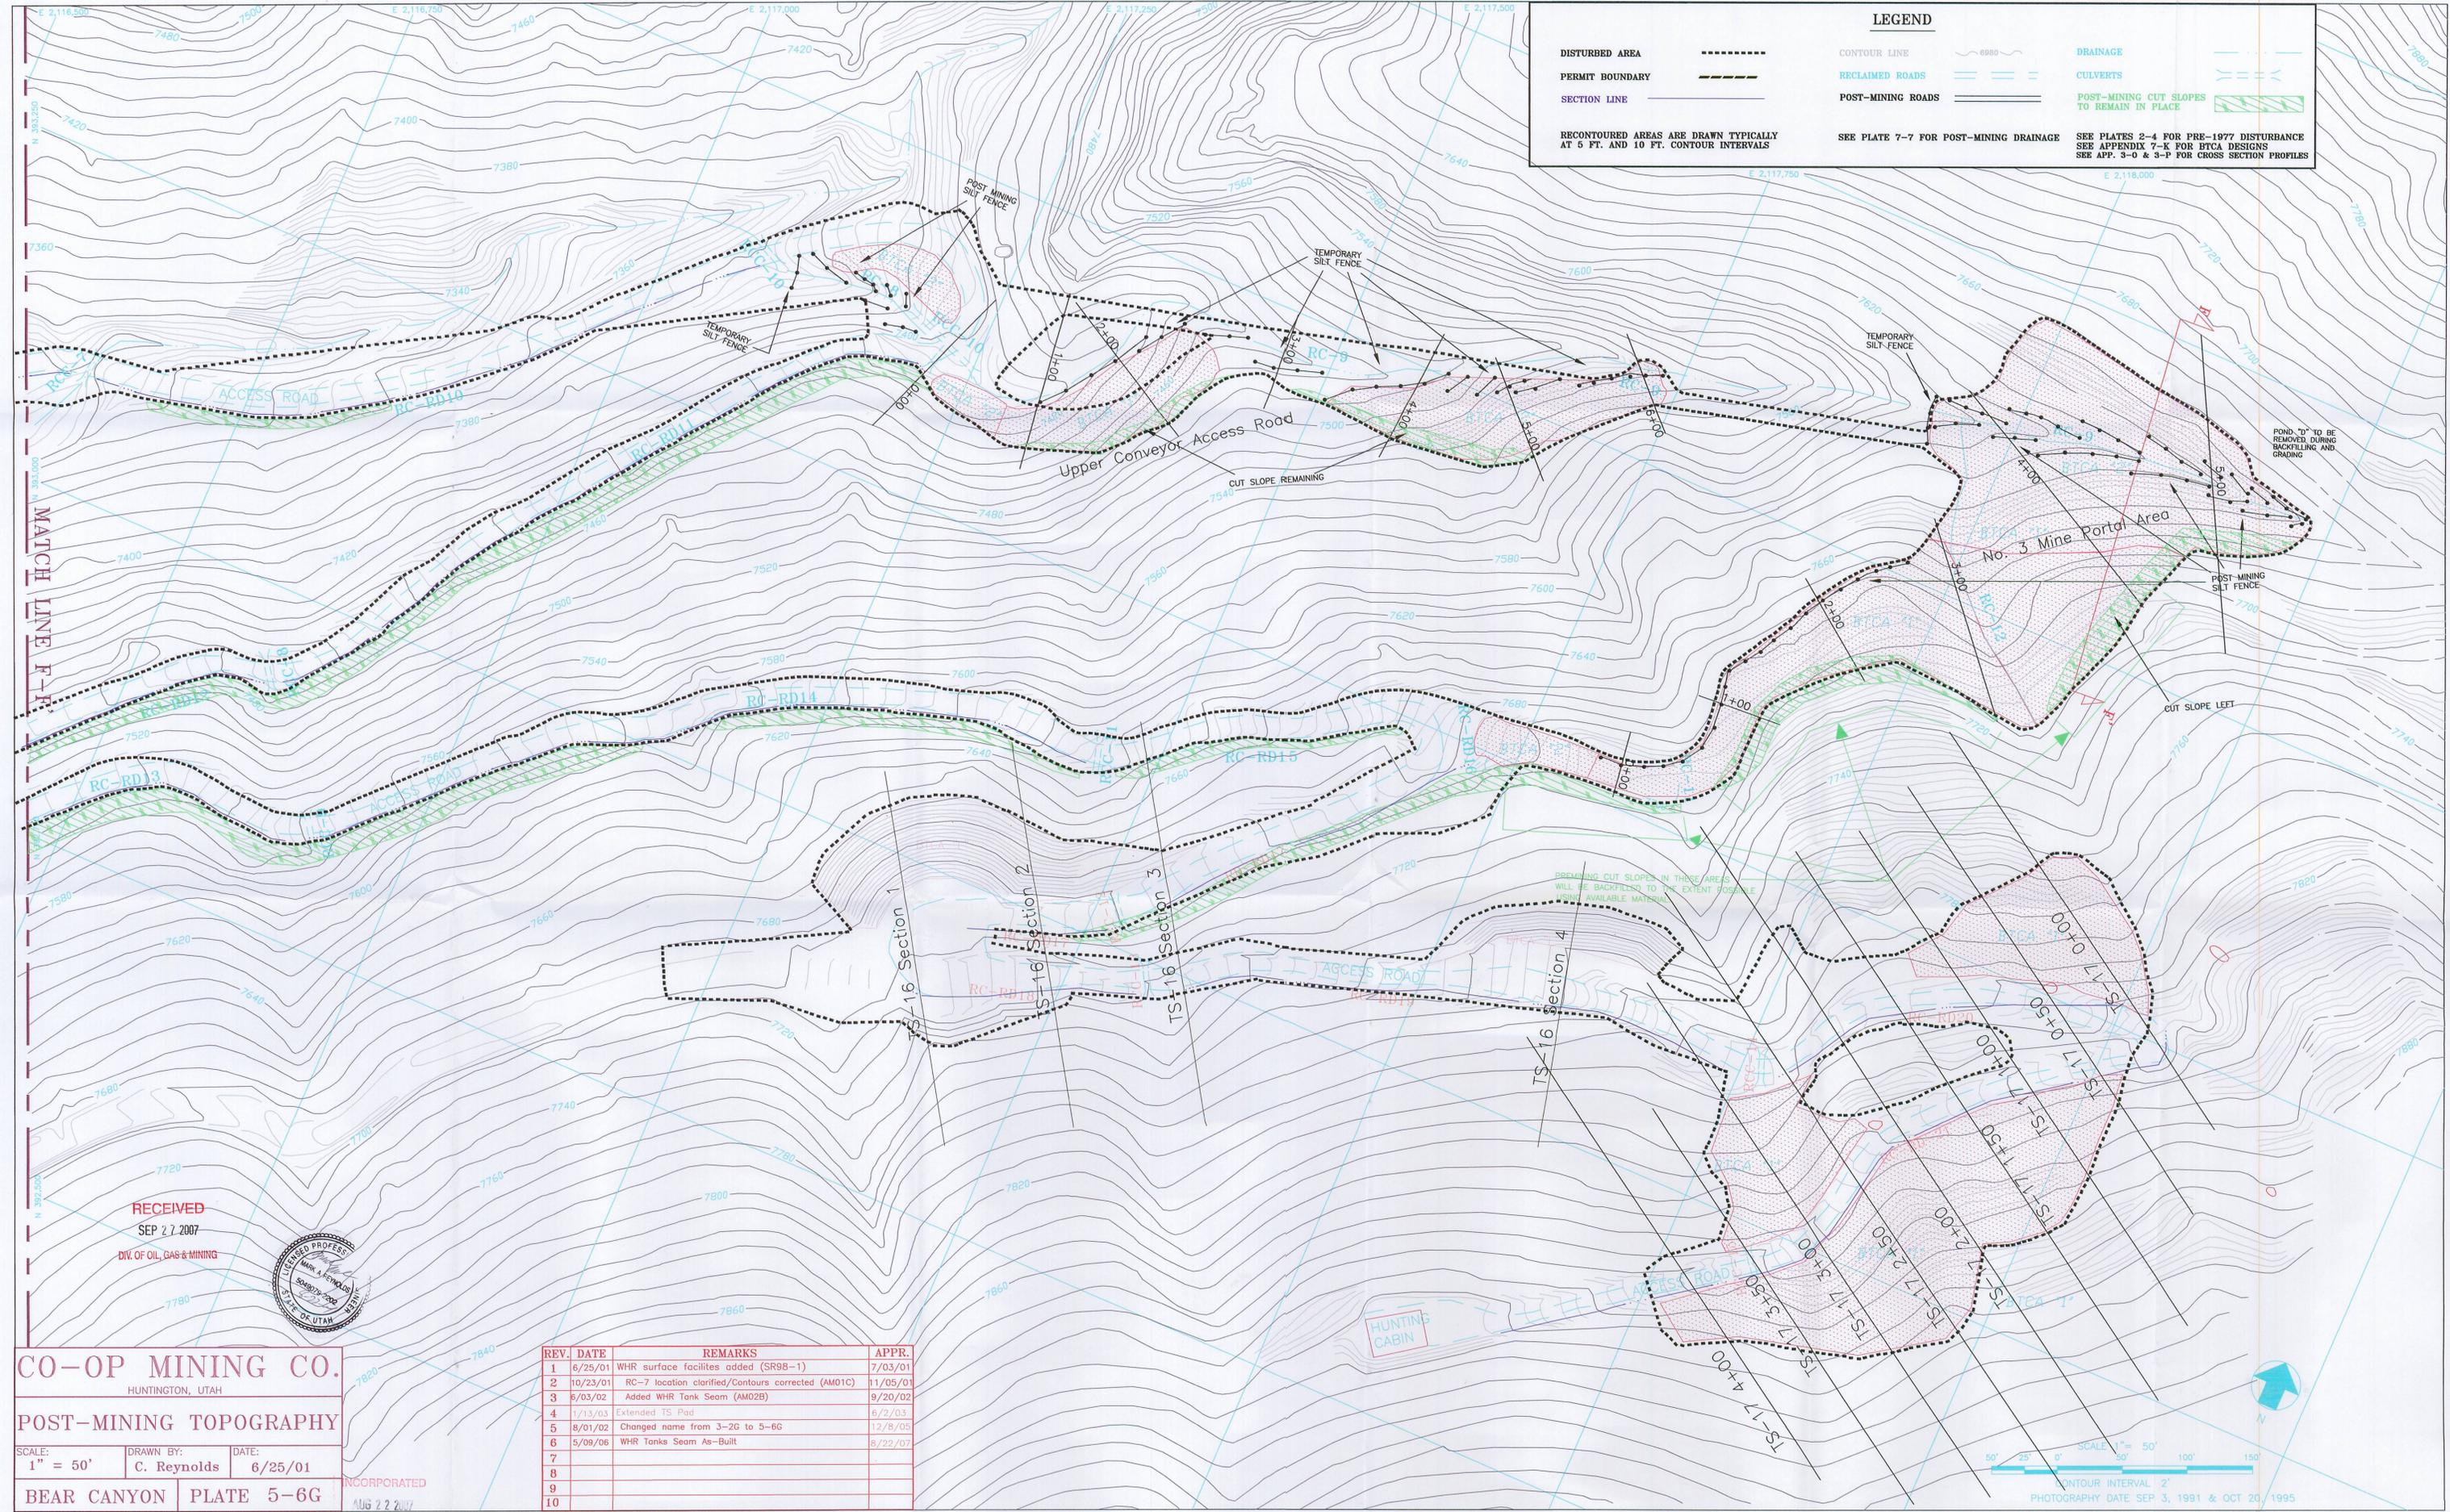

RECEIVED
SEP 27 2007
DIV. OF OIL, GAS & MINING



CO-OP MINING CO.
HUNTINGTON, UTAH

POST-MINING TOPOGRAPHY

SCALE: 1" = 50'
DRAWN BY: C. Reynolds
DATE: 6/25/01

BEAR CANYON PLATE 5-6G

REV.	DATE	REMARKS	APPR.
1	6/25/01	WHR surface facilities added (SR98-1)	7/03/01
2	10/23/01	RC-7 location clarified/Contours corrected (AM01C)	11/05/01
3	6/03/02	Added WHR Tank Seam (AM02B)	9/20/02
4	1/13/03	Extended TS Pad	6/2/03
5	8/01/02	Changed name from 3-26 to 5-6G	12/8/05
6	5/09/06	WHR Tanks Seam As-Built	8/22/07
7			
8			
9			
10			

