

LEGEND


DISTURBED AREA	-----	SECTION LINE	———	PERMIT BOUNDARY	-----
DRAINAGE	——— 0-10	CONTOUR LINE	~ 7350	CULVERT	——— C-10
DISTURBED AREA DRAINAGE	----- AD-1	UNDISTURBED AREA DRAINAGE	----- AU-1		

* AD-1 indicates drainage areas that are diverted through sediment ponds or alternate approved sediment control structures.

AU-1 indicates drainage areas that are diverted by ditch and/or culvert to off-site with limited or no sediment control.

REFER TO PLATES 7-1 FOR WATERSHEDS CONTRIBUTING TO SEDIMENTATION PONDS

SEE PLATES 2-4 FOR SURFACE FACILITIES

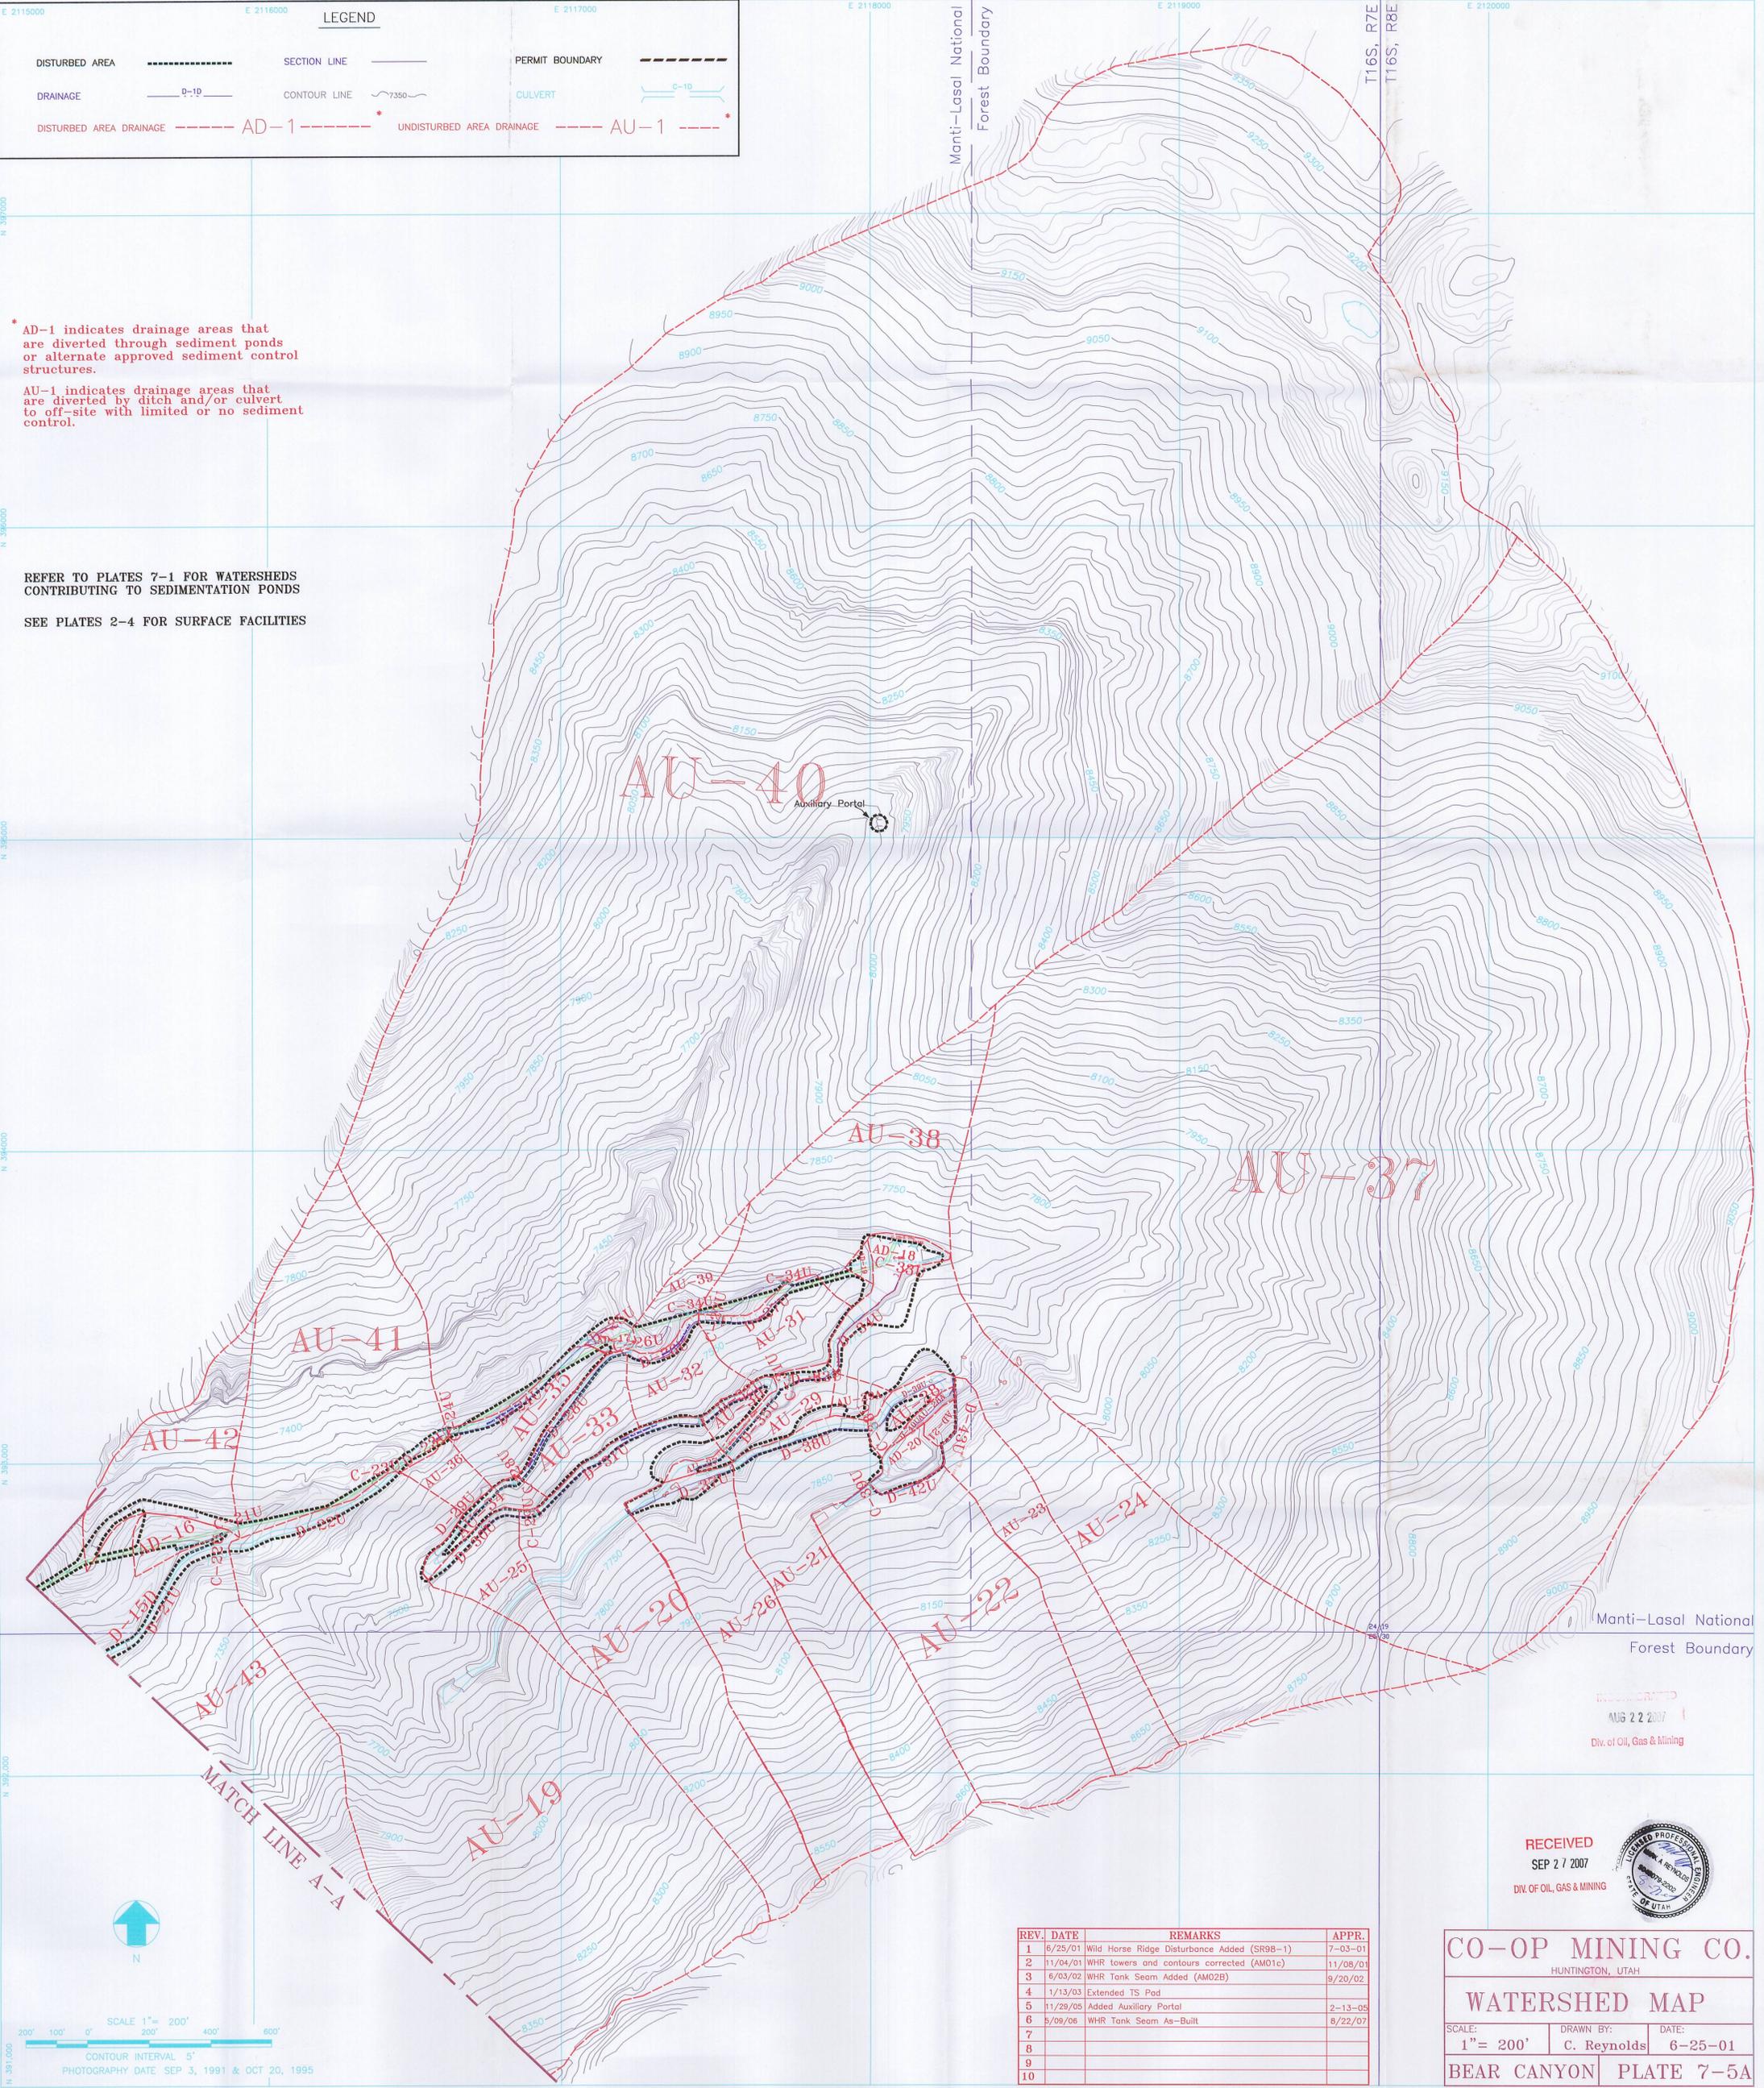

SCALE 1" = 200'

CONTOUR INTERVAL 5'

PHOTOGRAPHY DATE SEP 3, 1991 & OCT 20, 1995

↑ N

REV.	DATE	REMARKS	APPR.
1	5/25/01	Wild Horse Ridge Disturbance Added (SR98-1)	7-03-01
2	11/04/01	WHR towers and contours corrected (AM01c)	11/08/01
3	6/03/02	WHR Tank Seam Added (AM02B)	9/20/02
4	1/13/03	Extended TS Pad	
5	11/29/05	Added Auxiliary Portal	2-13-05
6	5/09/06	WHR Tank Seam As-Built	8/22/07
7			
8			
9			
10			

RECEIVED
SEP 27 2007
DIV. OF OIL, GAS & MINING



CO-OP MINING CO.
HUNTINGTON, UTAH

WATERSHED MAP

SCALE: 1" = 200' DRAWN BY: C. Reynolds DATE: 6-25-01

BEAR CANYON **PLATE 7-5A**