




PLAN VIEW

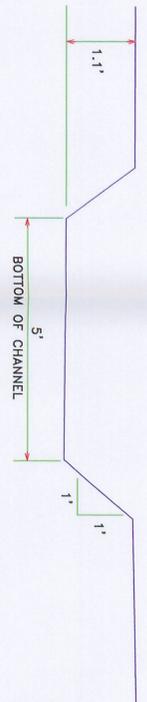

SECTION C-C'

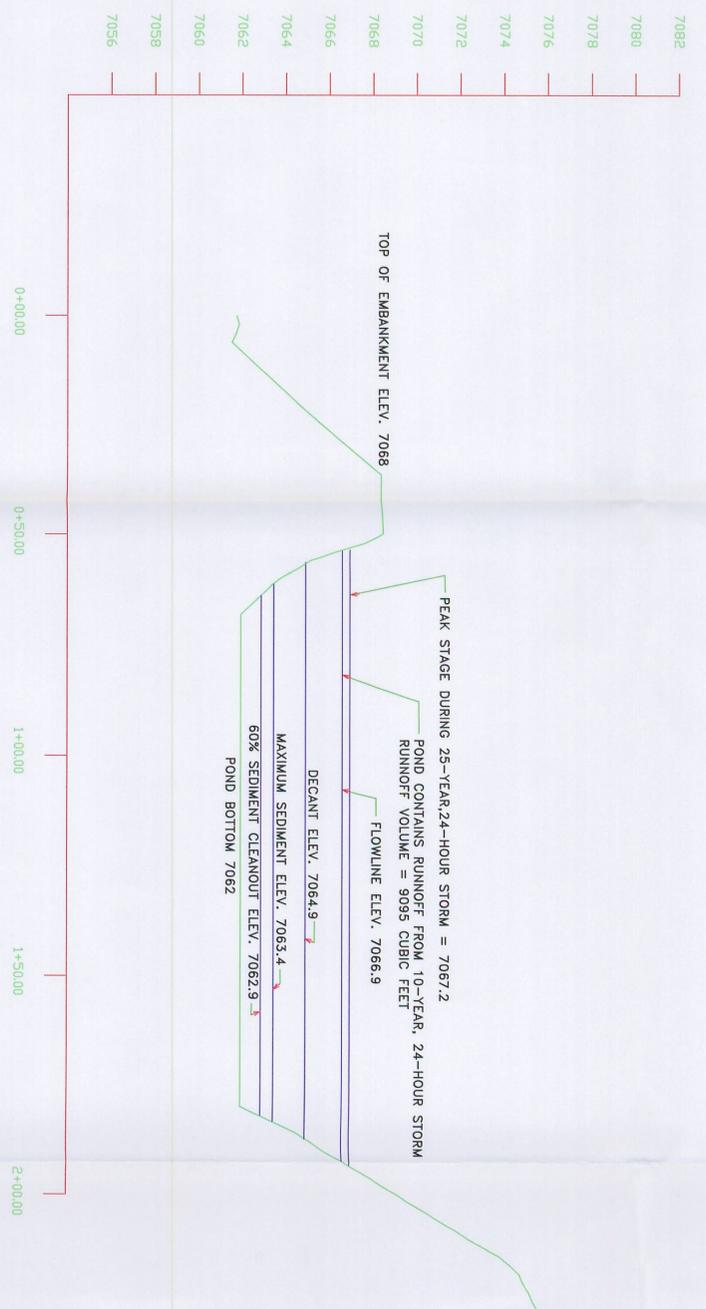

SECTION A-A'

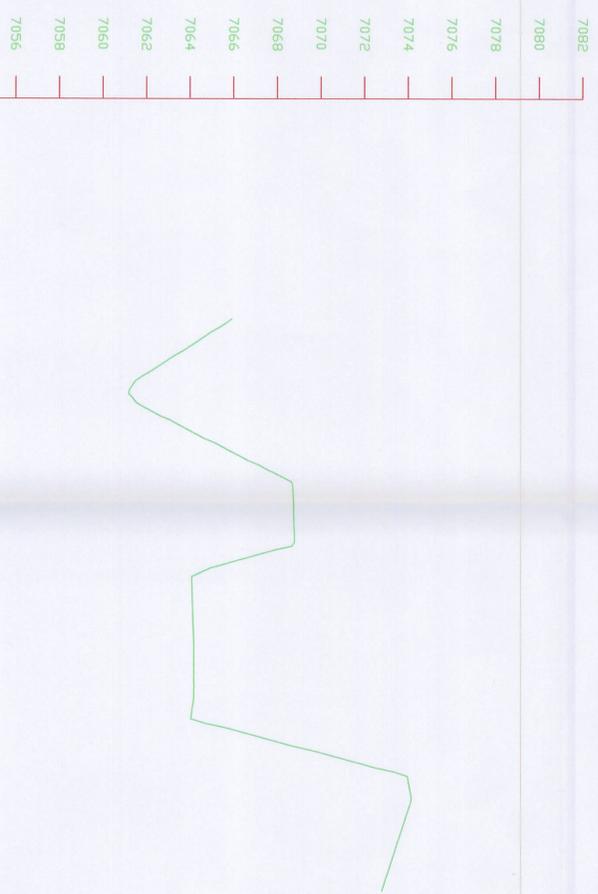

SECTION B-B'

REV.	DATE	REMARKS
1	3/31/92	DECANT/SED. MARKER/CULVERT ADDED
2	8/01/02	Digitized MDP
3	12/14/10	NOV-10068: Added C-140, removed grouted inlet to Pond
4		
5		
6		
7		
8		
9		
10		

RECEIVED  
DEC 28 2010  
DIV. OF OIL, GAS & MINING

ENGINEER'S CERTIFICATION  
I hereby certify that this drawing was prepared by me or under my direct supervision and that all of the information presented on this drawing is true and correct to the best of my knowledge and belief.  
James E. Stover, P.E.  
Utah P.E. 518604-2202

CASTLE VALLEY MINING, LLC  
AS BUILT  
**SEDIMENT POND "B"**  
SCALE: 1" = 20'  
DRAWN BY: C. REYNOLDS  
DATE: 8/01/91  
BEAR CANYON PLATE 7-3