


SEDIMENT POND PLAN VIEW

NOTE--SEE PLATE 7-6a FOR AS-BUILT CROSS-SECTIONS A-A', B-B', & C-C'

LARGE RIPRAP  
SMALL RIPRAP

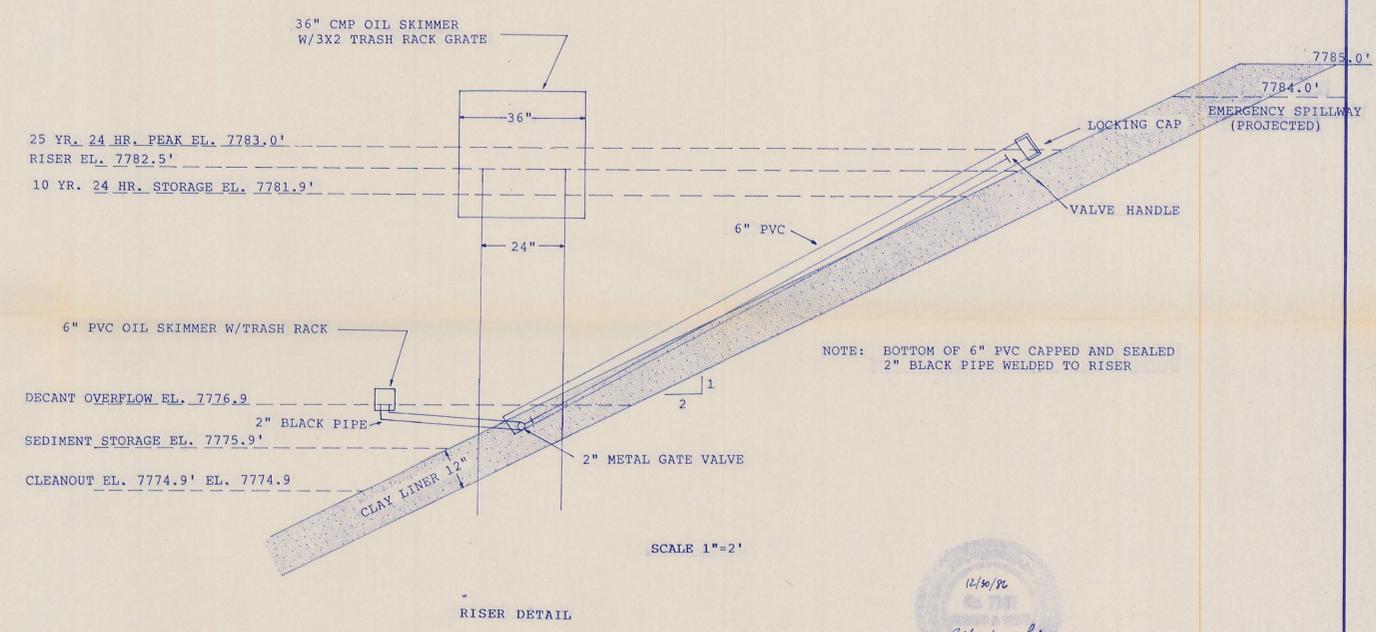

**GENWAL COAL CO.**  
 SEDIMENT POND DETAIL (AS BUILT)  
 FEB. 10, 1988  
 SCALE AS NOTED  
 PLATE 7-4a

ACK