



P.O. Box 910, East Carbon, Utah 84520 794 North "C" Canyon Rd, East Carbon, Utah 84520
Telephone (435) 888-4000 Fax (435) 888-4002

Utah Division of Oil, Gas & Mining
Utah Coal Program
1594 West North Temple, Suite 1210
P.O. Box 145801
Salt Lake City, UT 84114-5801

June 8, 2018

Attn: Daron Haddock
Permit Supervisor

Re: Genwal Resources, Inc. C/015/032
C18-003 Pond Map

Dear Mr. Haddock,

Please find attached the application to update Plate 7-3 sediment marker information for the approved Crandall Canyon MRP.

If you have any questions or problems with this change, please feel free to call me directly at 435-888-4026.

A handwritten signature in black ink, appearing to read "K. Madsen", is written over a horizontal line.

Karin Madsen
Engineering Tech
UtahAmerican Energy, Inc.

APPLICATION FOR PERMIT PROCESSING

<input checked="" type="checkbox"/> Permit Change X	<input type="checkbox"/> New Permit	<input type="checkbox"/> Renewal	<input type="checkbox"/> Transfer	<input type="checkbox"/> Exploration	<input type="checkbox"/> Bond Release	Permit Number: ACT/015/032
Title of Proposal: C18-003 Pond Map						Mine: Crandall Canyon Mine
						Permittee: Genwal Resources, Inc.


Description, include reason for application and timing required to implement

Instructions: If you answer yes to any of the first 8 questions (gray), submit the application to the Salt Lake Office. Otherwise, you may submit it to your reclamation


<input type="checkbox"/> Yes	<input type="checkbox"/> No	1. Change in the size of the Permit Area? _____ acres Disturbed Area? _____ acres <input type="checkbox"/> increase <input type="checkbox"/> decrease.
<input type="checkbox"/> Yes	<input type="checkbox"/> No	2. Is the application submitted as a result of a Division Order? DO #
<input type="checkbox"/> Yes	<input type="checkbox"/> No	3. Does application include operations outside a previously identified Cumulative Hydrologic Impact Area?
<input type="checkbox"/> Yes	<input type="checkbox"/> No	4. Does application include operations in hydrologic basins other than as currently approved?
<input type="checkbox"/> Yes	<input type="checkbox"/> No	5. Does application result from cancellation, reduction or increase of insurance or reclamation bond?
<input type="checkbox"/> Yes	<input type="checkbox"/> No	6. Does the application require or include public notice/publication?
<input type="checkbox"/> Yes	<input type="checkbox"/> No	7. Does the application require or include ownership, control, right-of-entry, or compliance information?
<input type="checkbox"/> Yes	<input type="checkbox"/> No	8. Is proposed activity within 100 feet of a public road or cemetery or 300 feet of an occupied dwelling?
<input type="checkbox"/> Yes	<input type="checkbox"/> No	9. Is the application submitted as a result of a Violation?
<input type="checkbox"/> Yes	<input type="checkbox"/> No	10. Is the application submitted as a result of other laws or regulations or policies? Explain:
<input type="checkbox"/> Yes	<input type="checkbox"/> No	11. Does the application affect the surface landowner or change the post mining land use?
<input type="checkbox"/> Yes	<input type="checkbox"/> No	12. Does the application require or include underground design or mine sequence and timing? (Modification of R2P2?)
<input type="checkbox"/> Yes	<input type="checkbox"/> No	13. Does the application require or include collection and reporting of any baseline information?
<input type="checkbox"/> Yes	<input type="checkbox"/> No	14. Could the application have any effect on wildlife or vegetation outside the current disturbed area?
<input type="checkbox"/> Yes	<input type="checkbox"/> No	15. Does application require or include soil removal, storage or placement?
<input type="checkbox"/> Yes	<input type="checkbox"/> No	16. Does the application require or include vegetation monitoring, removal or revegetation activities?
<input type="checkbox"/> Yes	<input type="checkbox"/> No	17. Does the application require or include construction, modification, or removal of surface facilities?
<input type="checkbox"/> Yes	<input type="checkbox"/> No	18. Does the application require or include water monitoring, sediment or drainage control measures?
<input type="checkbox"/> Yes	<input type="checkbox"/> No	19. Does the application require or include certified designs, maps, or calculations?
<input type="checkbox"/> Yes	<input type="checkbox"/> No	20. Does the application require or include subsidence control or monitoring?
<input type="checkbox"/> Yes	<input type="checkbox"/> No	21. Have reclamation costs for bonding been provided for?
<input type="checkbox"/> Yes	<input type="checkbox"/> No	22. Does application involve a perennial stream, a stream buffer zone or discharges to a stream?
<input type="checkbox"/> Yes	<input type="checkbox"/> No	23. Does the application affect permits issued by other agencies or permits issued to other entities?

X Attach 1 complete digital copy of the application and maps.

I hereby certify that I am a responsible official of the applicant and that the information contained in this application is true and correct to the best of my information and belief in all respects with the laws of Utah in reference to commitments, undertakings, and obligations, herein.

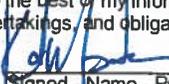 Karin Madsen - Engineering Tech - 6-8-18
Signed - Name - Position - Date

Subscribed and sworn to before me this 8th day of June, 2018.


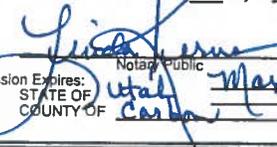
 Notary Public
My Commission Expires: March 27, 2021
Attest: STATE OF Utah COUNTY OF Carson




LINDA KERNS
NOTARY PUBLIC
STATE OF UTAH
COMMISSION # 693708
COMM.EXP.03-27-2021

Received by Oil, Gas & Mining



ASSIGNED TRACKING NUMBER

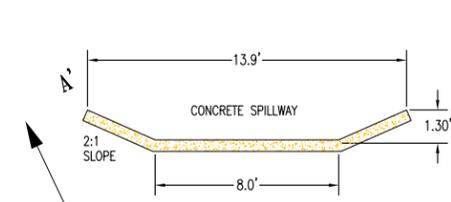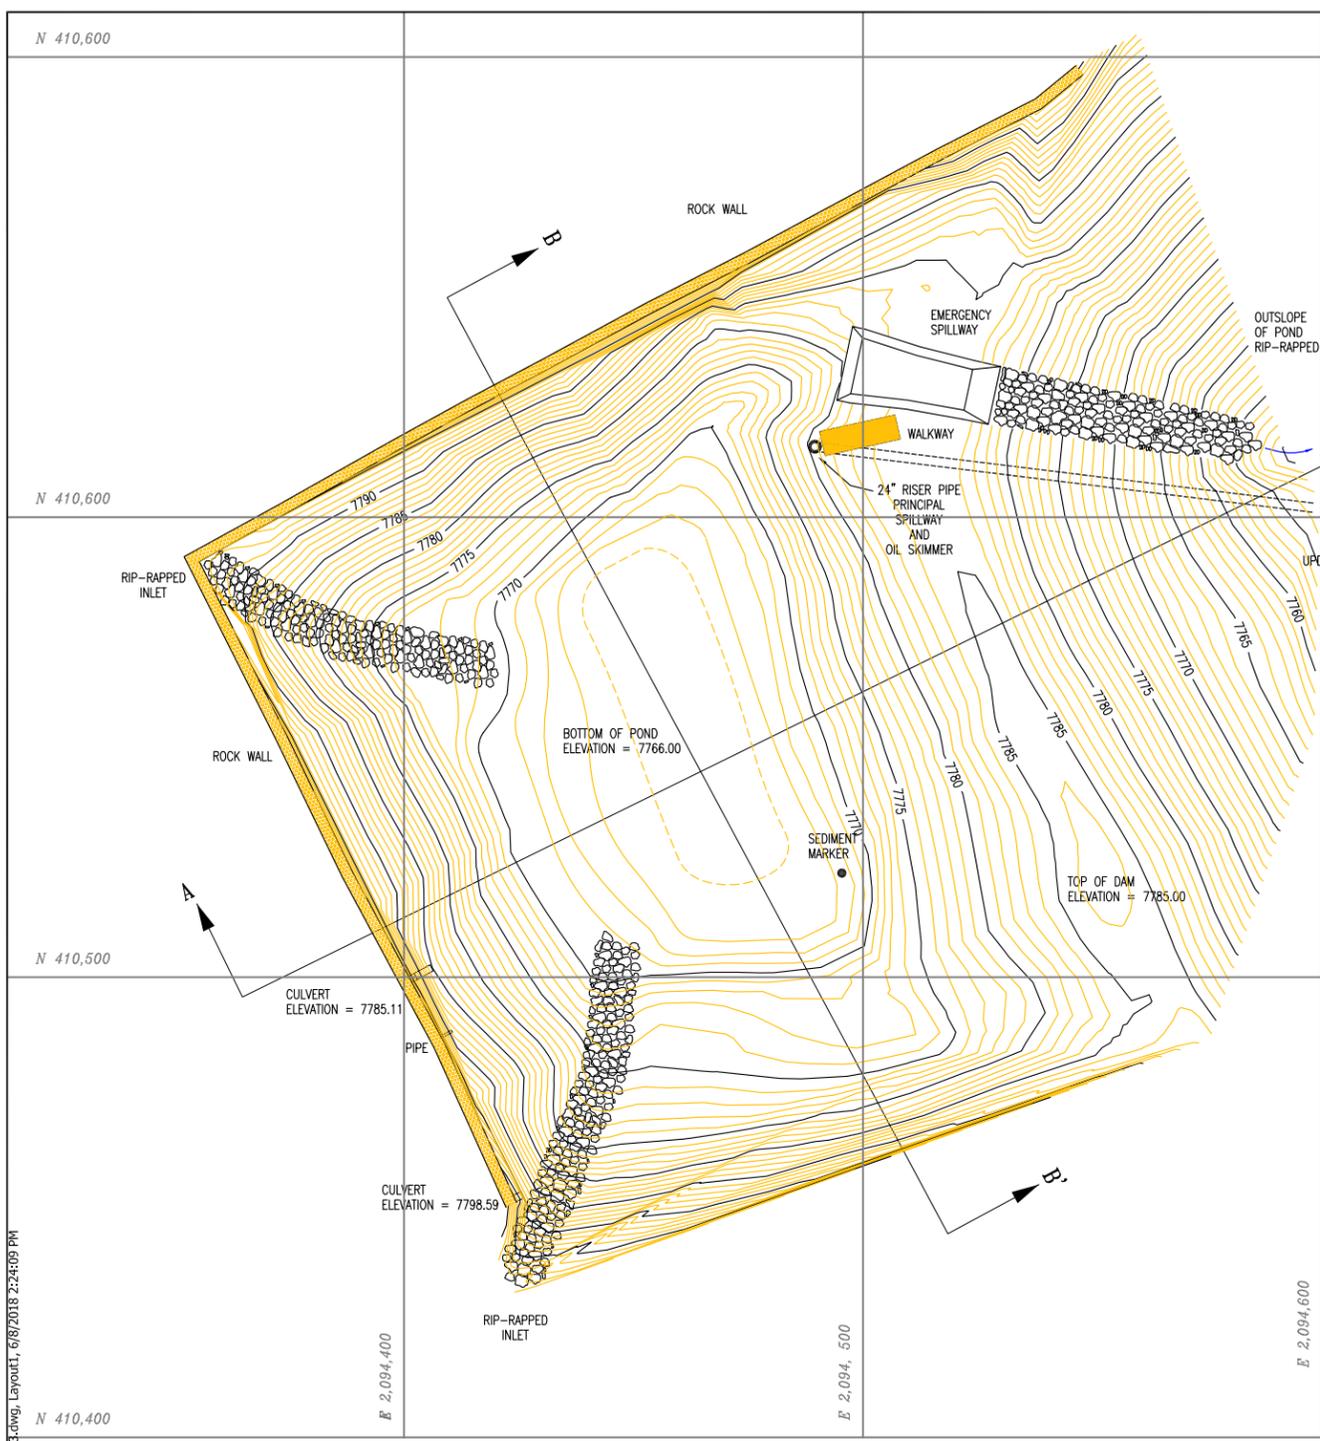


EMERGENCY SPILLWAY DETAIL

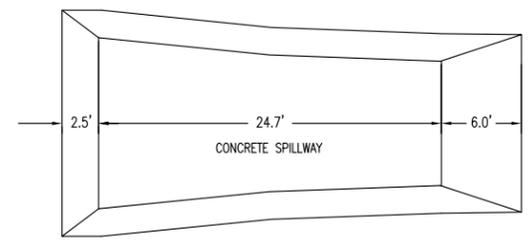

PRINCIPAL SPILLWAY DETAIL

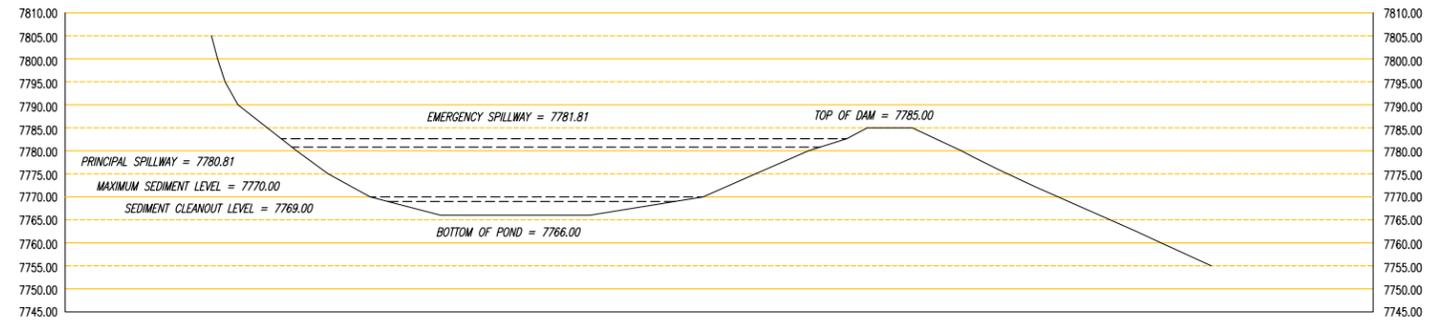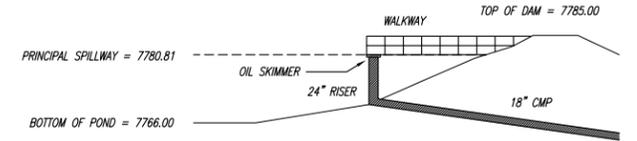

SECTION A-A'

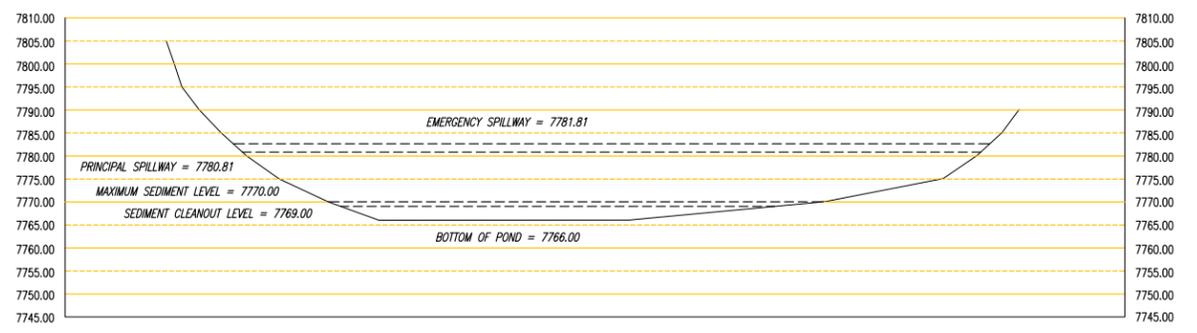

SECTION B-B'

AS-BUILT SEDIMENT POND:

LOCATION:	ELEVATION:	VOLUME:
BOTTOM OF POND:	7766.00	0.000 AC. FT.
SEDIMENT CLEANOUT LEVEL:	7769.00	0.290 AC. FT.
MAXIMUM SEDIMENT LEVEL:	7770.00	0.437 AC. FT.
PRINCIPAL SPILLWAY:	7780.81	3.513 AC. FT.
EMERGENCY SPILLWAY:	7781.81	3.936 AC. FT.



CONTOUR INTERVAL = 1'



P.O. Box 1077, 794 North "C" Canyon Rd, Price Utah
Telephone: (435) 888-4000

**CRANDALL CANYON MINE
SEDIMENT POND (AS-BUILT)**

REV: 13	ACAD: 7-3
DATE: 06-08-18	BY: JDS, PJJ
SCALE: 1" = 40'	PLATE #: 7-3