



P.O. Box 910, East Carbon, Utah 84520 794 North "C" Canyon Rd, East Carbon, Utah 84520  
Telephone (435) 888-4000 Fax (435) 888-4002

Utah Division of Oil, Gas & Mining  
Utah Coal Program  
1594 West North Temple, Suite 1210  
P.O. Box 145801  
Salt Lake City, UT 84114-5801

September 24, 2018

Attn: Daron Haddock  
Permit Supervisor

Re: Genwal Resources, Inc. C/015/032  
Trail Mountain Wildfire Drainage As-Built

Dear Mr. Haddock,

After the Trail Mountain Wildfire that took place this summer, Genwal Resources Inc. made upgrades to the existing debris racks that were already in place at Crandall Canyon Mine. Attached is the As-Built Map (Facilities Plate 5-3) showing the upgraded trash racks to be incorporated into our MRP.

If you have any questions regarding this submittal, please feel free to call me directly at: 435-888-4000.

A handwritten signature in black ink, appearing to read "Karin Madsen", is written over a horizontal line.

Karin Madsen  
Environmental Engineering Technician  
Genwal Resources, Inc.

# APPLICATION FOR PERMIT PROCESSING

<input checked="" type="checkbox"/> Permit Change	<input type="checkbox"/> New Permit	<input type="checkbox"/> Renewal	<input type="checkbox"/> Transfer	<input type="checkbox"/> Exploration	<input type="checkbox"/> Bond Release	Permit Number: ACT/015/032
Title of Proposal: C18-004 Trash Rack As-Built						Mine: Crandall Canyon Mine
						Permittee: Genwal Resources, Inc.

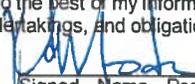
Description, include reason for application and timing required to implement

**Instructions:** If you answer yes to any of the first 8 questions (gray), submit the application to the Salt Lake Office. Otherwise, you may submit it to your reclamation

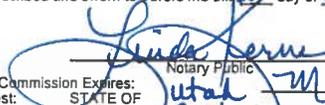
<input type="checkbox"/> Yes	<input type="checkbox"/> No	1. Change in the size of the Permit Area? _____ acres Disturbed Area? _____ acres <input type="checkbox"/> increase <input type="checkbox"/> decrease.
<input type="checkbox"/> Yes	<input type="checkbox"/> No	2. Is the application submitted as a result of a Division Order? DO #
<input type="checkbox"/> Yes	<input type="checkbox"/> No	3. Does application include operations outside a previously identified Cumulative Hydrologic Impact Area?
<input type="checkbox"/> Yes	<input type="checkbox"/> No	4. Does application include operations in hydrologic basins other than as currently approved?
<input type="checkbox"/> Yes	<input type="checkbox"/> No	5. Does application result from cancellation, reduction or increase of insurance or reclamation bond?
<input type="checkbox"/> Yes	<input type="checkbox"/> No	6. Does the application require or include public notice/publication?
<input type="checkbox"/> Yes	<input type="checkbox"/> No	7. Does the application require or include ownership, control, right-of-entry, or compliance information?
<input type="checkbox"/> Yes	<input type="checkbox"/> No	8. Is proposed activity within 100 feet of a public road or cemetery or 300 feet of an occupied dwelling?
<input type="checkbox"/> Yes	<input type="checkbox"/> No	9. Is the application submitted as a result of a Violation?
<input type="checkbox"/> Yes	<input type="checkbox"/> No	10. Is the application submitted as a result of other laws or regulations or policies? Explain:
<input type="checkbox"/> Yes	<input type="checkbox"/> No	11. Does the application affect the surface landowner or change the post mining land use?
<input type="checkbox"/> Yes	<input type="checkbox"/> No	12. Does the application require or include underground design or mine sequence and timing? (Modification of R2P2?)
<input type="checkbox"/> Yes	<input type="checkbox"/> No	13. Does the application require or include collection and reporting of any baseline information?
<input type="checkbox"/> Yes	<input type="checkbox"/> No	14. Could the application have any effect on wildlife or vegetation outside the current disturbed area?
<input type="checkbox"/> Yes	<input type="checkbox"/> No	15. Does application require or include soil removal, storage or placement?
<input type="checkbox"/> Yes	<input type="checkbox"/> No	16. Does the application require or include vegetation monitoring, removal or revegetation activities?
<input type="checkbox"/> Yes	<input type="checkbox"/> No	17. Does the application require or include construction, modification, or removal of surface facilities?
<input type="checkbox"/> Yes	<input type="checkbox"/> No	18. Does the application require or include water monitoring, sediment or drainage control measures?
<input type="checkbox"/> Yes	<input type="checkbox"/> No	19. Does the application require or include certified designs, maps, or calculations?
<input type="checkbox"/> Yes	<input type="checkbox"/> No	20. Does the application require or include subsidence control or monitoring?
<input type="checkbox"/> Yes	<input type="checkbox"/> No	21. Have reclamation costs for bonding been provided for?
<input type="checkbox"/> Yes	<input type="checkbox"/> No	22. Does application involve a perennial stream, a stream buffer zone or discharges to a stream?
<input type="checkbox"/> Yes	<input type="checkbox"/> No	23. Does the application affect permits issued by other agencies or permits issued to other entities?

**X Attach 1 complete digital copy of the application and maps.**

I hereby certify that I am a responsible official of the applicant and that the information contained in this application is true and correct to the best of my information and belief in all respects with the laws of Utah in reference to commitments, undertakings, and obligations, herein.

  
 Signed - Name - Position - Date Karin Madsen - Engineering Tech - 9-24-18

Subscribed and sworn to before me this 24<sup>th</sup> day of September, 2018.

  
 Notary Public  
 My Commission Expires: March 27, 2021  
 Attest: STATE OF Utah COUNTY OF Carbon



**LINDA KERNS**  
 NOTARY PUBLIC  
 STATE OF UTAH  
 COMMISSION # 693708  
 COMM. EXP. 03-27-2021

Received by Oil, Gas & Mining
ASSIGNED TRACKING NUMBER

## Application for Permit Processing Detailed Schedule of Changes to the MRP

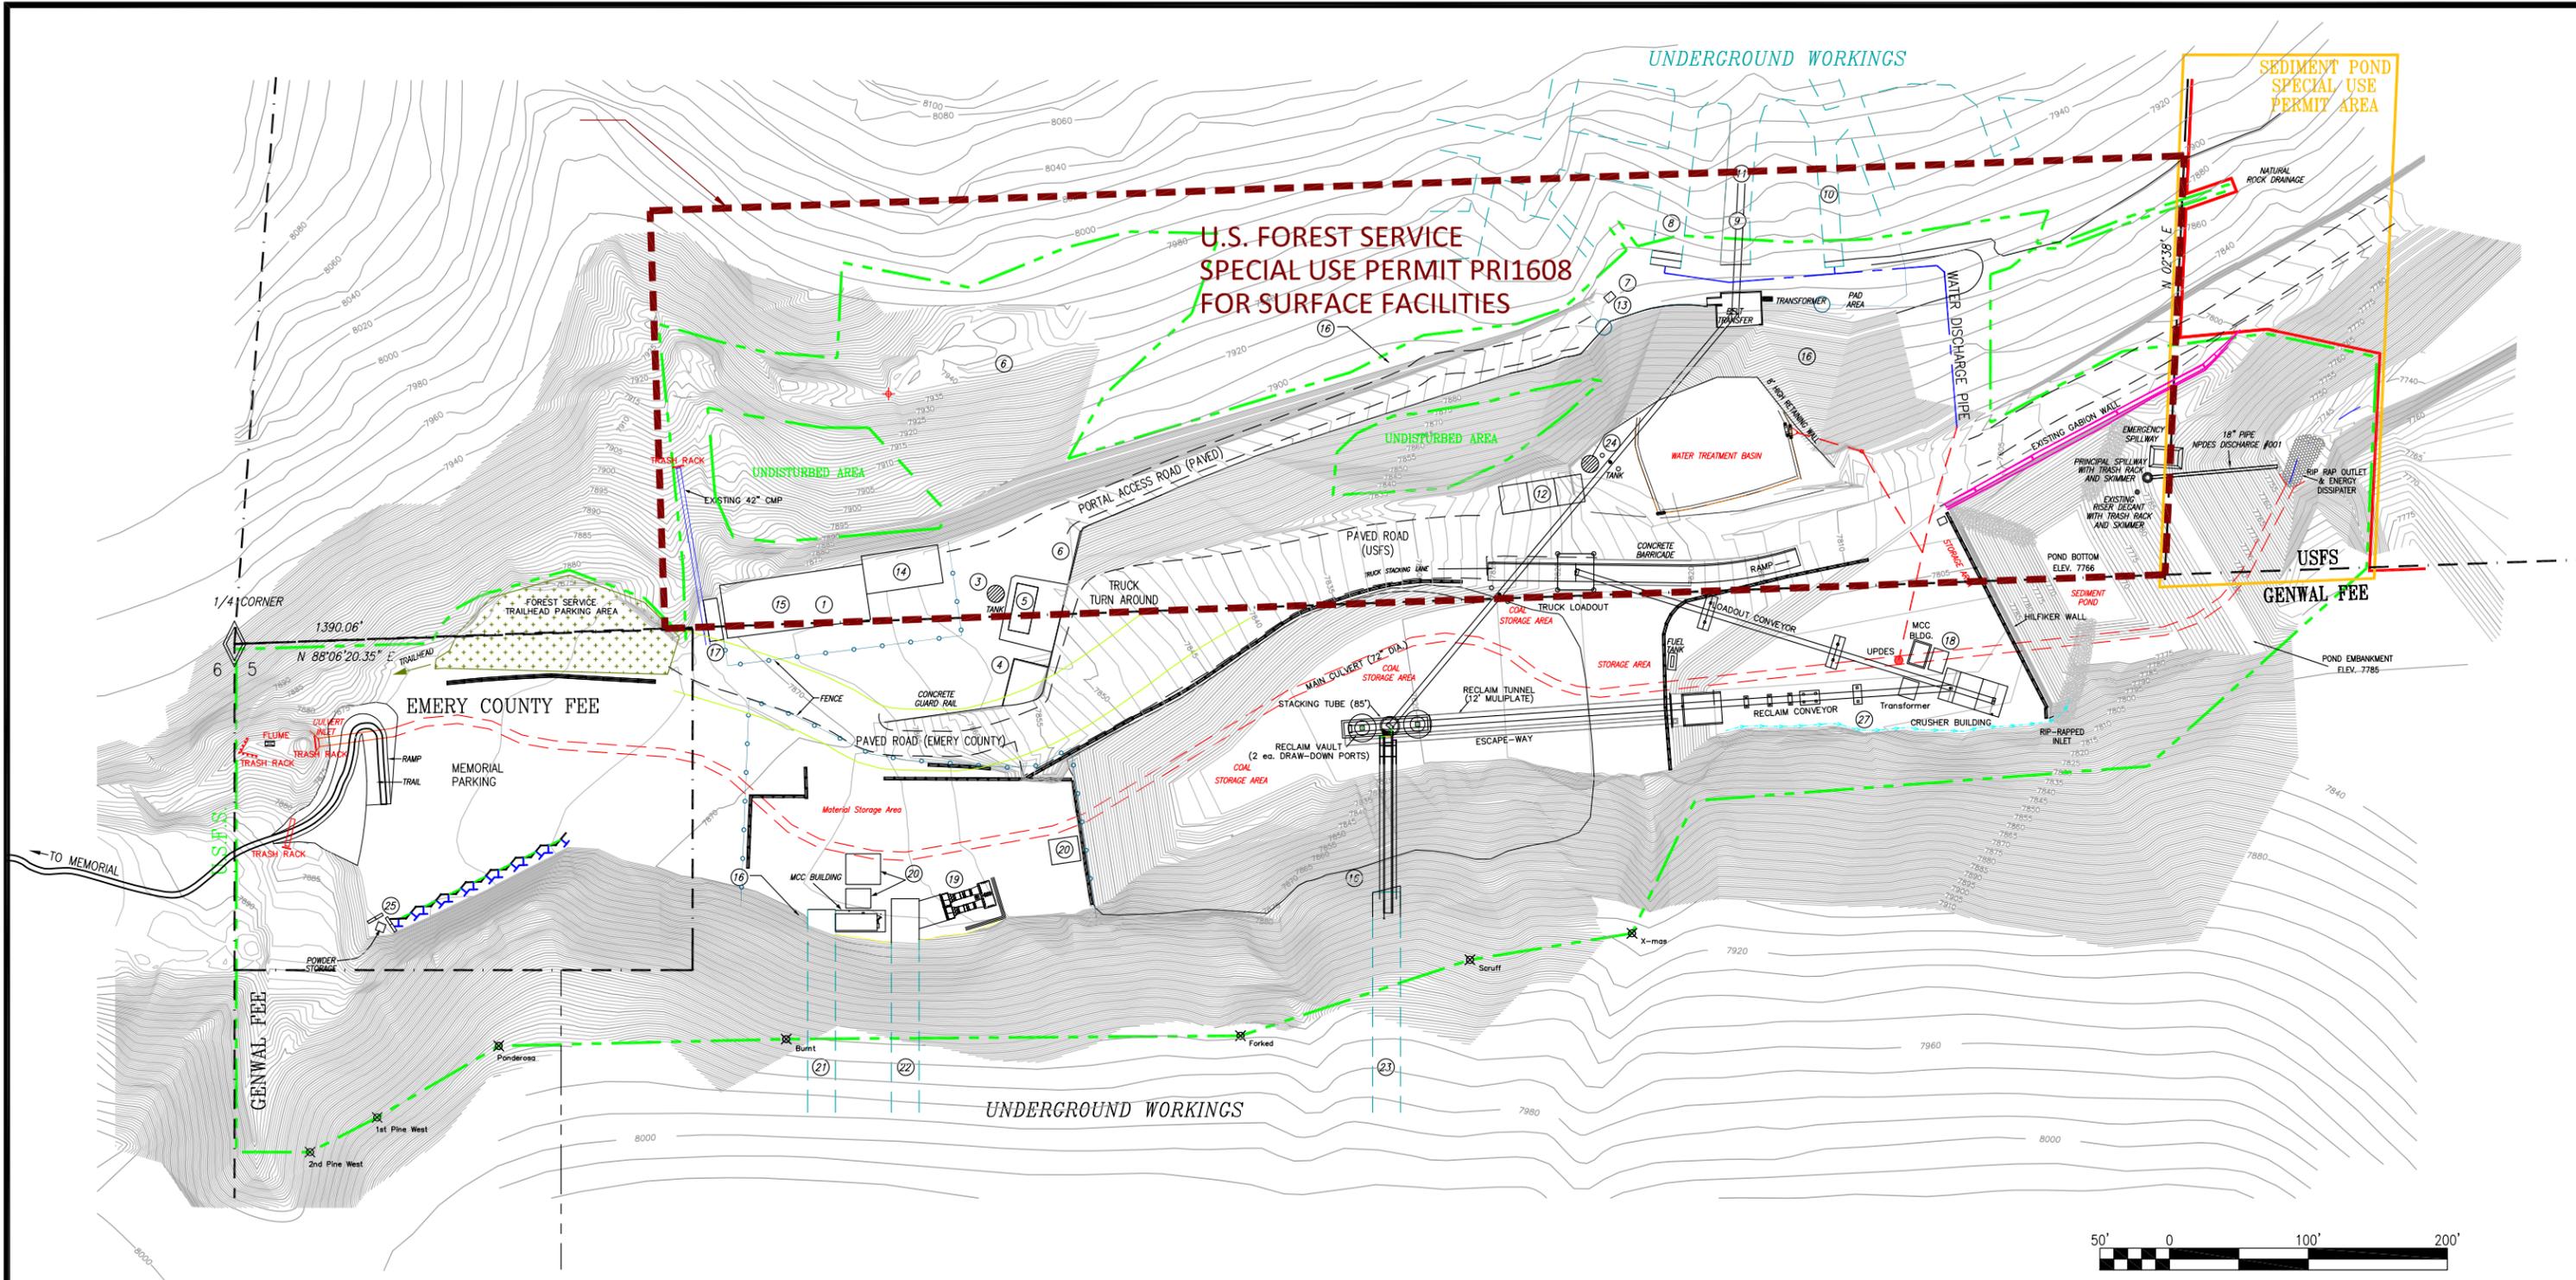
C18-004 Trash Rack As-Built	Permit Number: ACT/015/032
	Mine: Crandall Canyon Mine
	Permittee: Genwal Resources, Inc.

Provide a detailed listing of all changes to the mining and reclamation plan which will be required as a result of this proposed permit application. Individually list all maps and drawings which are to be added, replaced, or removed from the plan. Include changes of the table of contents, section of the plan, pages, or other information as needed to specifically locate, identify and revise the existing mining and reclamation plan. **Include page, section and drawing numbers as part of the description.**

			DESCRIPTION OF MAP, TEXT, OR MATERIALS TO BE CHANGED
<input type="checkbox"/> ADD	<input type="checkbox"/> REPLACE	<input type="checkbox"/> REMOVE	Update Plate 5-3
<input type="checkbox"/> ADD	<input type="checkbox"/> REPLACE	<input type="checkbox"/> REMOVE	
<input type="checkbox"/> ADD	<input type="checkbox"/> REPLACE	<input type="checkbox"/> REMOVE	
Any other specific or special instructions required for insertion of this proposal into the Mining and Reclamation Plan?

G:\Current Drawings\MRP Maps\Crandall Canyon\2015 Mid-Term Review\Task 5-3 REV 22.dwg, 11x17 Surface Facilities, 7/18/2018 3:16:41 PM



**LEGEND:**

SEDIMENT POND (SPECIAL USE PERMIT AREA)	
EXTENT OF DISTURBANCE	
10' CONTOUR	
JERSEY BARRIERS	
RE-ESTABLISHED USFS ROAD (DOUBLE-LANE)	
SAFETY BARRIERS	
FENCING	

**FACILITY LEGEND:**

1. Shop	14. New Warehouse and Office Building
2. Ventilation Fan	15. 4500 Gallon Culinary Water Tank
3. Rockdust Silo	16. Shotcrete
4. Concrete Dumpster Pad	17. Parts Shed
5. Power Center	18. Portable Shed
6. Power Pole	19. Ventilation Fan
7. Offices & Bathhouse (u'grd)	20. Material Storage Sheds
8. Intake Portal	21. Intake Portal
9. Belt Portal	22. Return Portal
10. Fan Portal	23. Belt Portal
11. Mine Belt	24. Mag Tank
12. Iron Treatment Shed	25. Powder Storage
13. Visual Disconnect	26. Cap Storage
	27. Concrete Ditch

T. 16 S., R. 7 E., SLBM



GENWAL<sup>™</sup>  
RESOURCES, INC.  
P.O. Box 1077, 794 North "C" Canyon Rd, Price Utah  
Telephone: (435) 888-4000

**CRANDALL CANYON MINE  
SURFACE FACILITIES**

REV: 22	ACAD: 5-3 REV22
DATE: 7-18-2018	BY: PJJ
SCALE: AS SHOWN	PLATE #: 5-3