

C/015/032 Incoming

#5742



P.O. Box 910, East Carbon, Utah 84520 794 North "C" Canyon Rd, East Carbon, Utah 84520
Telephone (435) 888-4000 Fax (435) 888-4002

Utah Division of Oil, Gas & Mining
Utah Coal Program
1594 West North Temple, Suite 1210
P.O. Box 145801
Salt Lake City, UT 84114-5801

September 24, 2018

RECEIVED
NOV 05 2018
DIV. OF OIL, GAS & MINING

Attn: Daron Haddock
Permit Supervisor

Re: Genwal Resources, Inc. C/015/032
Trail Mountain Wildfire Drainage As-Built

Dear Mr. Haddock,


Attached you will find 2 PE stamped clean copies of the As-Built Map (Facilities Plate 5-3) showing the upgraded trash racks to be incorporated into the Crandall Canyon MRP.

If you have any questions regarding this submittal, please feel free to call me directly at: 435-888-4000.

A handwritten signature in blue ink, appearing to read "Karin Madsen", written over a horizontal line.

Karin Madsen
Environmental Engineering Technician
Genwal Resources, Inc.

G:\Current Drawings\MP Maps\Crandall Canyon\2015 Mid-Term Review\Task 5190 - 3rd Submittal\Plate 5-3 REV 22.dwg, 11x17 Surface Facilities, 7/18/2018 3:16:41 PM

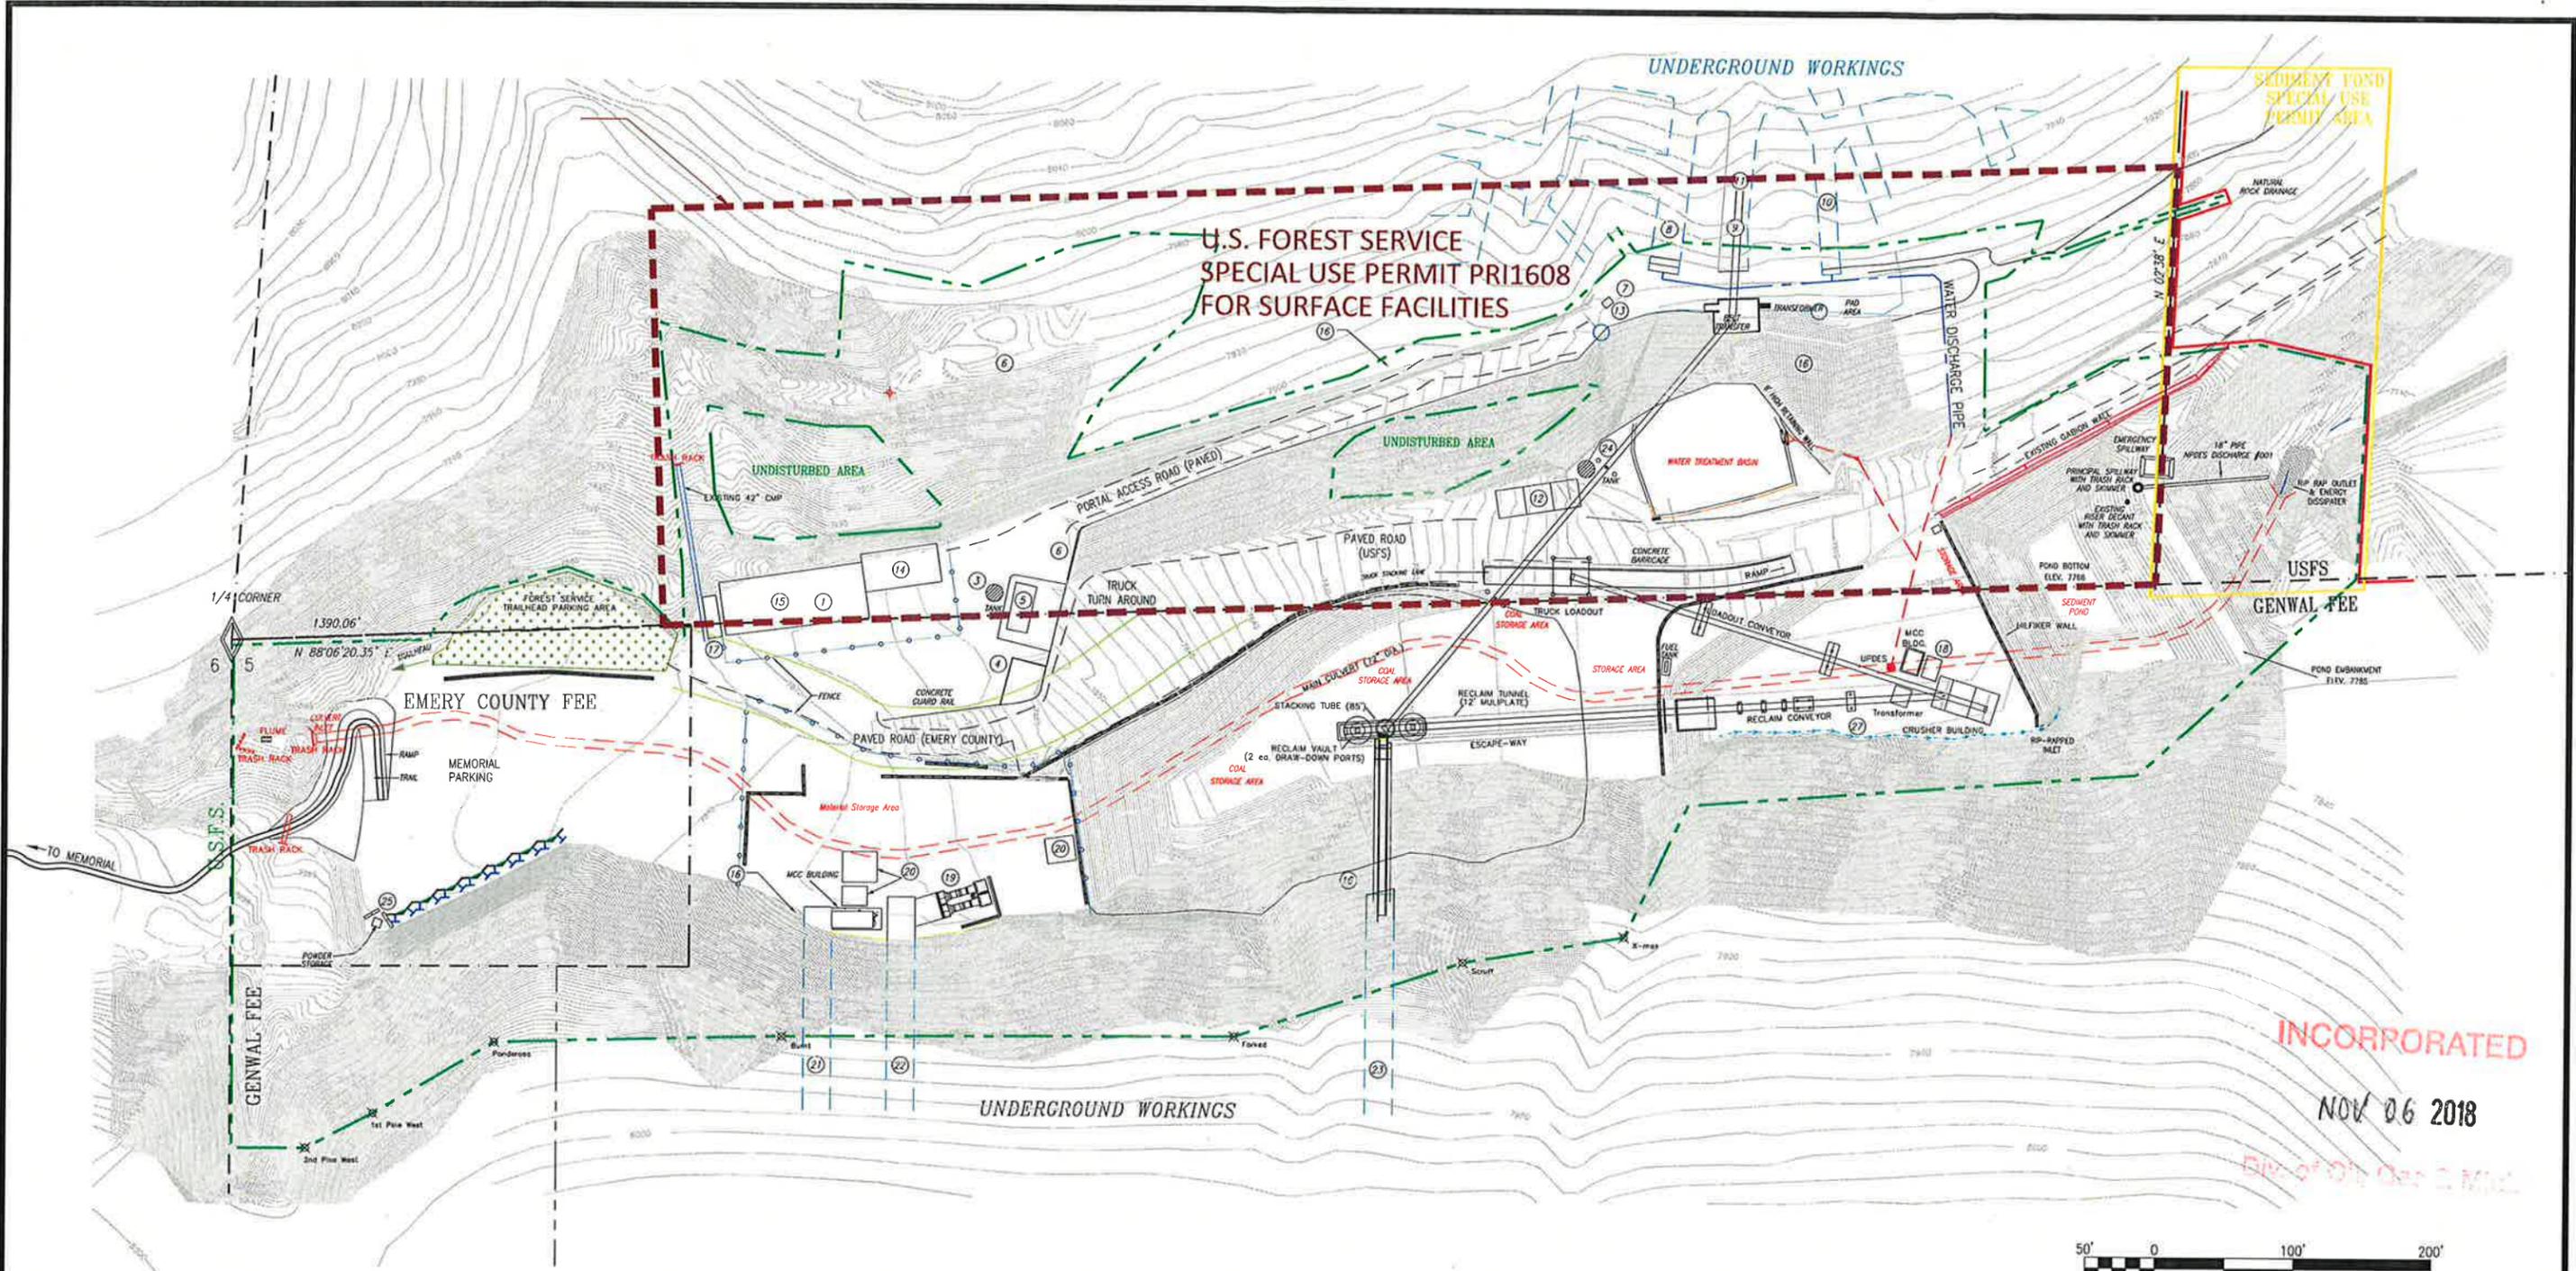

INCORPORATED
NOV 06 2018
Div. of Oil, Gas & Min.



LEGEND:

SEDIMENT POND (SPECIAL USE PERMIT AREA)	
EXTENT OF DISTURBANCE	
10' CONTOUR	
JERSEY BARRIERS	
RE-ESTABLISHED USFS ROAD (DOUBLE-LANE)	
SAFETY BARRIERS	
FENCING	

- FACILITY LEGEND:**
- | | |
|--------------------------------|---------------------------------------|
| 1. Shop | 14. New Warehouse and Office Building |
| 2. Ventilation Fan | 15. 4500 Gallon Culinary Water Tank |
| 3. Rockdust Silo | 16. Shotcrete |
| 4. Concrete Dumpster Pad | 17. Parts Shed |
| 5. Power Center | 18. Portable Shed |
| 6. Power Pole | 19. Ventilation Fan |
| 7. Offices & Bathhouse (u'grd) | 20. Material Storage Sheds |
| 8. Intake Portal | 21. Intake Portal |
| 9. Belt Portal | 22. Return Portal |
| 10. Fan Portal | 23. Belt Portal |
| 11. Mine Belt | 24. Mag Tank |
| 12. Iron Treatment Shed | 25. Powder Storage |
| 13. Visual Disconnect | 26. Cap Storage |
| | 27. Concrete Ditch |



GENVAL™
RESOURCES, INC.
P.O. Box 1077, 794 North "C" Canyon Rd, Price Utah
Telephone: (435) 888-4000

**CRANDALL CANYON MINE
SURFACE FACILITIES**

REV: 22	ACAD: 5-3 REV22
DATE: 7-18-2018	BY: PJJ
SCALE: AS SHOWN	PLATE #: 5-3

T. 16 S., R. 7 E., SLBM