



## Alton Coal Development, LLC

463 North 100 West, Suite 1

Cedar City, Utah 84720

Phone (435) 867-5331 • Fax (435) 867-1192

---

May 2, 2016

Daron R. Haddock  
Coal Program Manager  
Oil, Gas & Mining  
1594 West North Temple, Suite 1210  
Salt Lake City, UT 84114-5801

Subject: **Revised Drawing 5-3B submittal for NOV 21165 Mod 3, Alton Coal Development, LLC, Coal Hollow Mine, C/025/0005**

Dear Mr. Haddock,

In response to NOV 21165 Mod 3, Drawing 5-3B has been revised to reflect the current design of surface facilities at the Underground Mine. Modifications have been made to include culvert identifications.

Changes to the MRP associated with this amendment have been uploaded to the DOGM's server for review. PDF versions of the drawing are not certified. Upon approval, 2 (two) clean hard copies of the certified drawings for insertion into the MRP will be submitted. Please do not hesitate to contact me if you have any questions 435-691-1551.

Sincerely

B. Kirk Nicholes  
Environmental Specialist

## APPLICATION FOR COAL PERMIT PROCESSING

Permit Change  New Permit  Renewal  Exploration  Bond Release  Transfer

Permittee: Alton Coal Development, LLC

Mine: Coal Hollow Mine

Permit Number: C/025/0005

Title: Underground Mine Surface Facilities

Description, Include reason for application and timing required to implement:

Addition of new topsoil analysis

**Instructions:** If you answer yes to any of the first eight questions, this application may require Public Notice publication.

- Yes  No 1. Change in the size of the Permit Area? Acres: \_\_\_\_\_ Disturbed Area: \_\_\_\_\_  increase  decrease.
- Yes  No 2. Is the application submitted as a result of a Division Order? DO# \_\_\_\_\_
- Yes  No 3. Does the application include operations outside a previously identified Cumulative Hydrologic Impact Area?
- Yes  No 4. Does the application include operations in hydrologic basins other than as currently approved?
- Yes  No 5. Does the application result from cancellation, reduction or increase of insurance or reclamation bond?
- Yes  No 6. Does the application require or include public notice publication?
- Yes  No 7. Does the application require or include ownership, control, right-of-entry, or compliance information?
- Yes  No 8. Is proposed activity within 100 feet of a public road or cemetery or 300 feet of an occupied dwelling?
- Yes  No 9. Is the application submitted as a result of a Violation? NOV # 21165
- Yes  No 10. Is the application submitted as a result of other laws or regulations or policies?

*Explain:* \_\_\_\_\_

- Yes  No 11. Does the application affect the surface landowner or change the post mining land use?
- Yes  No 12. Does the application require or include underground design or mine sequence and timing? (Modification of R2P2)
- Yes  No 13. Does the application require or include collection and reporting of any baseline information?
- Yes  No 14. Could the application have any effect on wildlife or vegetation outside the current disturbed area?
- Yes  No 15. Does the application require or include soil removal, storage or placement?
- Yes  No 16. Does the application require or include vegetation monitoring, removal or revegetation activities?
- Yes  No 17. Does the application require or include construction, modification, or removal of surface facilities?
- Yes  No 18. Does the application require or include water monitoring, sediment or drainage control measures?
- Yes  No 19. Does the application require or include certified designs, maps or calculation?
- Yes  No 20. Does the application require or include subsidence control or monitoring?
- Yes  No 21. Have reclamation costs for bonding been provided?
- Yes  No 22. Does the application involve a perennial stream, a stream buffer zone or discharges to a stream?
- Yes  No 23. Does the application affect permits issued by other agencies or permits issued to other entities?
- Yes  No 24. Does the application include confidential information and is it clearly marked and separated in the plan?

**Please attach three (3) review copies of the application. If the mine is on or adjacent to Forest Service land please submit four (4) copies, thank you.** (These numbers include a copy for the Price Field Office)


I hereby certify that I am a responsible official of the applicant and that the information contained in this application is true and correct to the best of my information and belief in all respects with the laws of Utah in reference to commitments, undertakings, and obligations, herein.

B. Kirk Nicholes      Resident Agent      03/31/2016      *B. Kirk Nicholes*  
 Print Name                      Position                      Date                      Signature (Right-click above choose certify then have notary sign below)

Subscribed and sworn to before me this 31<sup>st</sup> day of March, 2016



Notary Public: *Winston Young*, state of Utah.

My commission Expires: 6/4/02/2018 }  
 Commission Number: 671357 } ss:  
 Address: 444 S Main St # B2 }  
 City: Cedar City State: UT Zip: 84720 }

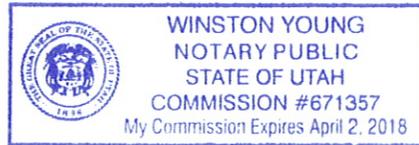

<p><b>For Office Use Only:</b></p>	<p><b>Assigned Tracking Number:</b></p>	<p><b>Received by Oil, Gas &amp; Mining</b></p>
------------------------------------	---	---



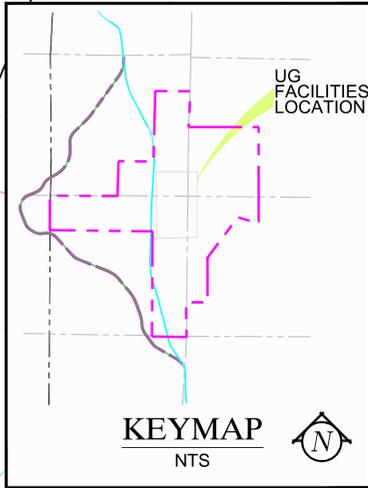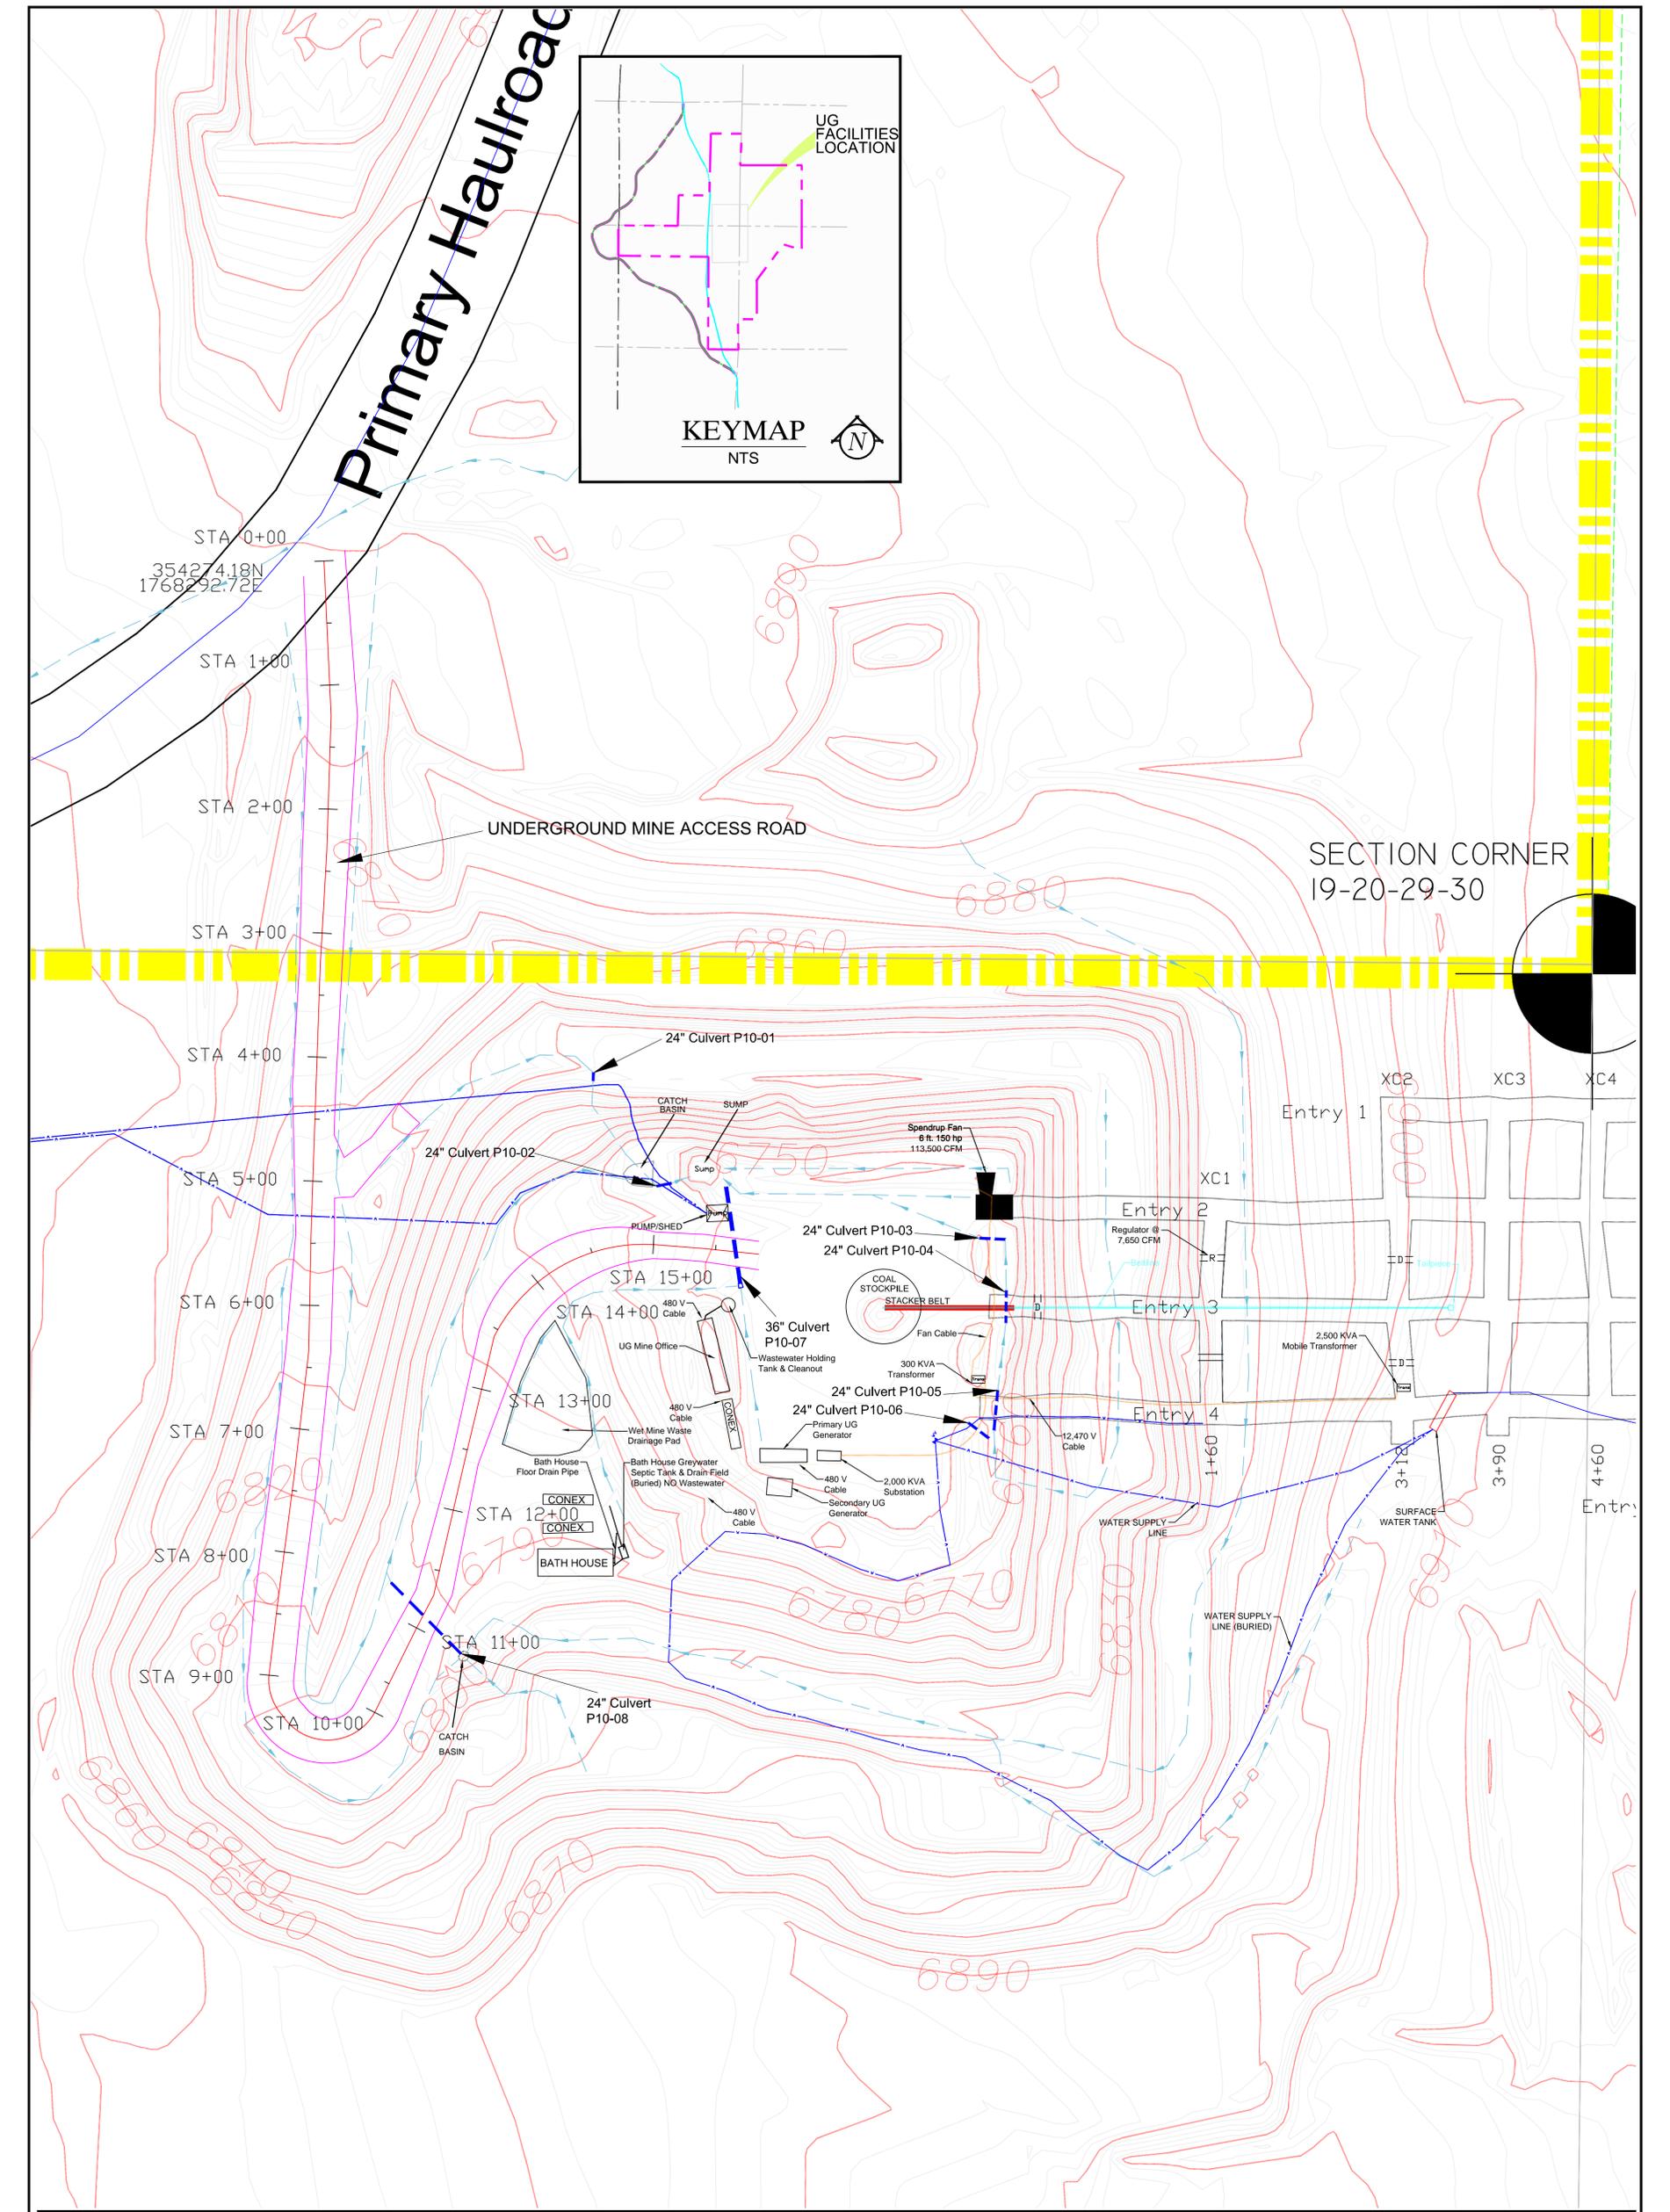

SECTION CORNER  
19-20-29-30

**LEGEND:**

- PERMIT BOUNDARY
- PRIVATE COAL OWNERSHIP
- SECTION LINE
- EXISTING DRAINAGE PATH
- WATER SUPPLY/DISCHARGE LINE

DRAWN BY: K. NICHOLAS	CHECKED BY: LWJ
DRAWING: 5-3B	DATE: 06/13/11
JOB NUMBER: 1400	SCALE: 1" = 60'
	SHEET

REVISIONS	
DATE:	BY:
6/13/11	KN/JKJR
09/28/15	KN
01/31/16	KN
03/31/16	AC
04/20/16	AC
05/02/16	AC

<b>UNDERGROUND FACILITIES &amp; STRUCTURES</b>	
<b>AS-BUILT LAYOUT</b>	
COAL HOLLOW PROJECT ALTON, UTAH	
<b>DRAWING: 5-3B</b>	

UTAH REGISTERED  
PROFESSIONAL ENGINEER  
#154168  
DAN W. GUY

Alton Coal Development  
**Coal Hollow Project**

463 North 100 West, Suite 1  
Cedar City, Utah 84721  
Phone (435) 867-5331  
Fax (435) 867-1192