



Alton Coal Development, LLC

463 North 100 West, Suite 1
Cedar City, Utah 84720
Phone (435) 867-5311 Fax (435) 867-1192

June 15, 2018

Daron R. Haddock
Coal Program Manager
Oil, Gas & Mining
1594 West North Temple, Suite 1210
Salt Lake City, UT 84114-5801

Subject: Redesign Pit 10 Sump As-Built, Alton Coal Development, LLC, Coal Hollow Mine, Kane County, Utah, C/025/0005

Dear Mr. Haddock,


Alton Coal Development, LLC (ACD) is submitting the attached update for Drawing 5-3B. The as-built sump sum has a capacity of 1.90 Acre-ft of water.

Changes to the MRP associated with this amendment have been uploaded to the DOGM's server for review. Upon approval, 2 (two) clean hard copies of the certified drawing for insertion into the MRP will be submitted. Please do not hesitate to contact me if you have any questions 435-691-1551.

Sincerely

B. Kirk Nicholes

Environmental Specialist

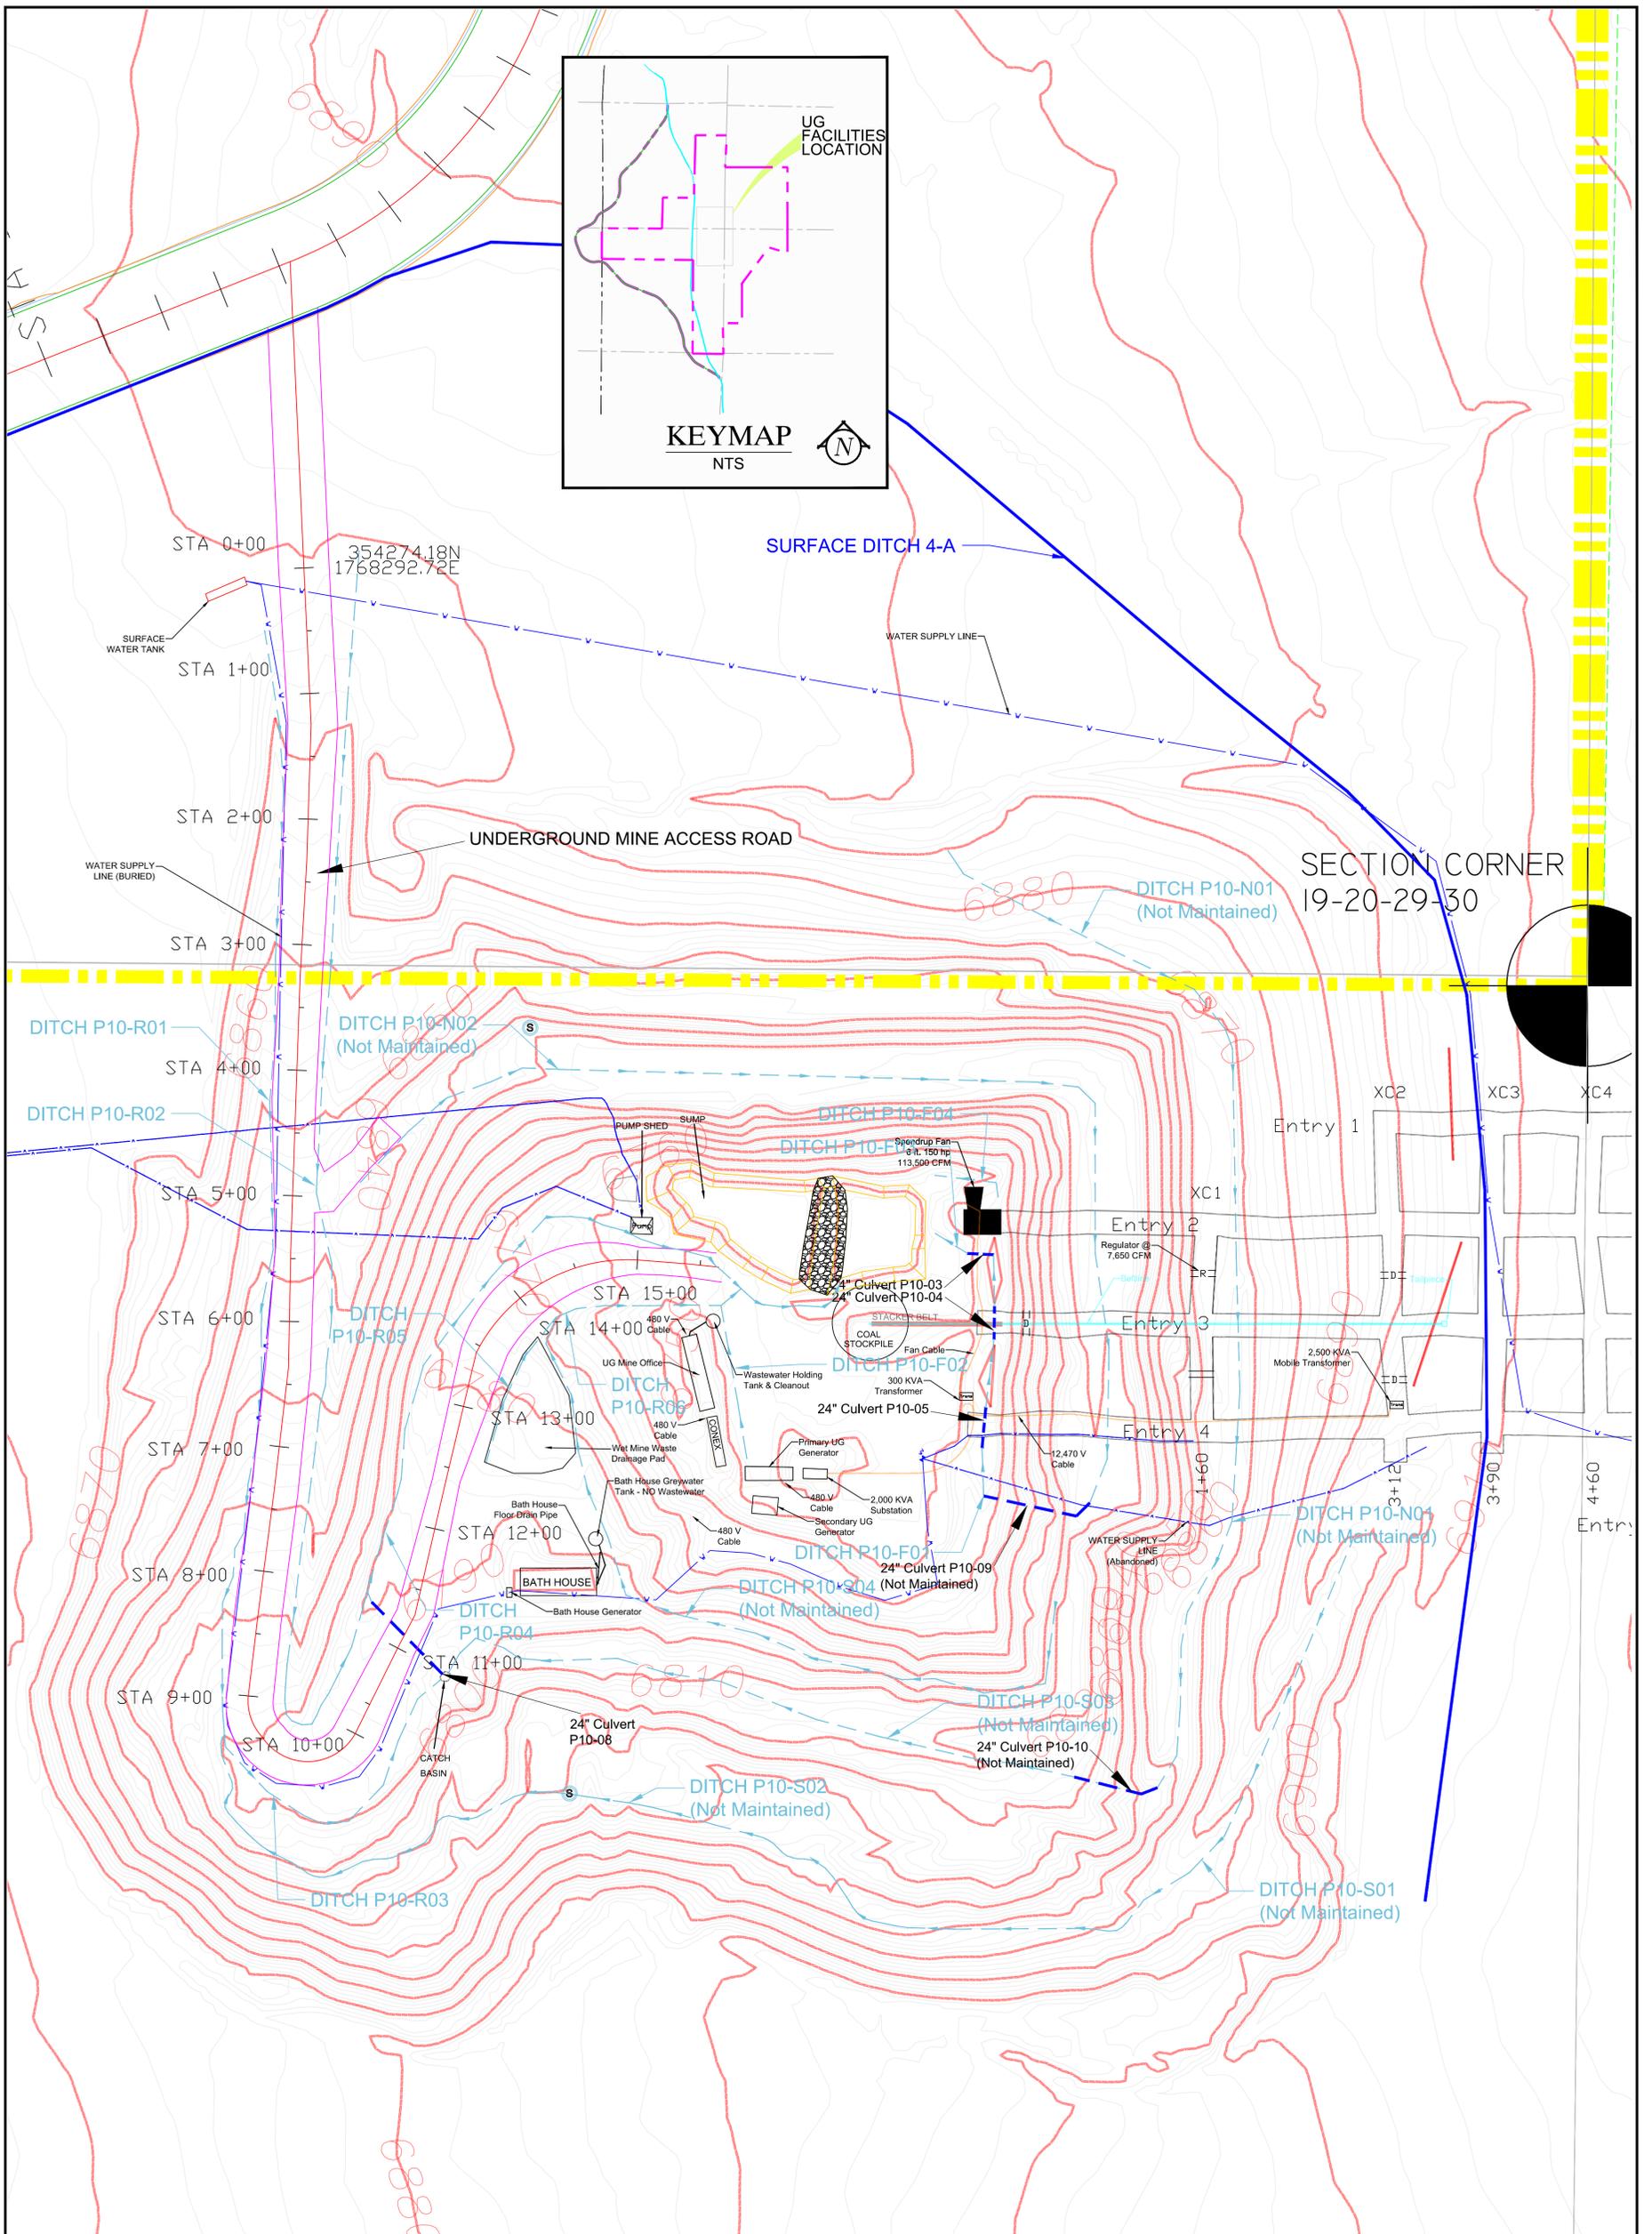

LEGEND:


- PERMIT BOUNDARY
- PRIVATE COAL OWNERSHIP
- SECTION LINE
- EXISTING DRAINAGE PATH
- WATER SUPPLY/DISCHARGE LINE
- o OBSERVED INTERMITTENT SEEP LOCATION

DRAWN BY: K. NICHOLES	CHECKED BY: LWJ
DRAWING: 5-3B	DATE: 06/13/11
	SCALE: 1" = 60'
JOB NUMBER: 1400	SHEET

REVISIONS	
DATE:	BY:
01/31/16	KN
03/31/16	AC
04/20/16	AC
05/02/16	AC
06/02/16	AC
11/30/17	AC
6/15/18	AC

UNDERGROUND FACILITIES & STRUCTURES	
AS-BUILT LAYOUT	
COAL HOLLOW PROJECT ALTON, UTAH	
DRAWING: 5-3B	



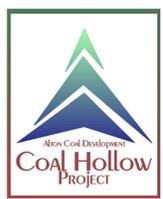

463 North 100 West, Suite 1
Cedar City, Utah 84721
Phone (435) 867-5331
Fax (435) 867-1192