



Alton Coal Development, LLC

463 North 100 West, Suite 1
Cedar City, Utah 84720
Phone (435) 867-5311 Fax (435) 867-1192

C/025/005 Incoming

#5694

June 15, 2018

Daron R. Haddock
Coal Program Manager
Oil, Gas & Mining
1594 West North Temple, Suite 1210
Salt Lake City, UT 84114-5801

Subject: **Redesign Pit 10 Sump As-Built, Alton Coal Development, LLC, Coal Hollow Mine, Kane County, Utah, C/025/0005**

Dear Mr. Haddock,

Alton Coal Development, LLC (ACD) is submitting the attached update for Drawing 5-3B. The as-built sump sum has a capacity of 1.90 Acre-ft of water.

Changes to the MRP associated with this amendment have been uploaded to the DOGM's server for review. Upon approval, 2 (two) clean hard copies of the certified drawing for insertion into the MRP will be submitted. Please do not hesitate to contact me if you have any questions 435-691-1551.

Sincerely

A handwritten signature in black ink, appearing to read "B. Kirk Nicholes".

B. Kirk Nicholes
Environmental Specialist

RECEIVED

JUL 19 2018

DIV. OF OIL, GAS & MINING

APPLICATION FOR COAL PERMIT PROCESSING

Permit Change New Permit Renewal Exploration Bond Release Transfer

Permittee: Alton Coal Development, LLC
Mine: Coal Hollow Mine
Title: As-built Pit 10 Sump

Permit Number: C/025/0005

Description, Include reason for application and timing required to implement:

Instructions: If you answer yes to any of the first eight questions, this application may require Public Notice publication.

- | | | |
|------------------------------|--|---|
| <input type="checkbox"/> Yes | <input checked="" type="checkbox"/> No | 1. Change in the size of the Permit Area? Acres: _____ Disturbed Area: _____ <input type="checkbox"/> increase <input type="checkbox"/> decrease. |
| <input type="checkbox"/> Yes | <input checked="" type="checkbox"/> No | 2. Is the application submitted as a result of a Division Order? DO# _____ |
| <input type="checkbox"/> Yes | <input checked="" type="checkbox"/> No | 3. Does the application include operations outside a previously identified Cumulative Hydrologic Impact Area? |
| <input type="checkbox"/> Yes | <input checked="" type="checkbox"/> No | 4. Does the application include operations in hydrologic basins other than as currently approved? |
| <input type="checkbox"/> Yes | <input checked="" type="checkbox"/> No | 5. Does the application result from cancellation, reduction or increase of insurance or reclamation bond? |
| <input type="checkbox"/> Yes | <input checked="" type="checkbox"/> No | 6. Does the application require or include public notice publication? |
| <input type="checkbox"/> Yes | <input checked="" type="checkbox"/> No | 7. Does the application require or include ownership, control, right-of-entry, or compliance information? |
| <input type="checkbox"/> Yes | <input checked="" type="checkbox"/> No | 8. Is proposed activity within 100 feet of a public road or cemetery or 300 feet of an occupied dwelling? |
| <input type="checkbox"/> Yes | <input checked="" type="checkbox"/> No | 9. Is the application submitted as a result of a Violation? NOV # _____ |
| <input type="checkbox"/> Yes | <input checked="" type="checkbox"/> No | 10. Is the application submitted as a result of other laws or regulations or policies?
<i>Explain:</i> _____ |
-
- | | | |
|---|--|--|
| <input type="checkbox"/> Yes | <input checked="" type="checkbox"/> No | 11. Does the application affect the surface landowner or change the post mining land use? |
| <input type="checkbox"/> Yes | <input checked="" type="checkbox"/> No | 12. Does the application require or include underground design or mine sequence and timing? (Modification of R2P2) |
| <input type="checkbox"/> Yes | <input checked="" type="checkbox"/> No | 13. Does the application require or include collection and reporting of any baseline information? |
| <input type="checkbox"/> Yes | <input checked="" type="checkbox"/> No | 14. Could the application have any effect on wildlife or vegetation outside the current disturbed area? |
| <input type="checkbox"/> Yes | <input checked="" type="checkbox"/> No | 15. Does the application require or include soil removal, storage or placement? |
| <input type="checkbox"/> Yes | <input checked="" type="checkbox"/> No | 16. Does the application require or include vegetation monitoring, removal or revegetation activities? |
| <input type="checkbox"/> Yes | <input checked="" type="checkbox"/> No | 17. Does the application require or include construction, modification, or removal of surface facilities? |
| <input checked="" type="checkbox"/> Yes | <input type="checkbox"/> No | 18. Does the application require or include water monitoring, sediment or drainage control measures? |
| <input checked="" type="checkbox"/> Yes | <input type="checkbox"/> No | 19. Does the application require or include certified designs, maps or calculation? |
| <input type="checkbox"/> Yes | <input checked="" type="checkbox"/> No | 20. Does the application require or include subsidence control or monitoring? |
| <input type="checkbox"/> Yes | <input checked="" type="checkbox"/> No | 21. Have reclamation costs for bonding been provided? |
| <input type="checkbox"/> Yes | <input checked="" type="checkbox"/> No | 22. Does the application involve a perennial stream, a stream buffer zone or discharges to a stream? |
| <input type="checkbox"/> Yes | <input checked="" type="checkbox"/> No | 23. Does the application affect permits issued by other agencies or permits issued to other entities? |
| <input type="checkbox"/> Yes | <input checked="" type="checkbox"/> No | 24. Does the application include confidential information and is it clearly marked and separated in the plan? |

Please attach three (3) review copies of the application. If the mine is on or adjacent to Forest Service land please submit four (4) copies, thank you. (These numbers include a copy for the Price Field Office)


I hereby certify that I am a responsible official of the applicant and that the information contained in this application is true and correct to the best of my information and belief in all respects with the laws of Utah in reference to commitments, undertakings, and obligations, herein.

<u>B. Kirk Nicholes</u>	<u>Environmental Specialist</u>	<u>06/15/2018</u>	<u>B. Kirk Nicholes</u>
Print Name	Position	Date	Signature (Right-click above choose certify then have notary sign below)



Subscribed and sworn to before me this 15 day of June, 2018

Notary Public: Wendy Smith, state of Utah.

My commission Expires: 8-21-2018 }
 Commission Number: 679017 } ss:
 Address: 377 n main }
 City: Cedar City State: UT Zip: 84721 }

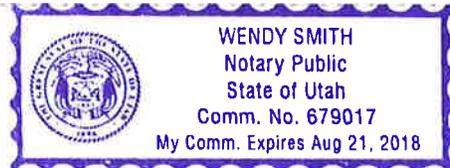

For Office Use Only:	Assigned Tracking Number:	Received by Oil, Gas & Mining RECEIVED JUL 19 2018 DIV. OF OIL, GAS & MINING
-----------------------------	----------------------------------	--

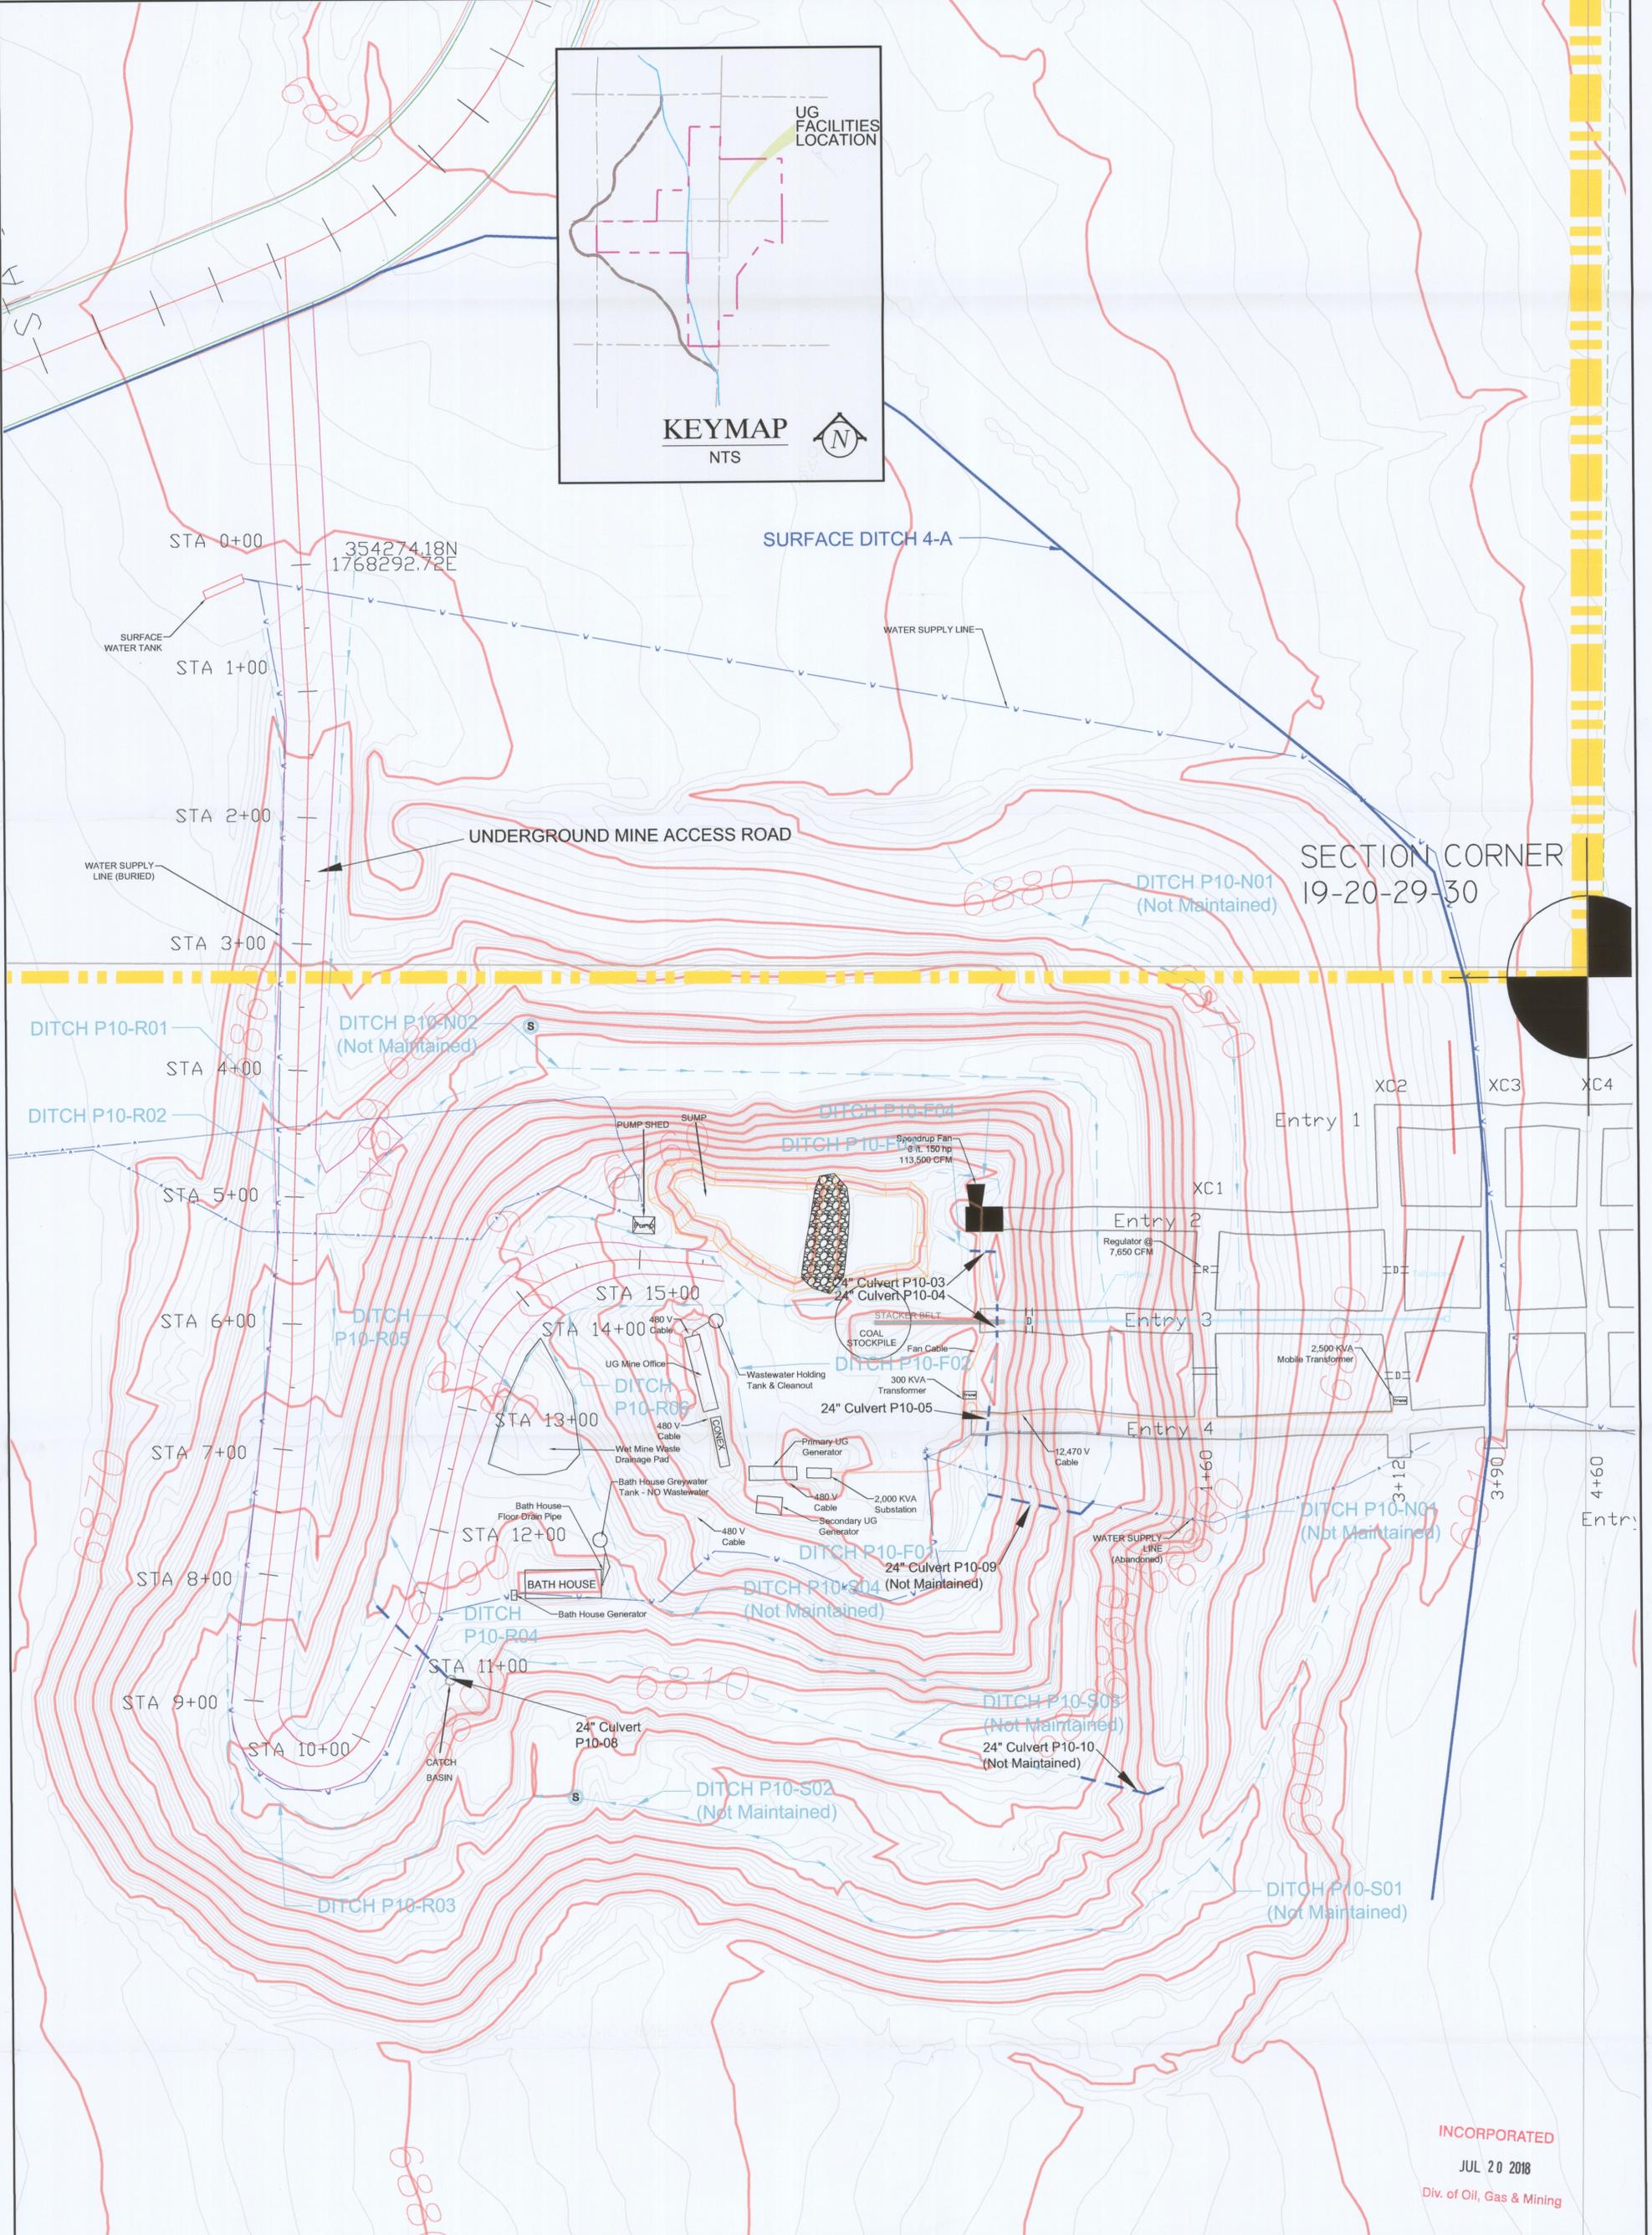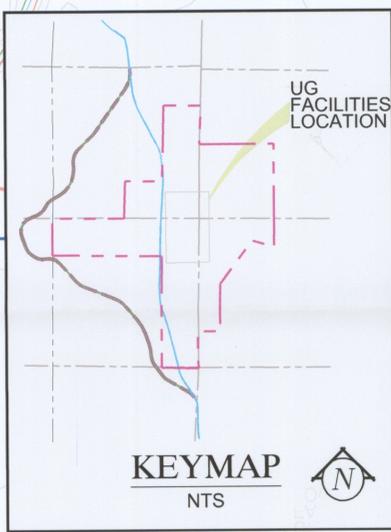

SECTION CORNER
19-20-29-30

INCORPORATED
JUL 20 2018
Div. of Oil, Gas & Mining

LEGEND:

- PERMIT BOUNDARY
- PRIVATE COAL OWNERSHIP
- SECTION LINE
- EXISTING DRAINAGE PATH
- WATER SUPPLY/DISCHARGE LINE
- OBSERVED INTERMITTENT SEEP LOCATION

DRAWN BY: K. NICHOLAS	CHECKED BY: LWJ
DRAWING: 5-3B	DATE: 06/13/11
	SCALE: 1" = 60'
JOB NUMBER: 1400	SHEET

REVISIONS	
DATE:	BY:
01/31/16	KN
03/31/16	AC
04/20/16	AC
05/02/16	AC
06/02/16	AC
11/30/17	AC
6/15/18	AC

UNDERGROUND FACILITIES & STRUCTURES

AS-BUILT LAYOUT

COAL HOLLOW PROJECT
ALTON, UTAH

DRAWING: 5-3B



Alton Coal Development
Coal Hollow Project

463 North 100 West, Suite 1
Cedar City, Utah 84721
Phone (435) 867-5331
Fax (435) 867-1192