

**CF** Canyon Fuel Company, LLC  
SUFCO Mine  
397 South 800 West  
Salina, UT 84654  
(435) 286-4880 Fax: (435) 286-4499

ORIGINAL

INCOMING  
C0410002

October 27, 2003

Permit Supervisor  
Utah Coal Regulatory Program  
1594 West North Temple, Suite 1210  
Box 145801  
Salt Lake City, Utah 84114-5801


Re: Minor Modification M&RP Permit Amendment, Abandoned Mining Equipment 2LPE,  
Canyon Fuel Company, LLC, SUFCO Mine C/041/002

Dear Permit Supervisor:

In response to the Division approval letter dated September 9, 2003 requesting upon completion of the storage/abandonment of the pan line sections and tailgate drive, the permittee must provide an "as-built" Figure 7-7, which is certified by a Utah registered professional engineer.

The enclosed eight copies of Figure 7-7 are being submitted to update the SUFCO mine plan. Forms C1 and C2 are included showing changes needed in Chapter 7.

Sincerely,  
CANYON FUEL COMPANY, LLC  
SUFCO Mine

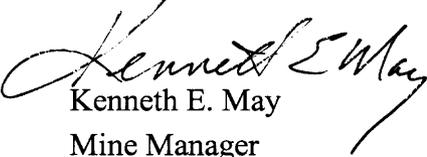  
Kenneth E. May  
Mine Manager

Encl.

KEM/MLD:kb

cc: DOGM Price Office  
DOGM Correspondence File

RECEIVED

OCT 29 2003

DIV. OF OIL, GAS &amp; MINING

# APPLICATION FOR COAL PERMIT PROCESSING

Permit Change  New Permit  Renewal  Exploration  Bond Release  Transfer

**Permittee:** CANYON FUEL COMPANY, LLC

**Mine:** SUFCO MINE

**Permit Number:** C/041/002

**Title:** Abandoned Mining Equipment 2LPE

**Description,** Include reason for application and timing required to implement:

Certified "as-built" Figure 7-7.

**Instructions:** If you answer yes to any of the first eight (gray) questions, this application may require Public Notice publication.

- Yes  No 1. Change in the size of the Permit Area? Acres: \_\_\_\_\_ Disturbed Area: \_\_\_\_\_  increase  decrease.
- Yes  No 2. Is the application submitted as a result of a Division Order? DO# \_\_\_\_\_
- Yes  No 3. Does the application include operations outside a previously identified Cumulative Hydrologic Impact Area?
- Yes  No 4. Does the application include operations in hydrologic basins other than as currently approved?
- Yes  No 5. Does the application result from cancellation, reduction or increase of insurance or reclamation bond?
- Yes  No 6. Does the application require or include public notice publication?
- Yes  No 7. Does the application require or include ownership, control, right-of-entry, or compliance information?
- Yes  No 8. Is proposed activity within 100 feet of a public road or cemetery or 300 feet of an occupied dwelling?
- Yes  No 9. Is the application submitted as a result of a Violation? NOV # \_\_\_\_\_
- Yes  No 10. Is the application submitted as a result of other laws or regulations or policies?

*Explain:* \_\_\_\_\_

- Yes  No 11. Does the application affect the surface landowner or change the post mining land use?
- Yes  No 12. Does the application require or include underground design or mine sequence and timing? (Modification of R2P2)
- Yes  No 13. Does the application require or include collection and reporting of any baseline information?
- Yes  No 14. Could the application have any effect on wildlife or vegetation outside the current disturbed area?
- Yes  No 15. Does the application require or include soil removal, storage or placement?
- Yes  No 16. Does the application require or include vegetation monitoring, removal or revegetation activities?
- Yes  No 17. Does the application require or include construction, modification, or removal of surface facilities?
- Yes  No 18. Does the application require or include water monitoring, sediment or drainage control measures?
- Yes  No 19. Does the application require or include certified designs, maps or calculation?
- Yes  No 20. Does the application require or include subsidence control or monitoring?
- Yes  No 21. Have reclamation costs for bonding been provided?
- Yes  No 22. Does the application involve a perennial stream, a stream buffer zone or discharges to a stream?
- Yes  No 23. Does the application affect permits issued by other agencies or permits issued to other entities?

**Please attach four (4) review copies of the application. If the mine is on or adjacent to Forest Service land please submit five (5) copies, thank you.** (These numbers include a copy for the Price Field Office)

I hereby certify that I am a responsible official of the applicant and that the information contained in this application is true and correct to the best of my information and belief in all respects with the laws of Utah in reference to commitments, undertakings, and obligations, herein.

KENNETH E. MAY, MINE MANAGER  
Print Name


*Kenneth E. May*  
Sign Name, Position, Date

10/27/03

Subscribed and sworn to before me this 27<sup>th</sup> day of October, 2003


*Ella Ruth Wayman*  
Notary Public

My commission Expires: \_\_\_\_\_, 20\_\_\_\_ }  
Attest: State of \_\_\_\_\_ } ss:  
County of \_\_\_\_\_

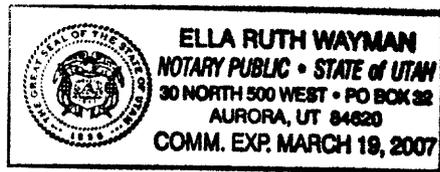

<p><b>For Office Use Only:</b></p>	<p>Assigned Tracking Number:</p>	<p>Received by Oil, Gas &amp; Mining</p> <p style="font-size: 24px; font-weight: bold;">RECEIVED</p> <p style="font-size: 24px; font-weight: bold;">OCT 29 2003</p> <p>DIV. OF OIL, GAS &amp; MINING</p>
------------------------------------	----------------------------------	--



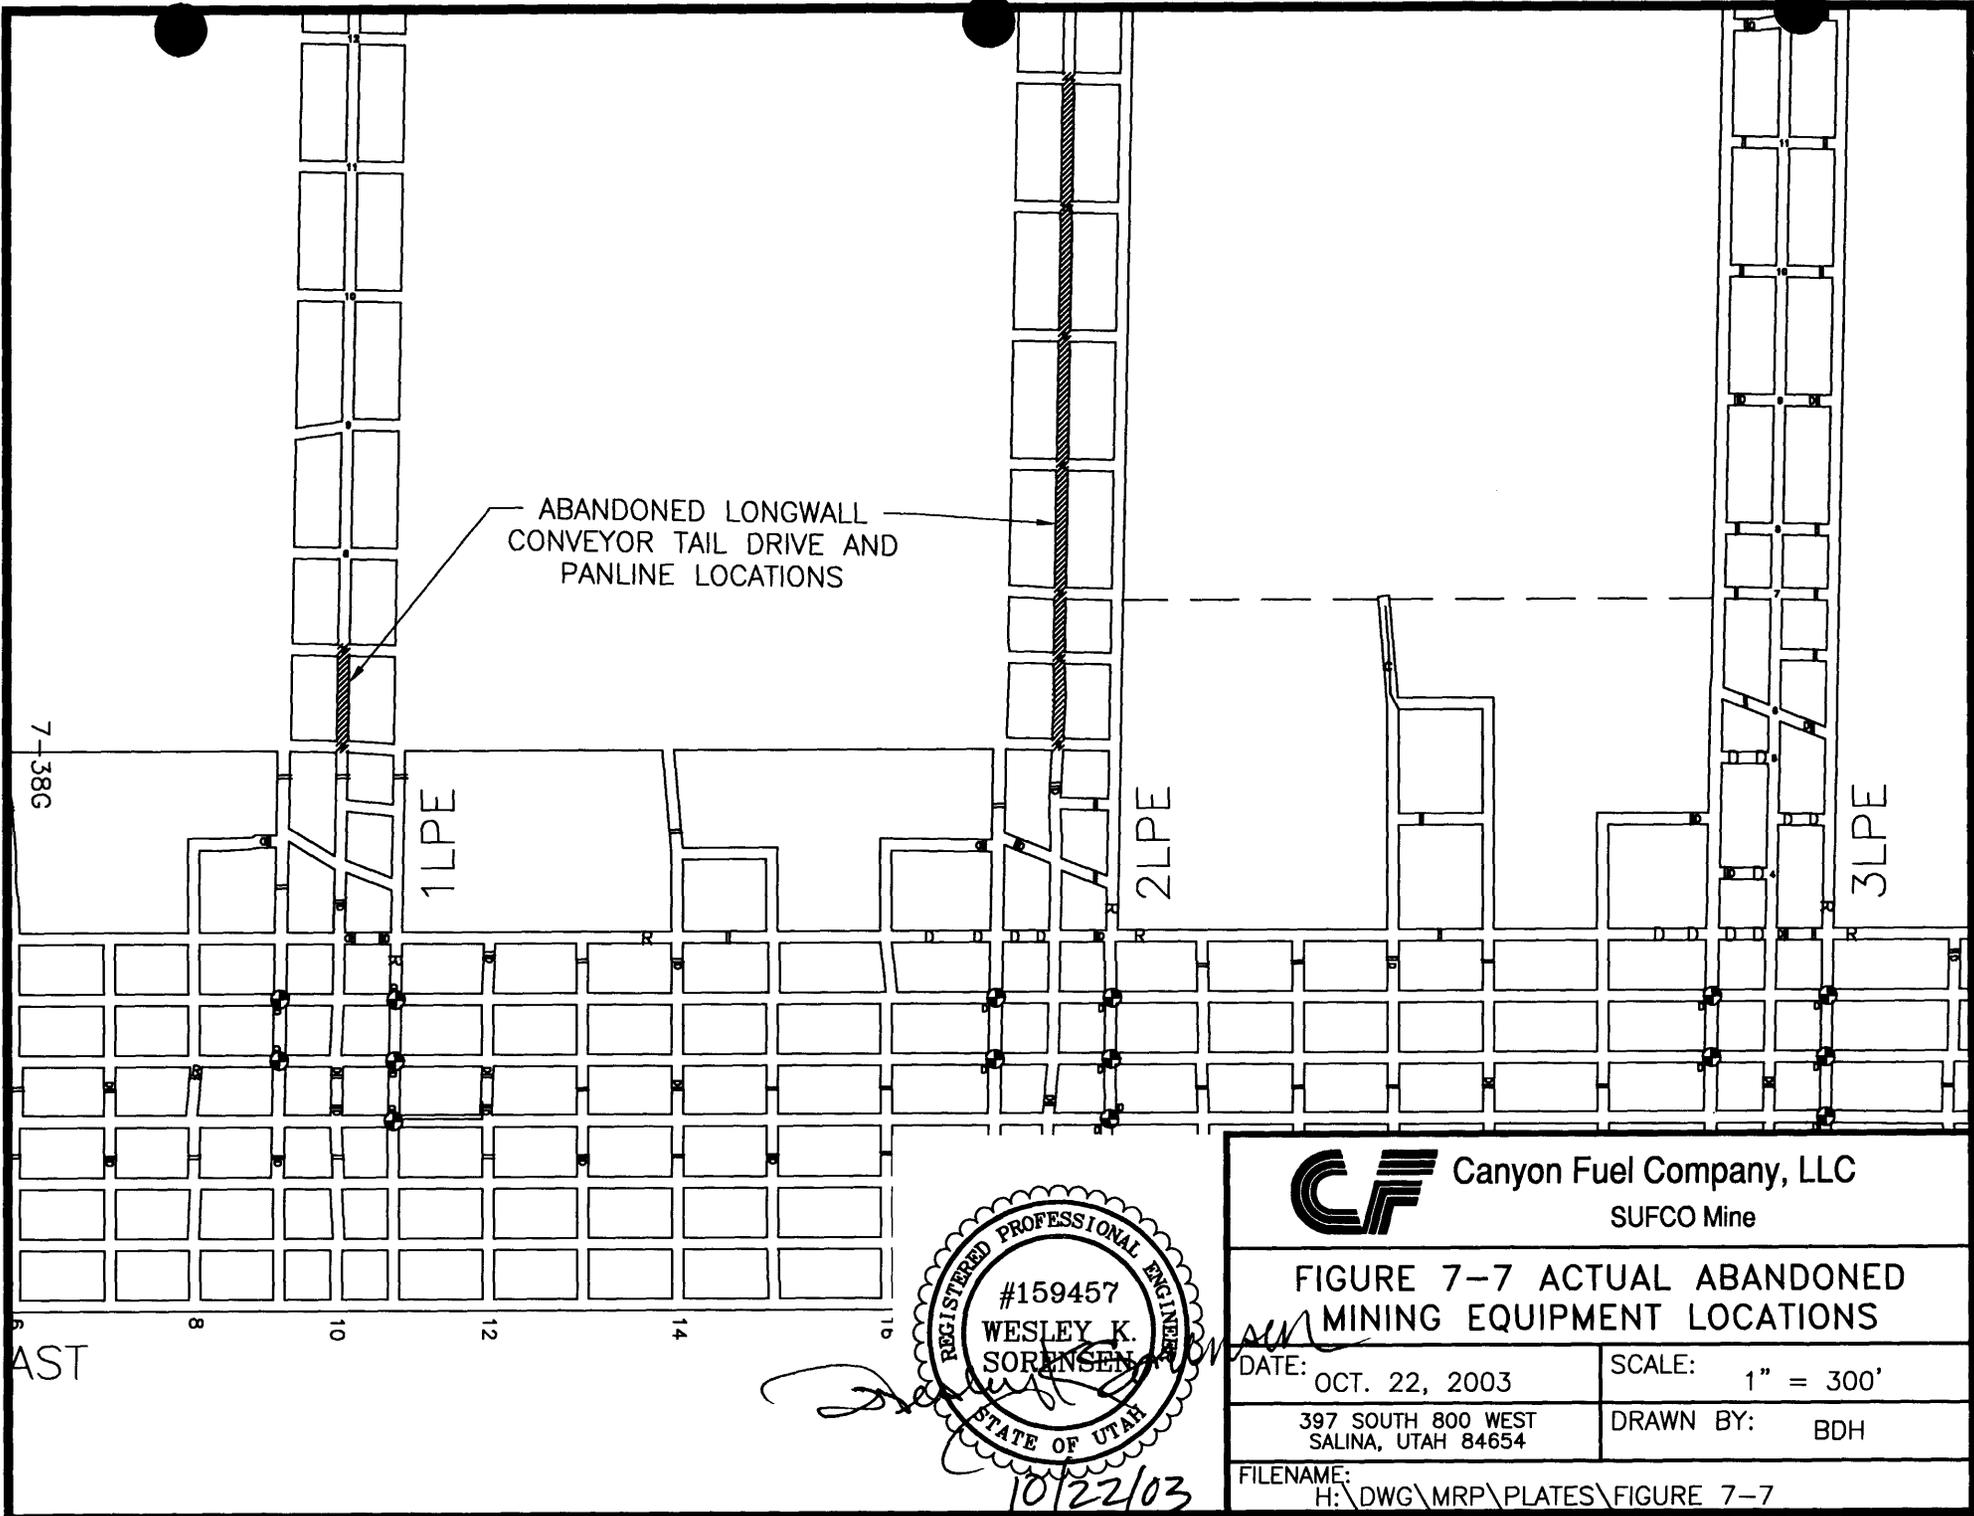

ABANDONED LONGWALL  
CONVEYOR TAIL DRIVE AND  
PANLINE LOCATIONS

7-38G


1LPE

2LPE

3LPE

6 8 10 12 14 16 19

AST

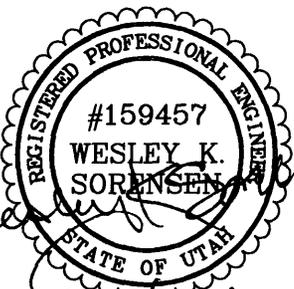

Canyon Fuel Company, LLC  
SUFCO Mine

FIGURE 7-7 ACTUAL ABANDONED  
MINING EQUIPMENT LOCATIONS

DATE: OCT. 22, 2003	SCALE: 1" = 300'
397 SOUTH 800 WEST SALINA, UTAH 84654	DRAWN BY: BDH

FILENAME: H:\DWG\MRP\PLATES\FIGURE 7-7

10/22/03