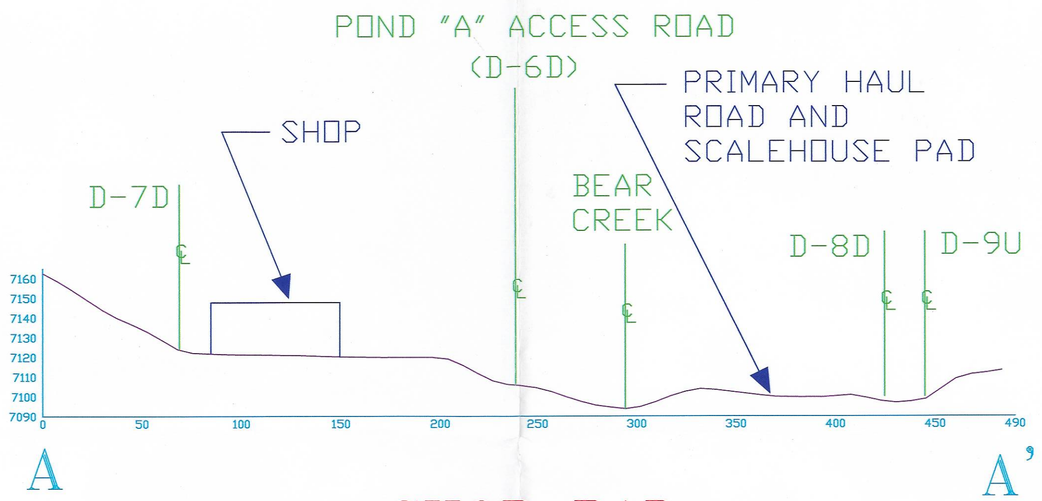

SHOP PAD CROSS-SECTION

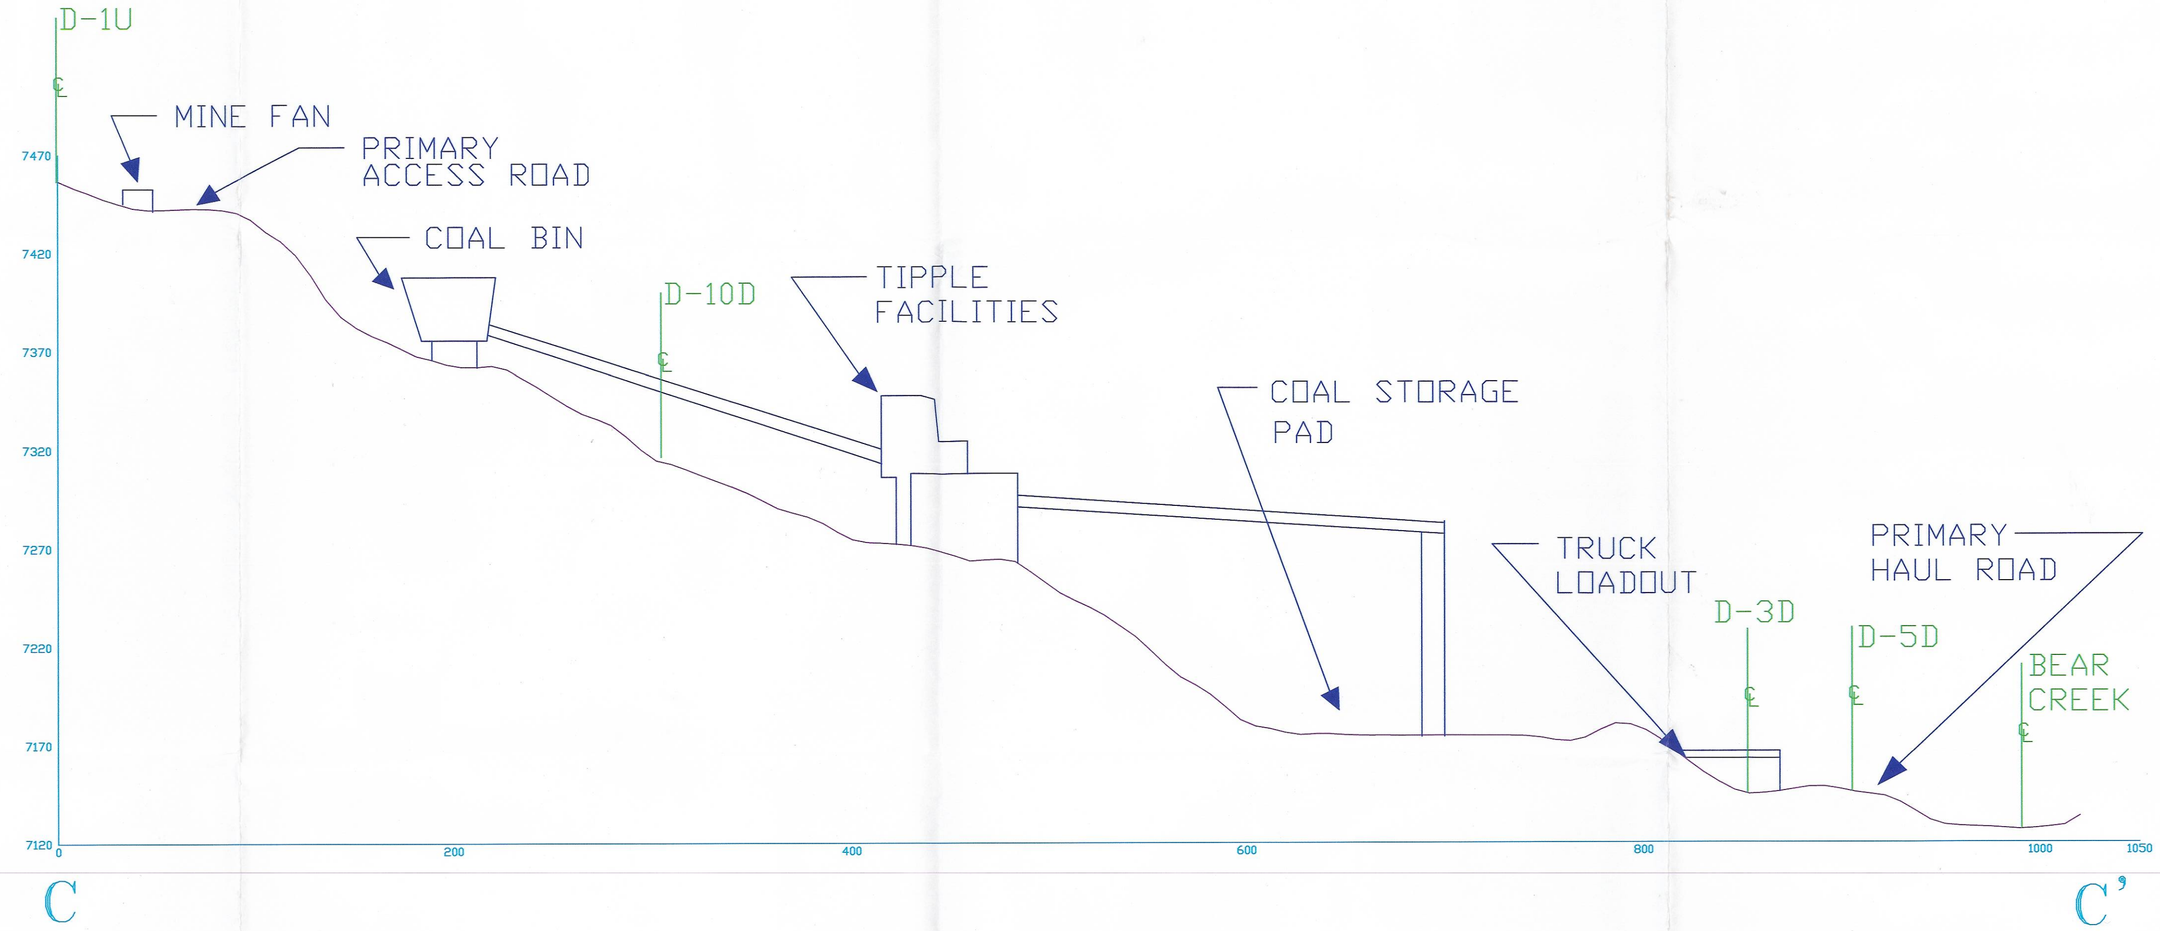

TIPPLE PAD AND COAL STORAGE PAD CROSS-SECTION

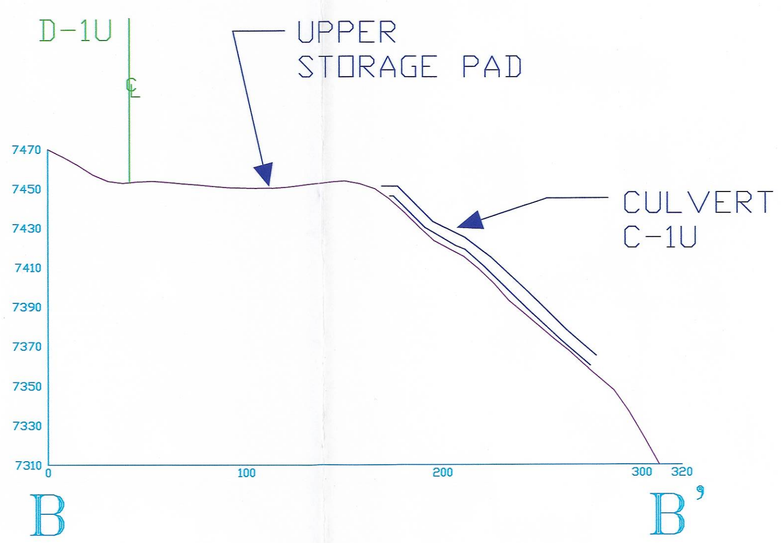

UPPER STORAGE PAD CROSS-SECTION

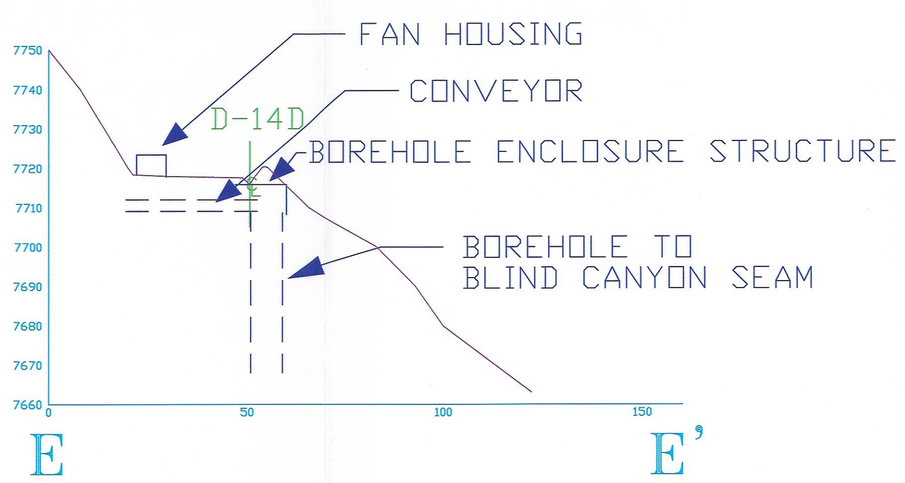

TANK SEAM PORTAL PAD CROSS-SECTION

1" = 25'

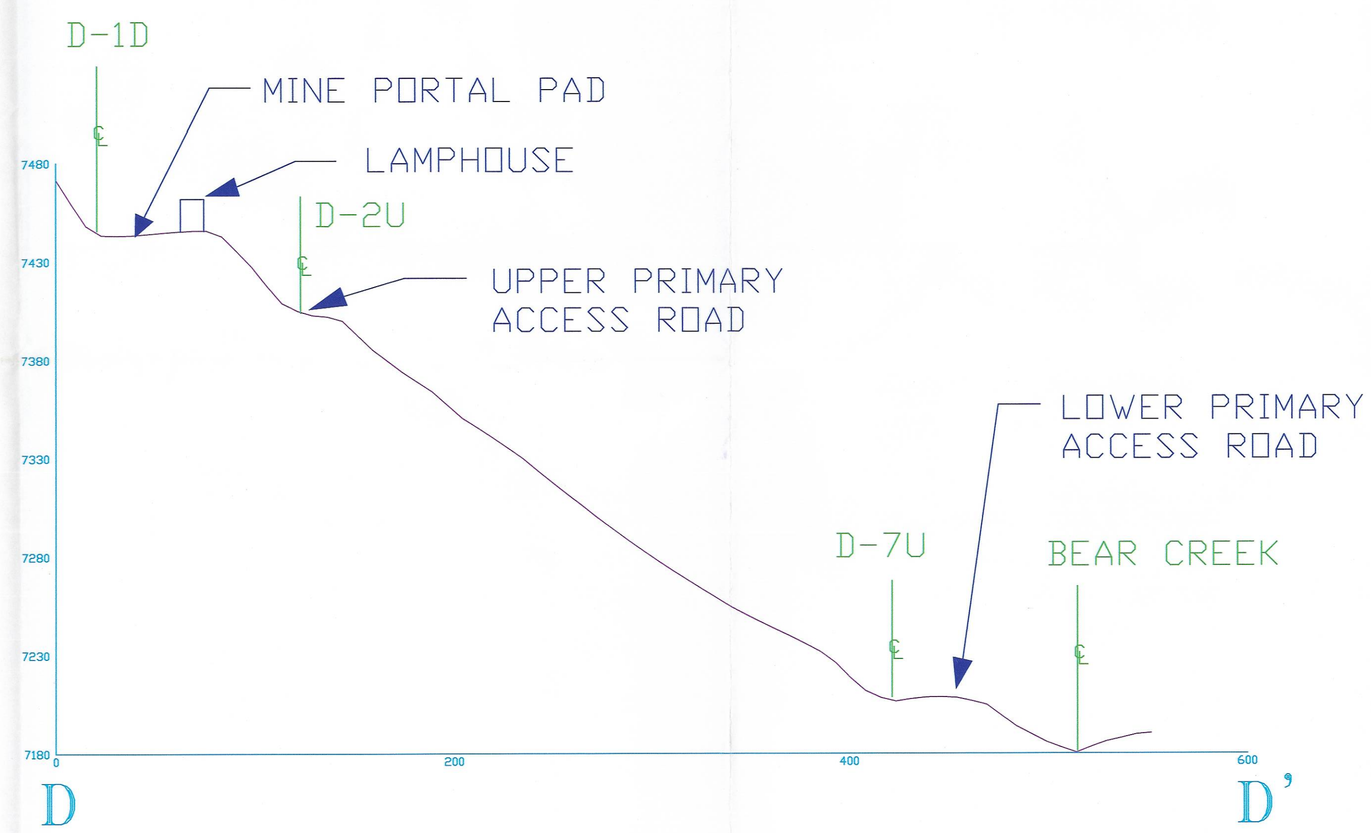

PORTAL PAD AND ACCESS ROAD CROSS-SECTION

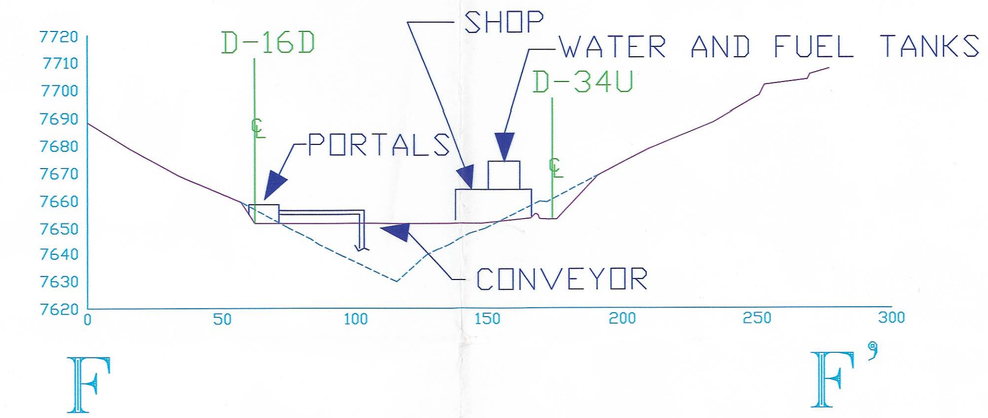

WHR BLIND CANYON SEAM PORTAL PAD

INCORPORATED
Div. of Oil, Gas & Mining

SEE PLATES 2-4 FOR CROSS-SECTION LOCATIONS
SEE PLATES 3-5 FOR ROAD DESIGNS
SEE PLATES 7-1 FOR HYDROLOGY
SEE TABLE 7.2-10 FOR DIVERSION CHARACTERISTICS

RECEIVED
FEB 2 3 2006
DIV. OF OIL, GAS & MINING

LICENSED PROFESSIONAL ENGINEER MARK A. REYNOLDS 3180279-2202 STATE OF UTAH

REV.	DATE	REMARKS	APPR.
1	10/22/93	Tank Seam Portal Pad X-Section Added (93B)	7/22/94
2	2/23/96	Cross Section E Updated for As-Built (96A)	7/05/96
3	6/25/01	Wild Horse Ridge Portal Pad Cross Section Added (SR96-1)	7/03/01
4	8/01/02	Changed name from 3-1 to 5-8	12/8/05
5			
6			
7			
8			
9			
10			

CO-OP MINING CO.
HUNTINGTON, UTAH

CROSS-SECTIONS

SCALE:	DRAWN BY:	DATE:
1" = 50'	C. Reynolds	4/09/92

BEAR CANYON | PLATE 5-8