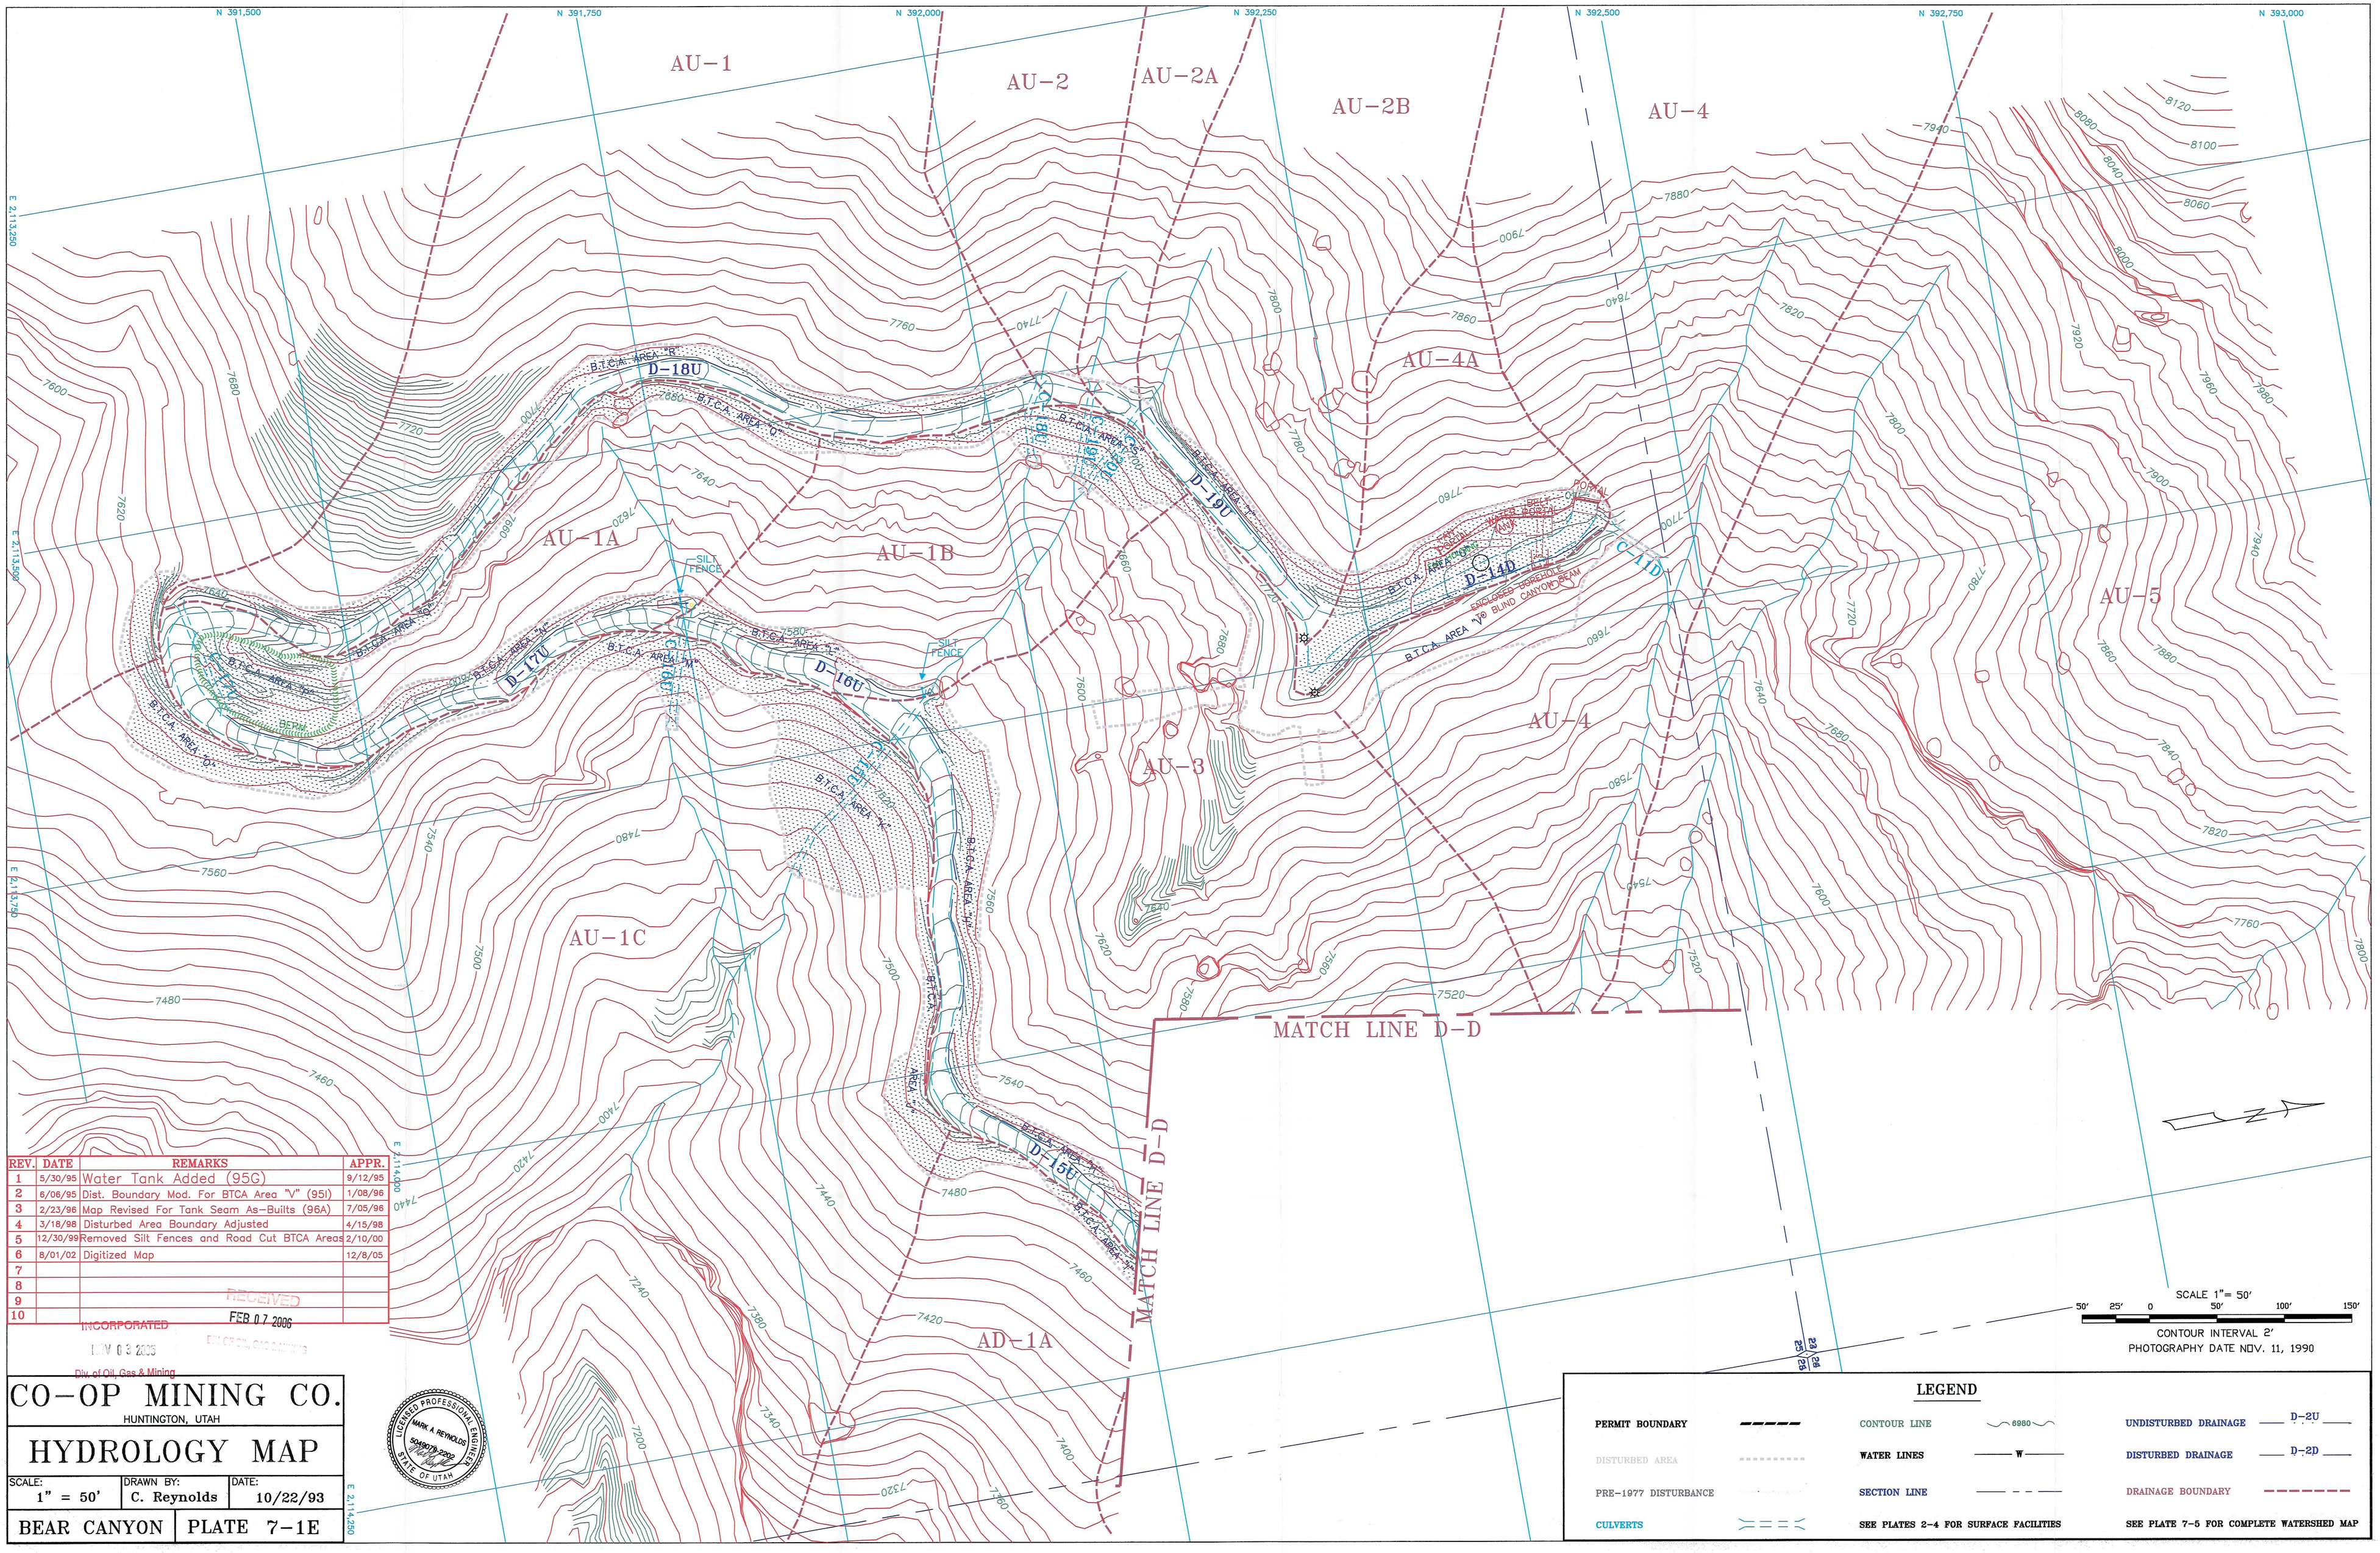

REV.	DATE	REMARKS	APPR.
1	5/30/95	Water Tank Added (95G)	9/12/95
2	6/06/95	Dist. Boundary Mod. For BTCA Area "V" (95I)	1/08/96
3	2/23/96	Map Revised For Tank Seam As-Builts (96A)	7/05/96
4	3/18/98	Disturbed Area Boundary Adjusted	4/15/98
5	12/30/99	Removed Silt Fences and Road Cut BTCA Areas	2/10/00
6	8/01/02	Digitized Map	12/8/05
7			
8			
9			
10			

RECEIVED
FEB 07 2006
DIV. OF OIL, GAS & MINING

INCORPORATED
NOV 03 2005
Div. of Oil, Gas & Mining

LICENSED PROFESSIONAL ENGINEER
MARK A. REYNOLDS
5049079-2202
STATE OF UTAH

CO-OP MINING CO.

HUNTINGTON, UTAH

HYDROLOGY MAP

SCALE:	DRAWN BY:	DATE:
1" = 50'	C. Reynolds	10/22/93

BEAR CANYON | PLATE 7-1E

LEGEND

PERMIT BOUNDARY		CONTOUR LINE	6980	UNDISTURBED DRAINAGE	D-2U
DISTURBED AREA		WATER LINES	W	DISTURBED DRAINAGE	D-2D
PRE-1977 DISTURBANCE		SECTION LINE		DRAINAGE BOUNDARY	
CULVERTS		SEE PLATES 2-4 FOR SURFACE FACILITIES		SEE PLATE 7-5 FOR COMPLETE WATERSHED MAP	