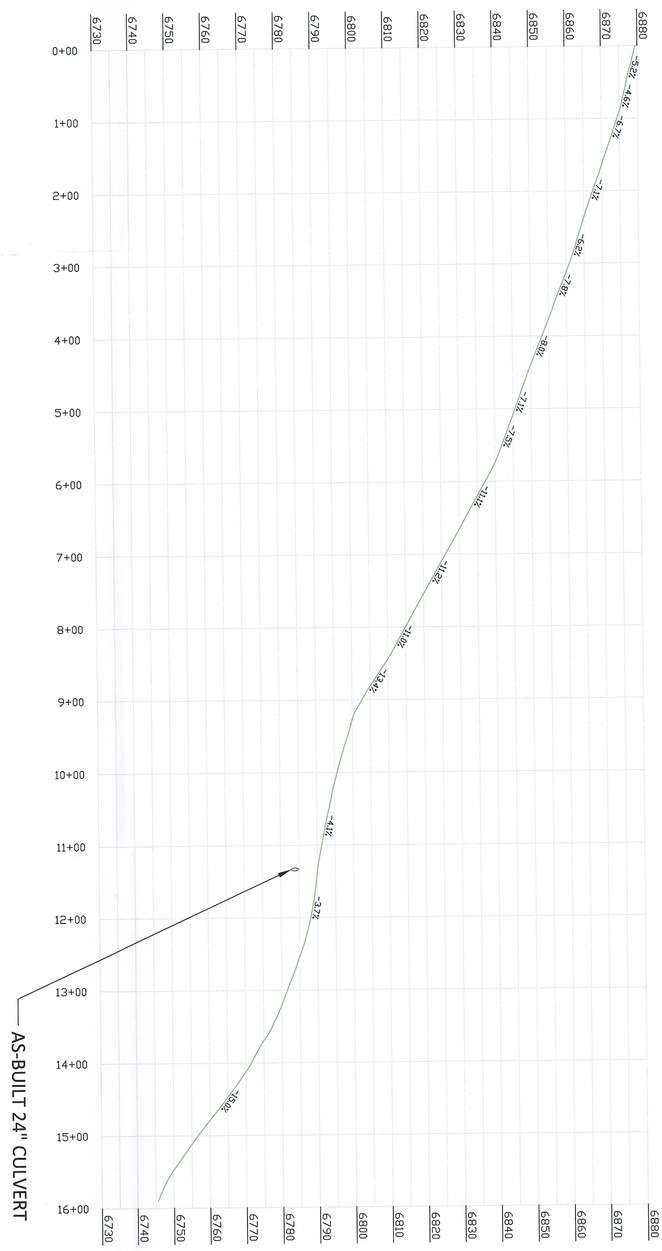

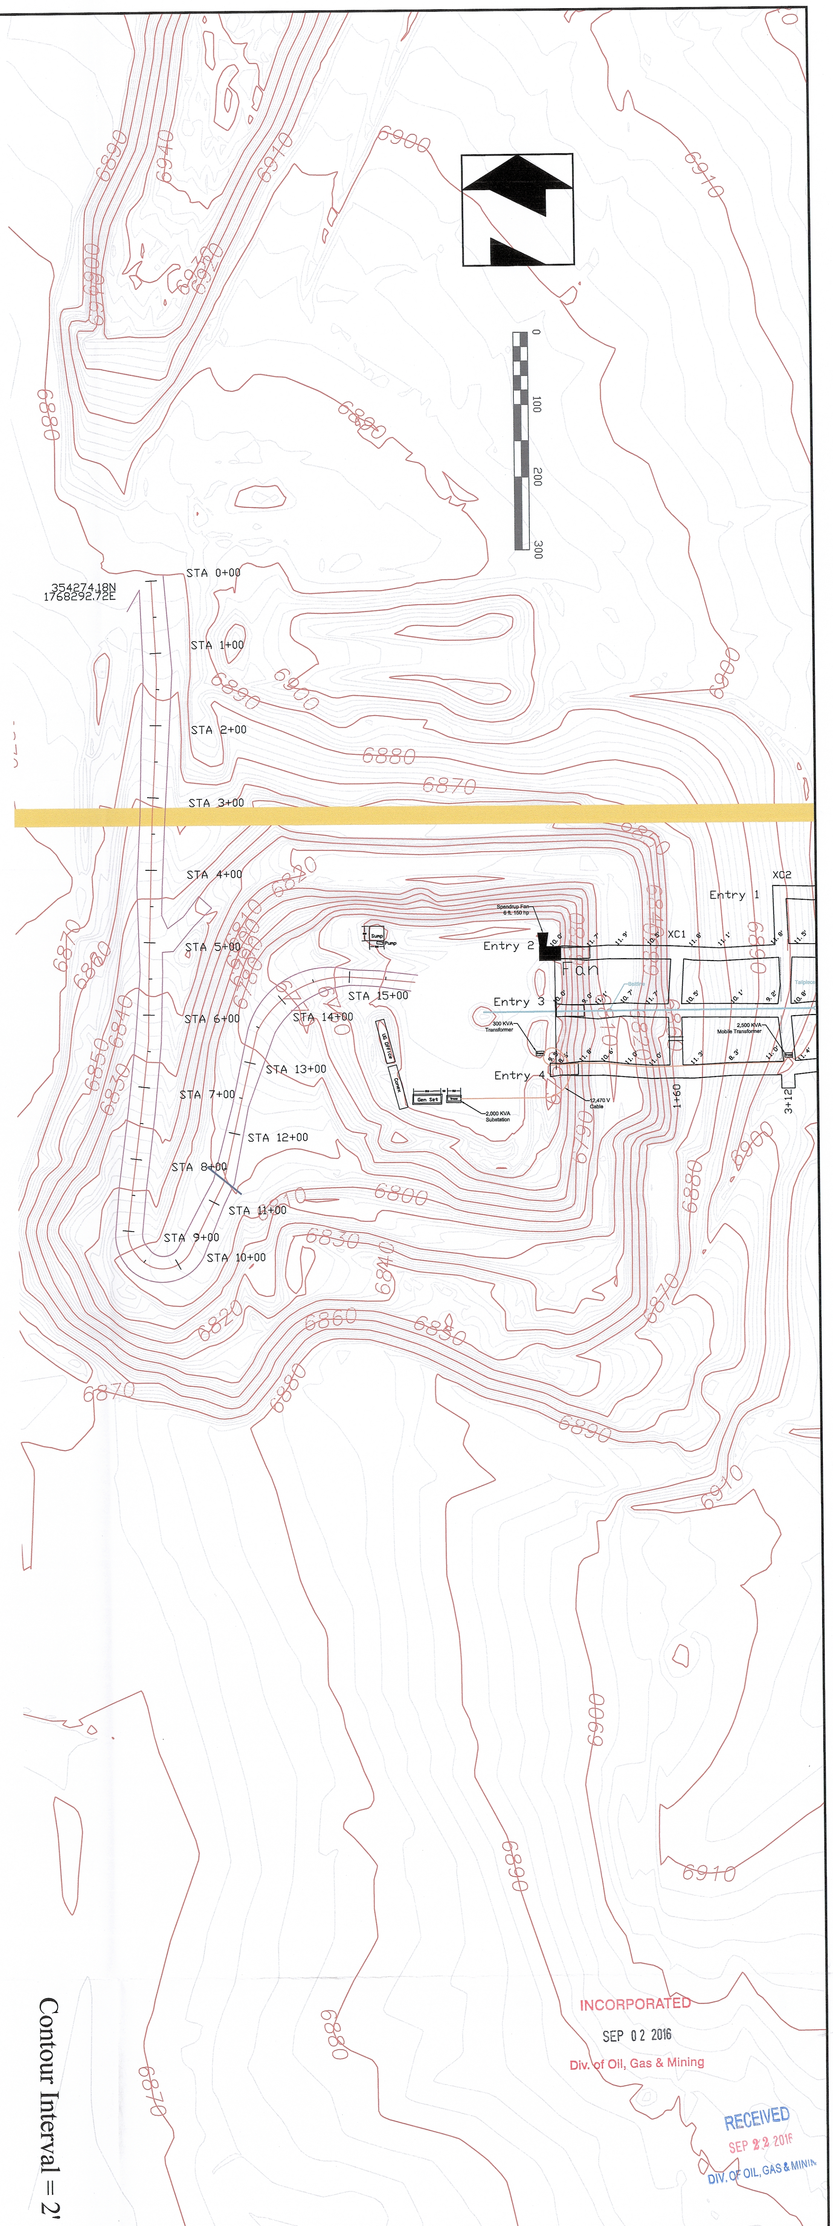

INCORPORATED
SEP 02 2016
Div. of Oil, Gas & Mining

RECEIVED
SEP 22 2016
DIV. OF OIL, GAS & MINING

LEGEND:
- LEASE BOUNDARY
- PRIVATE COAL OWNERSHIP
- SECTION LINE
- FOUND SECTION CORNER
- FOUND PROPERTY CORNER

DRAWN BY:	CHECKED BY:
A. CHRISTENSEN	DG
DRAWING: 5-22I	DATE: 4/10/15
	SCALE: 1" = 100'
JOB NUMBER: 1400	SHEET

REVISIONS

DATE:	BY:
XX/XX/XX	XX

PRIMARY ROADS UNDERGROUND ACCESS ROAD PLAN & PROFILE AS-BUILT

COAL HOLLOW PROJECT
ALTON, UTAH

DRAWING: 5-22I

UTAH REGISTERED PROFESSIONAL ENGINEER #154166 DAN W. GUY 9/16/16

Alton Coal Development
Coal Hollow Project
463 North 100 West, Suite 1
Cedar City, Utah 84720
Phone (435)867-5331
Fax (435)867-1192