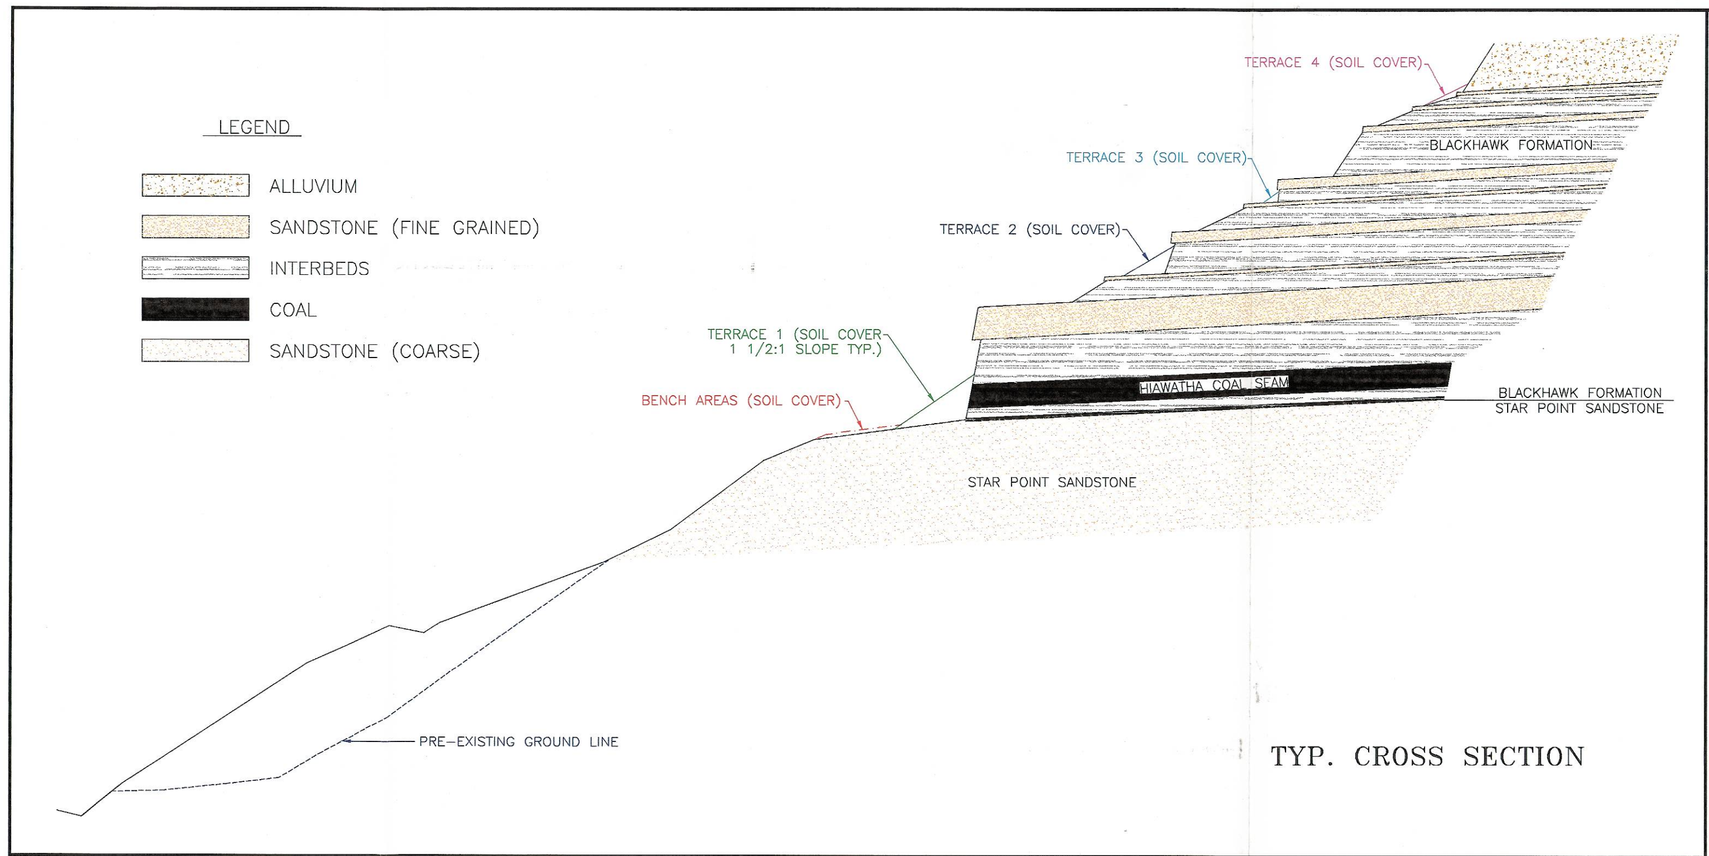

TYP. CROSS SECTION

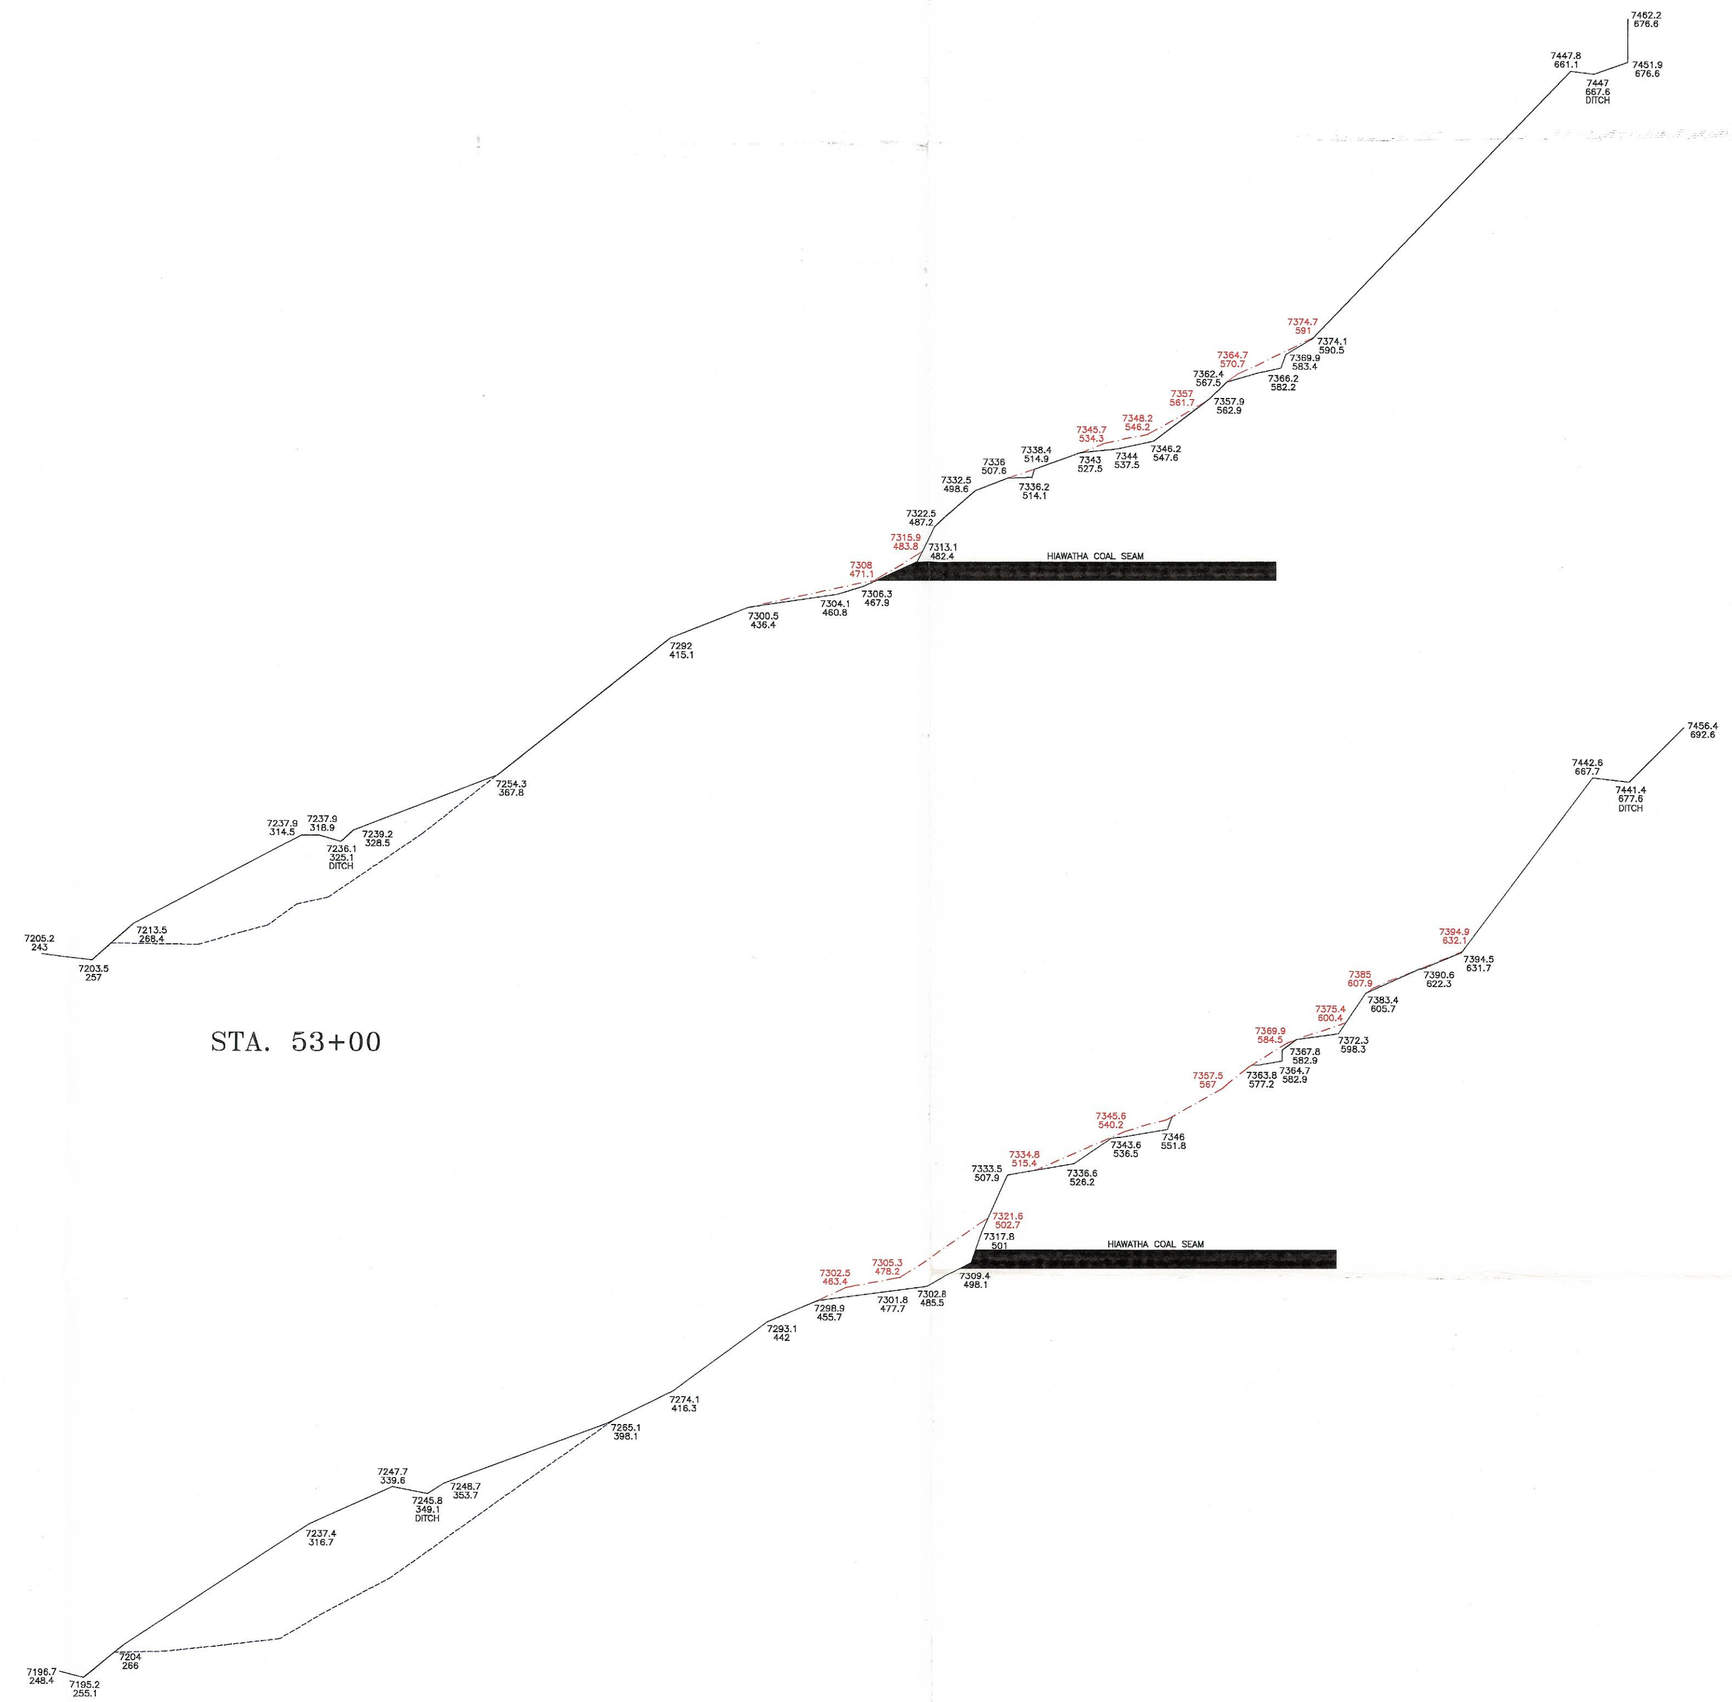

STA. 53+00

STA. 52+00

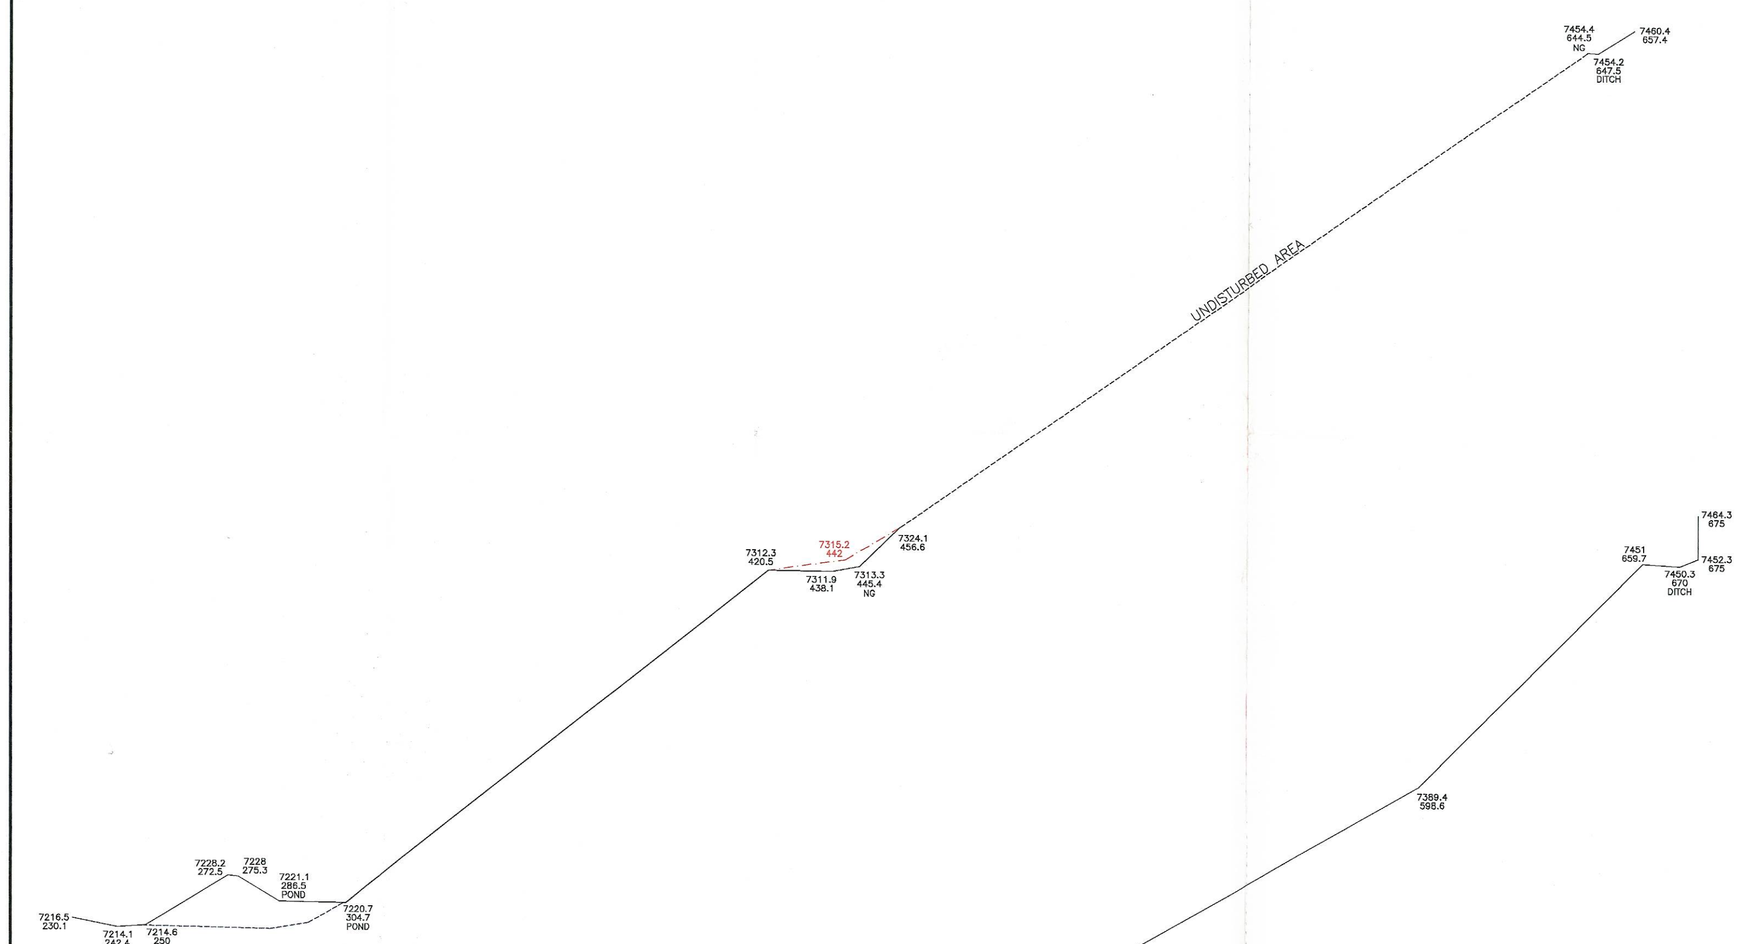

STA. 54+50

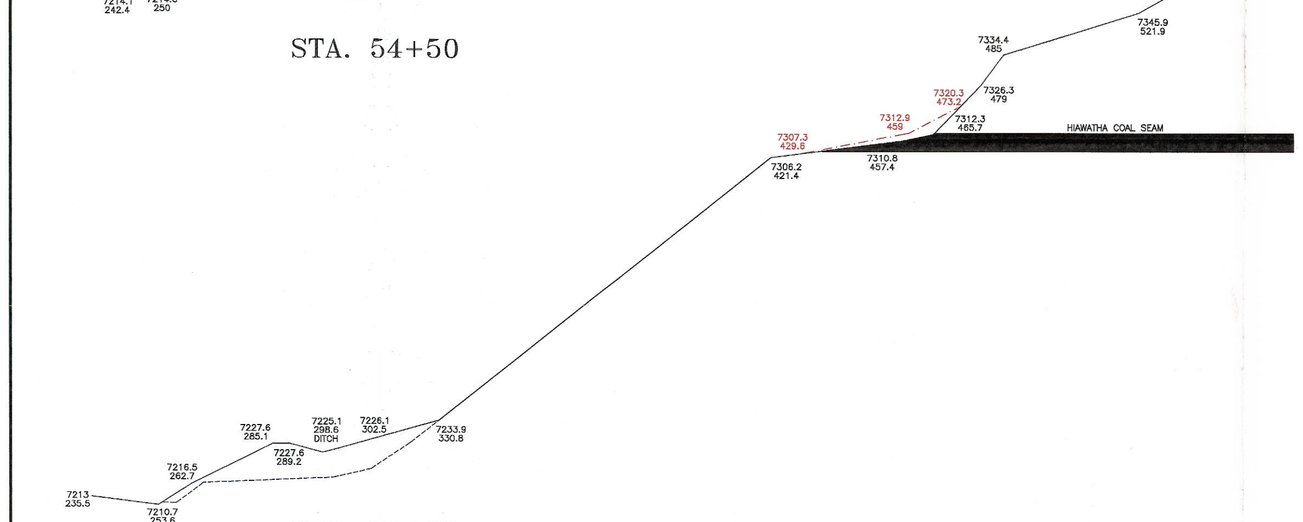

STA. 54+00

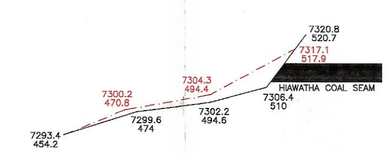

STA. 51+50

LEGEND

EXISTING GROUND LINE

PRE-EXISTING GROUND LINE

FINAL RECLAMATION LINE

NOTE:

REFER TO PLATE 5-5 FOR CROSS SECTION LOCATIONS AND BASELINES

LICENSED PROFESSIONAL ENGINEER JOHN CHRISTENSEN No. 165651 STATE OF UTAH

I, JOHN CHRISTENSEN BEING A REGISTERED PROFESSIONAL ENGINEER IN THE STATE OF UTAH, DO HEREBY CERTIFY THAT THE INFORMATION CONTAINED ON THIS DRWAING REPRESENTS THE AS-BUILT CONDITION TO THE BEST OF MY KNOWLEDGE AND BELIEF.

JOHN CHRISTENSEN NO. 165651 — DATE 7/30/01

INCORPORATED JAN 03 2002 DIV OF OIL GAS & MINING

RECEIVED FEB 13 2002 DIVISION OF OIL, GAS AND MINING

5-3

CAD FILE NAME/DISK#: JAZ\CW\KS1699D.DWG

DATE	REVISIONS	BY	CHK
7-27-01	REVISED TO REFLECT AS-BUILT CONDITIONS	KJL	

ENERGY WEST MINING COMPANY
HUNTINGTON, UTAH 84528

COTTONWOOD FAN PORTAL RECLAMATION SLOPE CROSS SECTIONS

DRAWN BY: K. LARSEN
SCALE: 1" =30'
DATE: SEPTEMBER 25, 1997
DRAWING #: KS1699D
SHEET 2 OF 2
REV. ___