LEGEND

EXISTING GROUND LINE

PRE-EXISTING GROUND LINE

FINAL RECLAMATION LINE

NOTE:

REFER TO PLATE 5-5 FOR CROSS SECTION LOCATIONS AND BASELINES




STA. 51+00

STA. 50+50




STA. 50+00

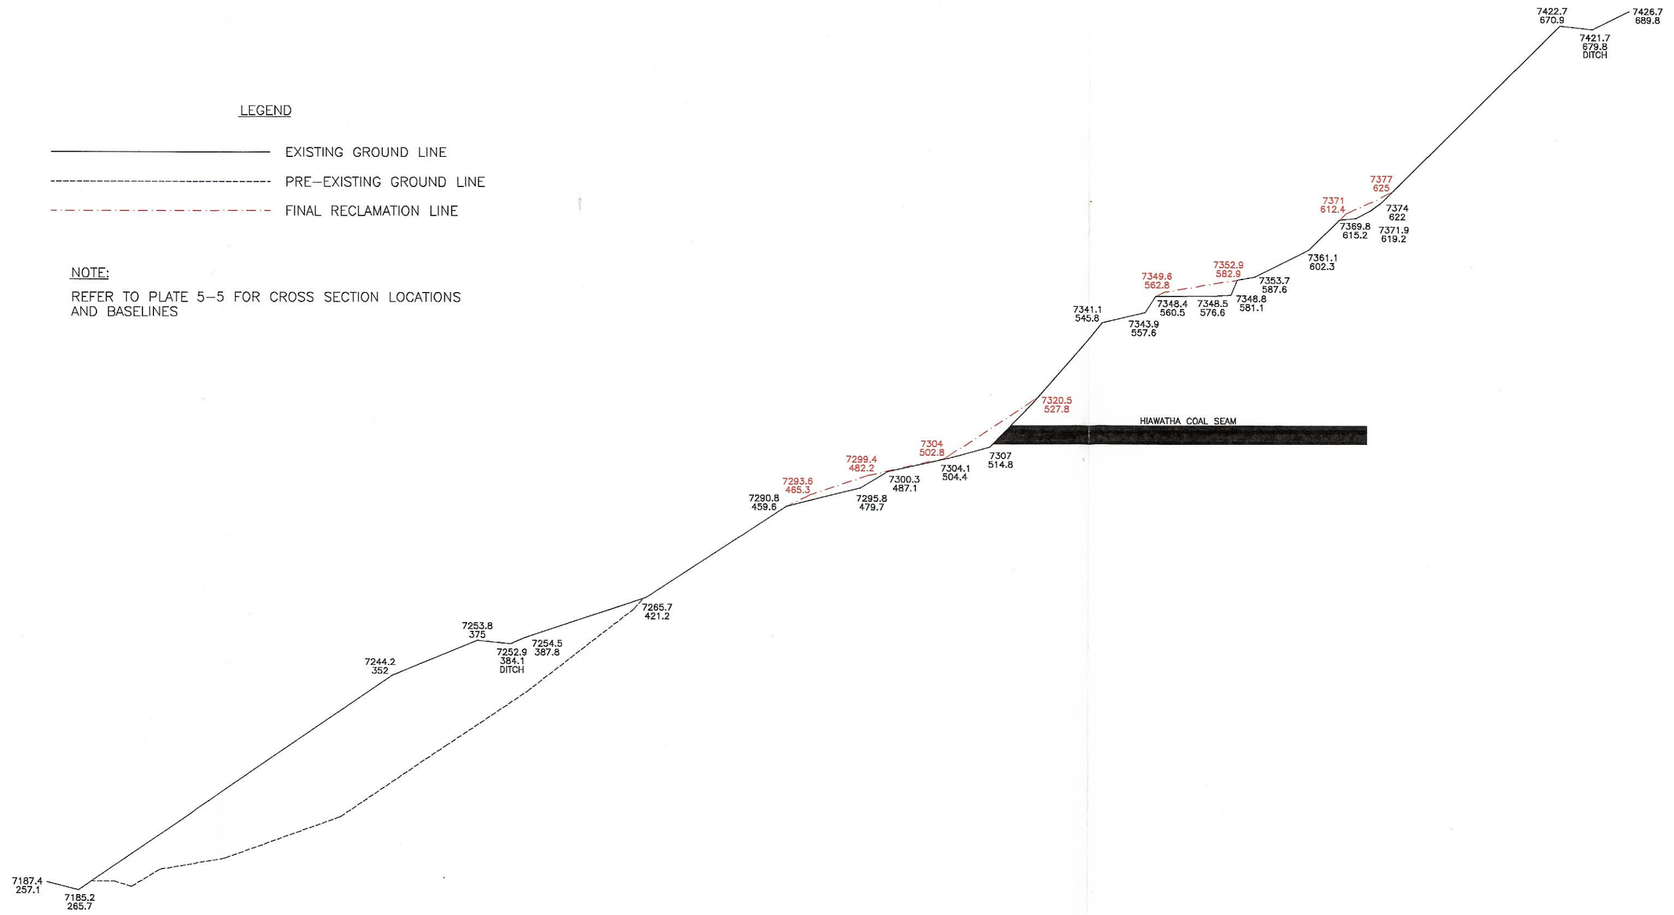


STA. 49+50

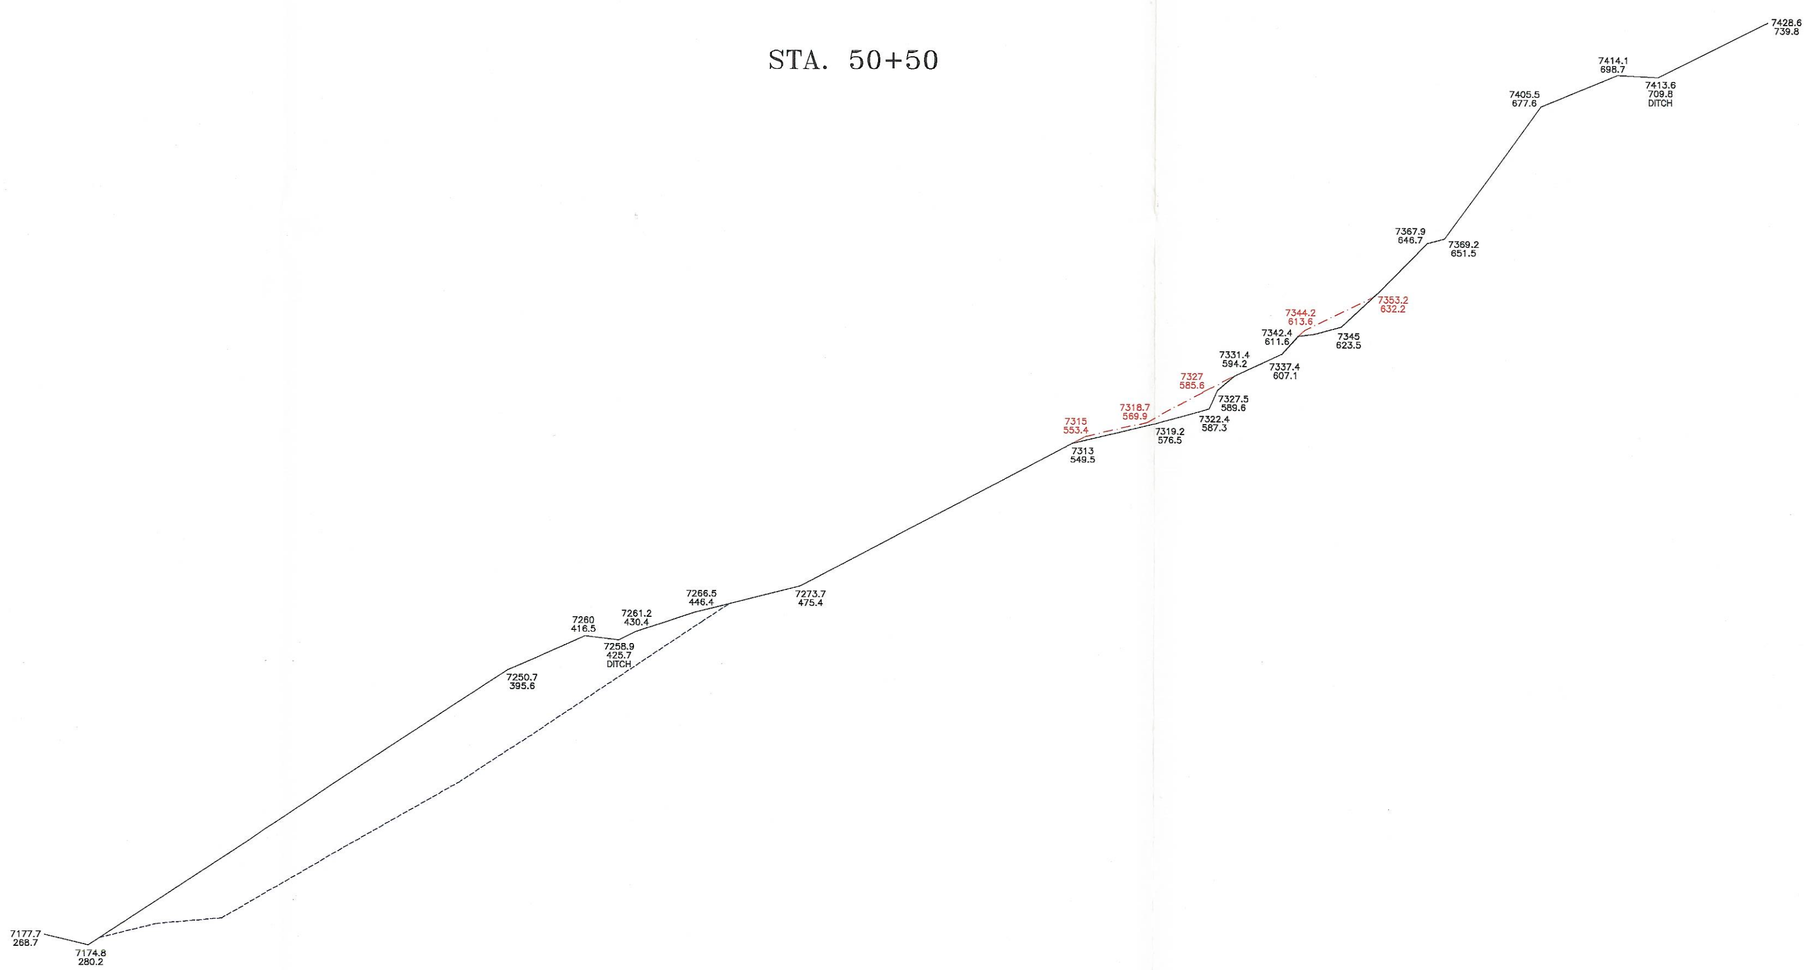


STA. 48+50

STA. 48+00

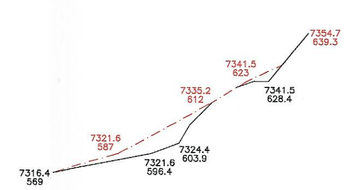STA. 47+50

LICENSED PROFESSIONAL ENGINEER
JOHN CHRISTENSEN
No. 165651
STATE OF UTAH

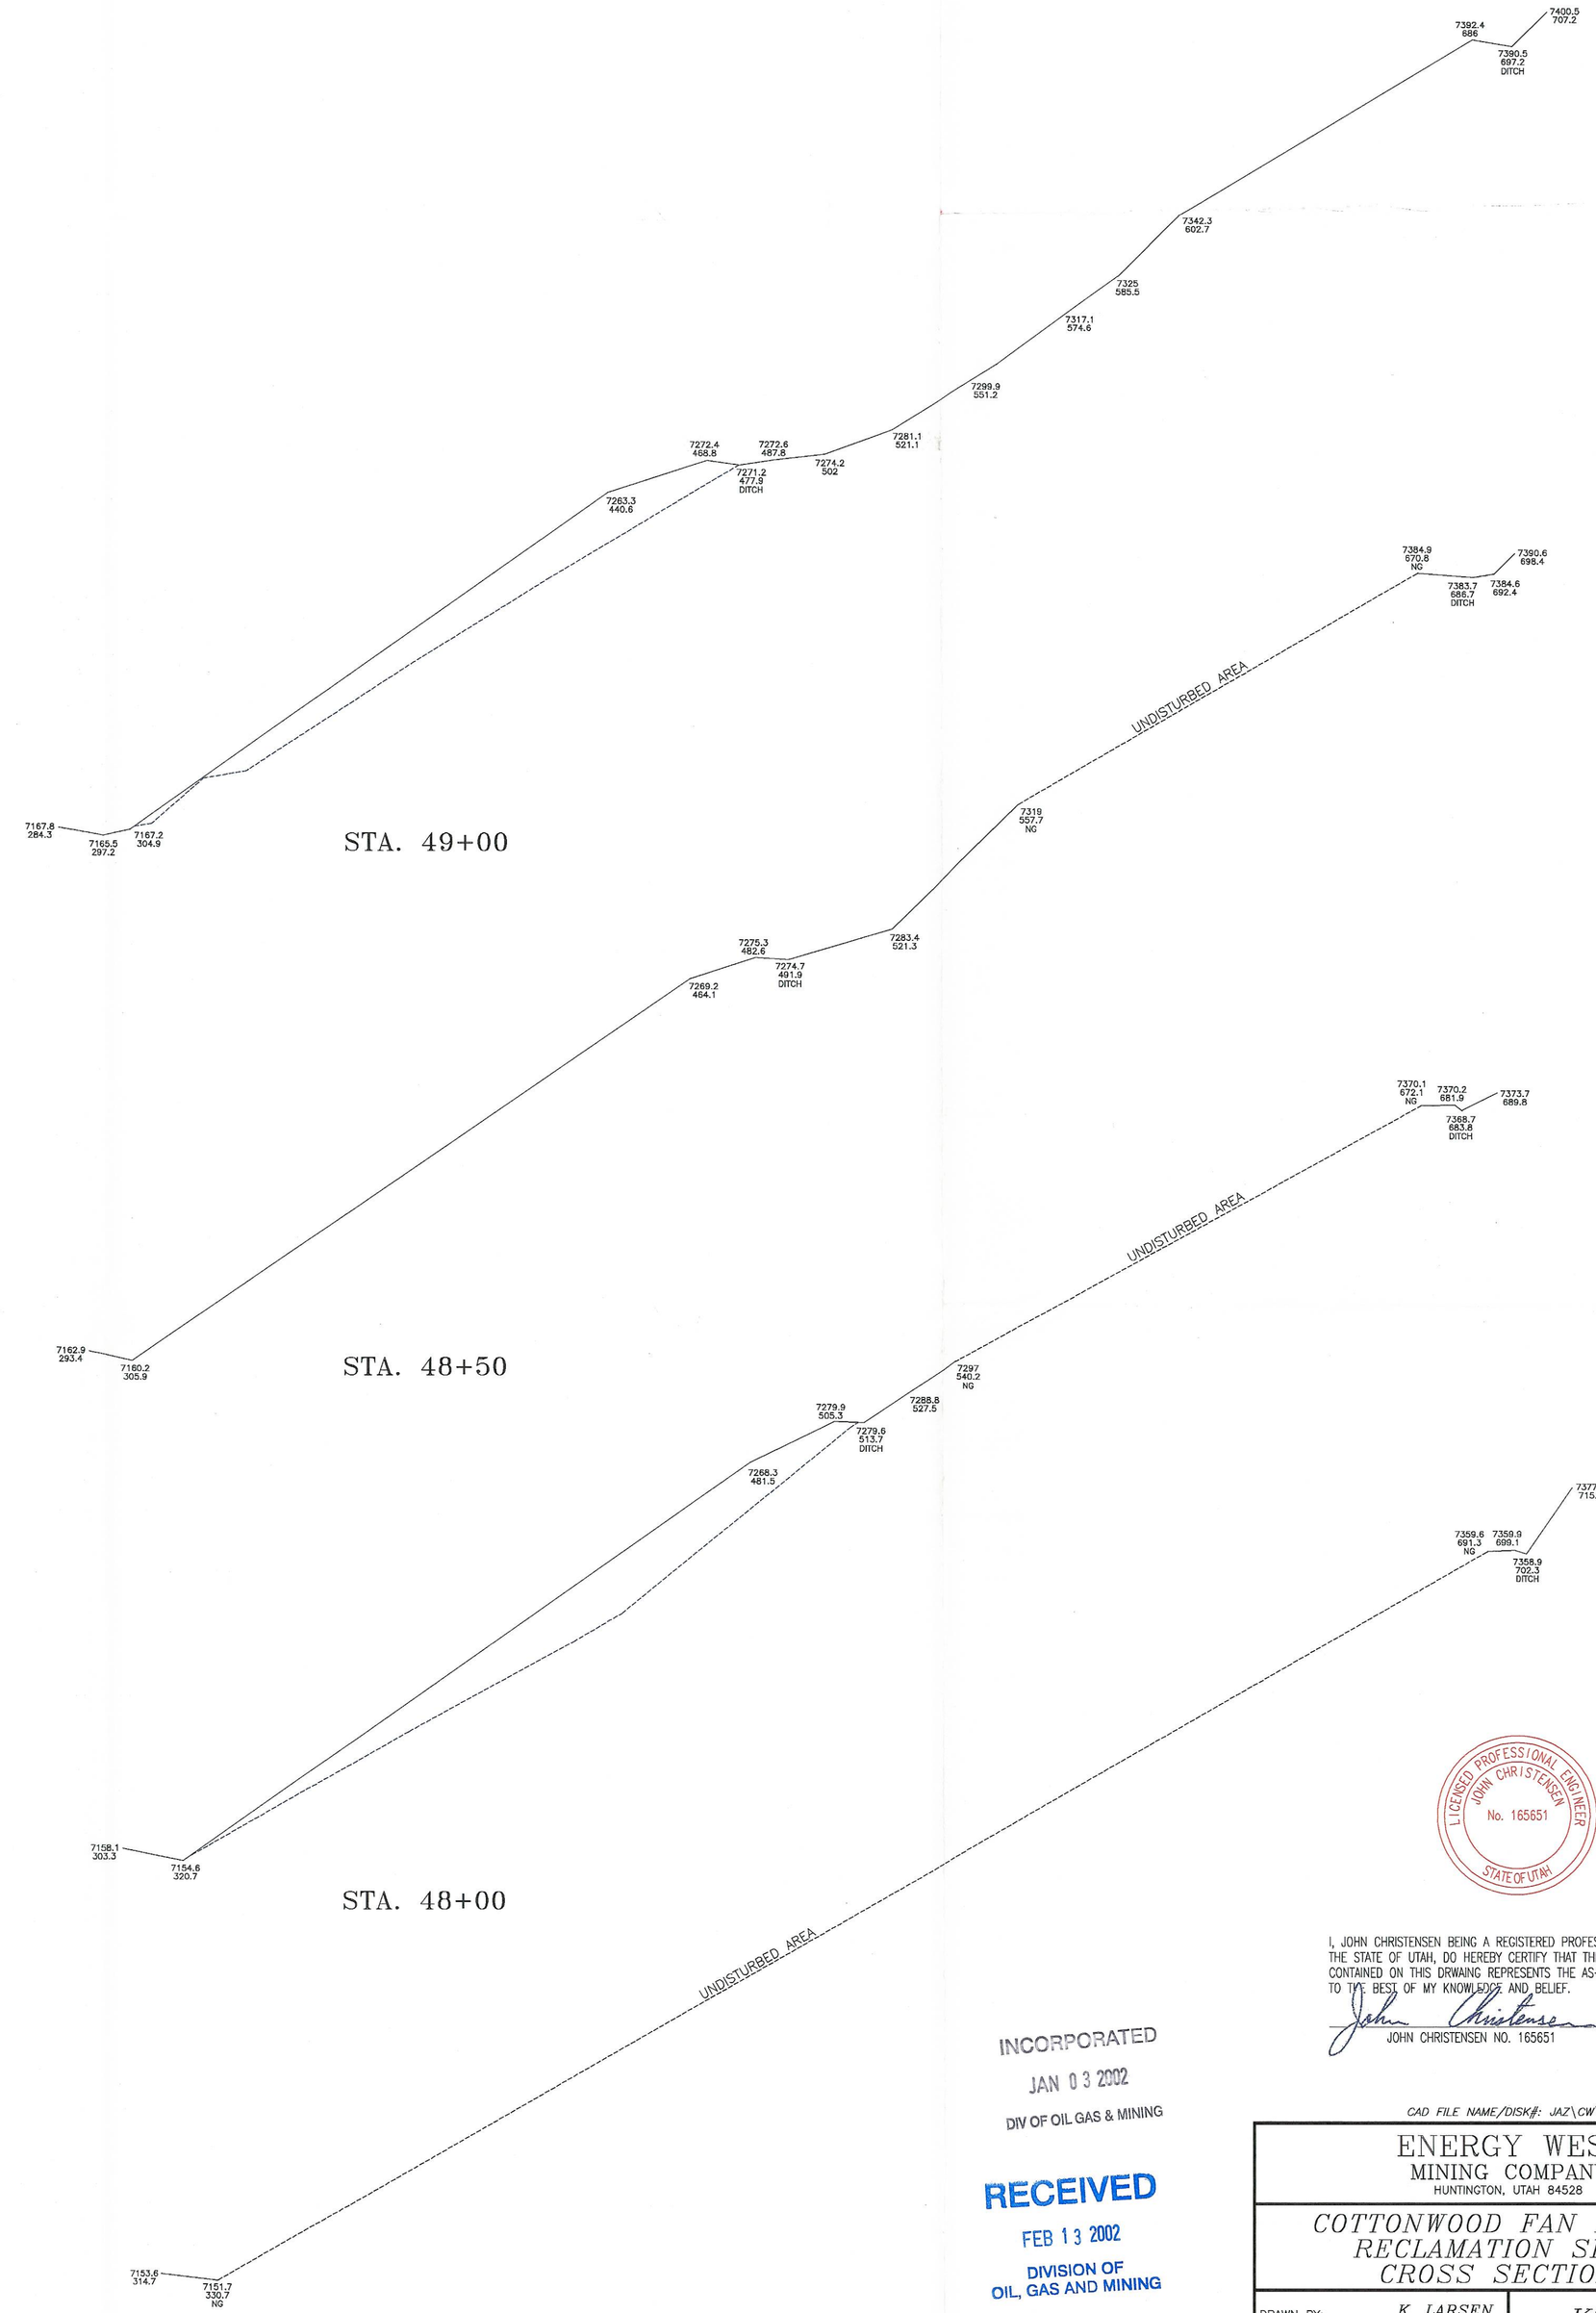I, JOHN CHRISTENSEN BEING A REGISTERED PROFESSIONAL ENGINEER IN THE STATE OF UTAH, DO HEREBY CERTIFY THAT THE INFORMATION CONTAINED ON THIS DRAWING REPRESENTS THE AS-BUILT CONDITION TO THE BEST OF MY KNOWLEDGE AND BELIEF.

John Christensen 7/30/01

JOHN CHRISTENSEN NO. 165651 DATE

INCORPORATED
JAN 03 2002
DIV OF OIL GAS & MINING

RECEIVED
FEB 13 2002
DIVISION OF
OIL, GAS AND MINING

**5-3**

CAD FILE NAME/DISK#: JAZ\CW\KS1699D.DWG

| DATE | REVISIONS | BY | CHK |
|---|---|---|---|
| 7-27-01 | REVISED TO REFLECT AS-BUILT CONDITIONS | KJL | |

ENERGY WEST
MINING COMPANY
HUNTINGTON, UTAH 84528

COTTONWOOD FAN PORTAL
RECLAMATION SLOPE
CROSS SECTIONS

DRAWN BY: K. LARSEN

SCALE: 1" = 30'

DATE: SEPTEMBER 25, 1997

DRAWING #: KS1699D

SHEET 1 OF 2 REV. ___