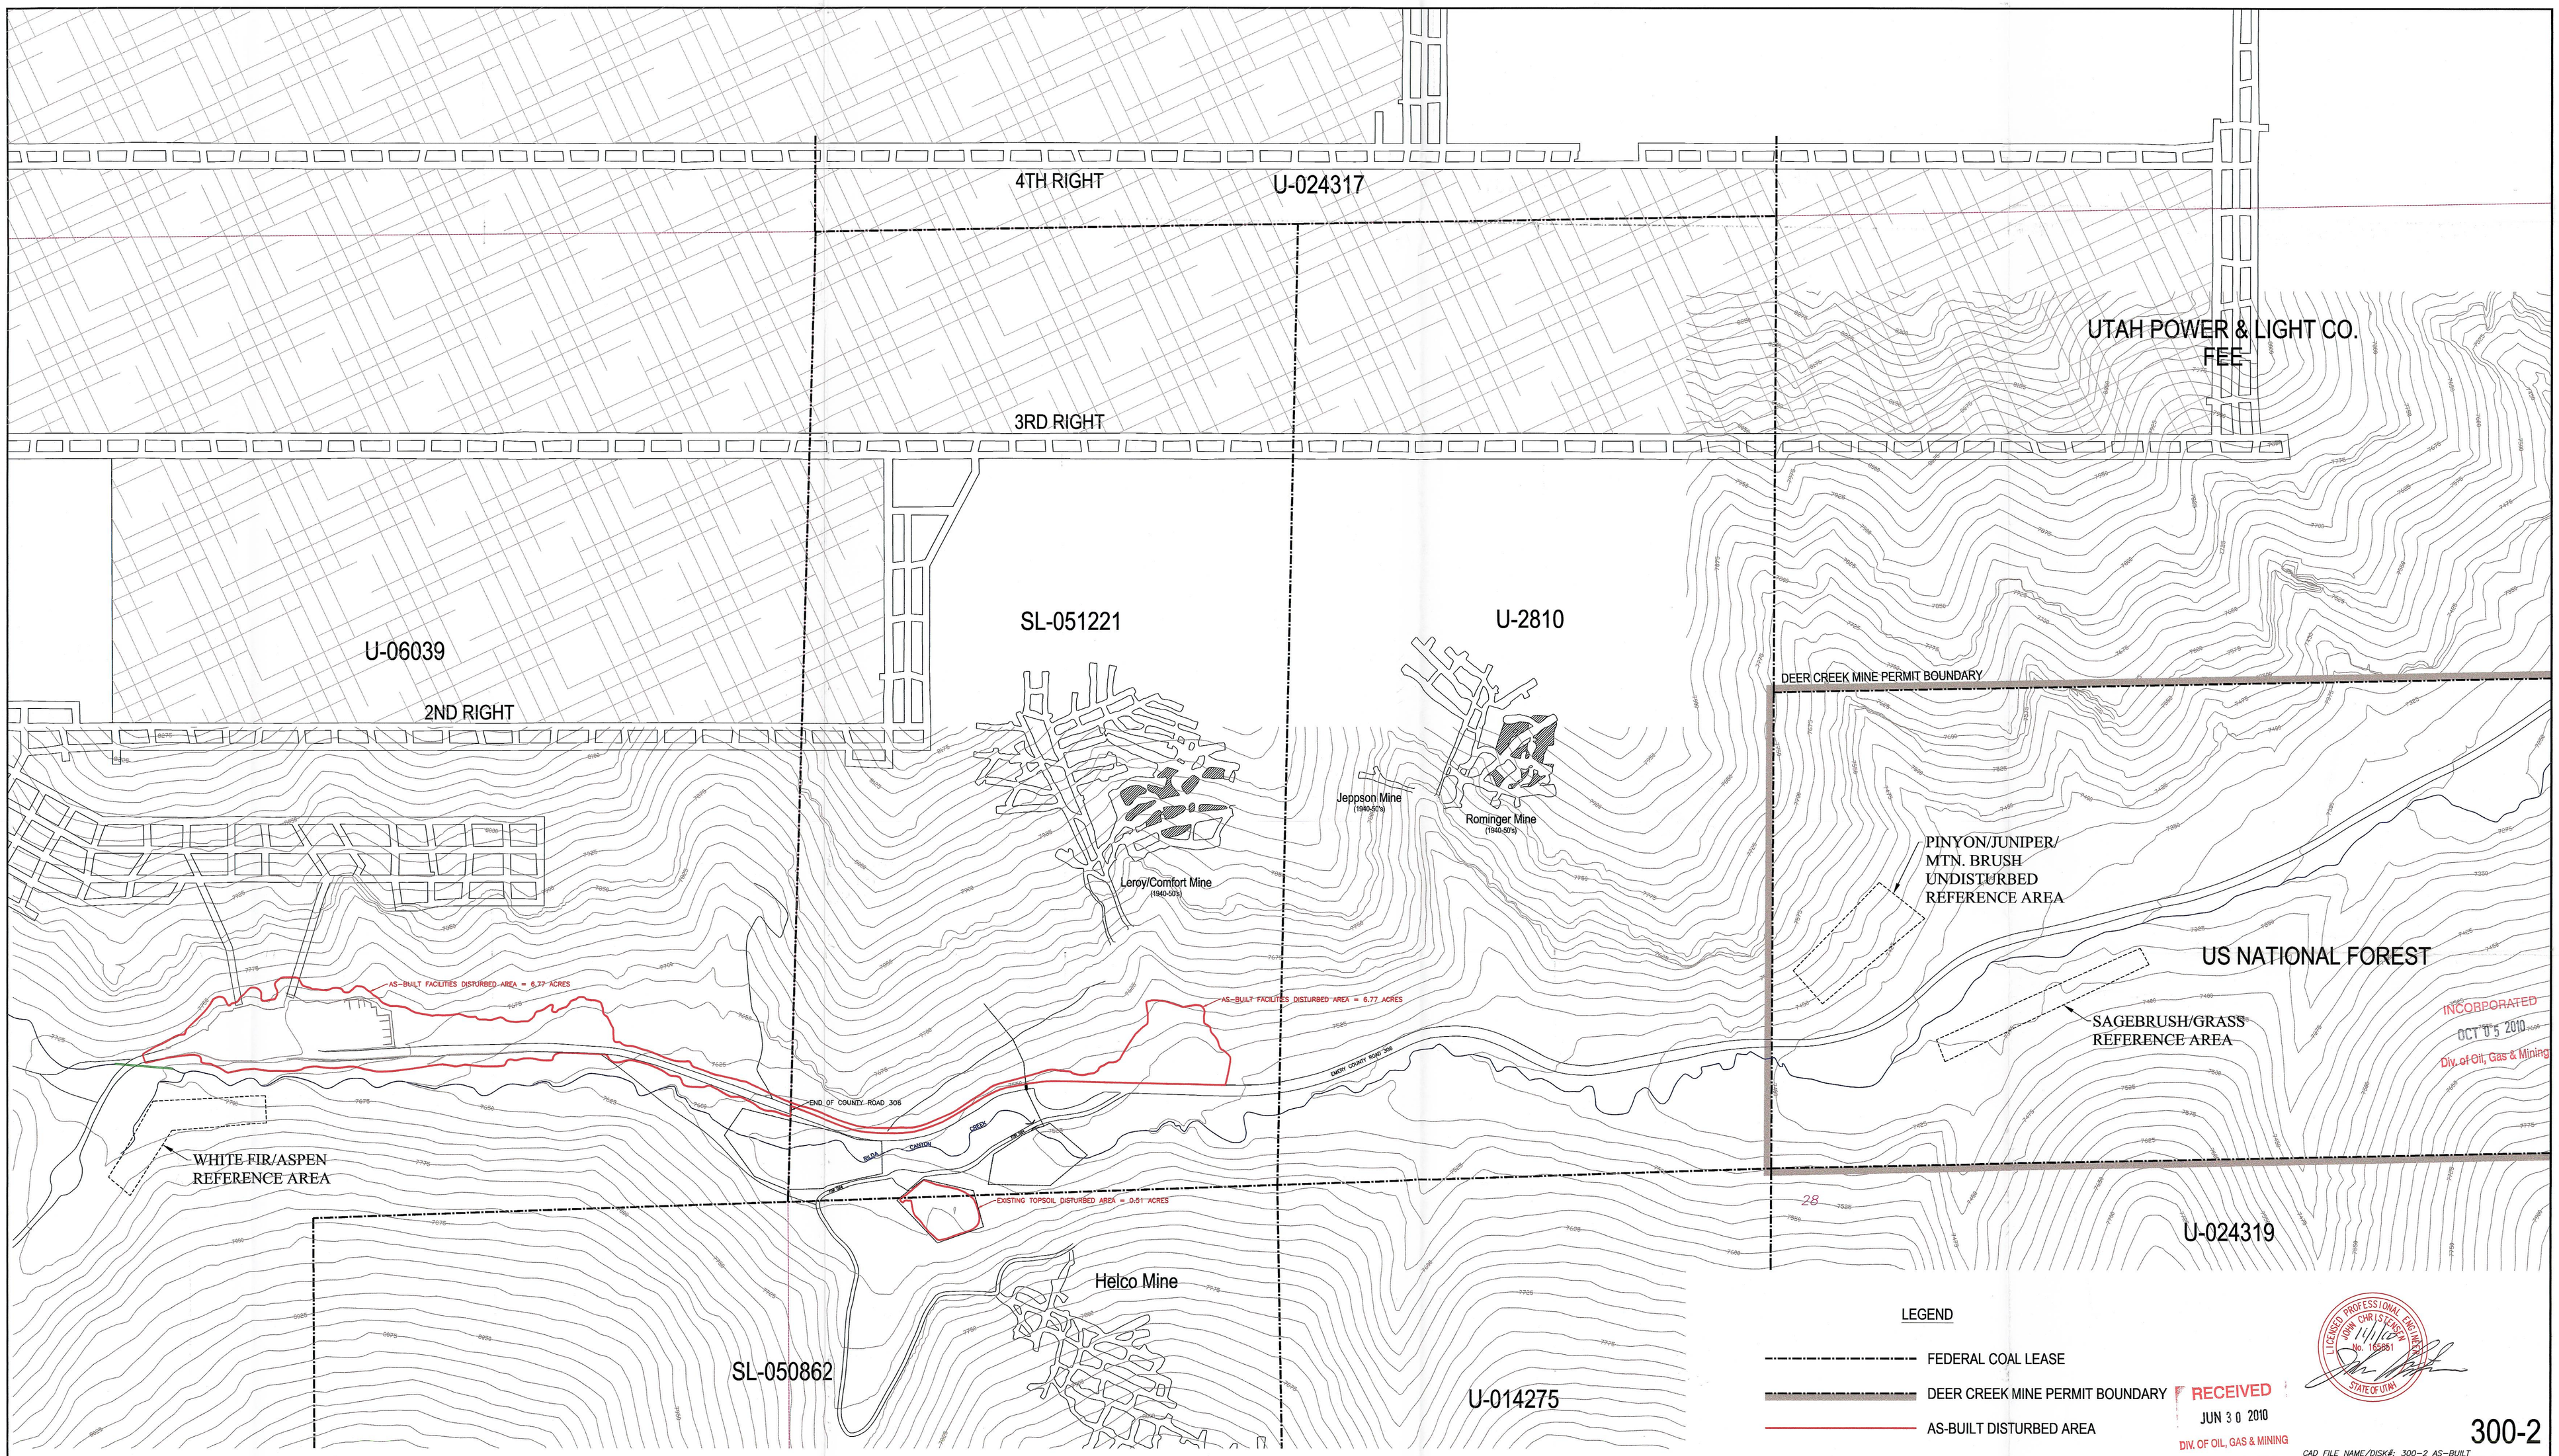

LEGEND

FEDERAL COAL LEASE

DEER CREEK MINE PERMIT BOUNDARY

AS-BUILT DISTURBED AREA

INCORPORATED
OCT 0 5 2010
Div. of Oil, Gas & Mining

RECEIVED
JUN 3 0 2010
DIV. OF OIL, GAS & MINING

LICENSED PROFESSIONAL ENGINEER
JOHN CHRISTENSEN
No. 155881
STATE OF UTAH

300-2

CAD FILE NAME/DISK#: 300-2 AS-BUILT

RECEIVED
NOV 0 4 2010
DIV. OF OIL, GAS & MINING

DATE	REVISION	BY	CHK
2/4/2010	ADDED AS-BUILT DISTURBED AREA BOUNDARY AND FENCE AROUND TOPSOIL PILE	KJL	

ENERGY WEST MINING COMPANY
A SUBSIDIARY OF PACIFICORP

DEER CREEK MINE
RILDA CANYON FACILITIES
VEGETATION REFERENCE AREAS

DRAWN BY: K. LARSEN
SCALE: 1"=200'
DATE: JUNE 16, 2009
DRAWING #: 300-2
SHEET 1 OF 1
REV. 1