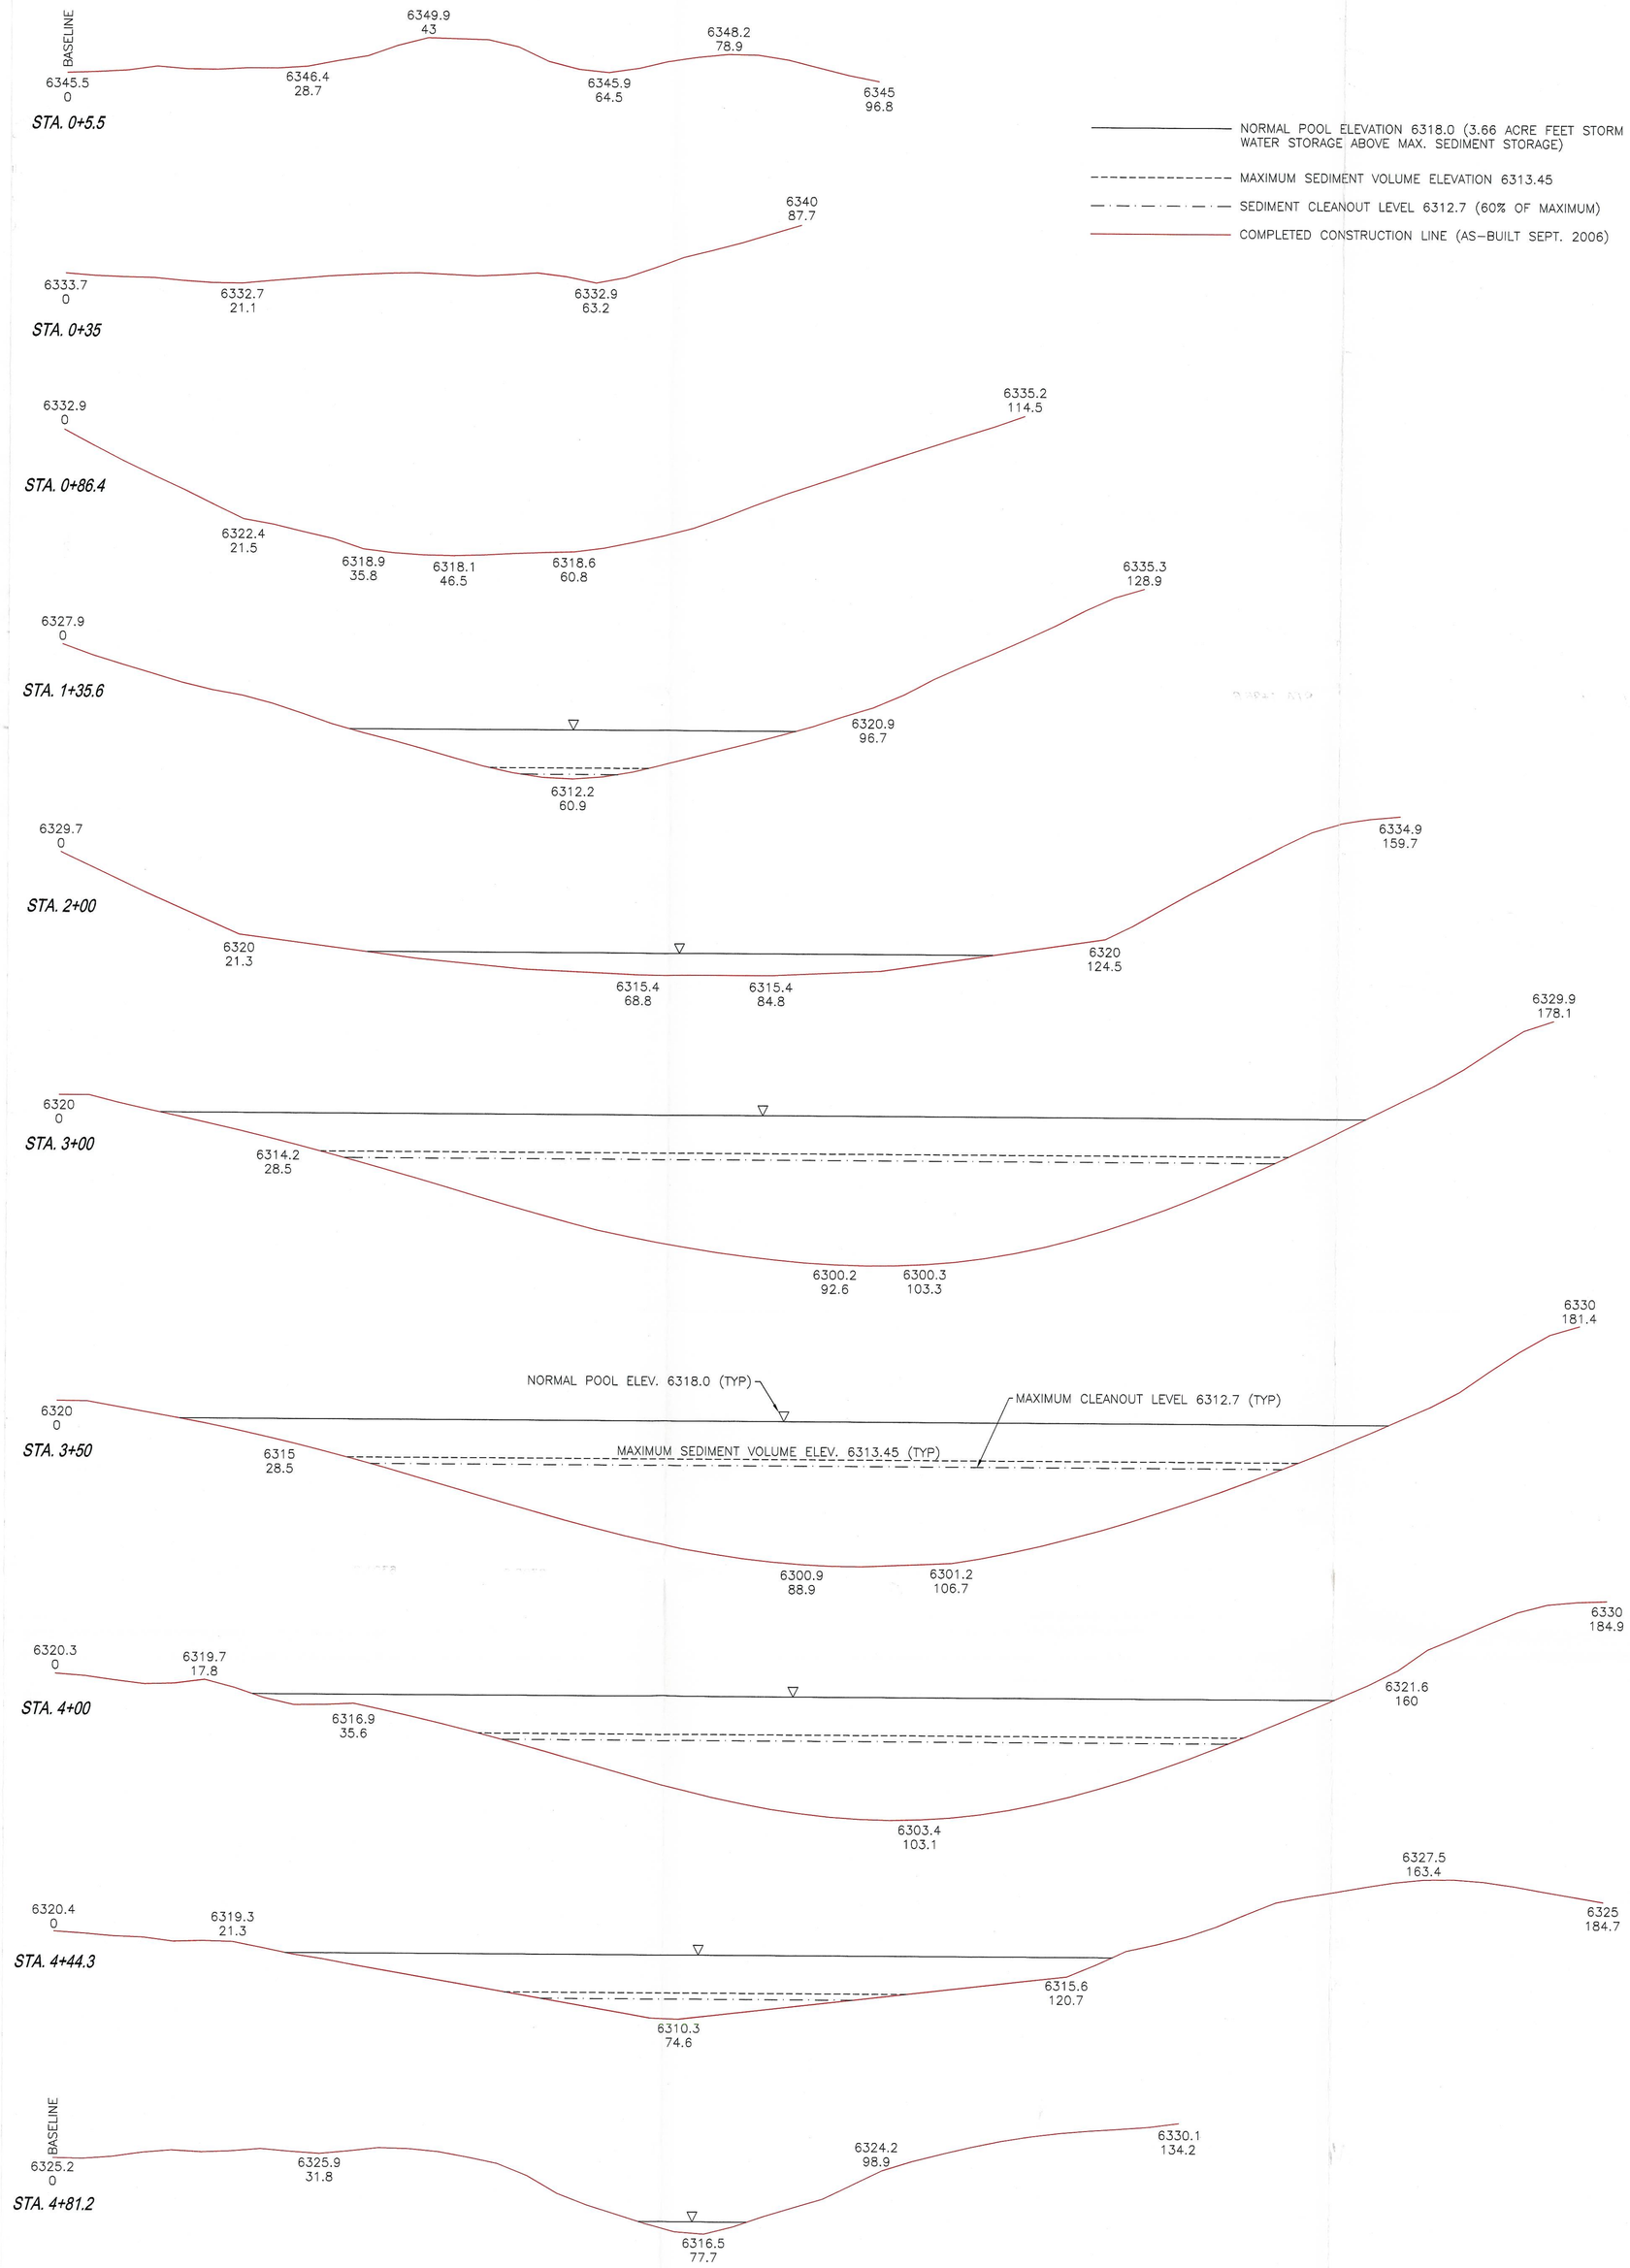

SEDIMENT BASIN - CROSS SECTIONS

SCALE: 1"=10'

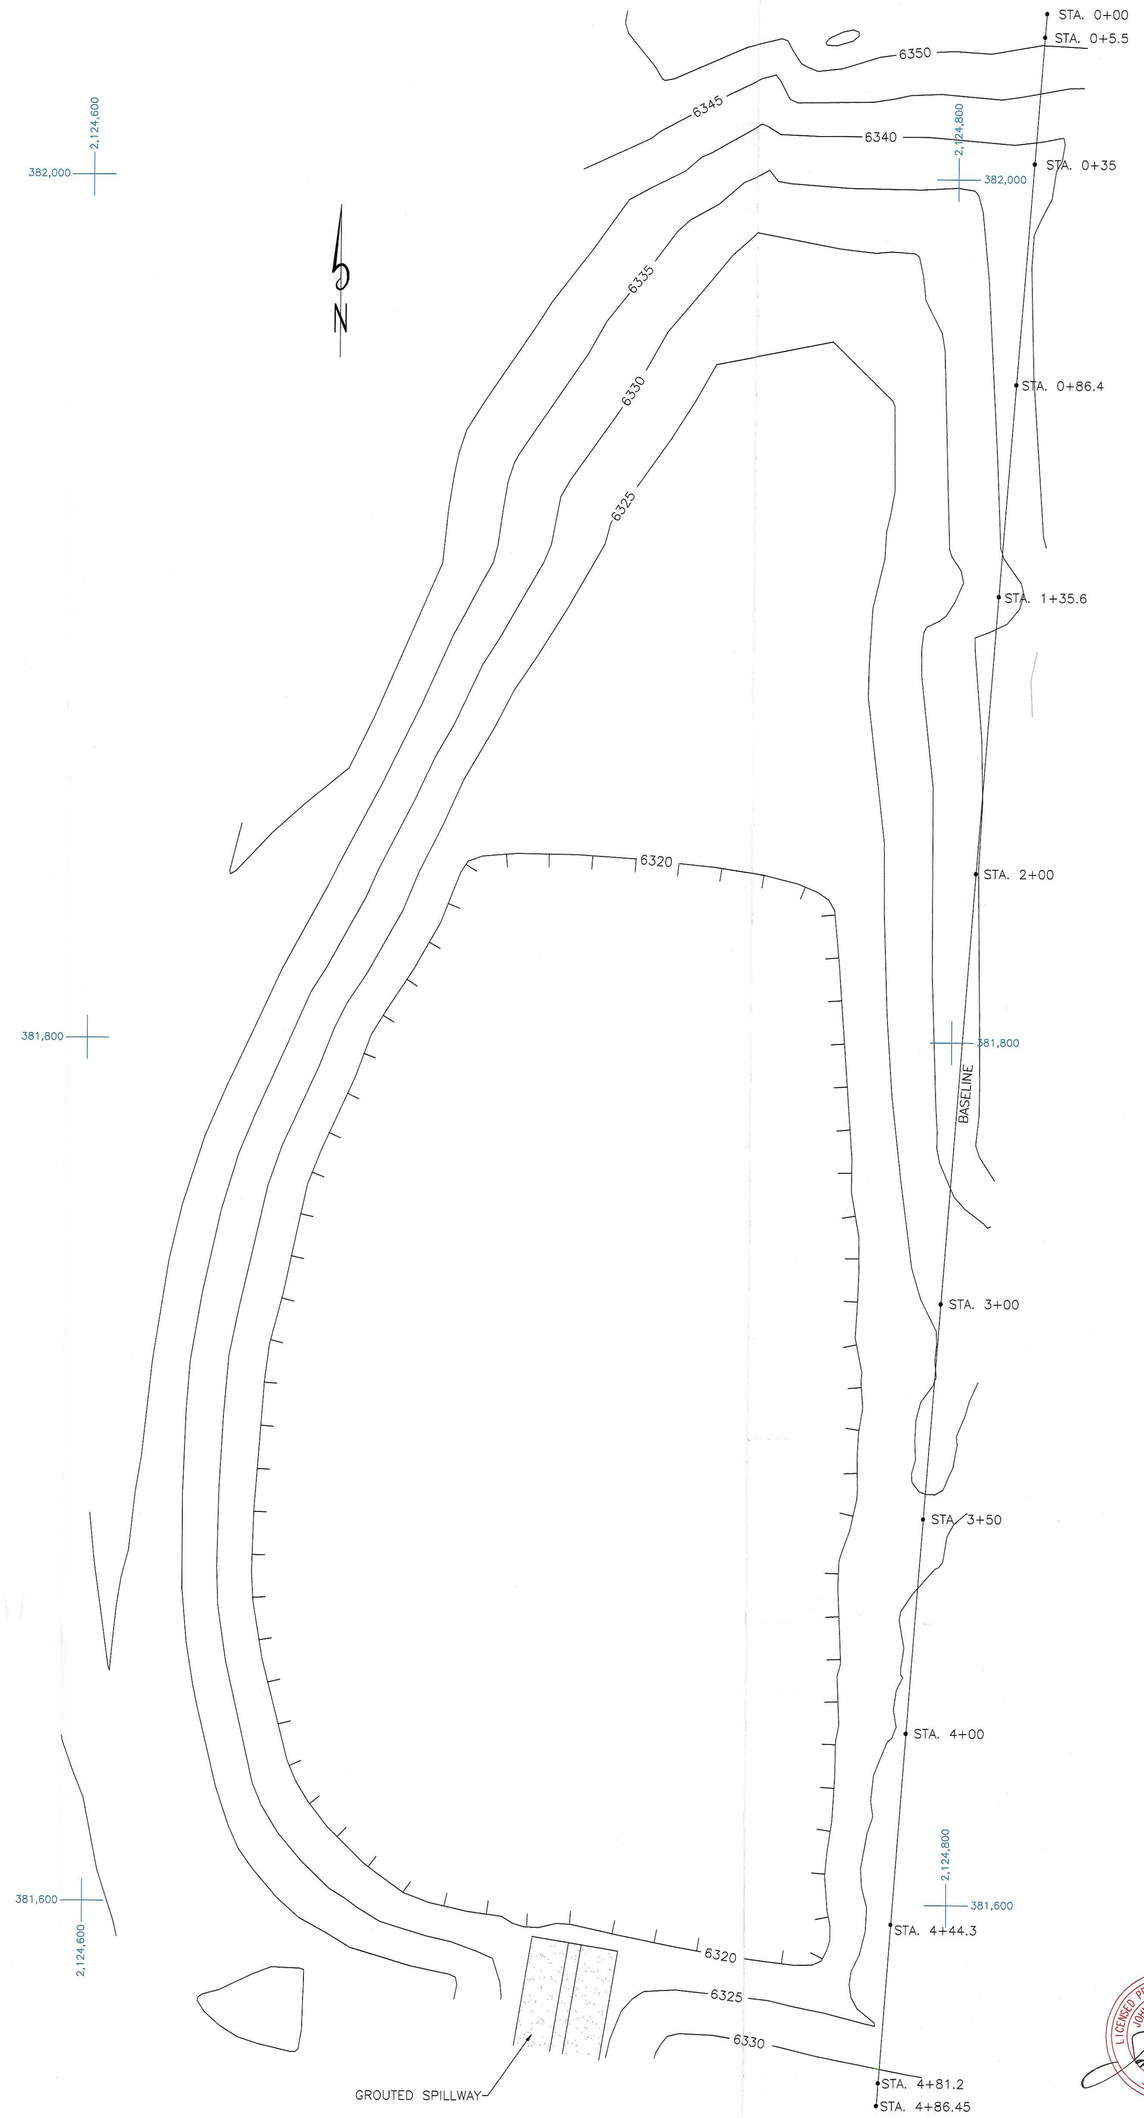

PLAN VIEW - SEDIMENTATION POND

SCALE: 1"=20'

LICENSED PROFESSIONAL ENGINEER
JOHN CHRISTENSEN
No. 166551
STATE OF UTAH
11/30/07

INCORPORATED
DEC 06 2007
Div. of Oil, Gas & Mining

RECEIVED
DEC 05 2007
DIV. OF OIL, GAS & MINING

CAD FILE NAME/DISK#: CM-10880-DR.DWG

4-11

ENERGY WEST MINING COMPANY
A SUBSIDIARY OF PACIFICORP

DEER CREEK MINE/WASTE ROCK STORAGE FACILITY
SEDIMENT DETENTION BASIN
PLAN VIEW AND CROSS SECTIONS

DRAWN BY:	K. LARSEN	CM-10880-DR
SCALE:	AS NOTED	DRAWING #:
DATE:	SEPT. 23, 1992	SHEET 1 OF 1 REV.

DATE	REVISION	BY
5-14-07	REVISED TO REFLECT THE AS-BUILT CONDITIONS	KJL