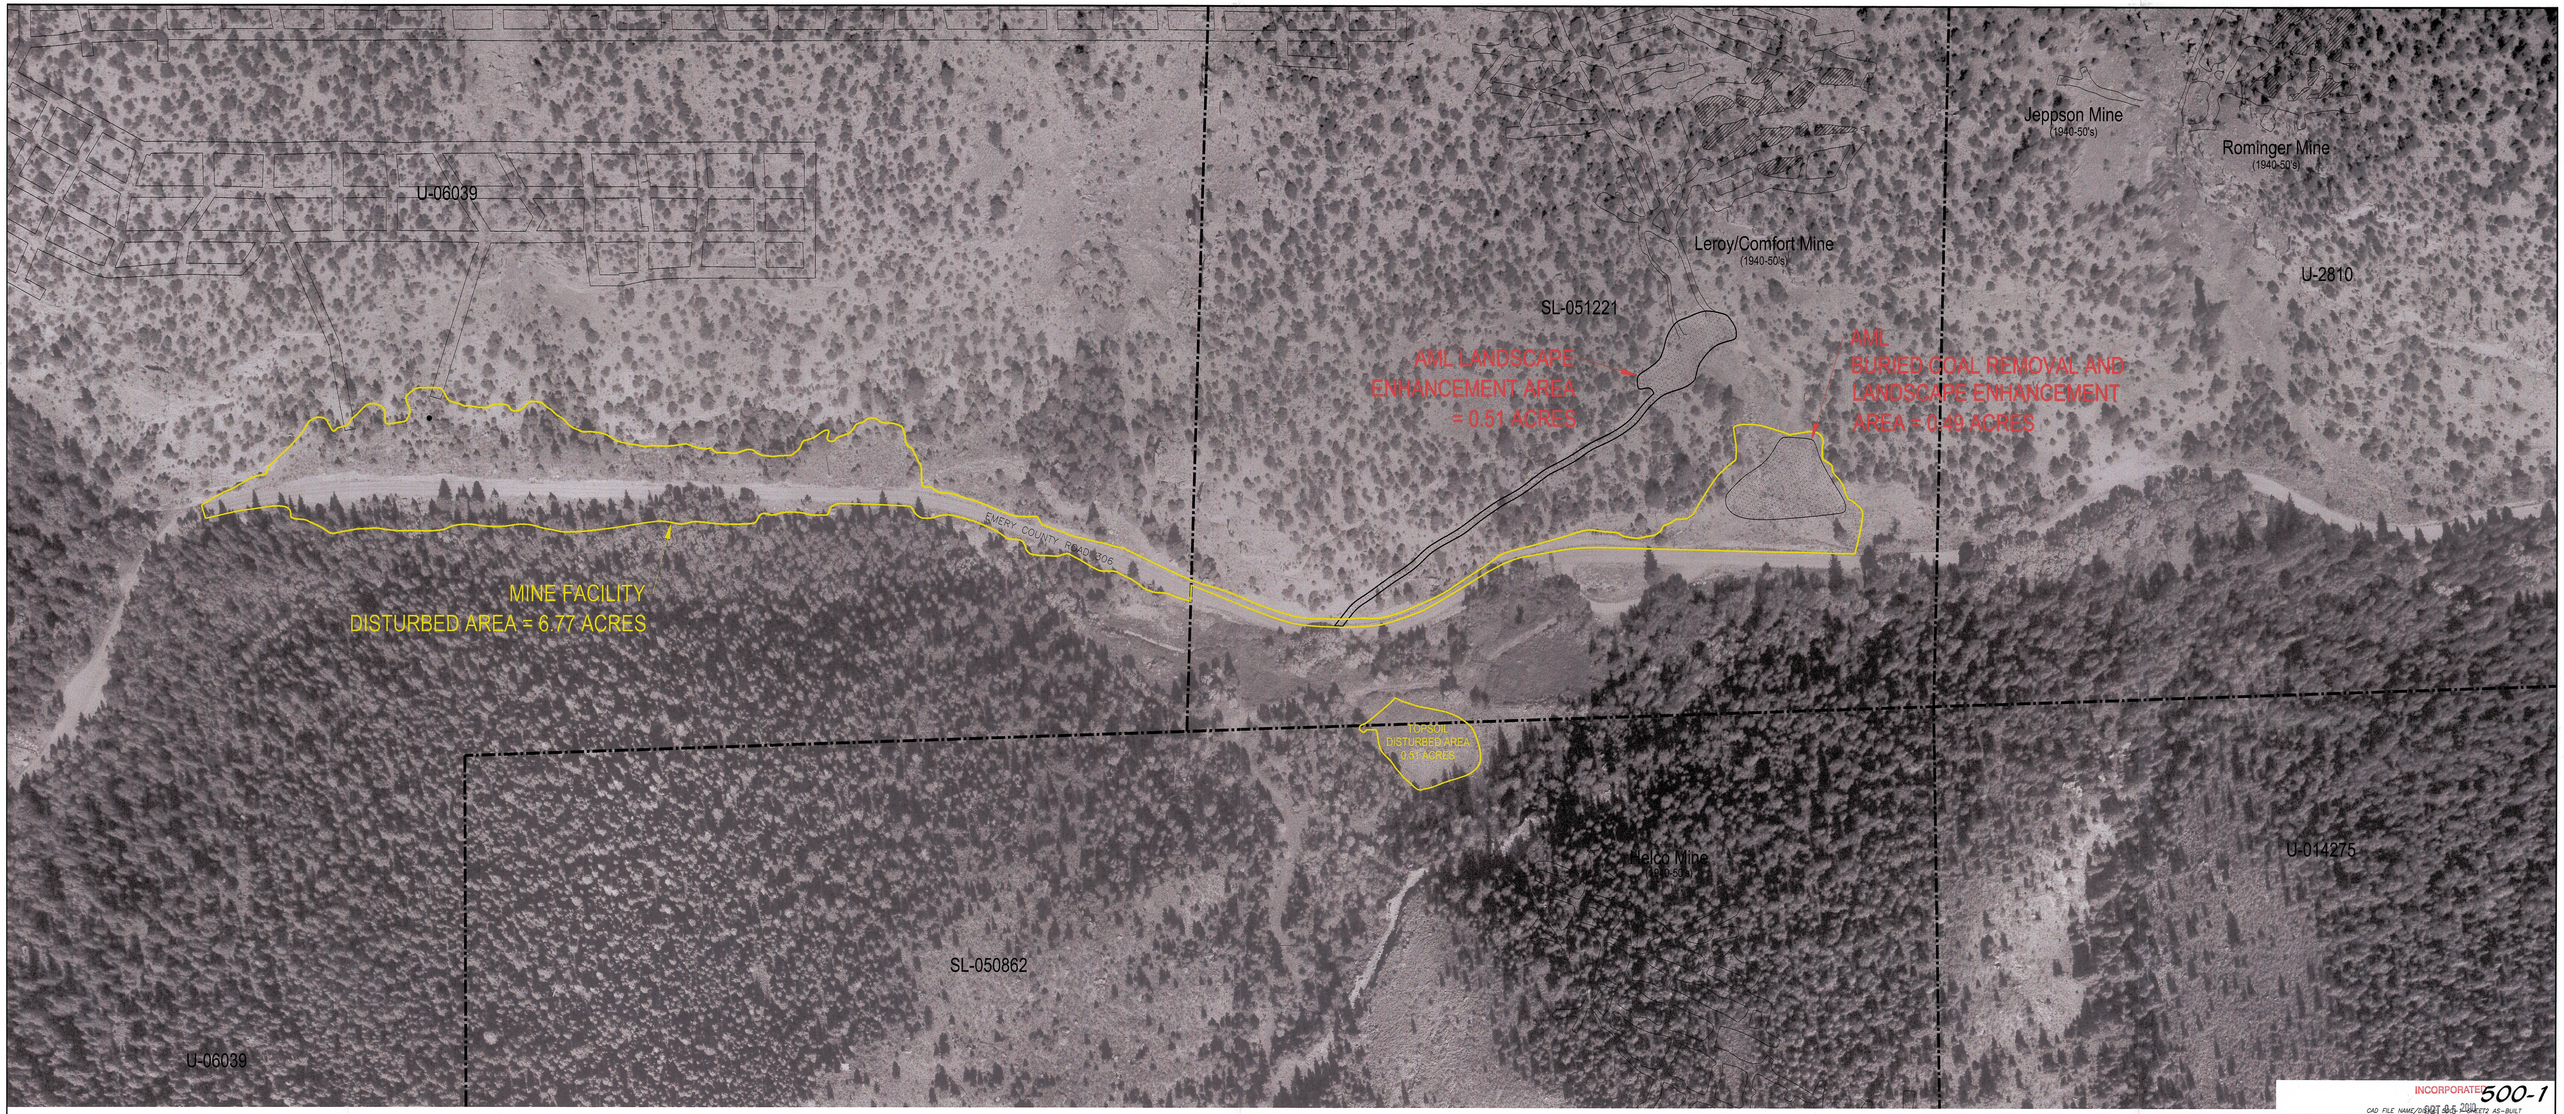

INCORPORATED 500-1
OCT 04 2010
CAD FILE NAME/DATE: 500-1 AS-BUILT2 AS-BUILT

ENERGY & WEST MINING COMPANY
A SUBSIDIARY OF PACIFICORP

DEER CREEK MINE
RILDA CANYON
PRE-DISTURBANCE AERIAL

RECEIVED
NOV 04 2010
DIV. OF OIL, GAS & MINING

DATE	REVISION	BY	CHK
2/4/2010	ADDED AS-BUILT DISTURBED AREA BOUNDARY AND AML LANDSCAPE ENHANCEMENT AREAS	KJL	

DRAWN BY:	K. LARSEN	500-1	
SCALE:	1" = 100'	DRAWING #:	
DATE:	APRIL 16, 2010	SHEET 2 OF 3	REV. 1