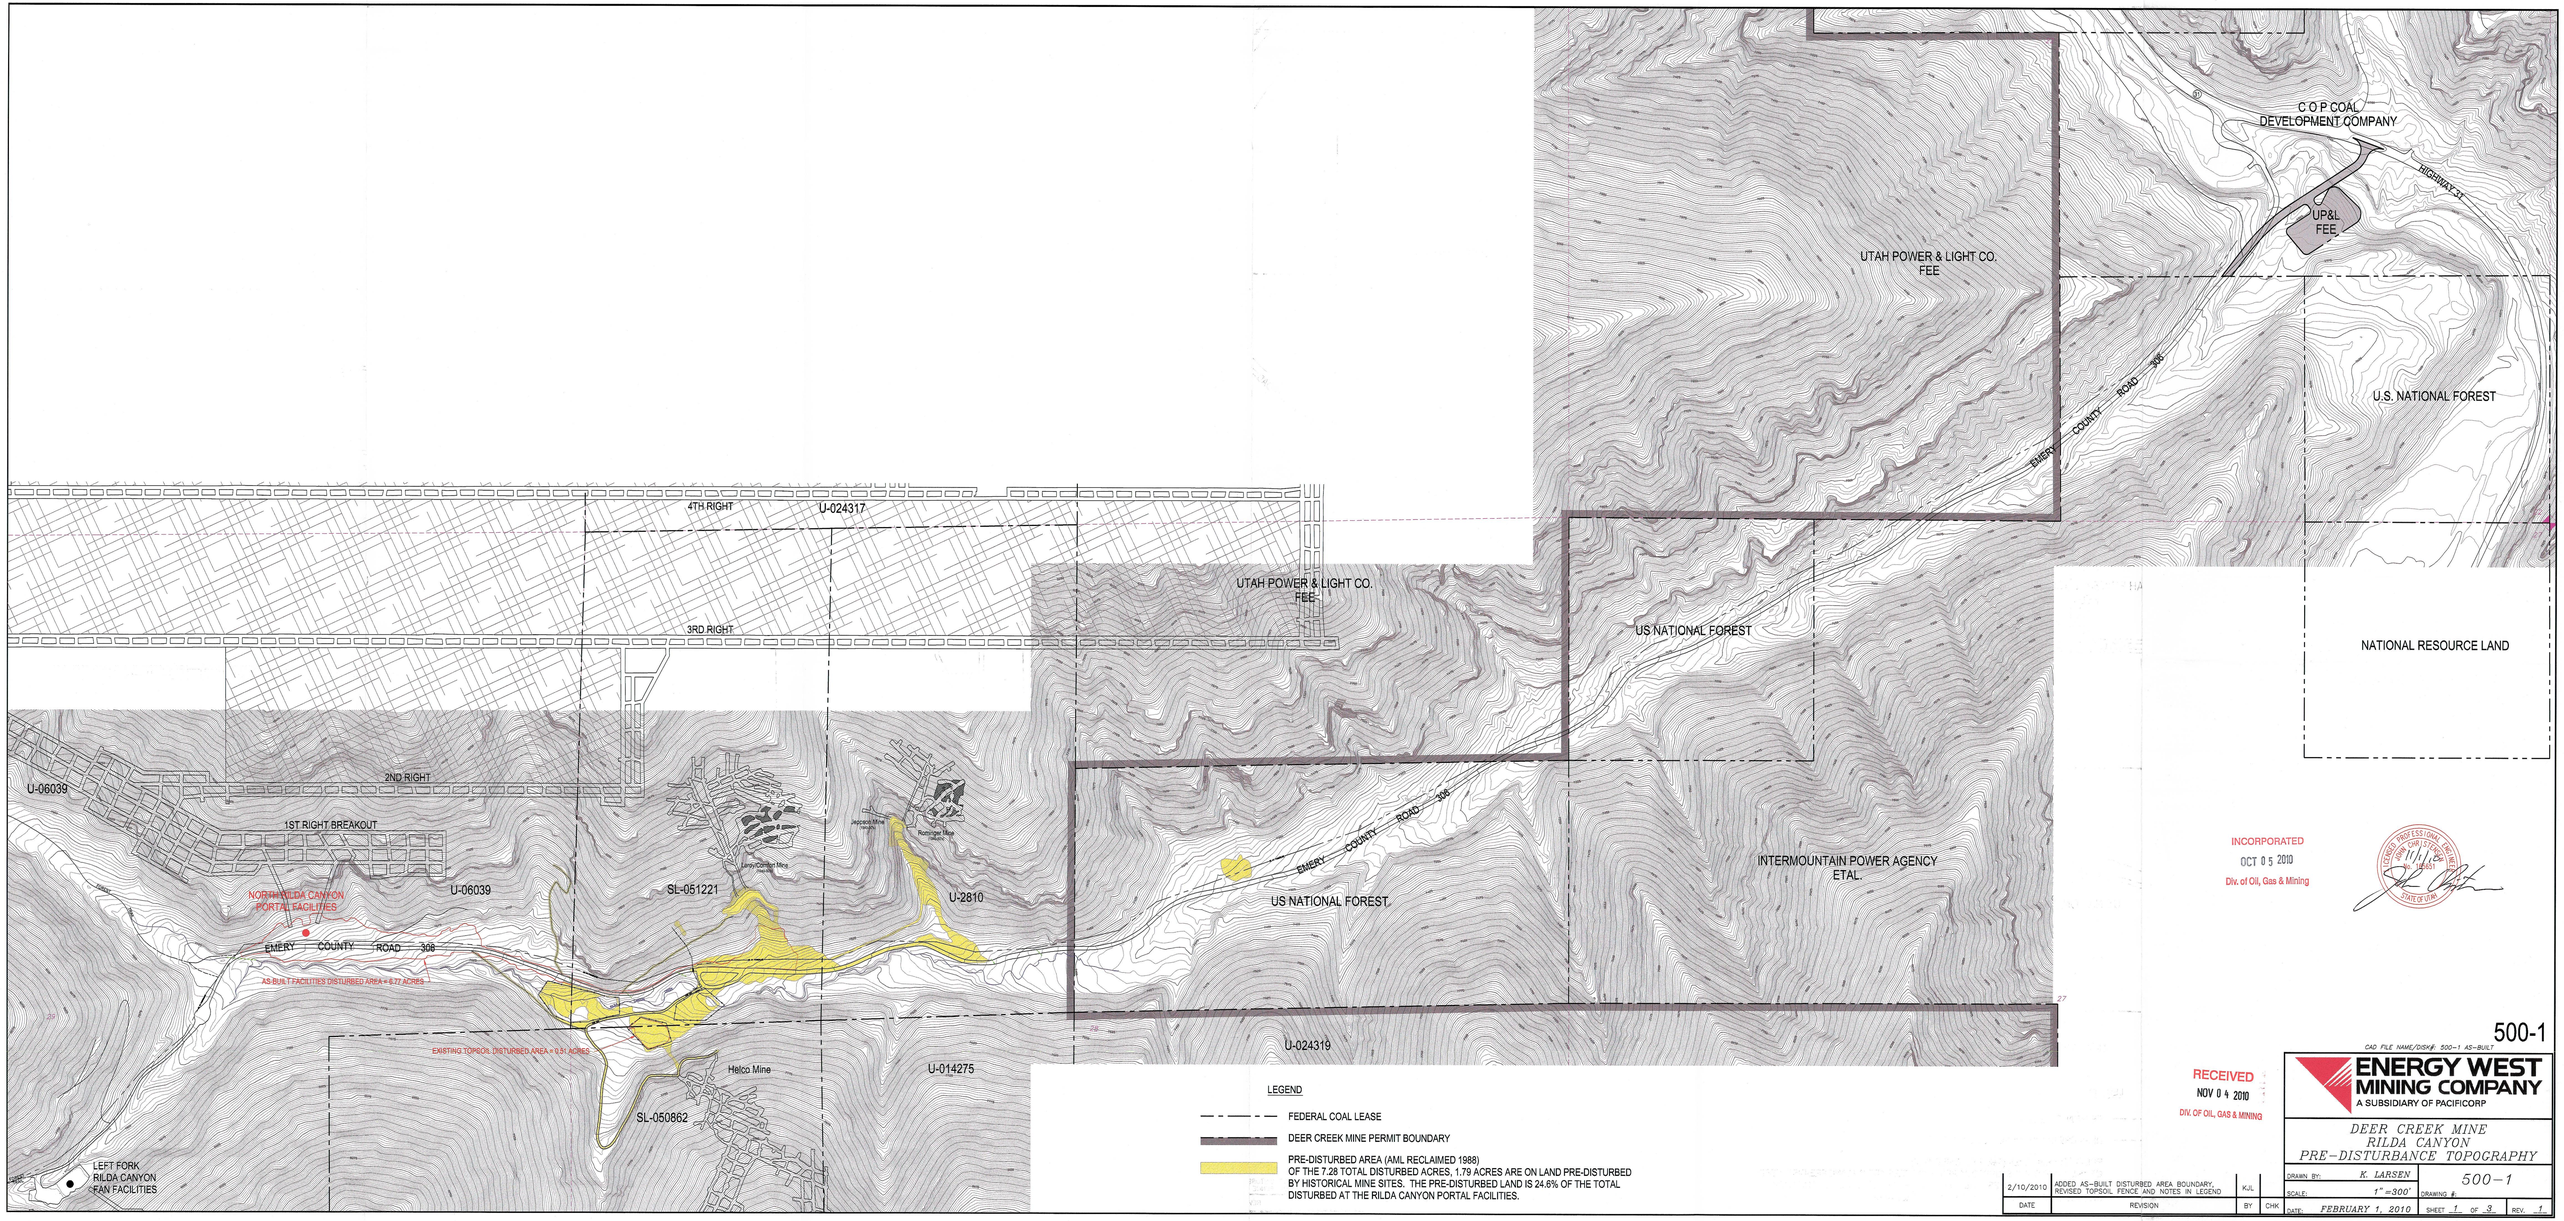

INCORPORATED
OCT 0 5 2010
Div. of Oil, Gas & Mining

RECEIVED
NOV 0 4 2010
DIV. OF OIL, GAS & MINING

500-1

CAD FILE NAME/DISK#: 500-1 AS-BUILT

ENERGY WEST MINING COMPANY
A SUBSIDIARY OF PACIFICORP

DEER CREEK MINE
RILDA CANYON
PRE-DISTURBANCE TOPOGRAPHY

DATE	REVISION	BY	CHK
2/10/2010	ADDED AS-BUILT DISTURBED AREA BOUNDARY, REVISED TOPSOIL FENCE AND NOTES IN LEGEND	KJL	

DRAWN BY: K. LARSEN
SCALE: 1"=300'
DATE: FEBRUARY 1, 2010
DRAWING #: 500-1
SHEET 1 OF 3
REV. 1