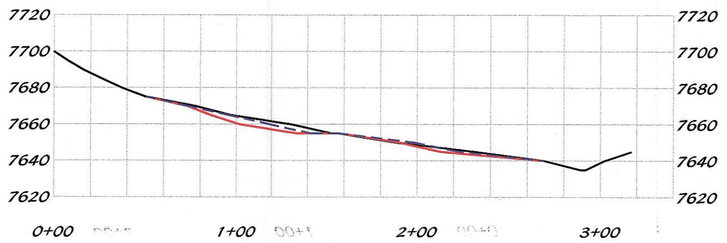

9+50

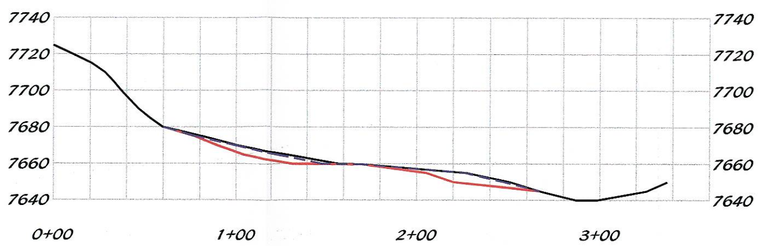

9+00

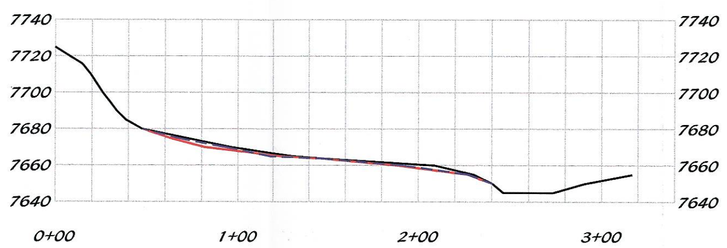

8+50

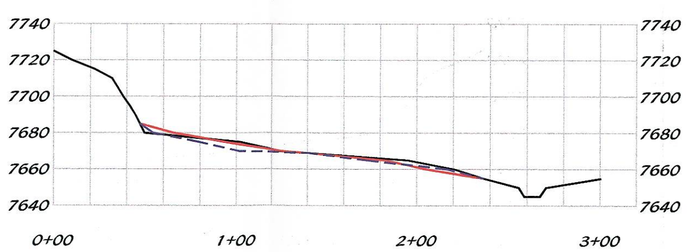

8+00

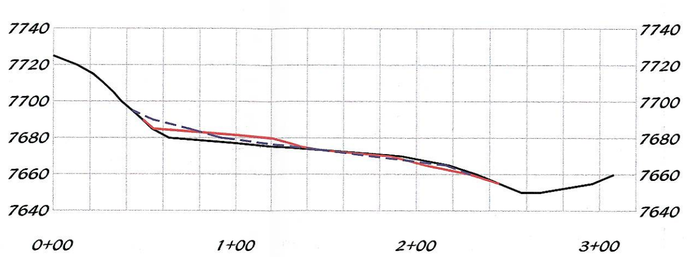

7+50

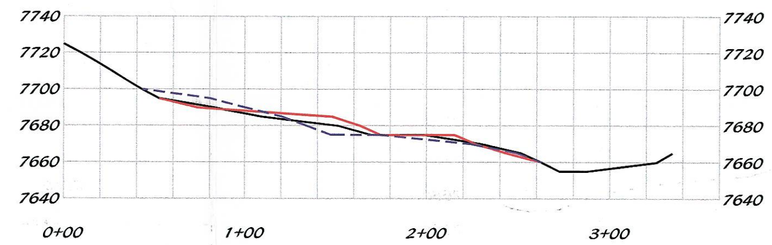

7+00

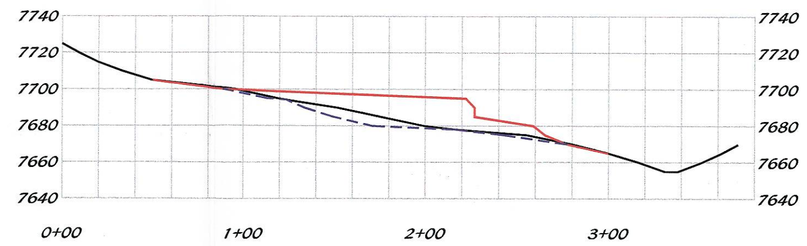

6+50

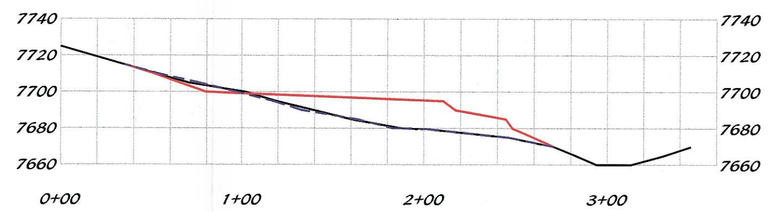

6+00

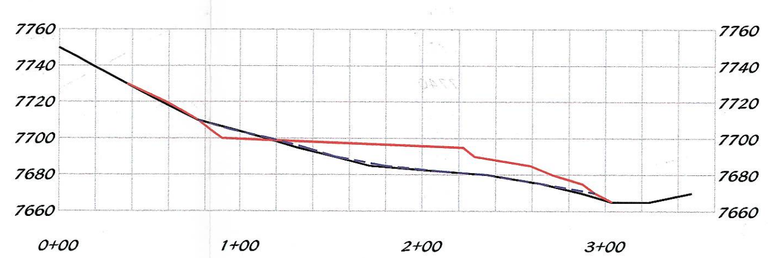

5+50

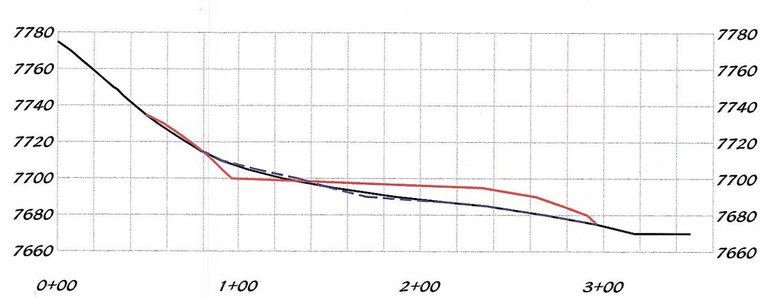

5+00

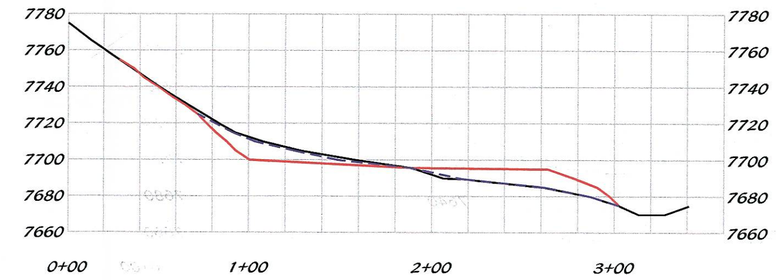

4+50

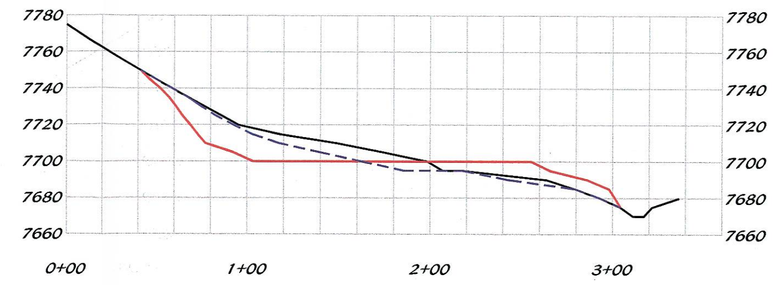

4+00

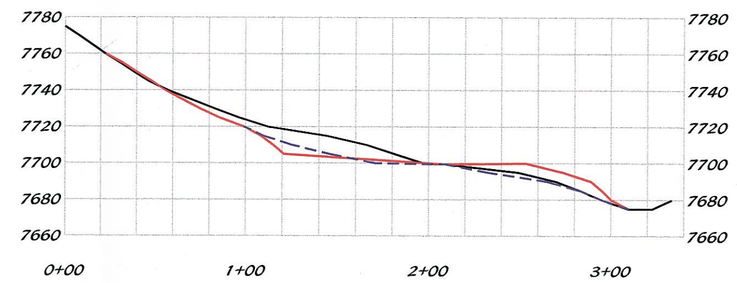

3+50

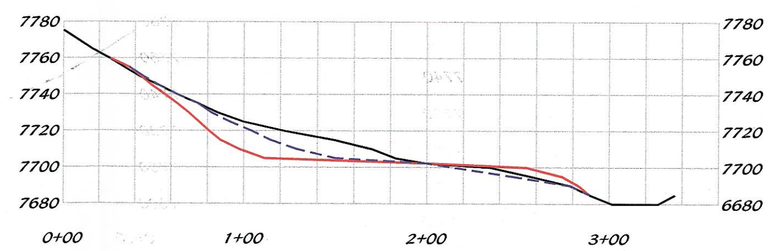

3+00

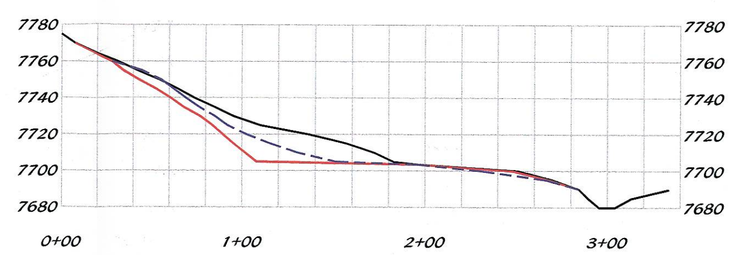

2+50

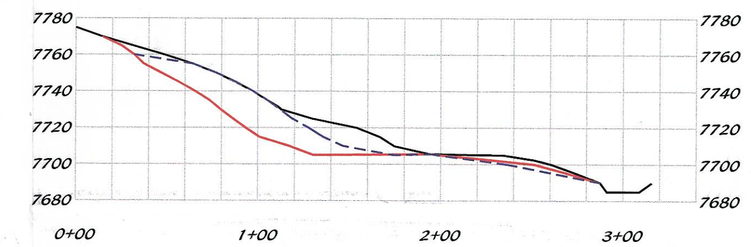

2+00

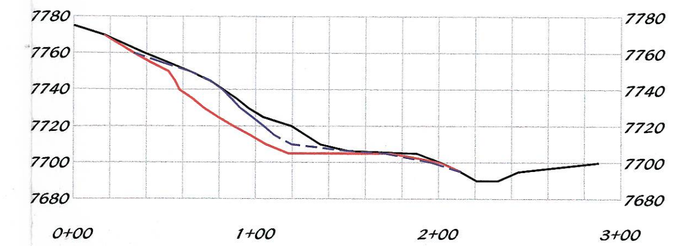

1+50

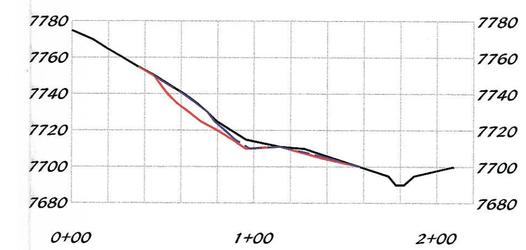

1+00

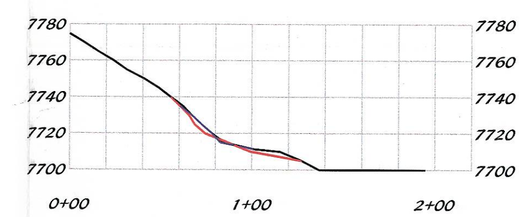

0+50

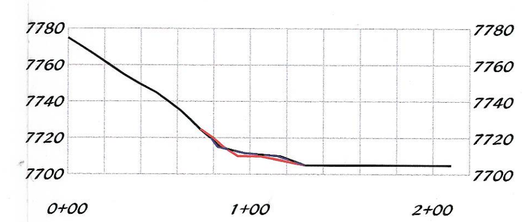

0+00

INCORPORATED
OCT 0 5 2010
Div. of Oil, Gas & Mining

500-4

CAD FILE NAME/DISK#: 500-4 AS-BUILT

NOTES

1. CROSS SECTIONS REFERENCE FROM 500-3
2. REFER TO VOLUME 11 APPENDIX VOLUME ENGINEERING APPENDIX F FOR SLOPE STABILITY ANALYSIS

LICENSED PROFESSIONAL ENGINEER
JOHN CARASTATHIS
No. 146651
STATE OF UTAH

LEGEND

- PRE-EXISTING LINE
- POST CONSTRUCTION LINE
- FINAL RECLAMATION LINE

RECEIVED
NOV 0 4 2010
DIV. OF OIL, GAS & MINING

DATE	REVISION	BY	CHK
2/19/2010	REVISED TO REFLECT THE AS-BUILT CONDITIONS	KJL	

ENERGY WEST MINING COMPANY
A SUBSIDIARY OF PACIFICORP

DEER CREEK MINE
RILDA CANYON FACILITIES
CROSS SECTIONS

DRAWN BY: K. LARSEN
SCALE: 1" =60'
DATE: MARCH 25, 2009
DRAWING #: 500-4
SHEET 1 OF 4
REV. 1