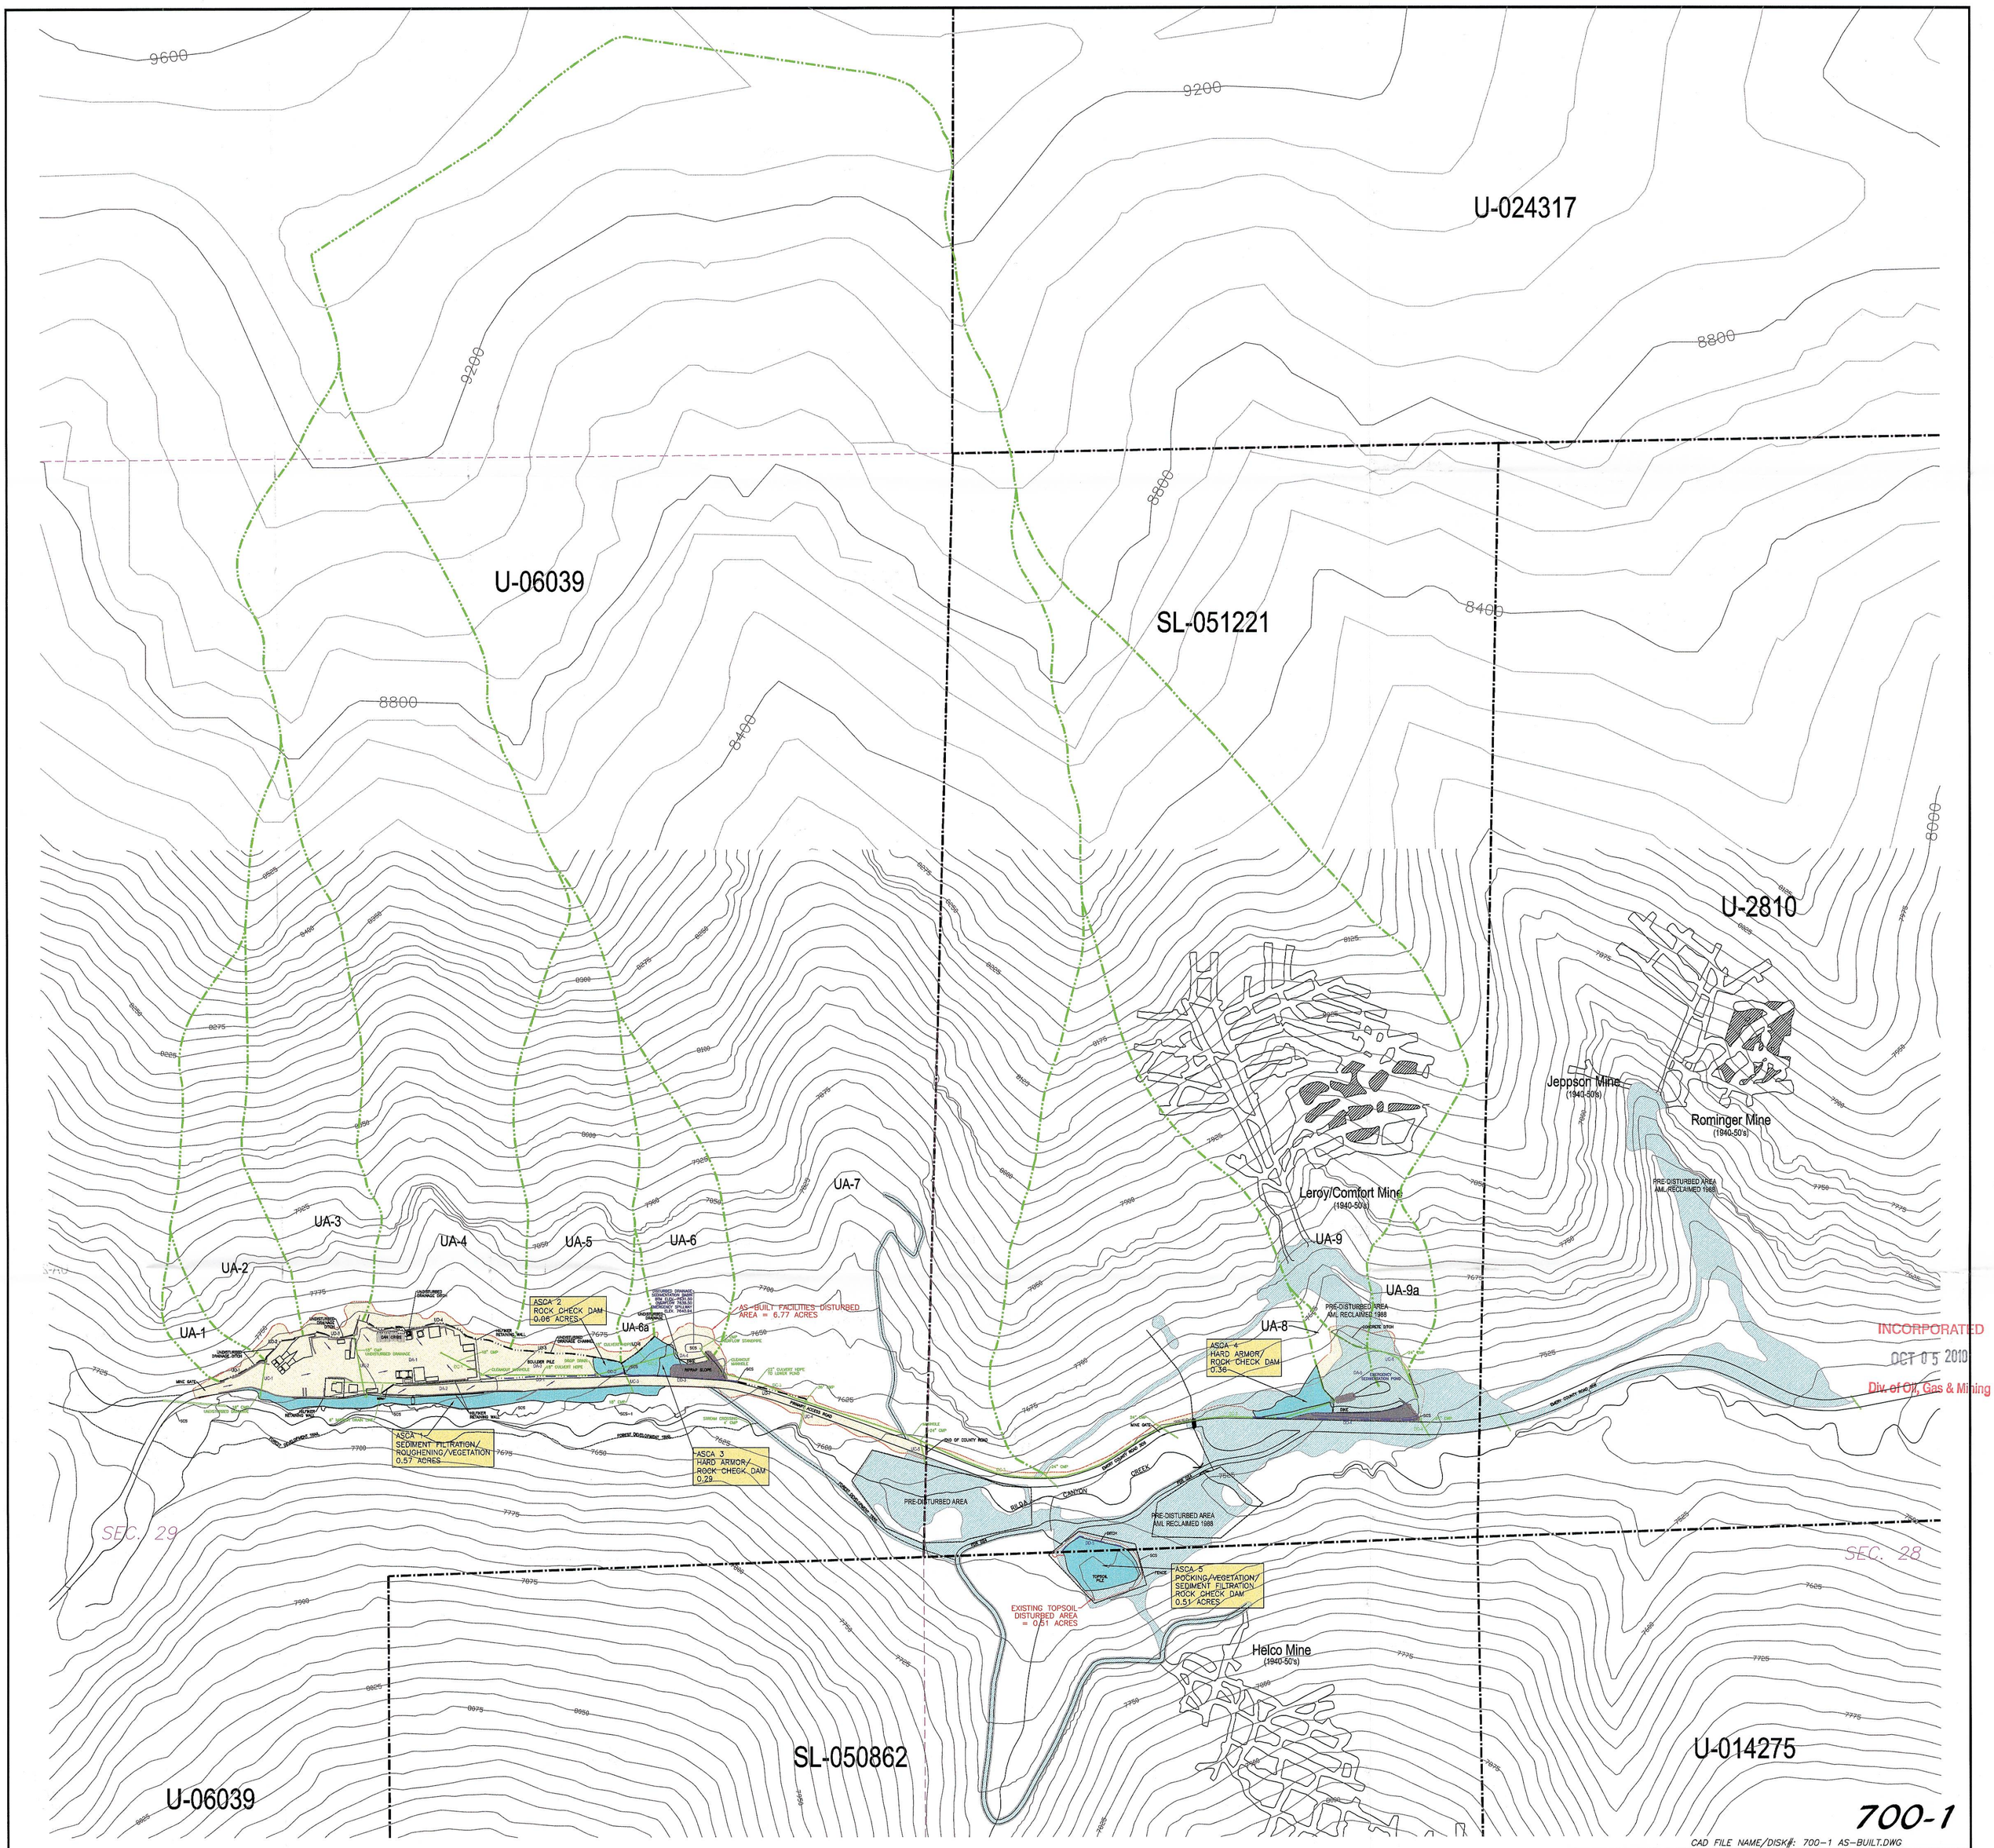

700-1

CAD FILE NAME/DISK#: 700-1 AS-BUILT.DWG

INCORPORATED
OCT 0 5 2010
Div. of Oil, Gas & Mining

RECEIVED
NOV 0 4 2010
DIV. OF OIL, GAS & MINING

LICENSED PROFESSIONAL ENGINEER
JOHN CHR. STENGEN
No. 165651
STATE OF UTAH
11/1/10

Legend:

Undisturbed Drainage Area	Jersey Barrier
UA-5a (Numbers Report to Bypass Culverts)	Drop Inlet
Disturbed Area Ditch	Culvert
Undisturbed Area Ditch	Rip Rap
Direction of Flow	Fence
As-Built Disturbed Area	Dirt Berm
Pre-Disturbance Area	SCS Sediment Control Structure

DATE	REVISION	BY	CHK
6/16/2010	REVISED TO REFLECT THE AS-BUILT CONDITIONS, DISTURBED AREA BOUNDARY AND TOPOGRAPHY	KJL	

ENERGY WEST MINING COMPANY
A SUBSIDIARY OF PACIFICORP

DEER CREEK MINE
RILDA CANYON FACILITIES
DRAINAGE AREA MAP

DRAWN BY: K. LARSEN
SCALE: 1" =200'
DATE: AUGUST 25, 2004
DRAWING #: 700-1
SHEET 1 OF 1
REV. ___