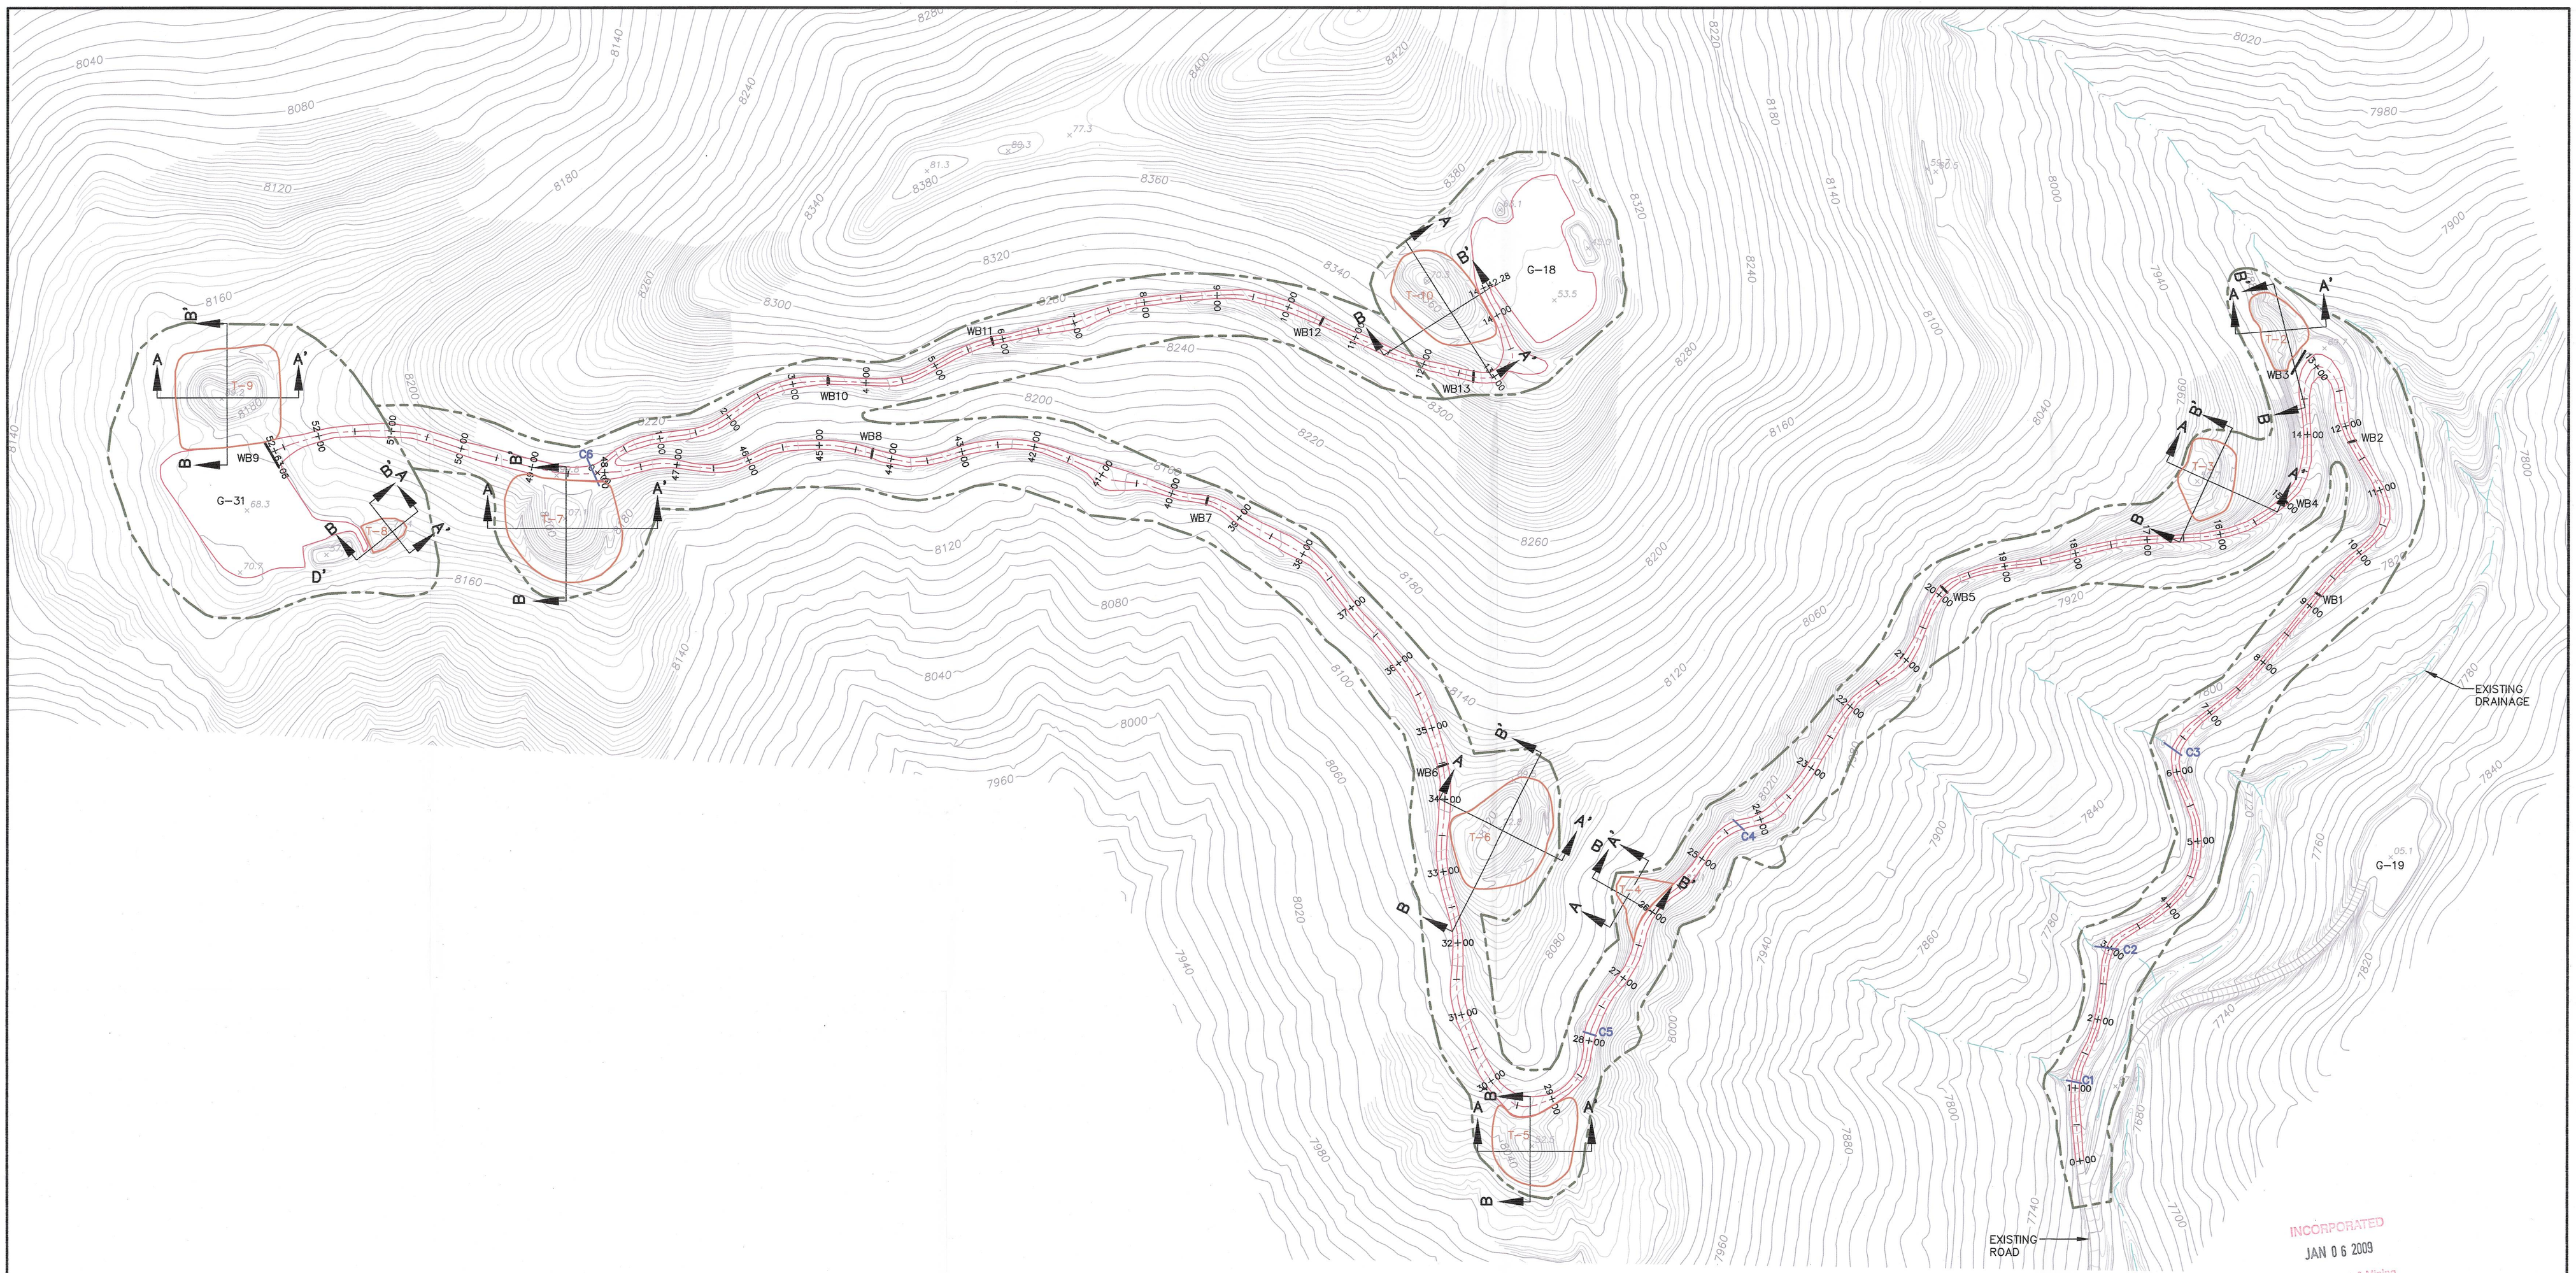


INCORPORATED
JAN 0 6 2009
Div. of Oil, Gas & Mining

RECEIVED
JAN 2 1 2009
DIV. OF OIL, GAS & MINING

REGISTERED PROFESSIONAL ENGINEER
No. 168246
RICHARD B. WHITE
STATE OF UTAH

LEGEND

- STOCKPILE LOCATIONS
- WB10 WATER BAR
- C4 CULVERT
- CENTER LINE OF ROAD
- DISTURBED AREA BOUNDARY

| REVISIONS OR UP-DATES | | |
|---|---|---|
| NO. | DATE | BY |
| 1 | 12/29/08 | SWF |

| | |
|---|---|
| DATE: | AUGUST, 2008 |
| DESIGNED BY: | ADM |
| DRAWN BY: | SWF |
| CHECKED BY: | |
| SCALE: | 1"=100' |

FILENAME: G:\1098-03 ACCESS ROAD\ASBUILT DWGS\ATT5-4-PLATE1.DWG

Canyon Fuel Company, LLC
Dugout Canyon Mine

# DEGAS WELL G-31, G-18 AND ACCESS ROAD

P.O BOX 1029
WELLINGTON, UTAH 84542

DRAWING OR MAP NUMBER ATTACHMENT 5-4a PLATE 1