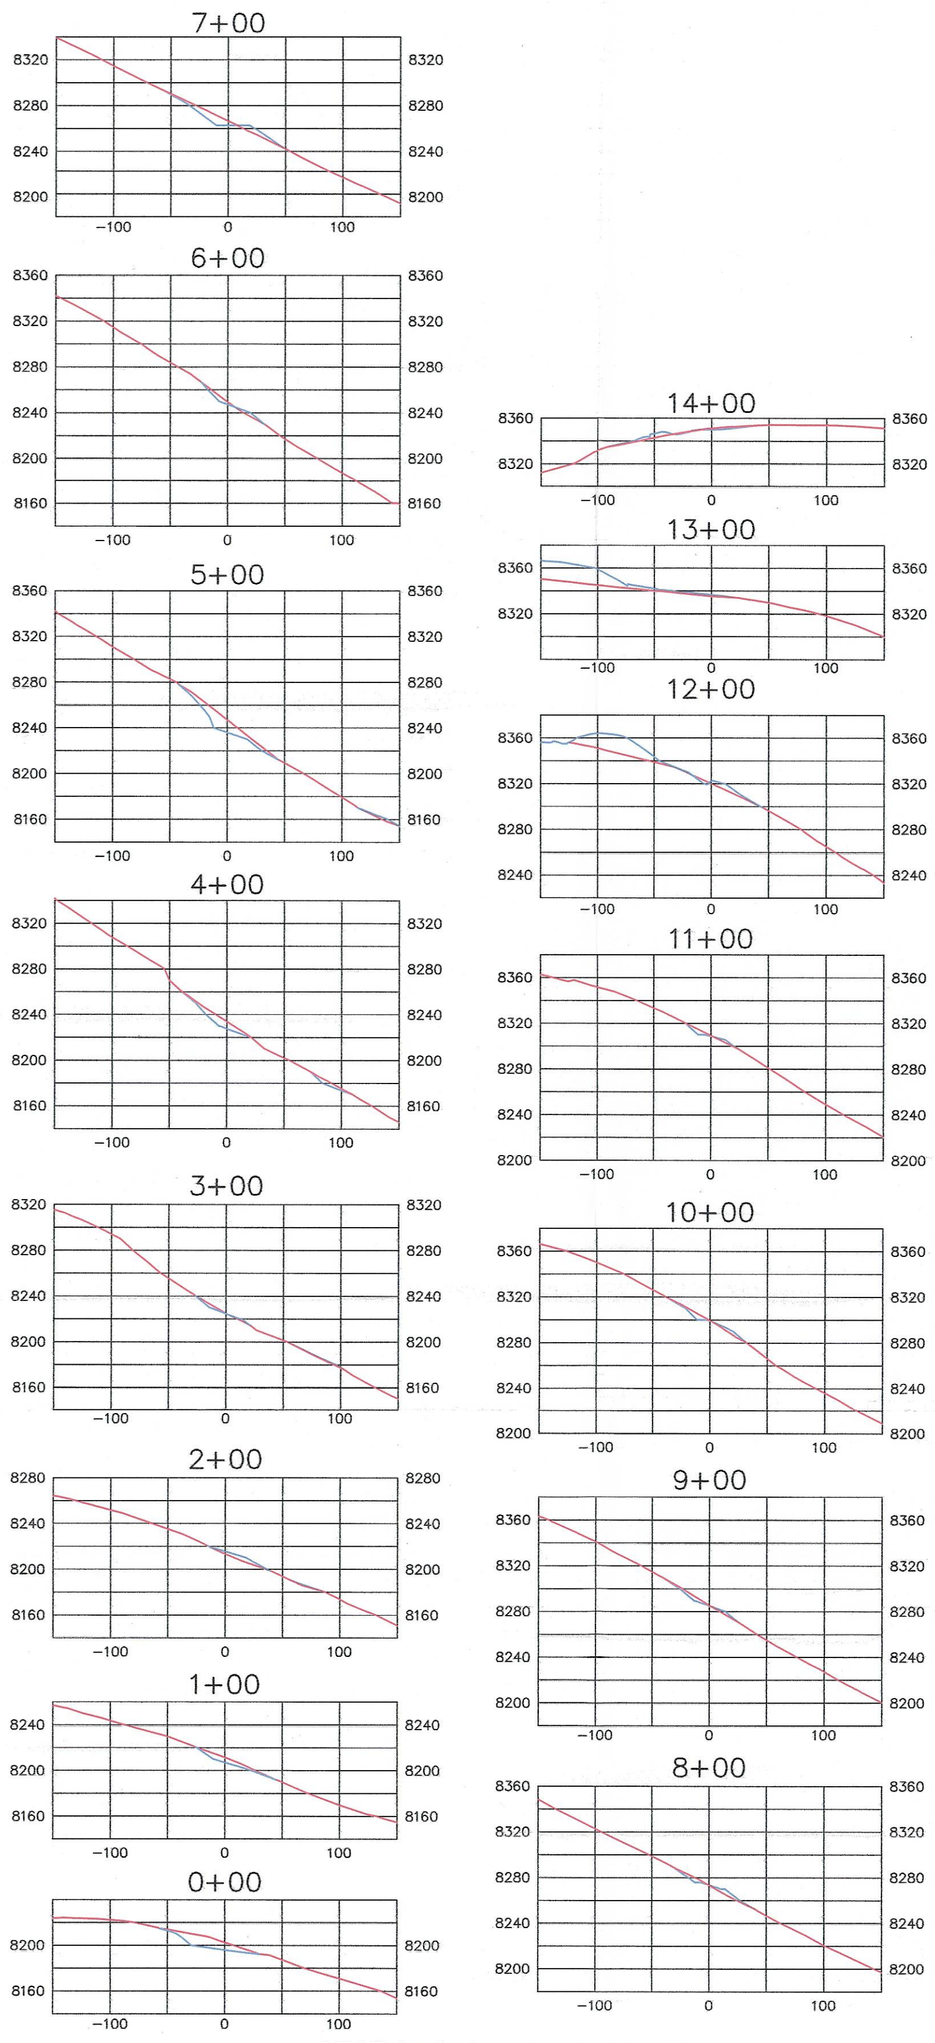

SECTIONS 0+00 TO 19+00
(TO G-18)

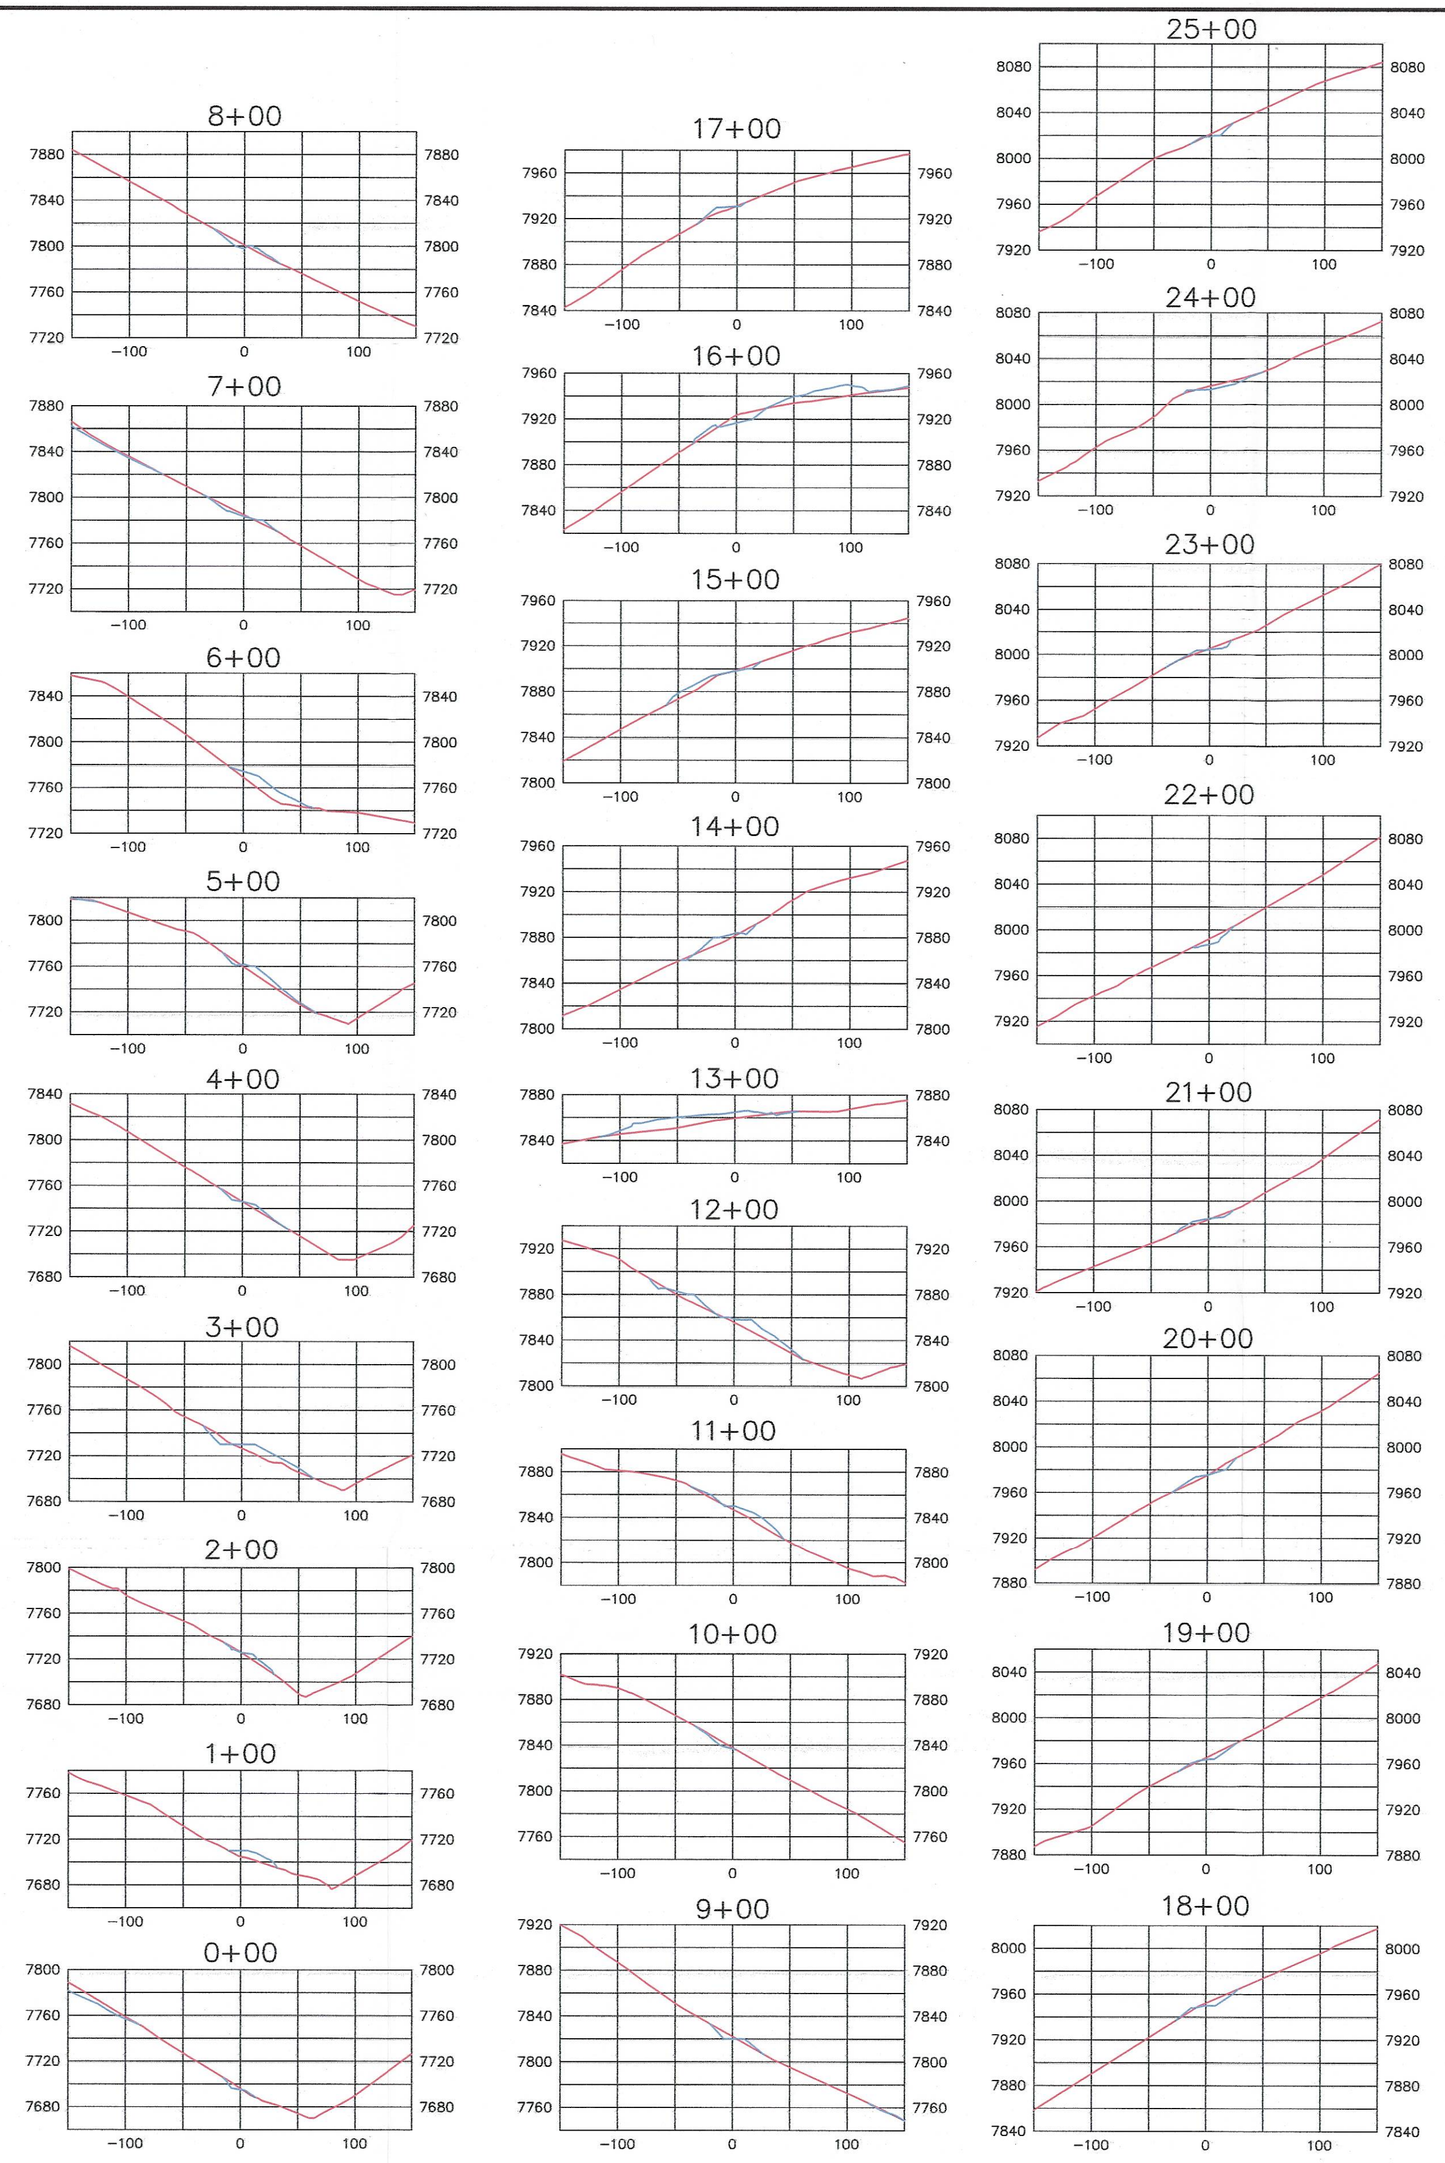

SECTIONS 0+00 TO 52+00
(TO G-31)

RECEIVED
JAN 21 2009
DIV. OF OIL, GAS & MINING
INCORPORATED
JAN 06 2009
Div. of Oil, Gas & Mining

LEGEND

EXISTING GROUND SURFACE

ASBUILT SURFACE

REGISTERED PROFESSIONAL ENGINEER
No. 168246
RICHARD B. WHITE
NOT VALID WITHOUT A SEAL
STATE OF UTAH

REVISIONS OR UP-DATES		
NO.	DATE	BY

DATE:	AUGUST, 2008
DESIGNED BY:	ADM
DRAWN BY:	SWF
CHECKED BY:	
SCALE:	1"=100' HORZ. AND VERT.

FILENAME: G:\1098-03 ACCESS ROAD\ASBUILT DWGS\ ATT5-4-PLATE2.DWG

Canyon Fuel Company, LLC
Dugout Canyon Mine

DEGAS WELL G-31, G-18 ASBUILT CROSS-SECTIONS

P.O BOX 1029
WELLINGTON, UTAH 84542

DRAWING OR MAP NUMBER ATTACHMENT 5-4a
PLATE 2