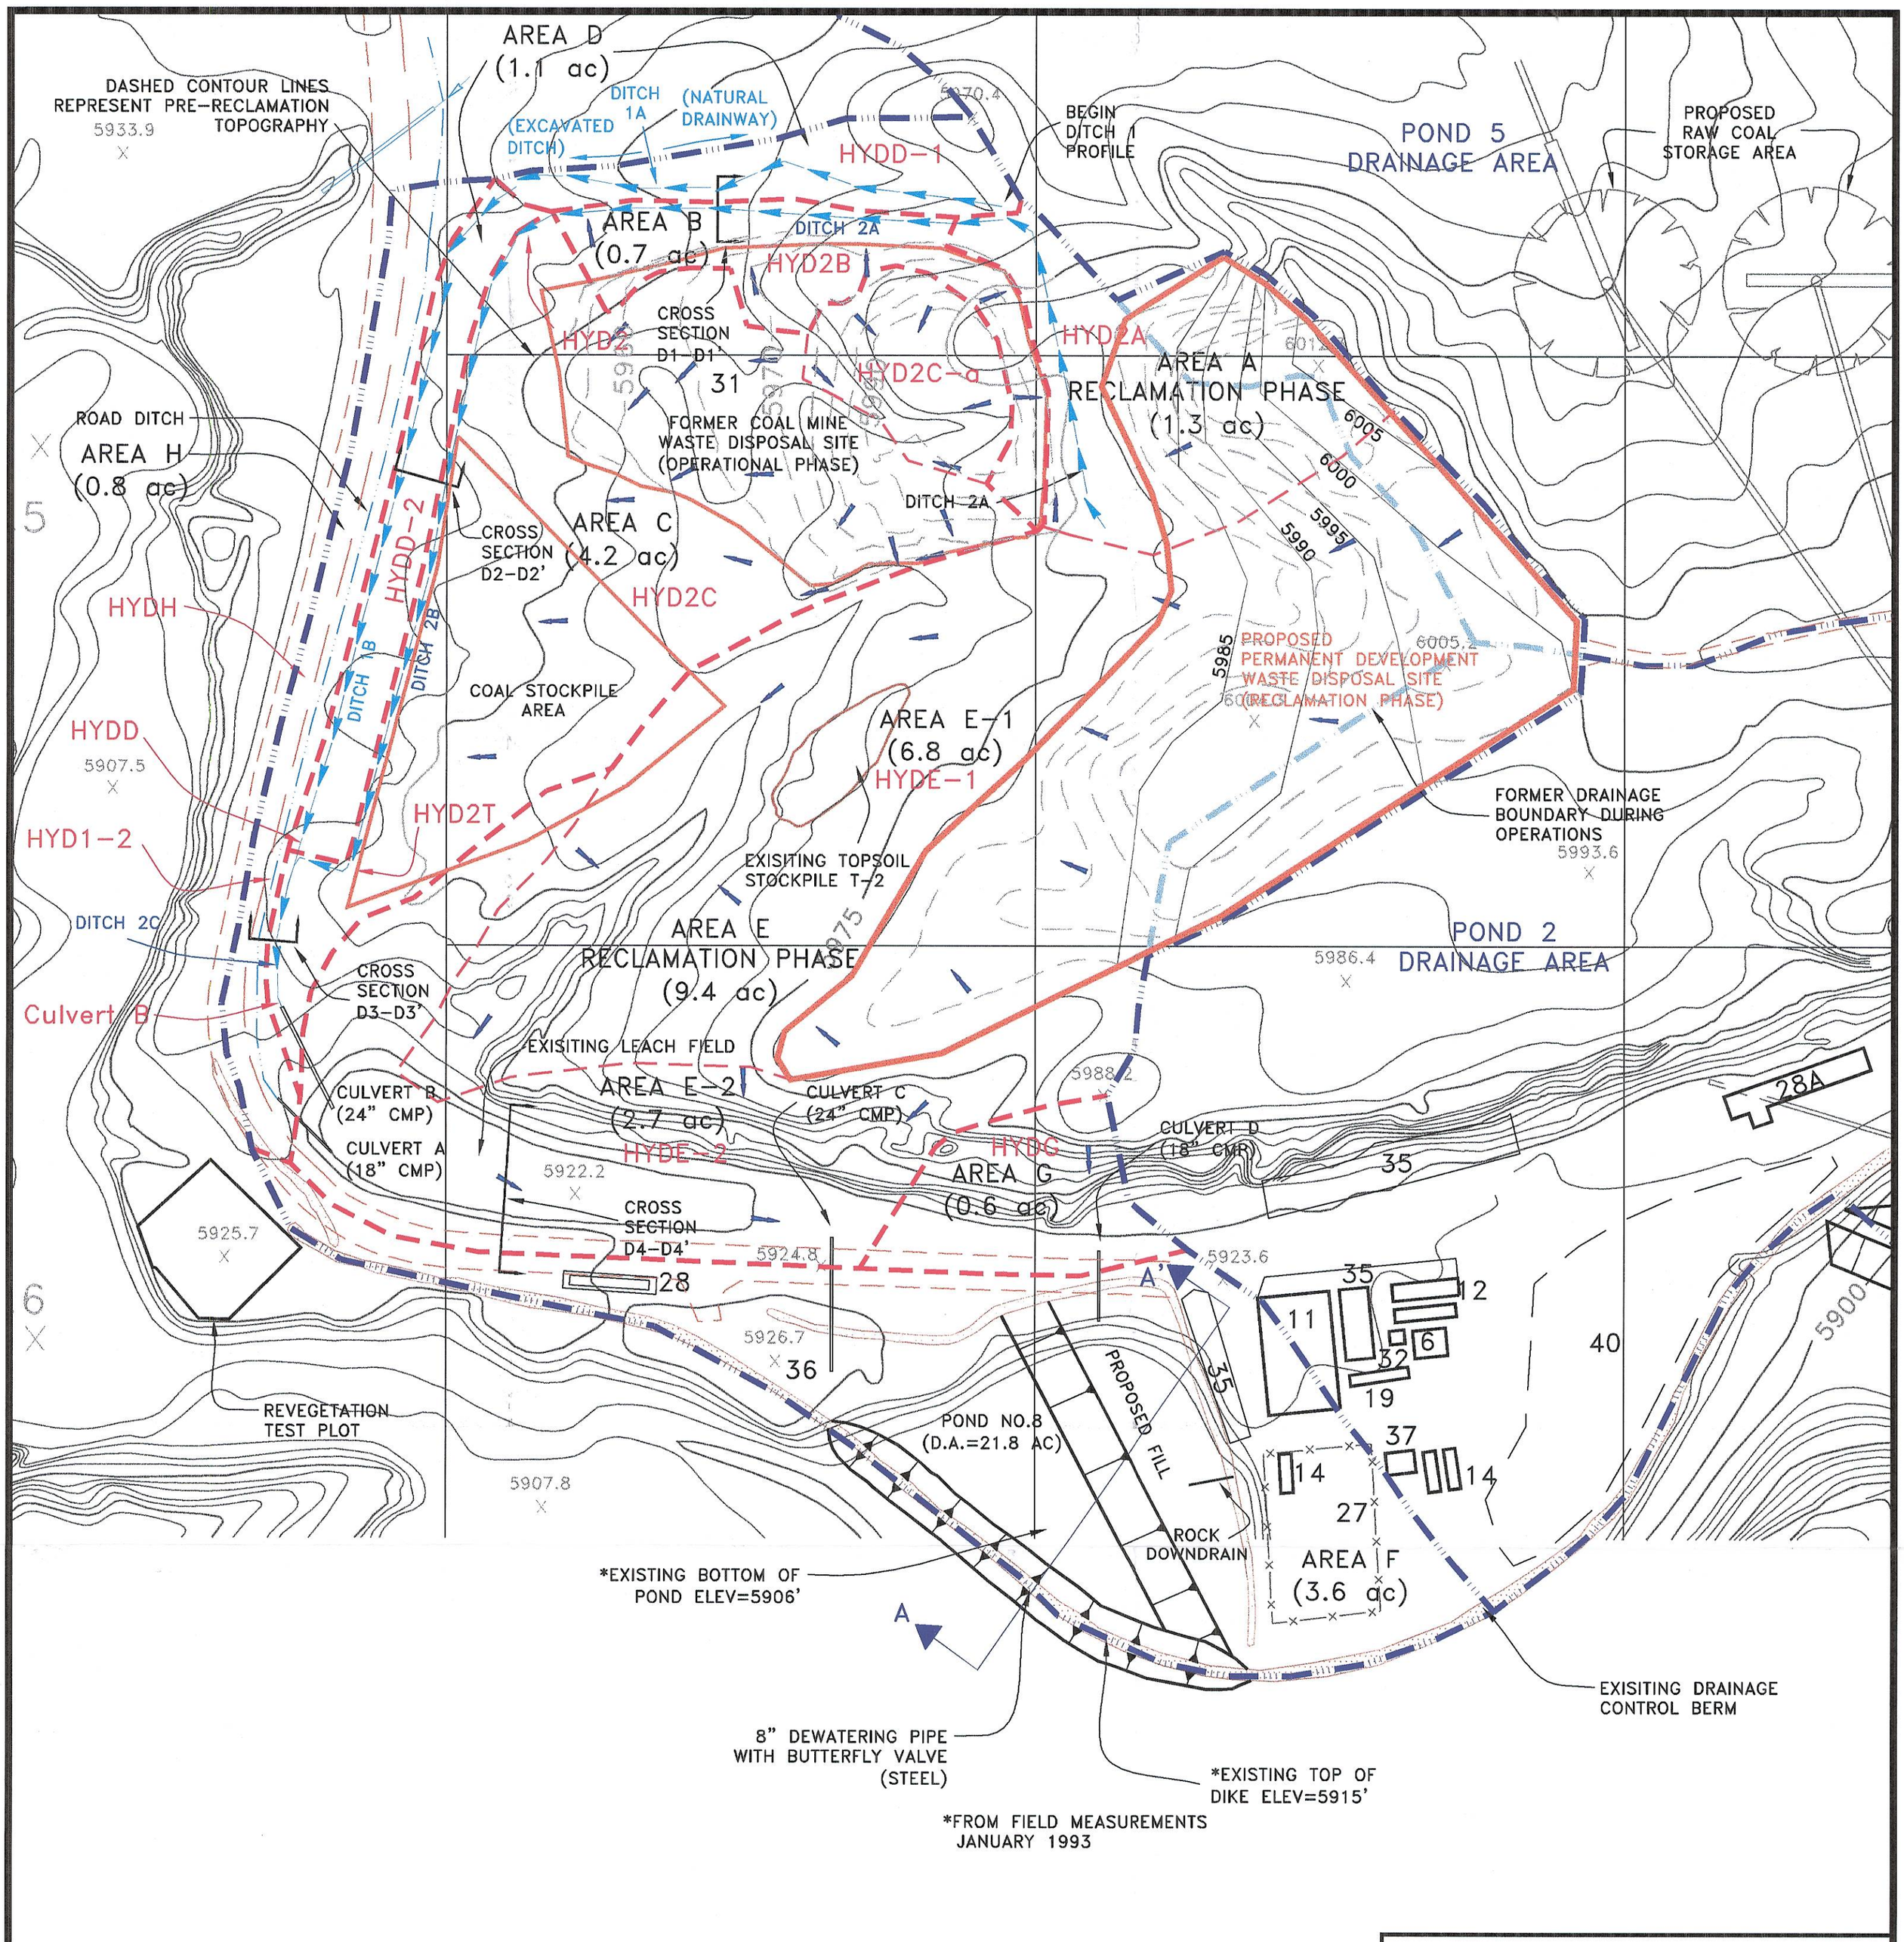

LEGEND

- DRAINAGE BOUNDARY – RECLAMATION
- SUBWATERSHED AREA
- AREA B — SUBWATERSHED TITLES
- HYD2A — HEC-HMS MODEL ELEMENTS
- SURFACE FLOW DIRECTION
- TOPOGRAPHY
- PRE-RECLAMATION TOPOGRAPHY

DRAINAGE BOUNDARIES APPLICABLE TO RECLAMATION PHASE

INCORPORATED
MAR 0 4 2008
Div. of Oil, Gas & Mining

NO.	REVISIONS	BY	DATE
1	"ASBUILT 18" CMP, RIP RAP & 8" STEEL PIPE"	JNT	6-21-93
2	REVISED REFUSE AREA DRAINAGE DESIGN	NPN	02-08

CONSOLIDATION COAL COMPANY
PO BOX 566, SESSER, IL 62884

PERMIT ACT 015/015

POND NO. 8
PLAN VIEW AND DRAINAGE MAP RECLAMATION PHASE

MINE: EMERY		DATE: 3/93	
CHKD.		SCALE: 1" = 100'	
APPD.		DRAWING NO.: APPENDIX VI - 7 REVISED 3/93	MINE
DRAWN: NPNENV	PAGE 52M of 52		