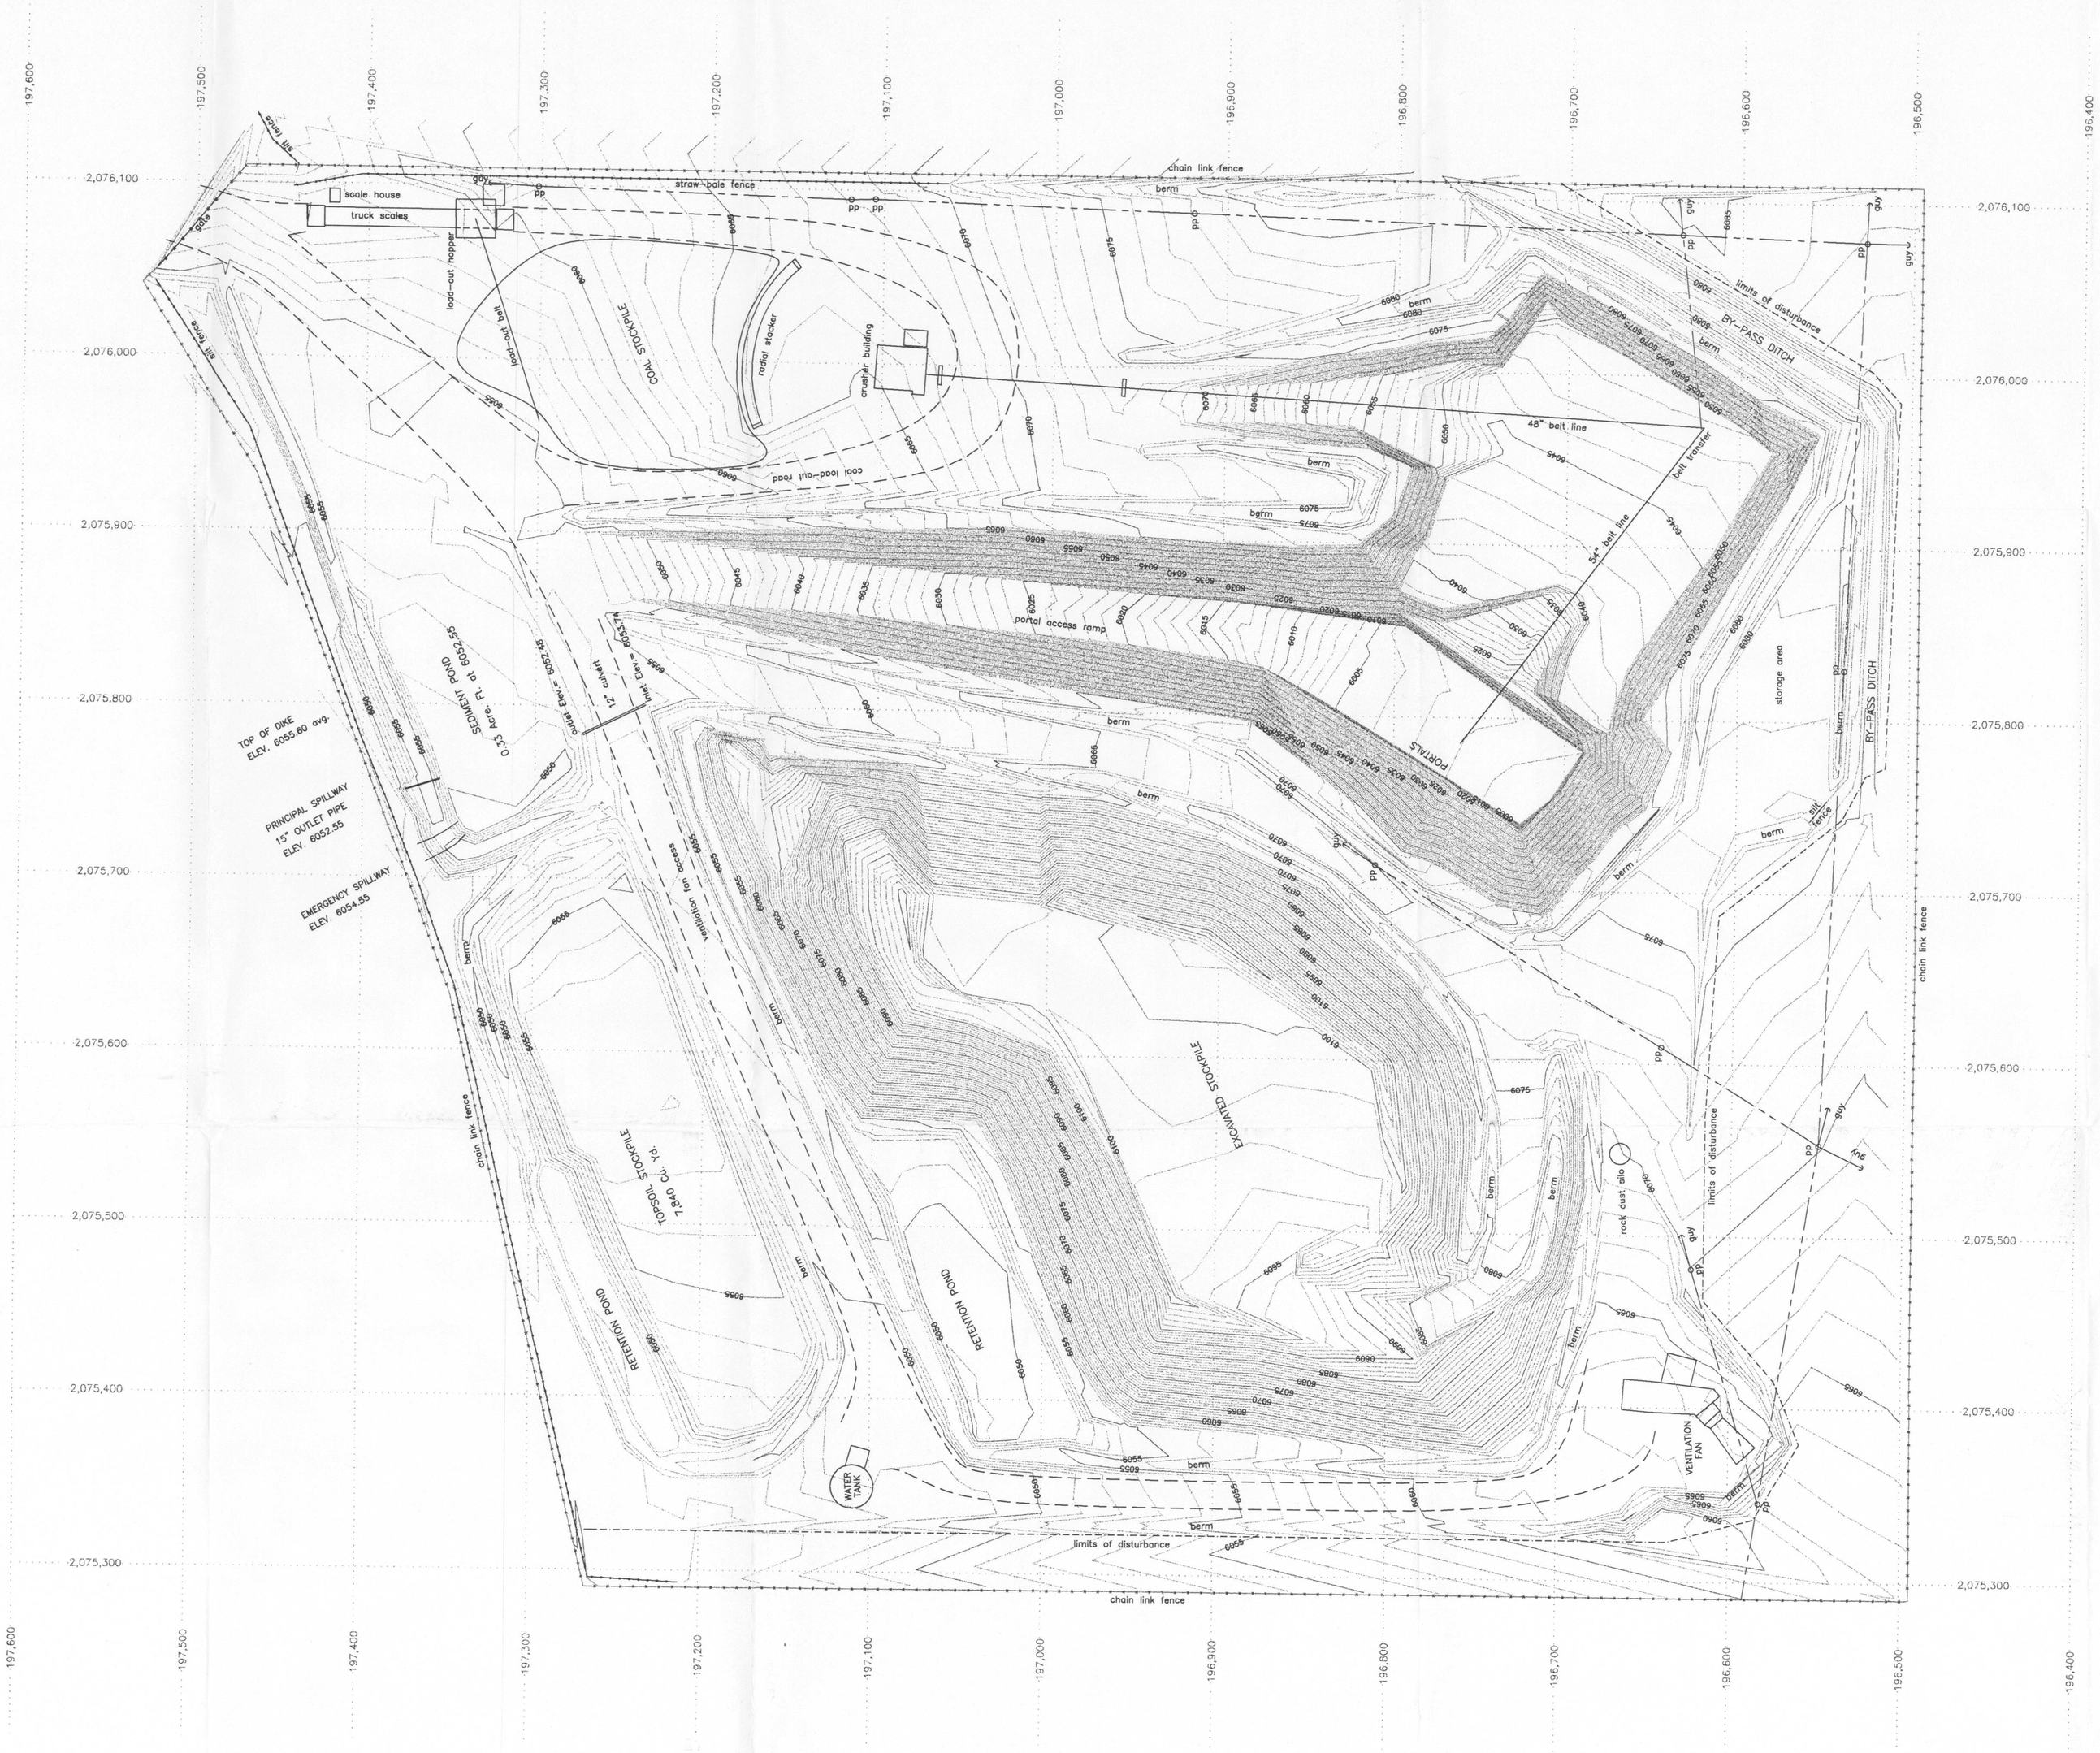

RECEIVED
MAY 05 2003
DIV. OF OIL, GAS & MINING

INCORPORATED
DEC 06 2002
DIV OF OIL GAS & MINING

LICENSED LAND SURVEYOR
163634
LEE M. SWASEY
4/28/03
STATE OF UTAH

SCALE: 1" = 50'
COUNTOUR INTERVAL = 1 FOOT
COORDINATE SYSTEM = NAD27 UTAH CENTRAL STATE PLANE

PLOT : 1=1	DESIGNED			CHECKED			NO.	REVISIONS	BY
	DRAWN	LMS	4-03	CHECKED	CEJ	4-03			
	SURVEYED	BHT	4-03	CHECKED	LMS	4-03			
	R.O.W.			CHECKED					

CONSOLIDATION COAL COMPANY
EMERY, UTAH
NEW PORTAL SITE

johansen & tuttle engineering inc.
BOX 487, CASTLE DALE, UTAH 84513, (435) 381-2523, FAX 381-2522, email jt @ etv.net

4th EAST SURFACE FACILITIES
"AS-BUILTS"

PROJECT NO.

PLATE
II - 3A