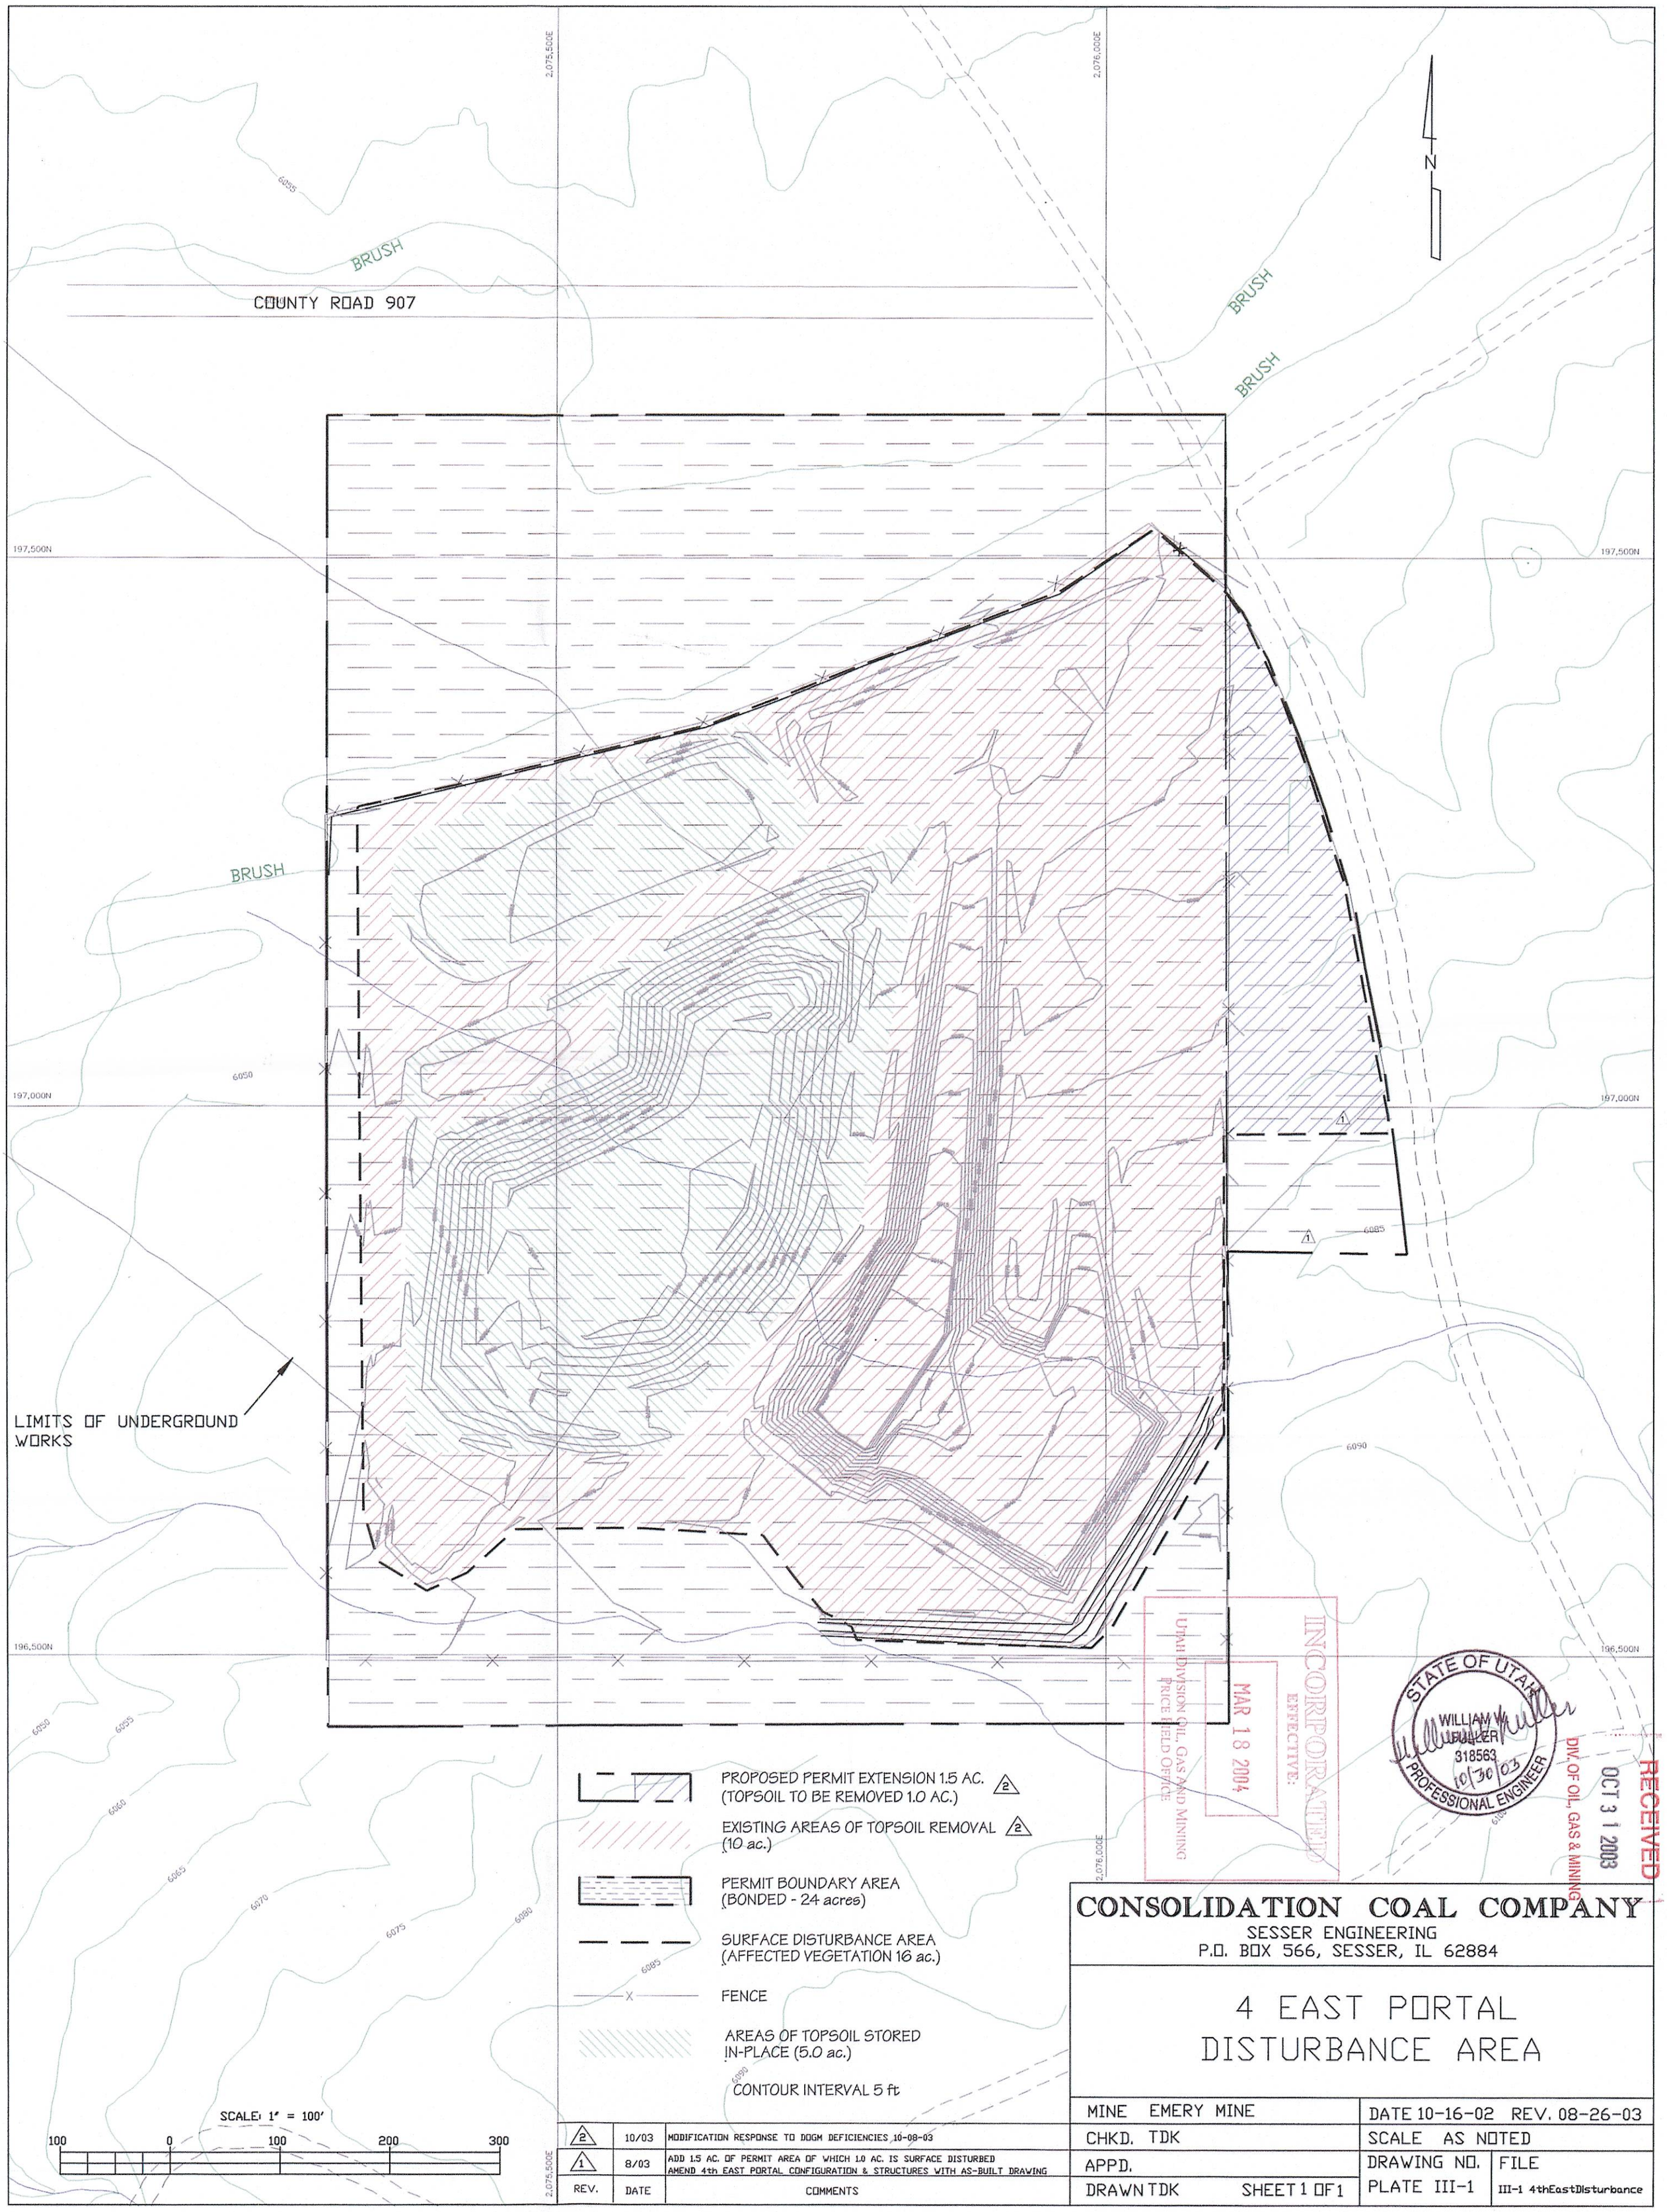
2,075,500E
2,076,000E
N
BRUSH
COUNTY ROAD 907
BRUSH
BRUSH
BRUSH
197,500N
197,000N
196,500N
LIMITS OF UNDERGROUND WORKS
6050
6055
6060
6065
6070
6075
6080
6085
6090
PROPOSED PERMIT EXTENSION 1.5 AC. (TOPSOIL TO BE REMOVED 1.0 AC.) 2
EXISTING AREAS OF TOPSOIL REMOVAL (10 ac.) 2
PERMIT BOUNDARY AREA (BONDED - 24 acres)
SURFACE DISTURBANCE AREA (AFFECTED VEGETATION 16 ac.)
FENCE
AREAS OF TOPSOIL STORED IN-PLACE (5.0 ac.)
CONTOUR INTERVAL 5 ft
SCALE: 1" = 100'
100 0 100 200 300
UTAH DIVISION OIL, GAS AND MINING PRICE FIELD OFFICE
INCORPORATED EFFECTIVE: MAR 18 2004
STATE OF UTAH WILLIAM MUELLER 318563 10/30/03 PROFESSIONAL ENGINEER
RECEIVED OCT 31 2003 DIV. OF OIL, GAS & MINING
CONSOLIDATION COAL COMPANY
SESSER ENGINEERING
P.O. BOX 566, SESSER, IL 62884
4 EAST PORTAL DISTURBANCE AREA
MINE EMERY MINE
DATE 10-16-02 REV. 08-26-03
CHKD. TDK
SCALE AS NOTED
APPD.
DRAWN TDK
SHEET 1 OF 1
DRAWING NO. PLATE III-1
FILE III-1 4thEastDisturbance
REV. DATE COMMENTS
2 10/03 MODIFICATION RESPONSE TO DOGM DEFICIENCIES 10-08-03
1 8/03 ADD 1.5 AC. OF PERMIT AREA OF WHICH 1.0 AC. IS SURFACE DISTURBED AMEND 4th EAST PORTAL CONFIGURATION & STRUCTURES WITH AS-BUILT DRAWING